


O  
36  
D

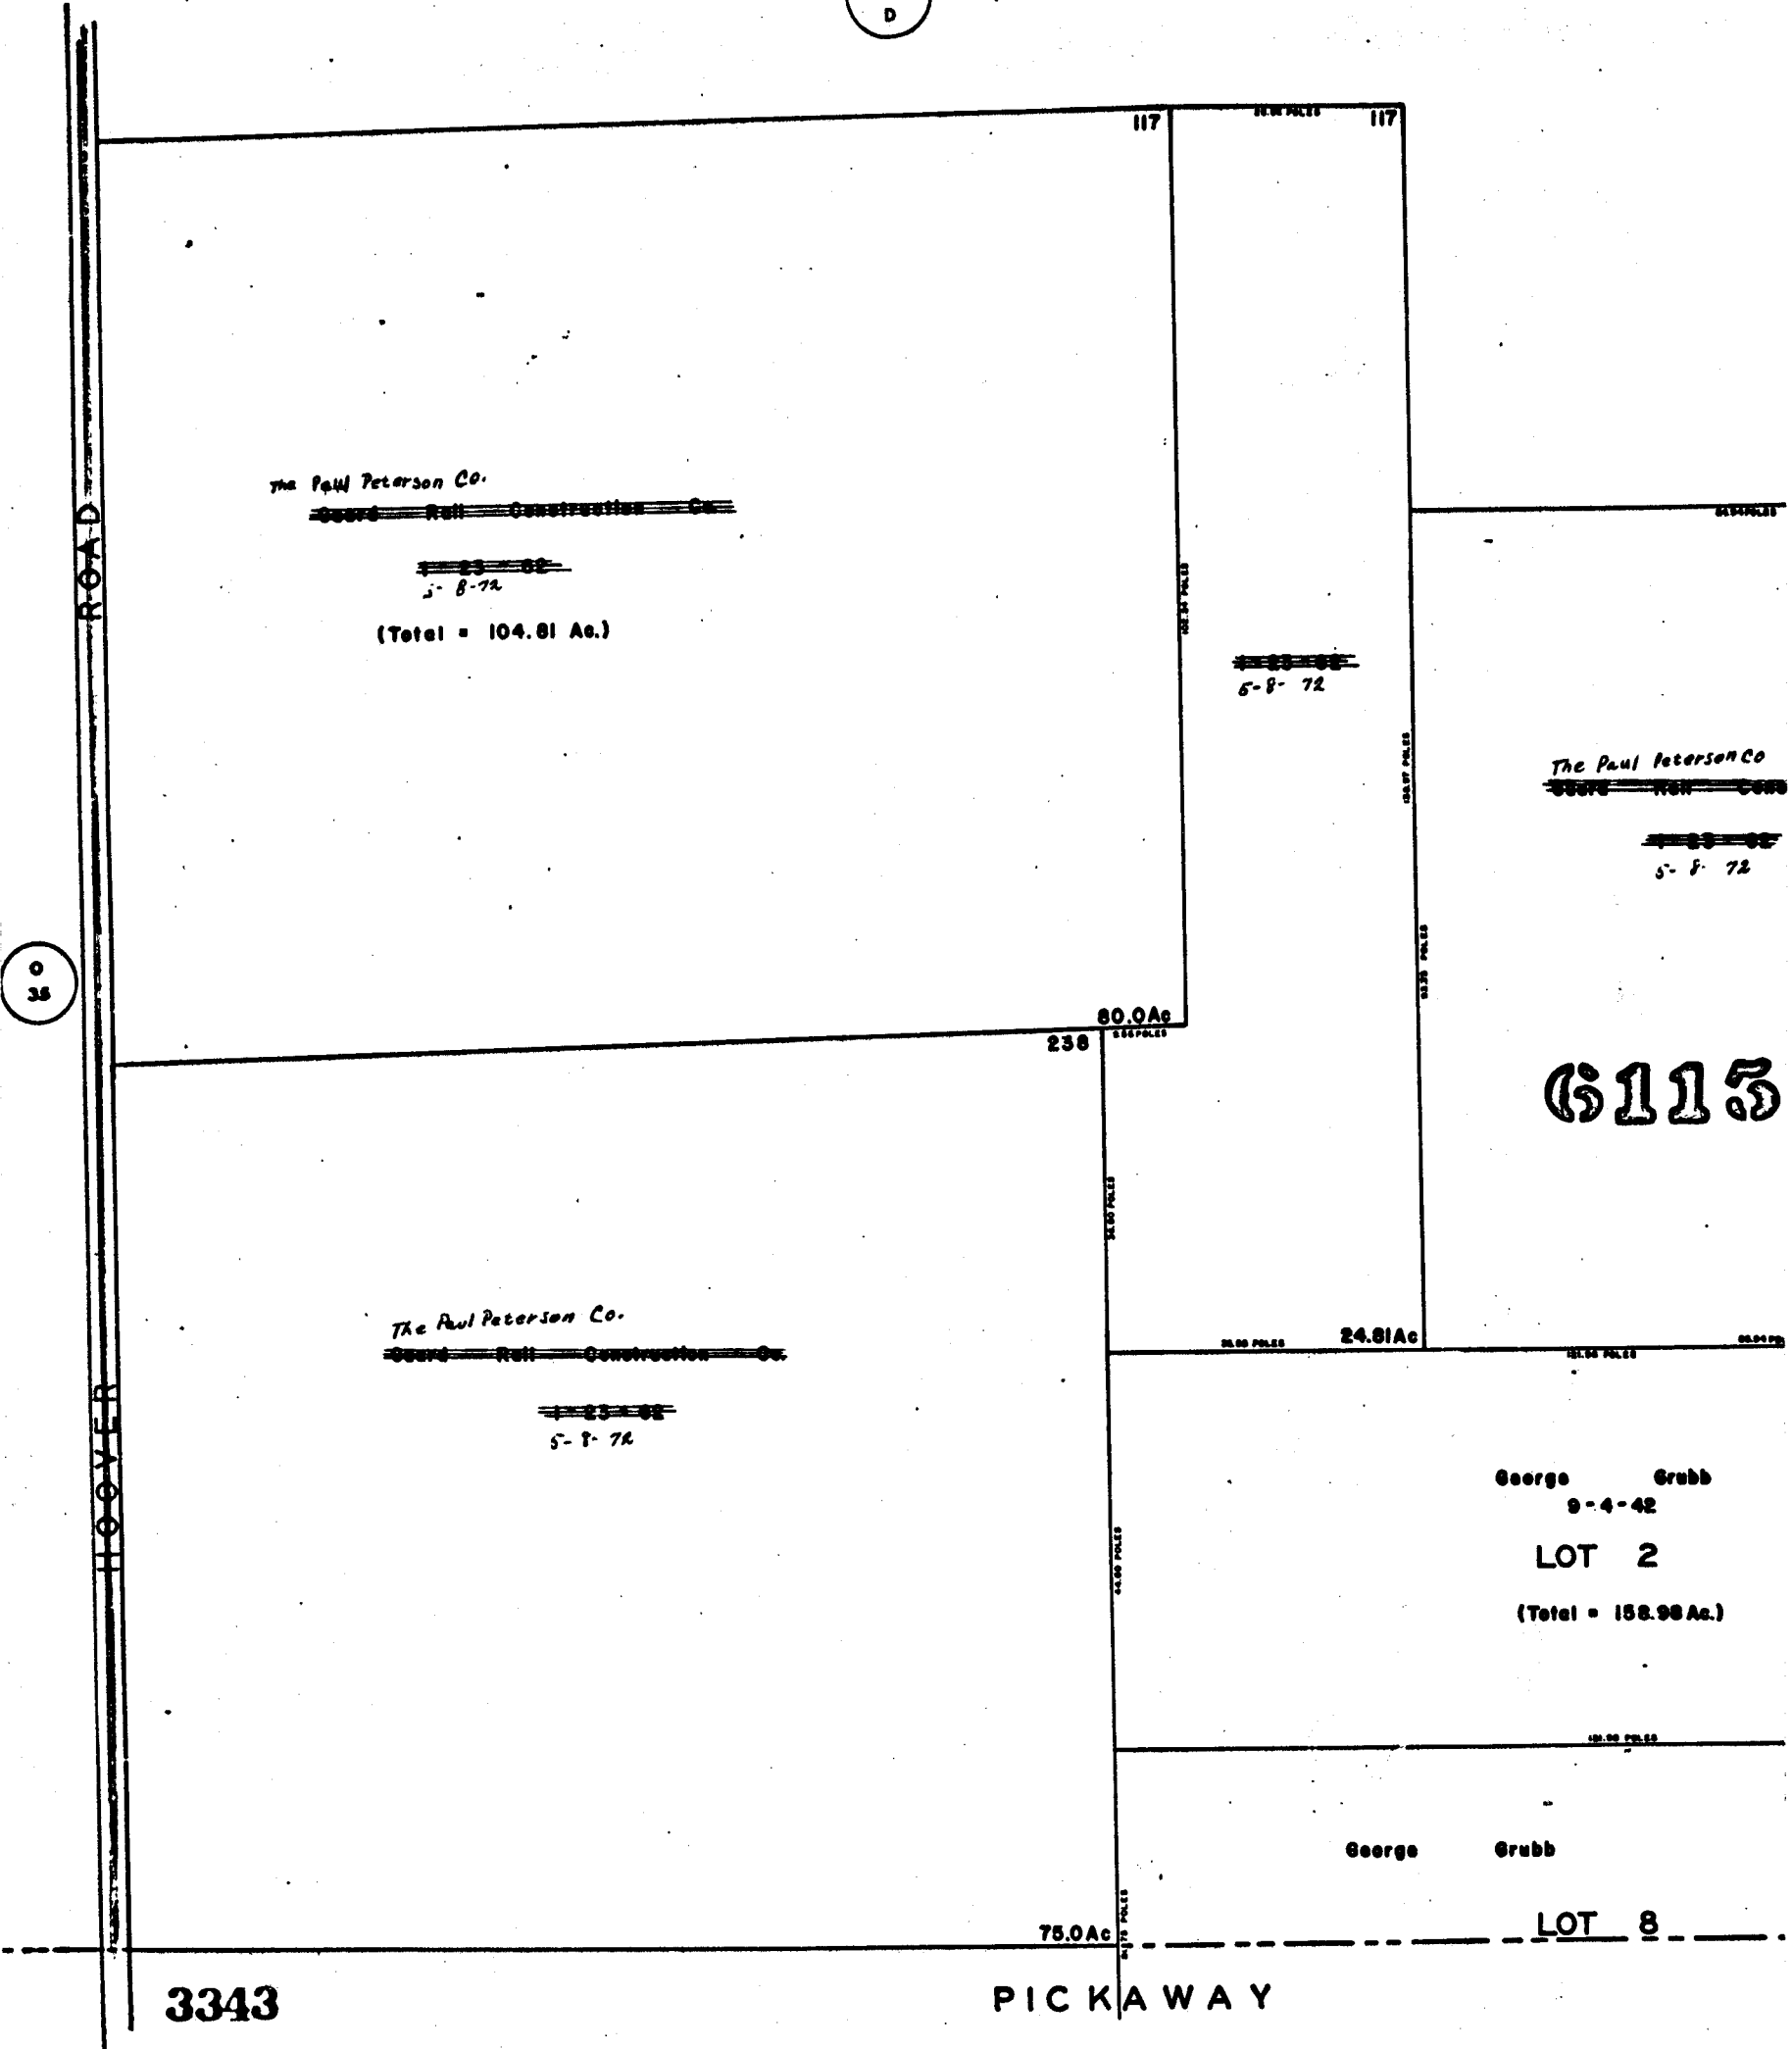

The Paul Peterson Co.

~~Survey Roll Construction Co.~~

~~5-8-72~~

(Total = 104.81 Ac.)

~~5-8-72~~

The Paul Peterson Co.

~~Survey Roll Construction Co.~~

~~5-8-72~~

6115

The Paul Peterson Co.

~~Survey Roll Construction Co.~~

~~5-8-72~~

George Grubb  
9-4-42

LOT 2

(Total = 158.98 Ac.)

George Grubb

LOT 8

3343

PICKAWAY


O-36-F

JACKSON TWP



SCALE 1" = 200'  
TAXING V.M.S. DISTRICTS JACKSON TWP

36

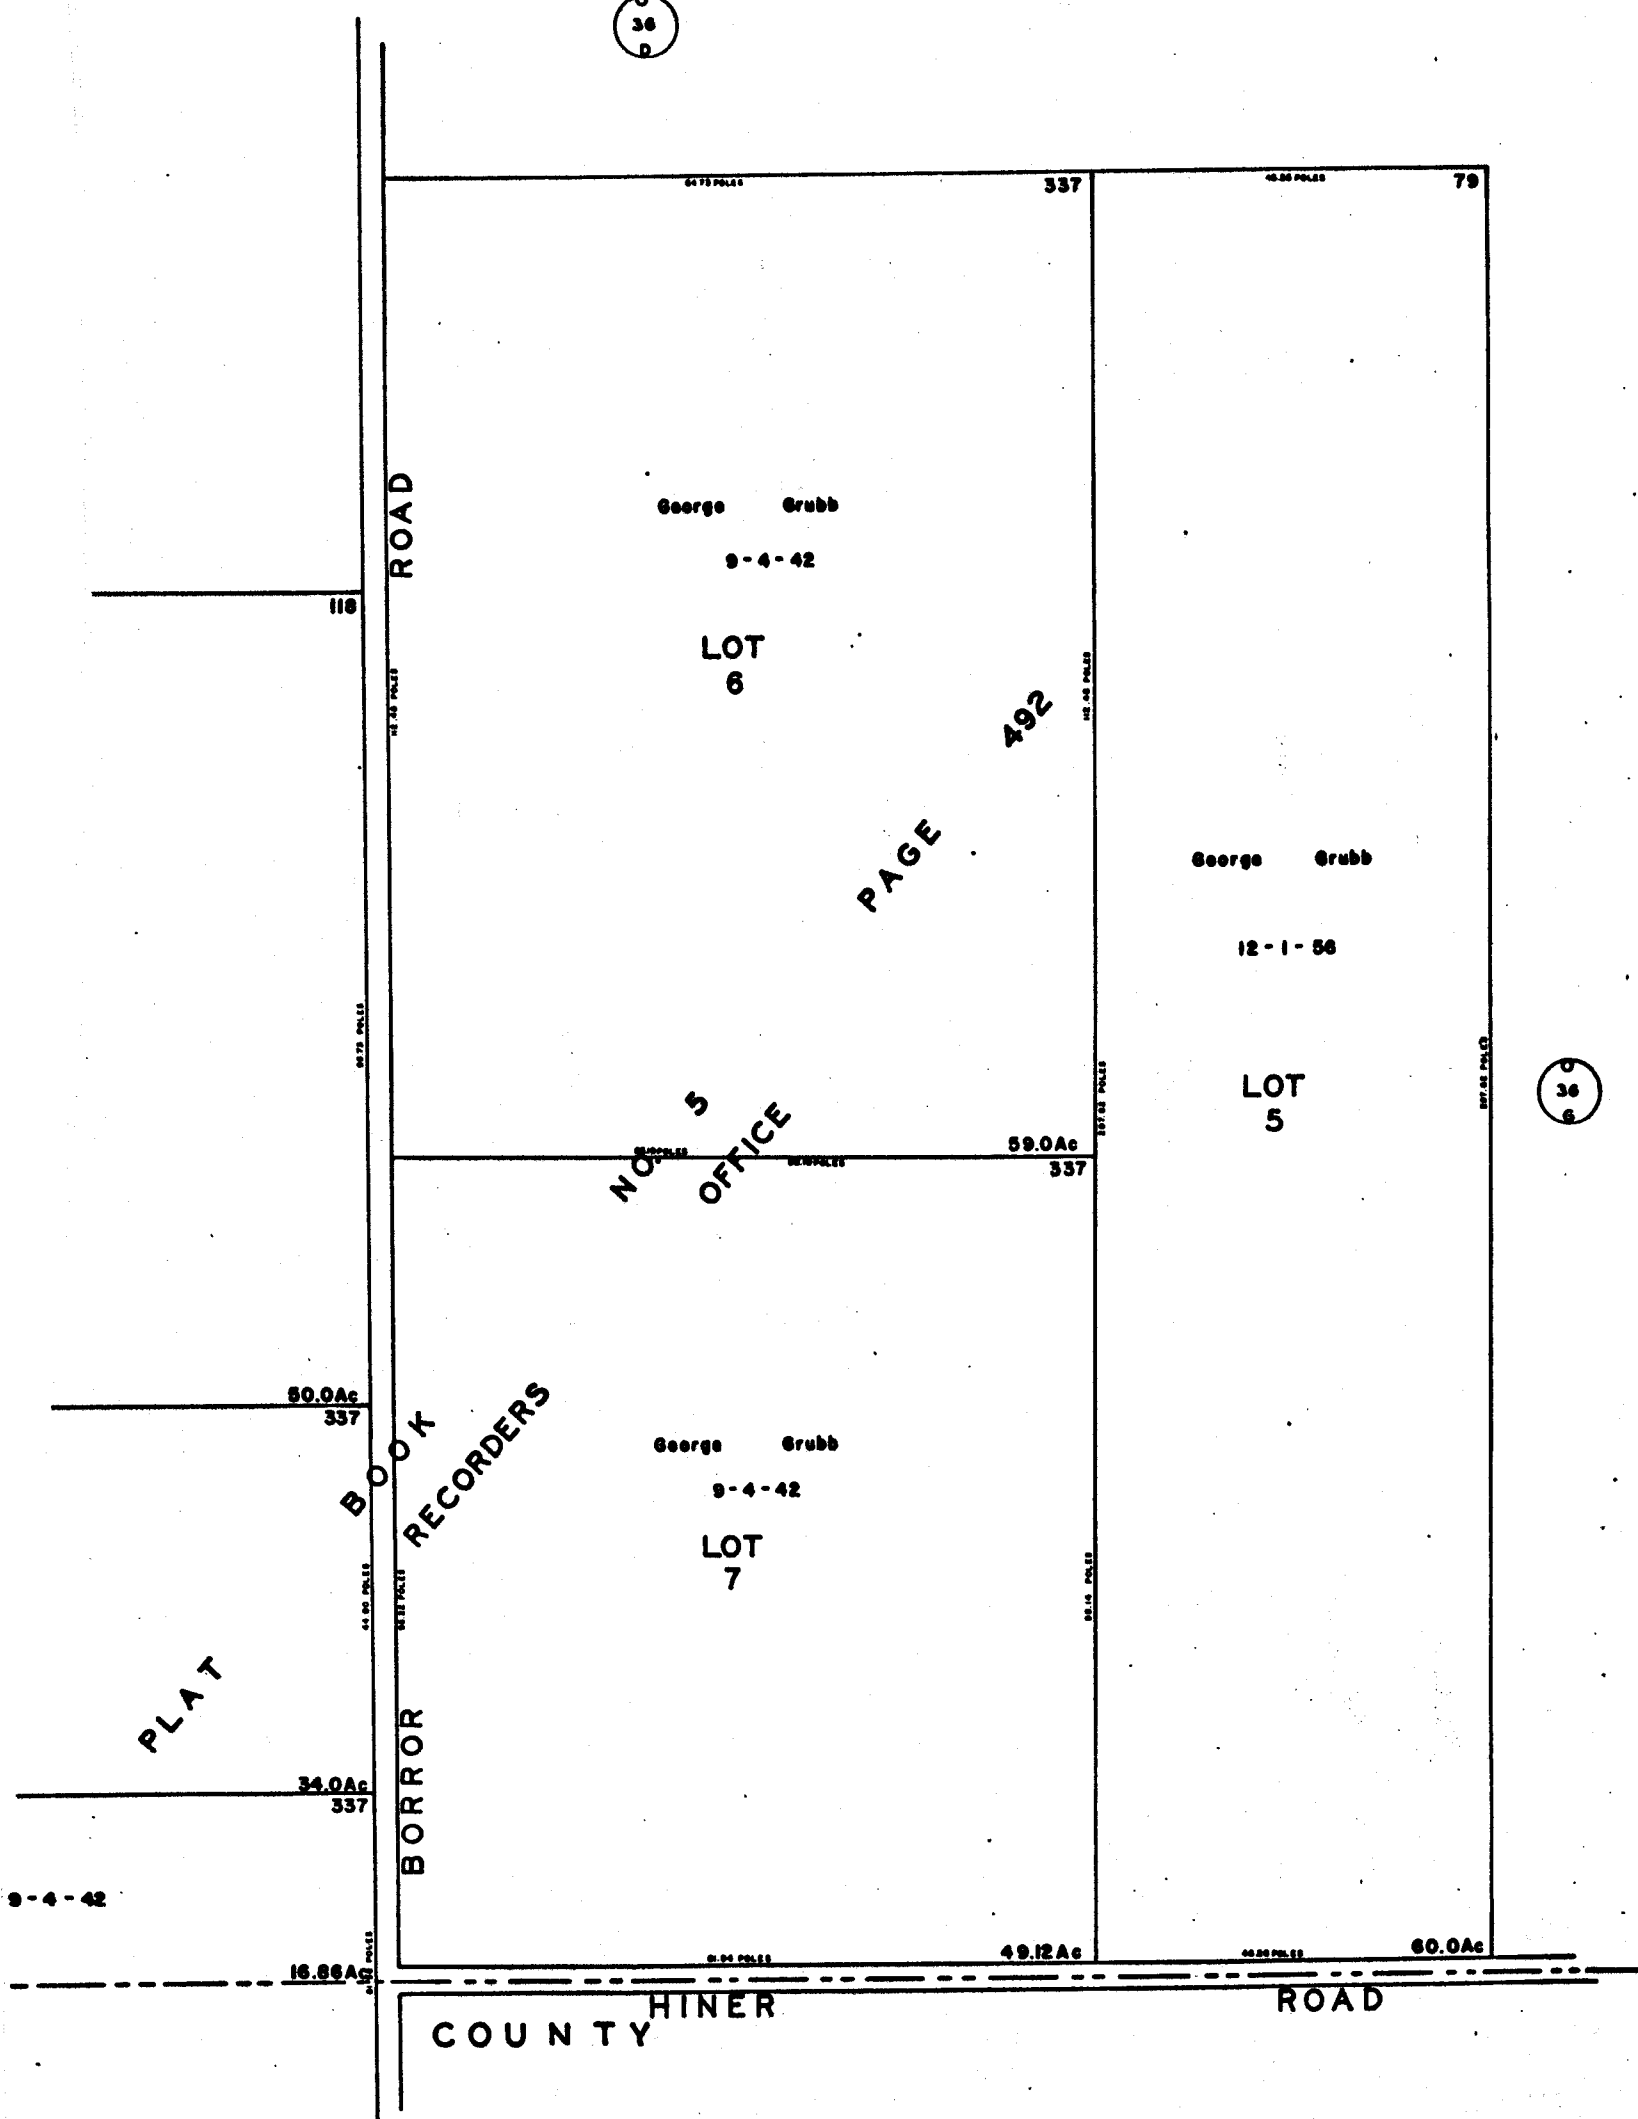

36

BORROR ROAD

HINER ROAD

COUNTY

PLAT

BOOK RECORDERS

OFFICE NO. 5

PAGE 492

3344

O-36-F