


0
33
G

665

LONDON-GROVEPORT

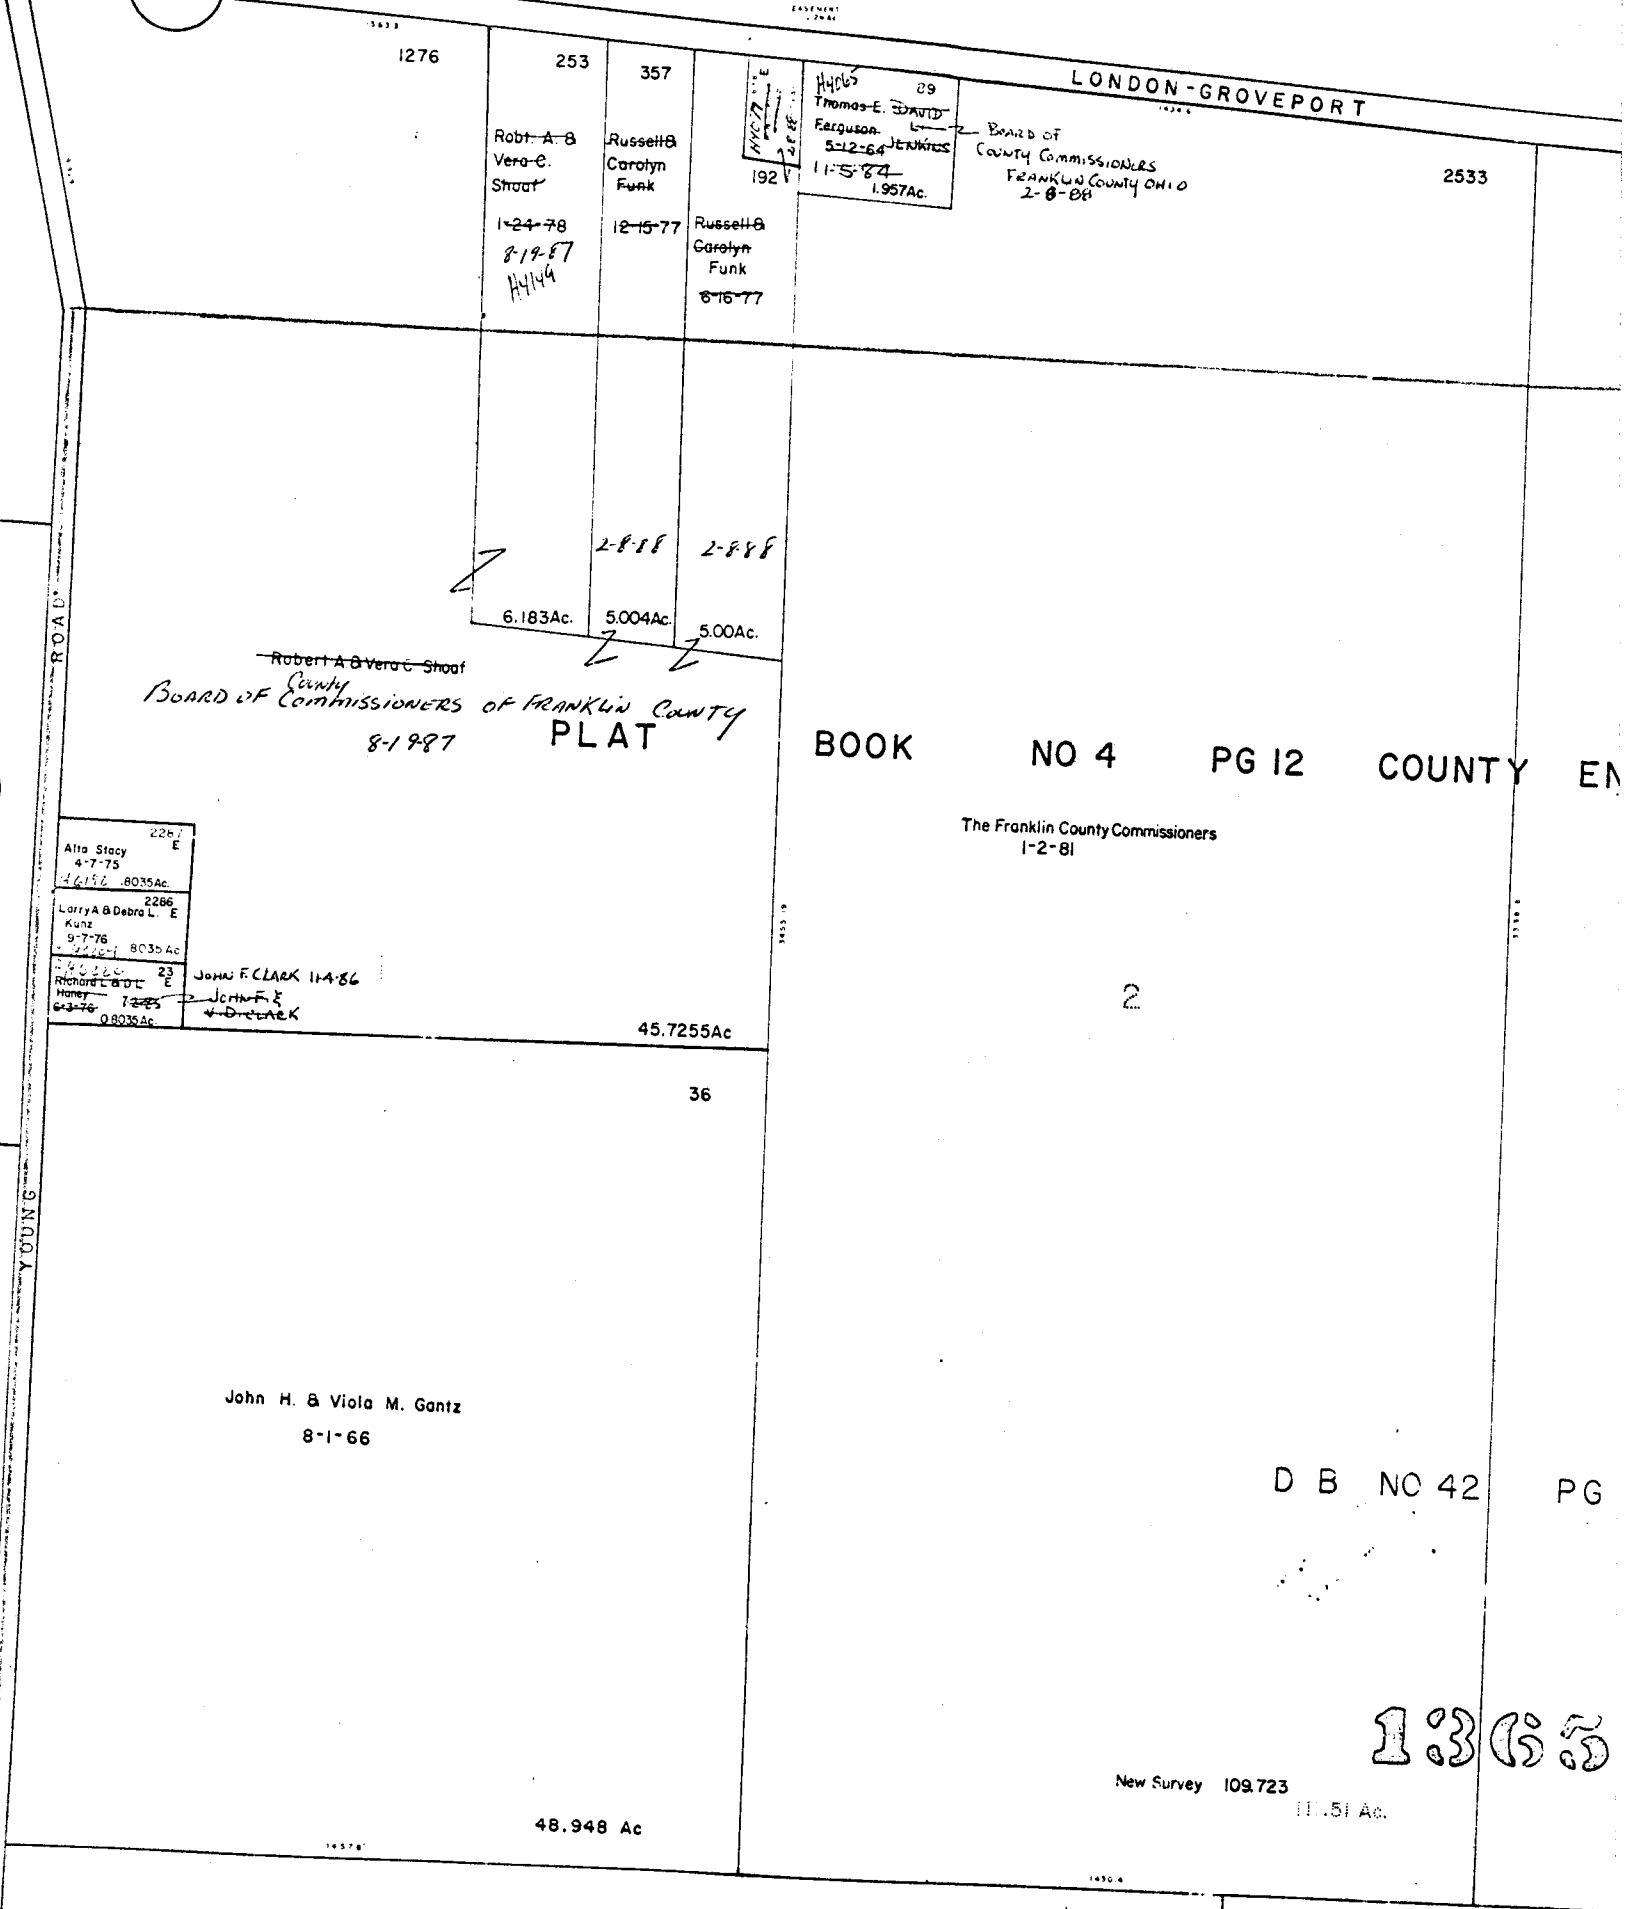

0
84

D B NC 42 PG

1365

0
35
C

0-35-A

JACKSON TWP



SCALE 1" = 200'

V.M.S.

E = HIGHWAY EASEMENT

TAXING DISTRICT DISTRICT CODE

JACKSON TWP 160

H... HOUSE NUMBERS

0
33
H

1371

ROAD

1489

S. R. 665

272

272

H3851

H3573

ENGRS OFFICE

The Franklin County Commissioners
1-2-81

3

0
35
B

~~4-24-67~~
9-23-85

~~4-24-67~~
9-23-85

RICHARD T. BARBEE & WILLIAM T. SCHUCH
Helen E. Schuch & T. Richard Barbree
4-24-67 9-23-85

~~4-24-67~~
9-23-85

~~4-24-67~~
9-23-85

G 16 RECORDERS OFF

112.55 Ac
109 Ac.

(1.69 Ac)
Easement

State

(2986 Ac)

of

(2986 Ac)

Ohio

(2986 Ac.)

(15.24 Ac.)

Total
139.1 Ac.

(1966 Ac.)

(2986 Ac)



0-35-A

QRP 2 (7-81)

482