


0
87
B

6210

0
87
D

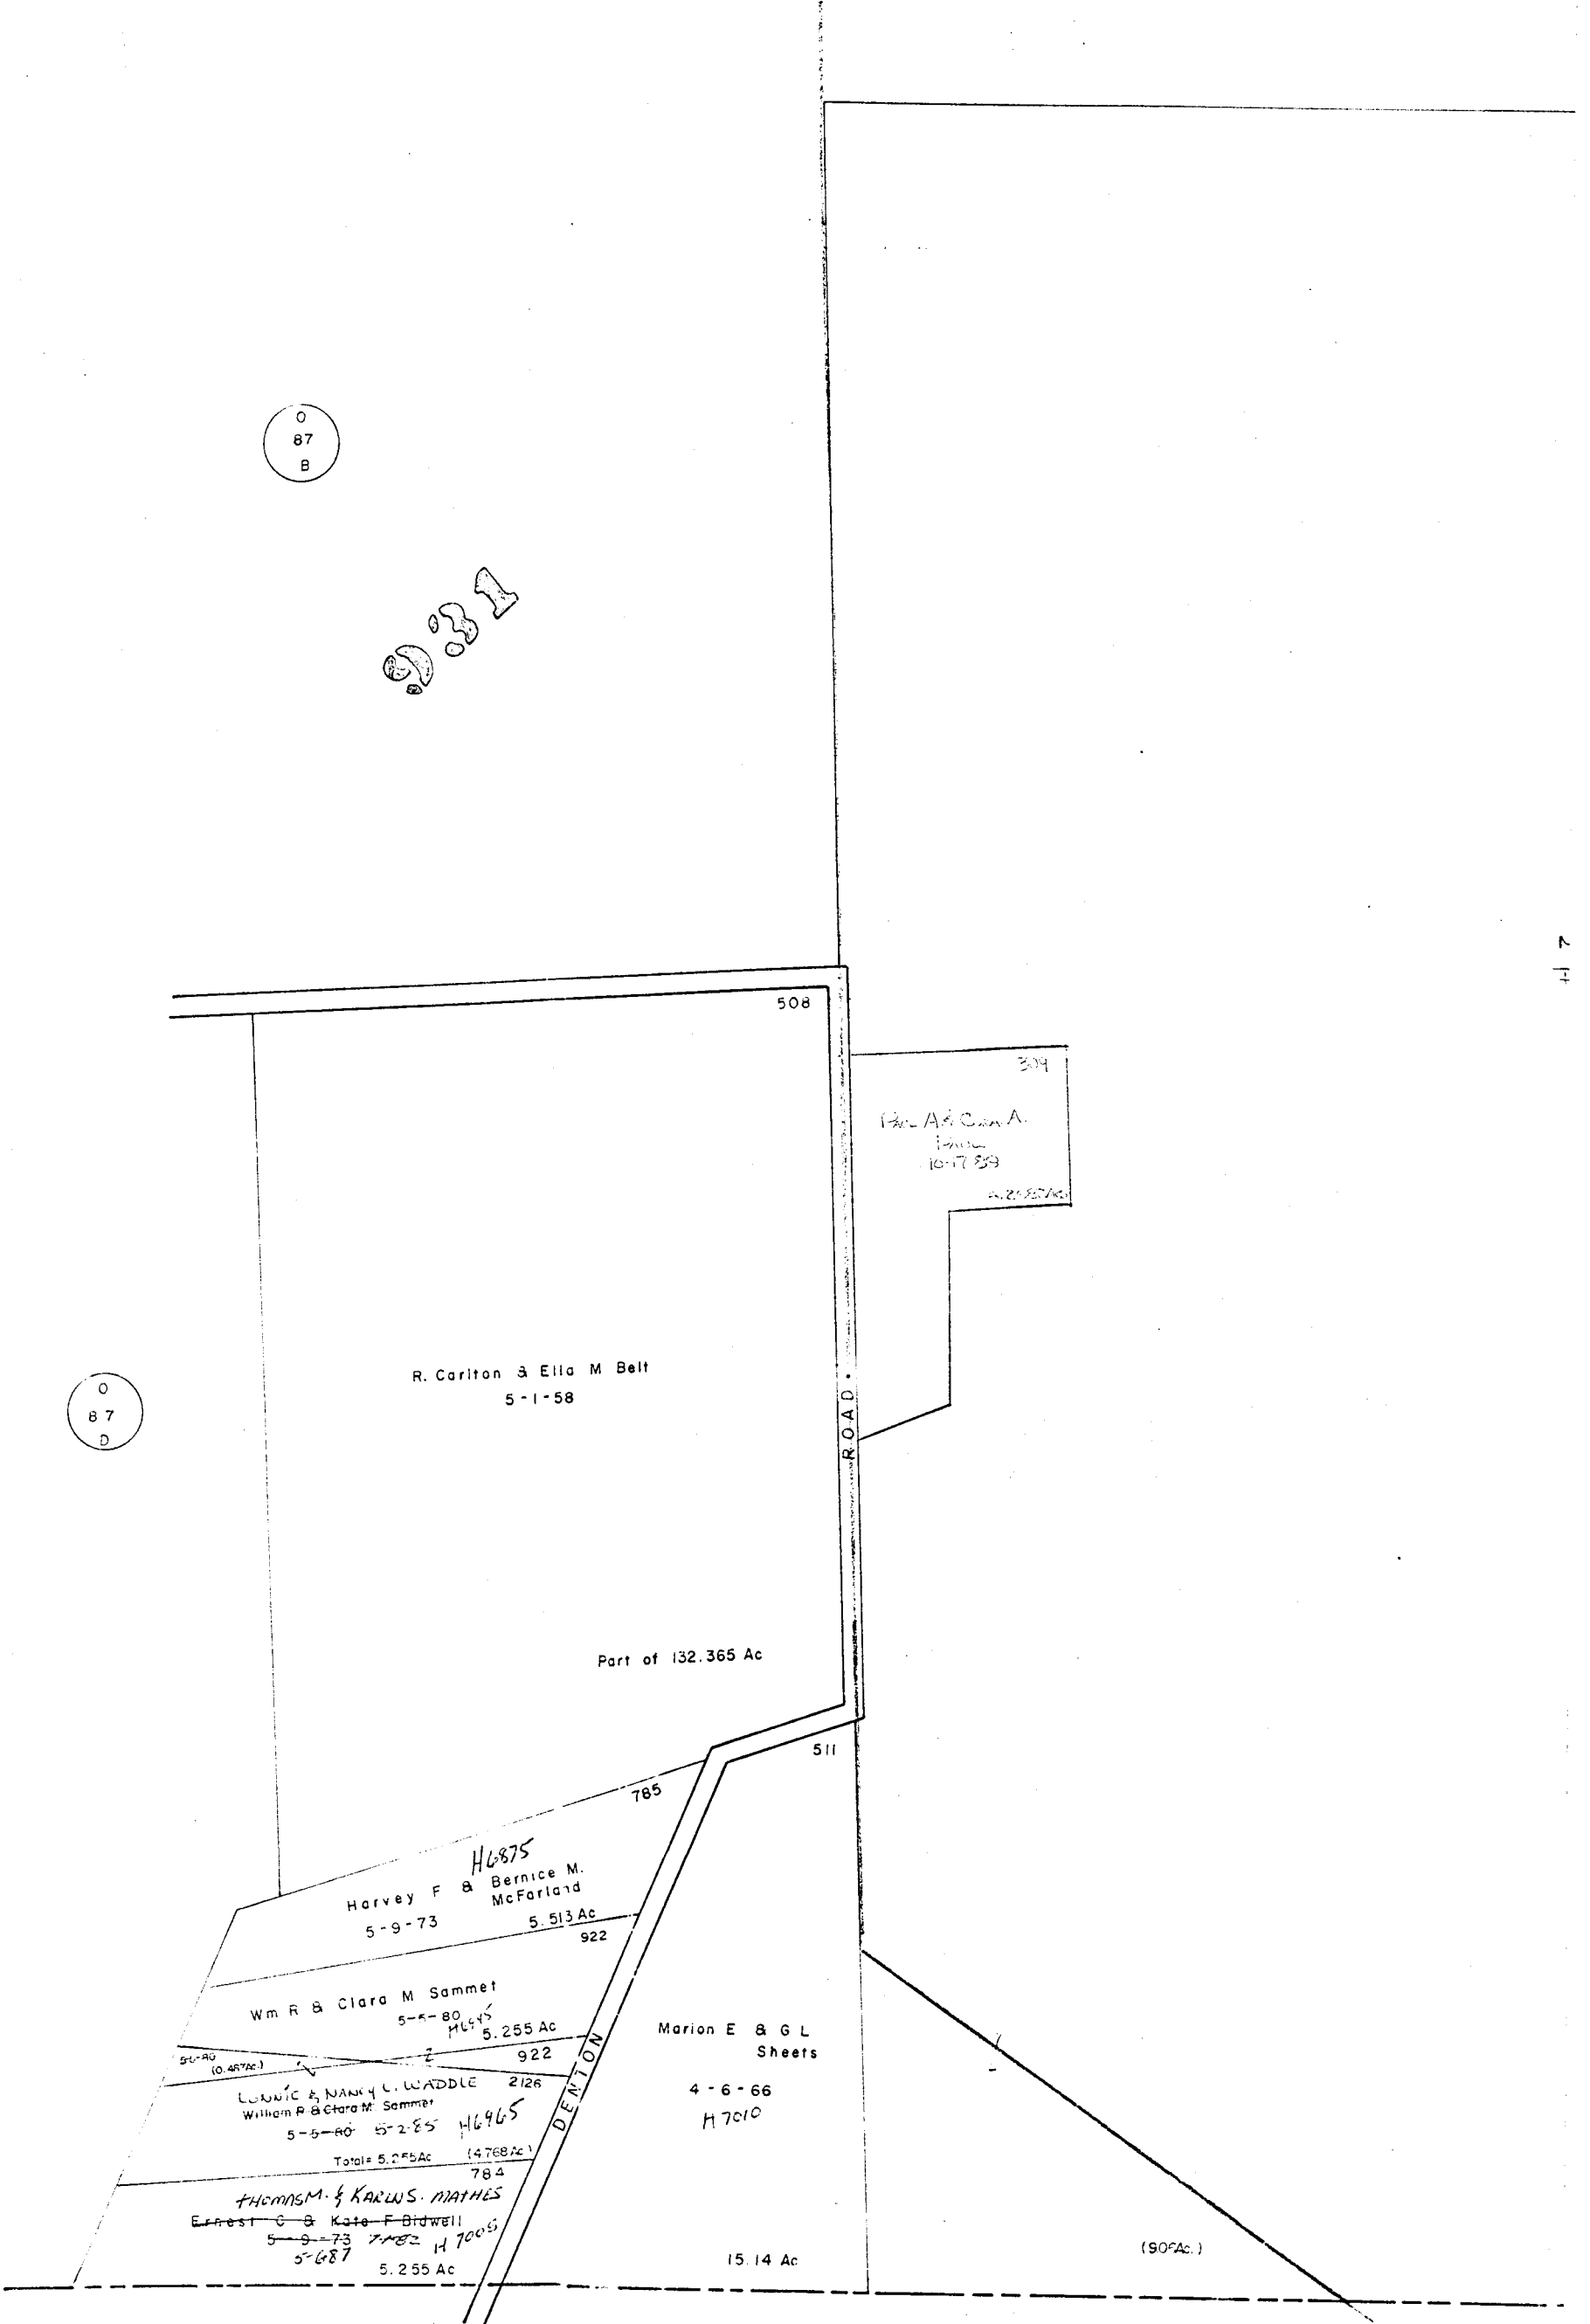

6210

PICKAWAY

0
87
C

O-87-E
PLEASANT TWP



SCALE: 1"=200'
V.M.S.

E-HIGHWAY EASEMENT
TAXING DISTRICTS DISTRICT CODE
PLEASANT TWP 230
HOUSE NUMBER

RYAN D. SCOTT L.E.
1230-06 1-8-87

5.375Acs ~~7.445~~

2795

SAUNDRA S. HOLSTEIN
~~The Travellers Insurance Co.~~
9-8-80

54.625Acs.
~~62.66Acs~~

ROAD
YOUNG

TOWNSHIP

0
35
F

JACKSON

0
35
F

M. DOUGLAS & CAROL R. MINNICH

The Travellers Insurance Company
Lester L. & Miriam A. Jordan
9-28-88

1010

H6684
H6738
H6756

370.178Acs.
~~377.186Acs~~
437.186 Ac

COUNTY

O-87-E

1284