

MYERS SURVEYING CO.
2700 East Main Street, Columbus 9 (Bexley), Ohio

SURVEY OF LOTS 422, 423, NATIONAL PIKE LITTLE FARMS
PRAIRIE TWP. N-85

17825 7150
17825 7125



FOR
MR. ^B EVERHARD

P.B. 12 Page 7
Scale 1" = 40'

Franklin Co. Rec. Office
8 · 10 · 64

Rec'd

N 85

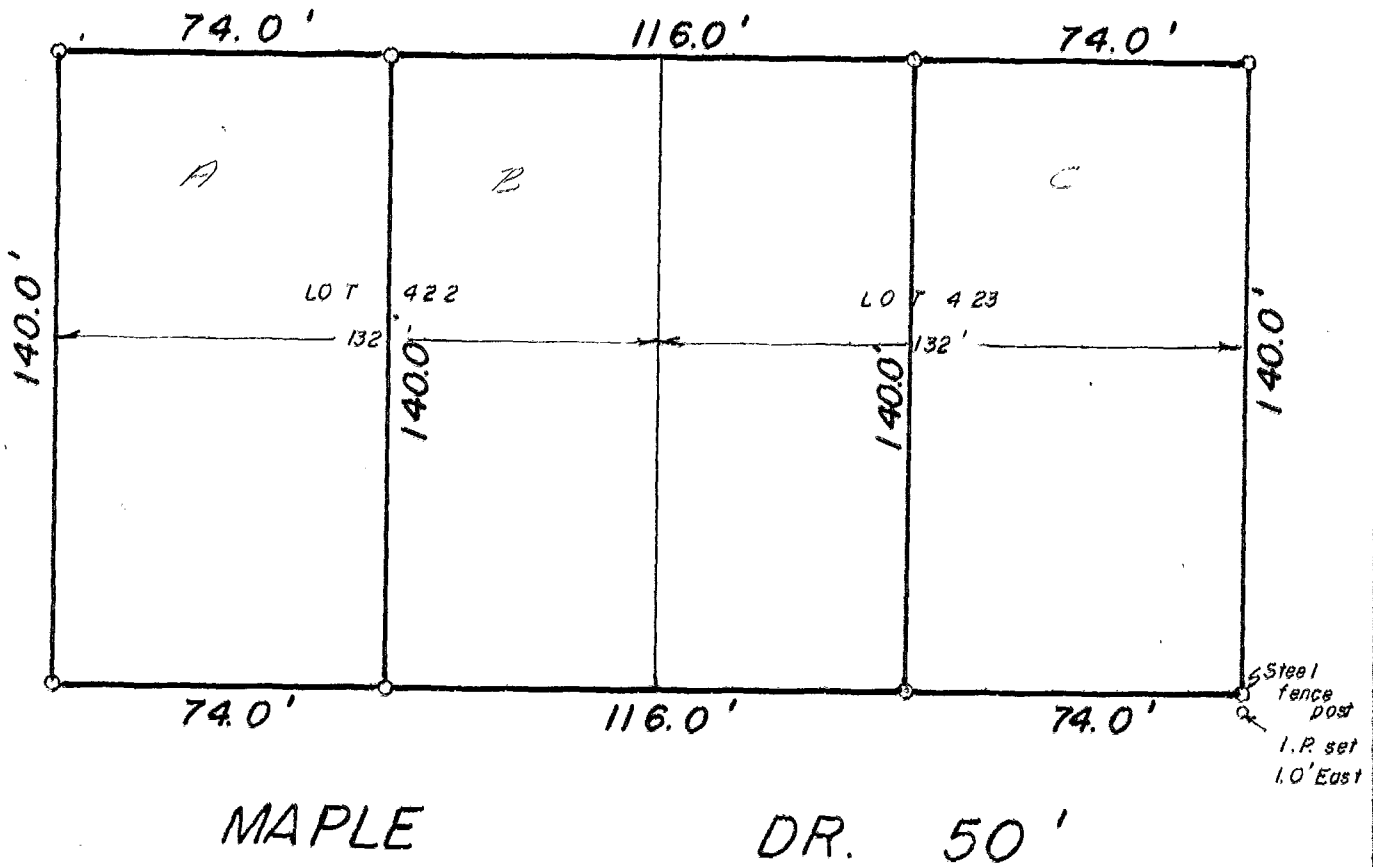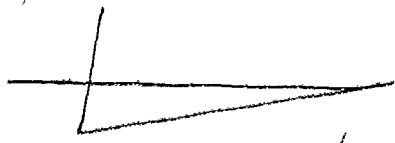

N-85

We hereby certify that the foregoing plat was prepared from an actual survey of the premises. ~~_____~~
~~_____~~ Iron pins not set unless indicated
thus -0-.

MYERS SURVEYING CO.

BY Oliver DeWitt
Registered Surveyor