


ORDER NO. 10-51

PLAT SHOWING
TRACTS OF LAND ON WEST MOUNTAIN STREET
AND
ROBERT LLOYD

~~M-161~~ M-161
~~1781~~

Also Ord. 900-51
Also in Deed Book 1866
Page 260
Deed Book 2466 Page 52

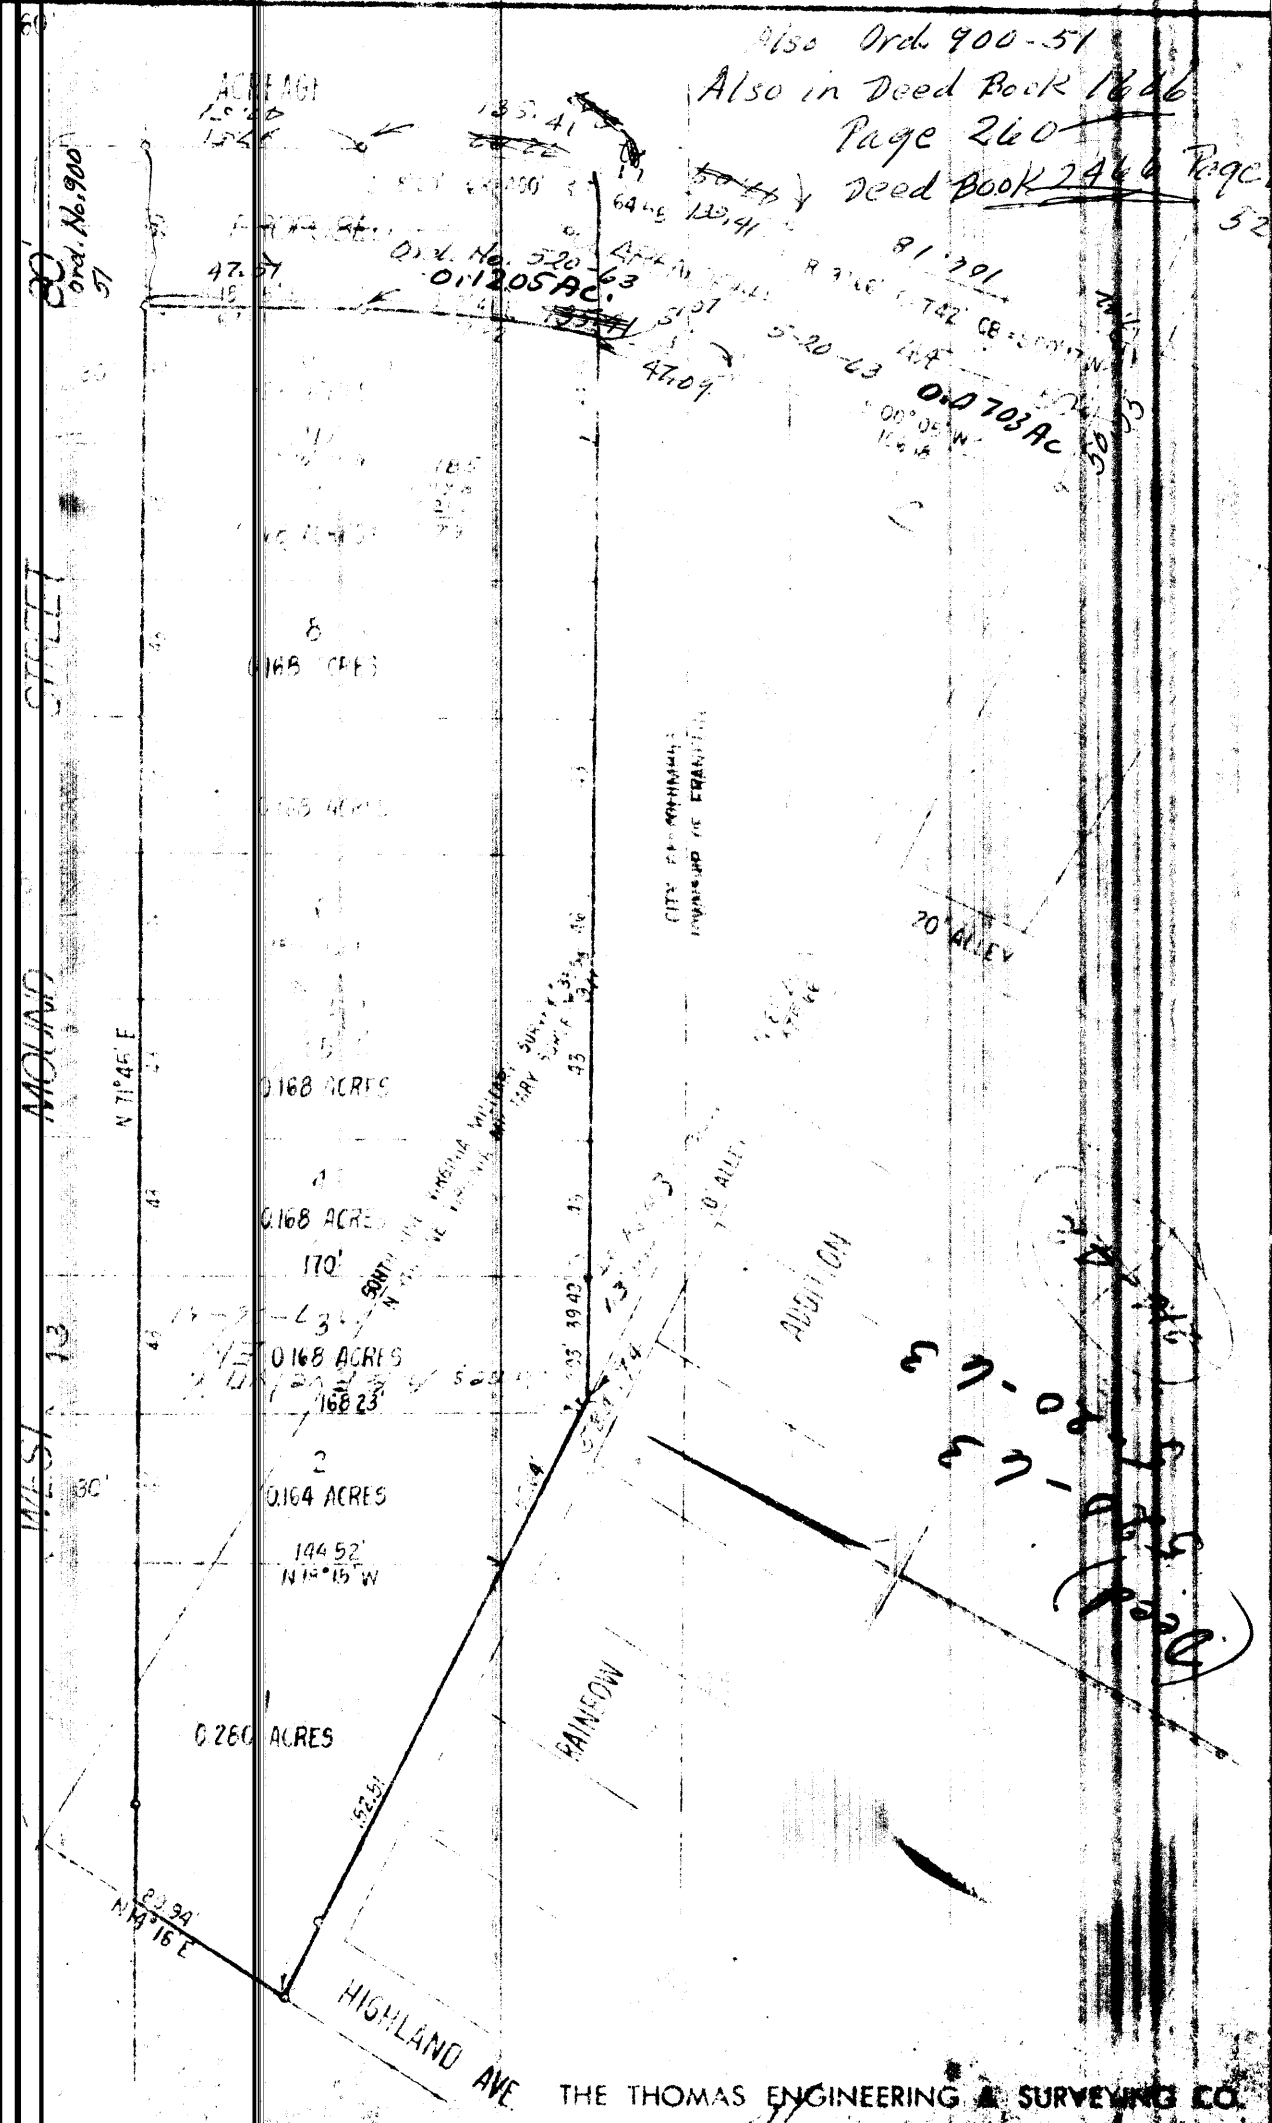

Pool Original
M-161

3150 120 1951

Pool Original

Drawn by C. H. ...

THE THOMAS ENGINEERING & SURVEYING CO.

Rayley B. White
Registered Engineer & Surveyor