

Harry L. Greene, Surveyor

2160 Tremont Center, Columbus, Ohio 43221


To: Capitol Title Agency
Home Buyers Mortgage Company

Re: Rouda

Being Lot No. 4, KIPLING PLAINS ADDITION, City of Upper Arlington
Franklin County, Ohio.

4879, 4881, 4883, 4885 Nugent Drive

PB. ~~38~~ Page ~~108~~ Recorder's Office, Franklin County, Ohio.
Scale 1" = 20' Date Dec. 29, 1986

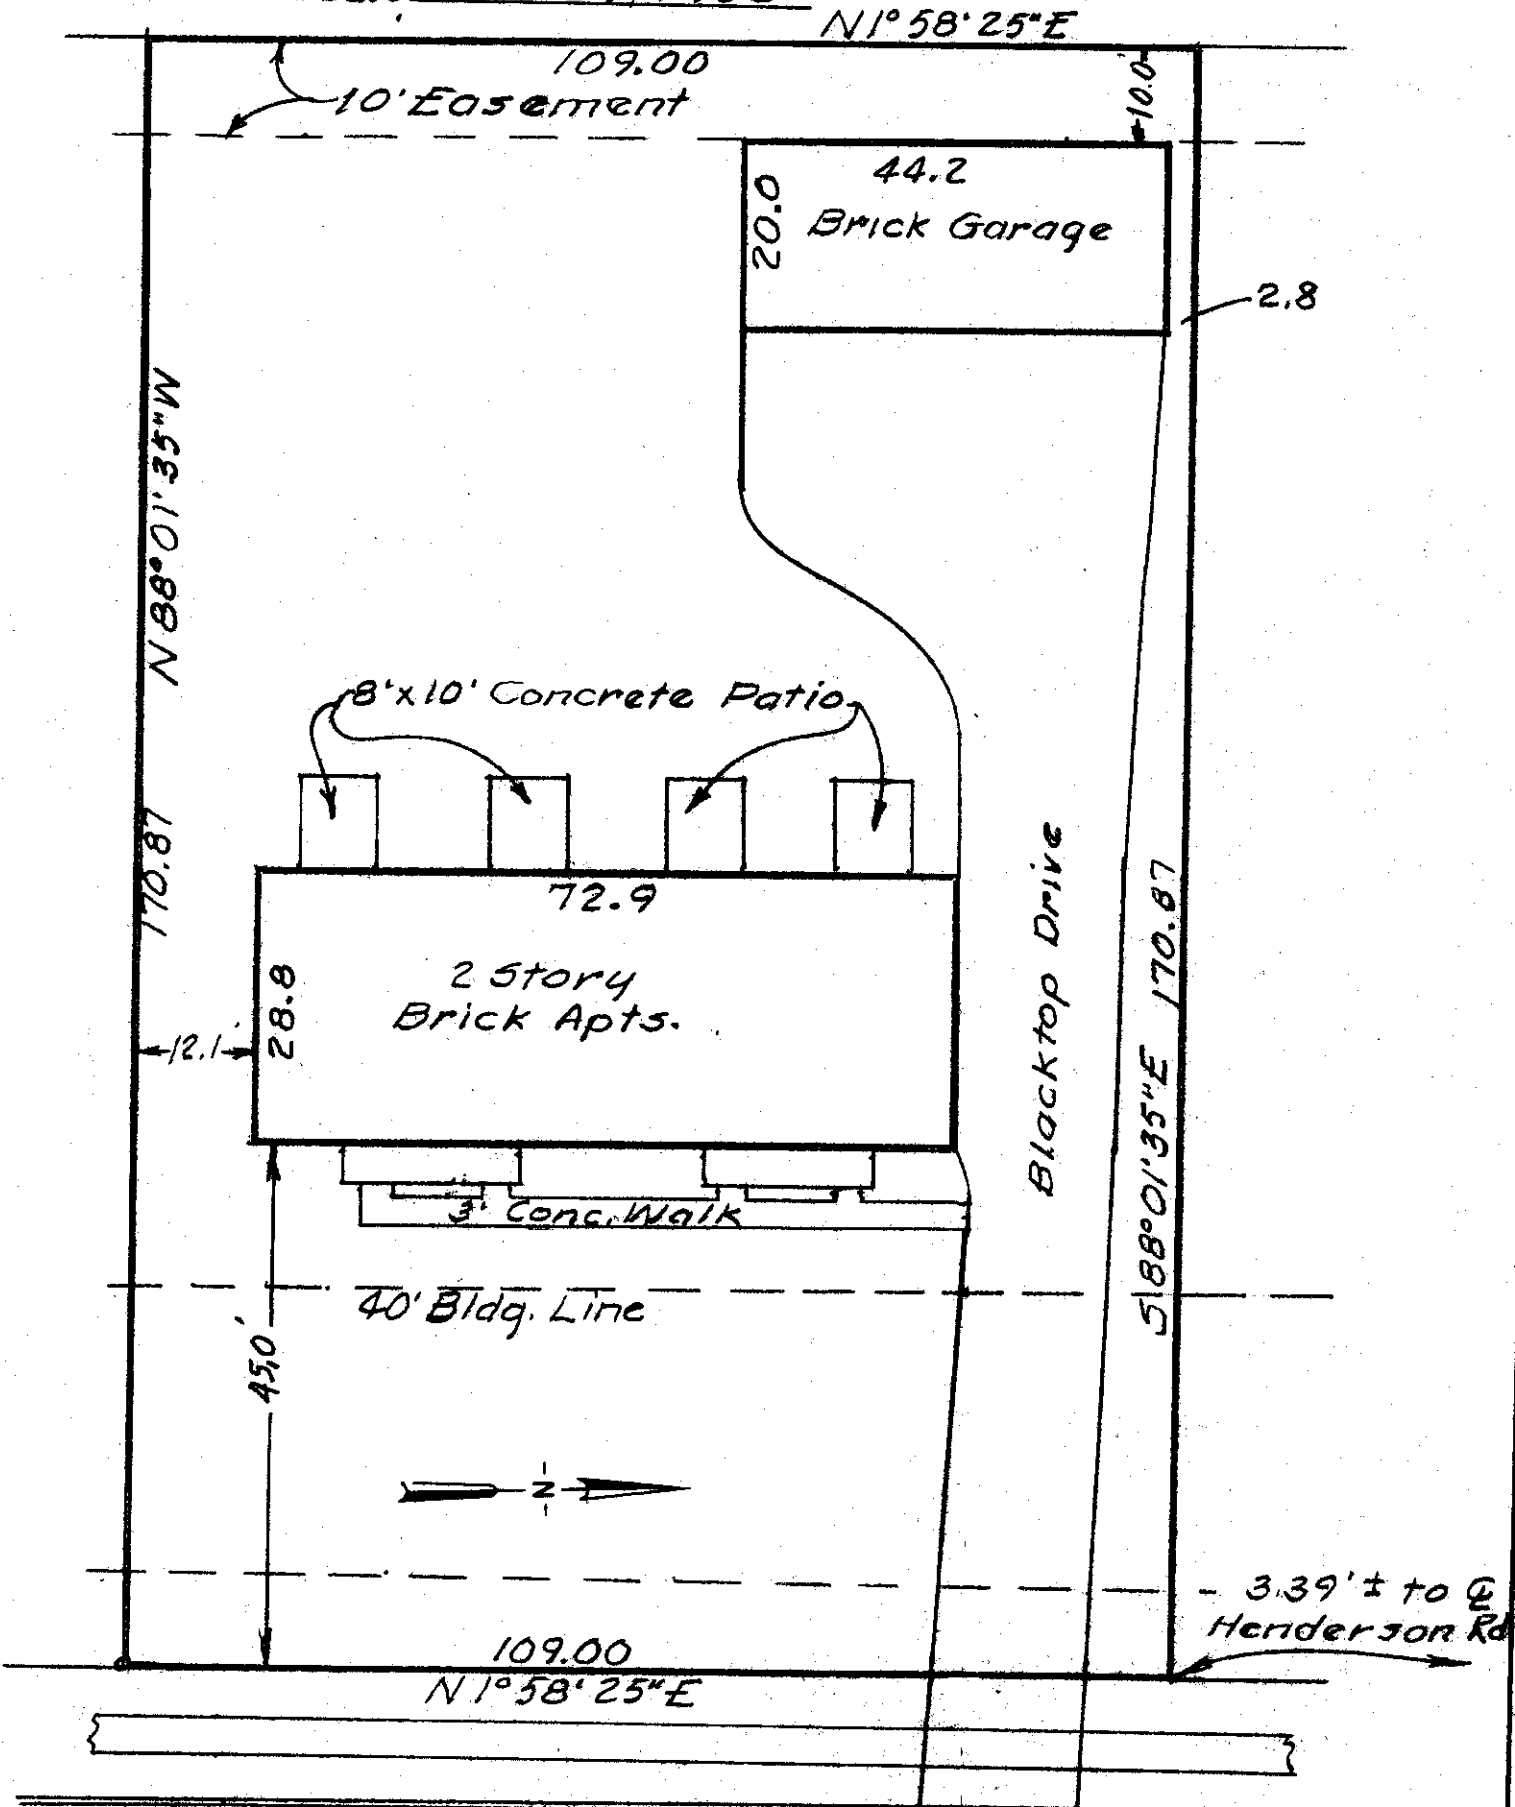

I hereby certify the above plat has been prepared from actual survey of the premises for use in mortgage loan and title purposes only. No sideline of principal building is less than dimension shown. Property corners not located unless shown thus -o-.

NUGENT DRIVE 60'

Harry L. Greene
Harry L. Greene, Registered Surveyor, No. 4058