


Harry L. Greene, Surveyor

2160 Tremont Center, Columbus, Ohio 43221

Plat showing As Built Survey of Lot Nos. 23, 24 & 25 of Block No. 1 of Indianola Summit Addition

For: Citizens Federal Savings & Loan Assoc. and Ohio Bar Title Insurance Co.

PB. 5 Page 140 Recorders Office, Franklin County, Ohio.
Scale 1" = 30' Date January 24, 1986

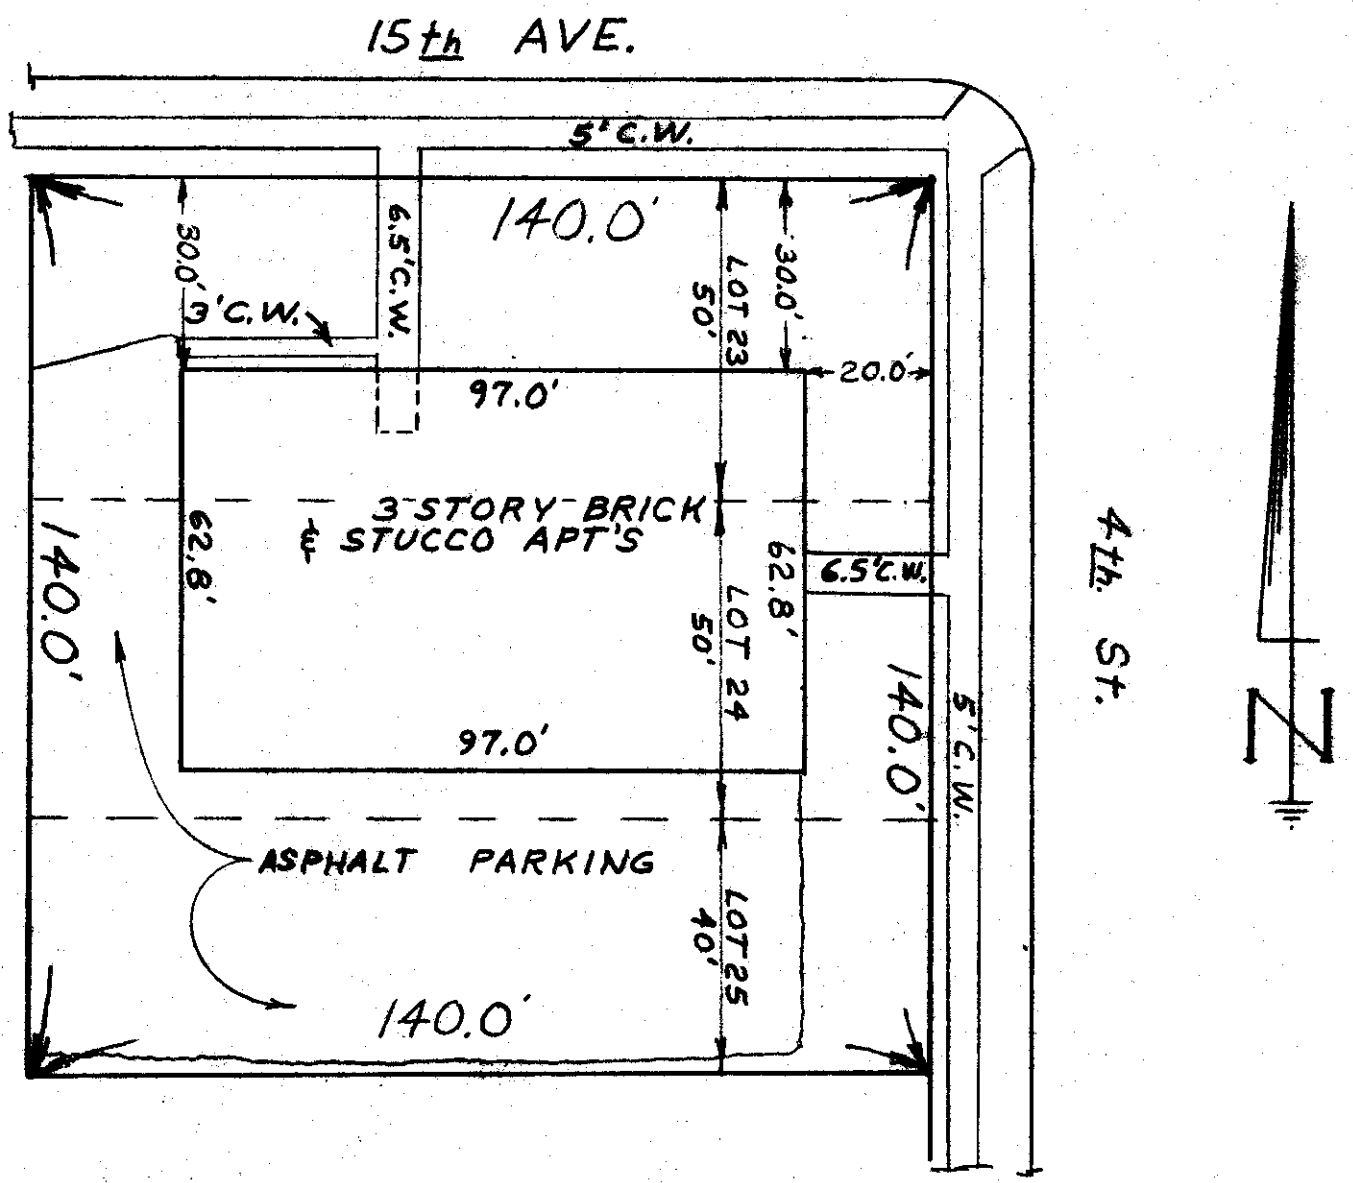

I hereby certify the above plat has been prepared from actual survey of the premises for use in mortgage loan and title purposes only. No sideline of principal building is less than dimension shown. Property corners not located unless shown thus -o-.

Harry L. Greene
Harry L. Greene, Registered Surveyor, No. 4058