

Harry L. Greene, Surveyor


2160 Tremont Center, Columbus, Ohio 43221

PLAT SHOWING AS BUILT SURVEY FOR LOT NO. 18, BLOCK 320,
SHELBOURNE HEIGHTS, CITY OF UPPER ARLINGTON, OHIO.

For: Sullivan Builders.

2764 Lymington Road.

PB. 29 Page 49 Recorders Office, Franklin County, Ohio.
Scale 1" = 20' Date November 7, 1989

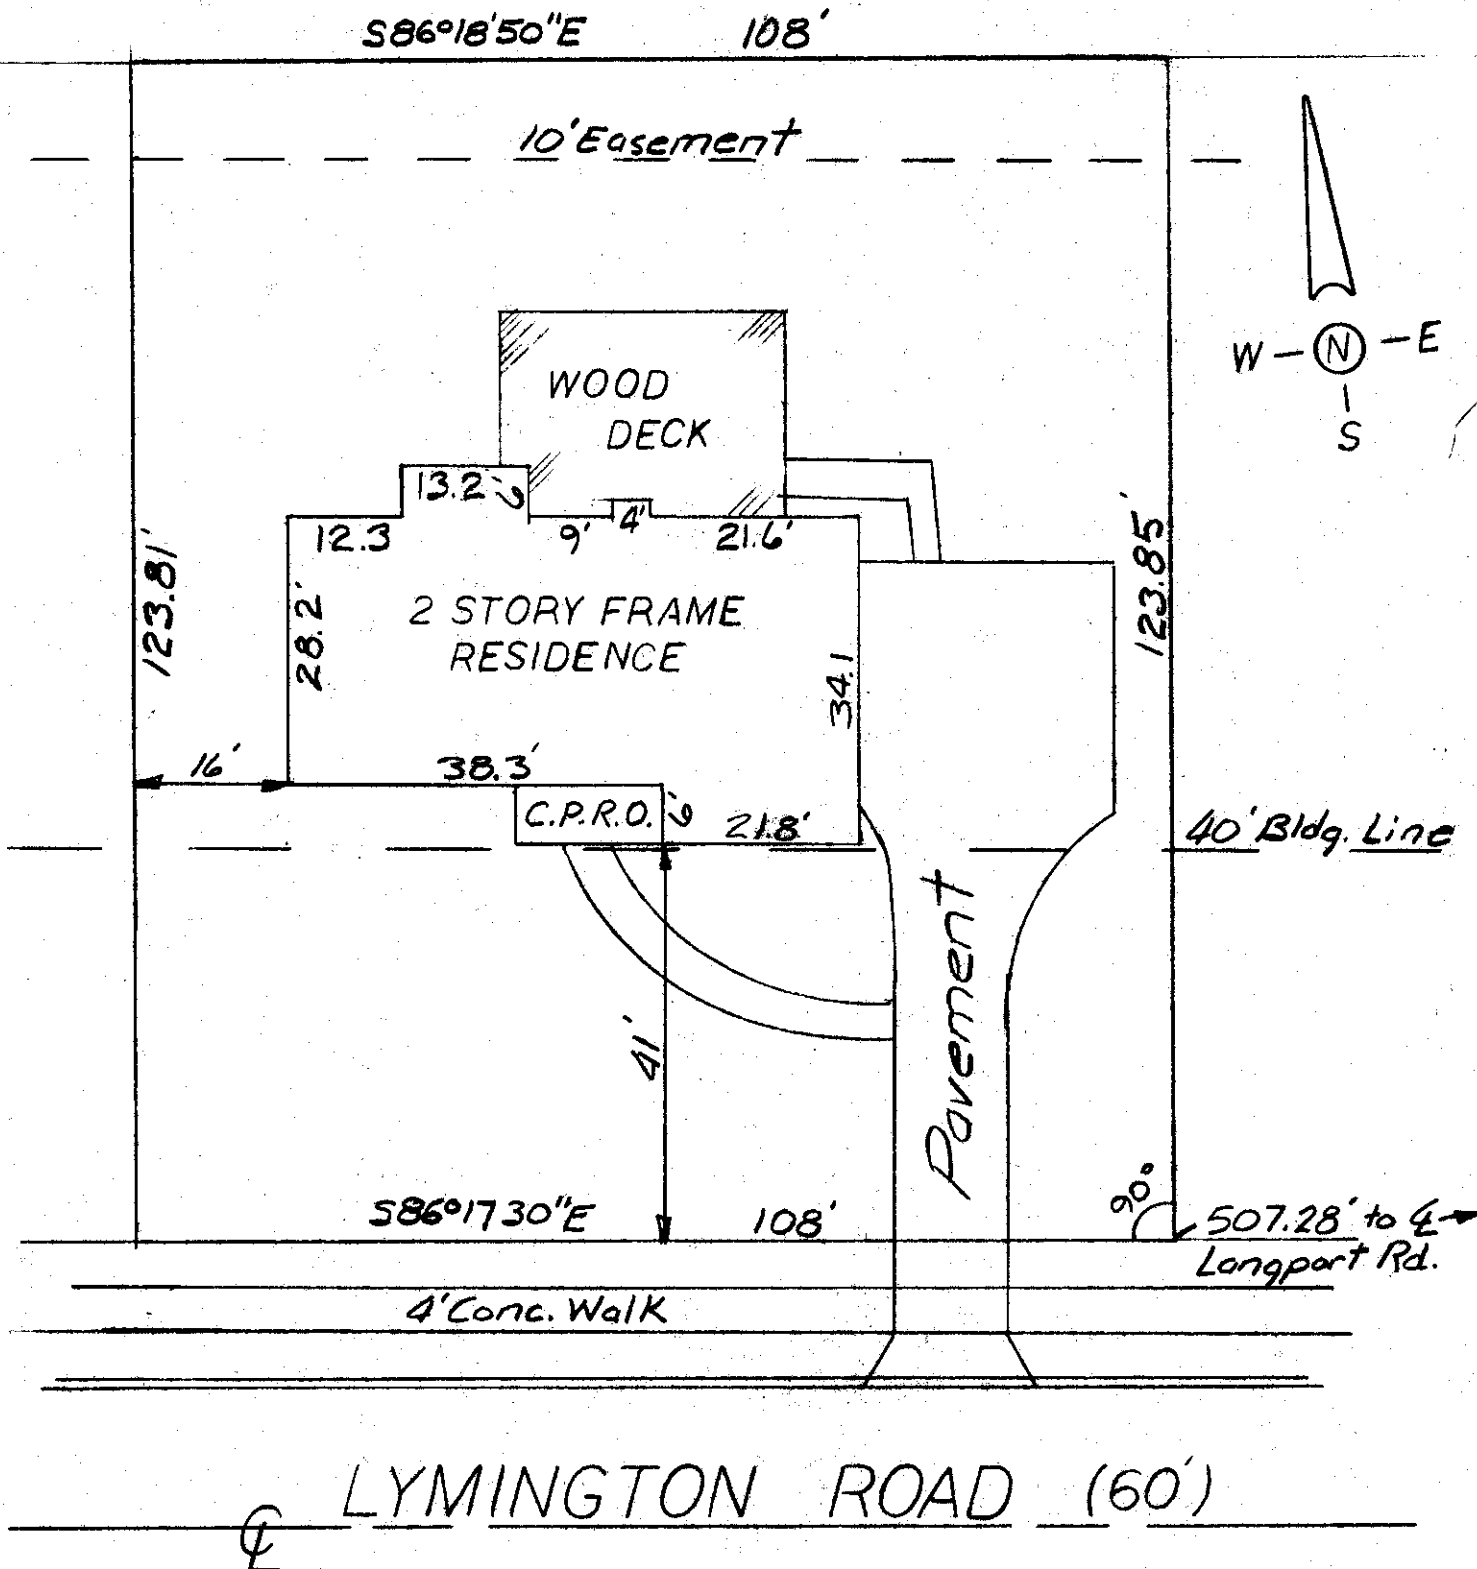

I hereby certify the above plat has been prepared from actual survey of the premises for use in mortgage loan and title purposes only. No sideline of principal building is less than dimension shown. Property corners not located unless shown thus -o-.

Harry L. Greene
Harry L. Greene, Registered Surveyor, No. 4058