


Harry L. Greene, Surveyor

2160 Tremont Center, Columbus, Ohio 43221

Plat showing asbuilt survey of Marshall residence. Being part of lot 12 block 85, City of Upper Arlington, Franklin County, Ohio.

PB. 14 Page 31 Recorders Office, Franklin County, Ohio.
 Scale 1" = 20' Date June 19, 1989

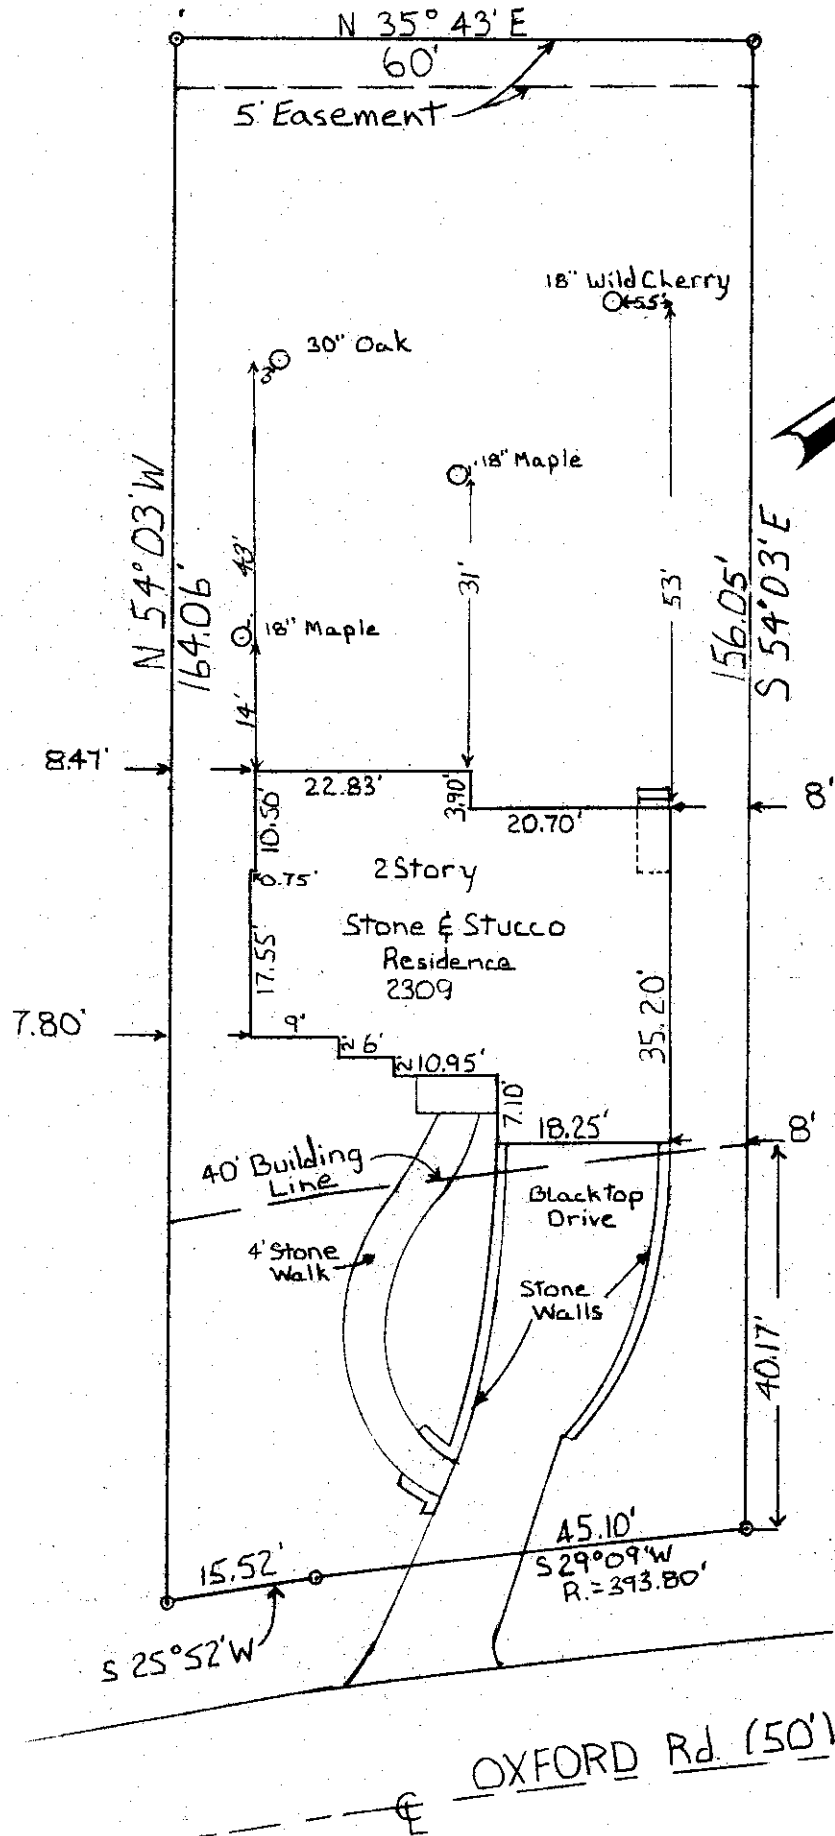

OXFORD Rd. (50')

I hereby certify the above plat has been prepared from actual survey of the premises

Harry L. Greene
 Harry L. Greene, Registered Surveyor, No. 4058