


AS-BUILT SURVEY OF ALUM CREEK PLAZA for BUCKEYE FEDERAL SAVINGS AND LOAN

HERBERT C. HUBER PLAT BOOK 57 PAGE 52

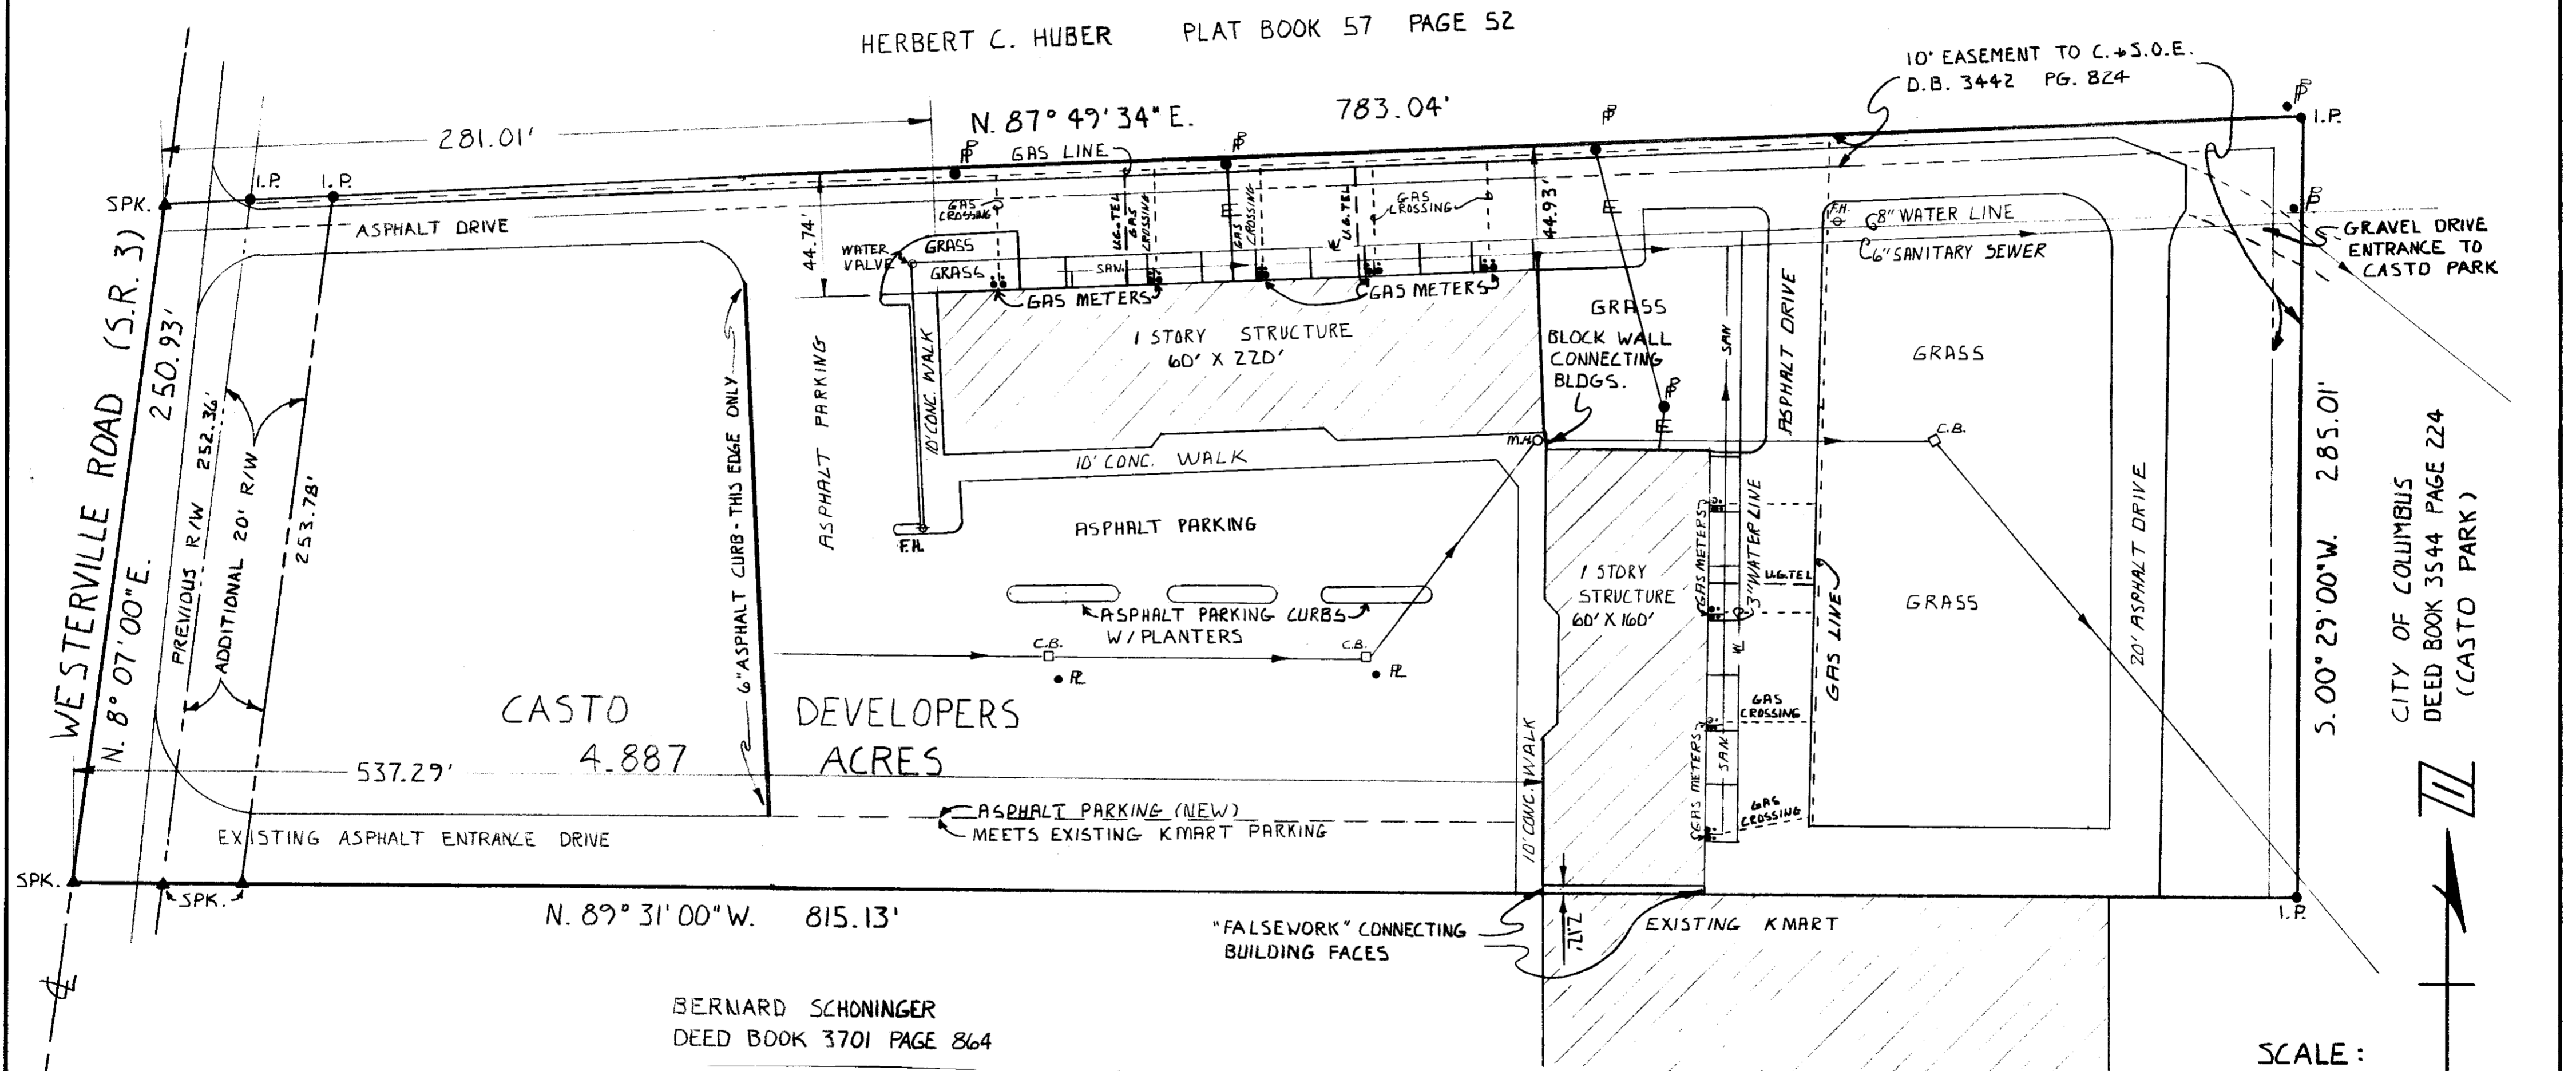

CASTO
4.887
DEVELOPERS
ACRES

BERNARD SCHONINGER
DEED BOOK 3701 PAGE 864

NOT
REVIEWED

SITUATED IN SECTION 2, T2N,
R17W, UNITED STATES MILITARY
LANDS, FRANKLIN COUNTY, OHIO, AND
BEING 4.887 ACRES CONVEYED TO
JAMES D. CASTO BY DEED OF RECORD IN
O.R. 01439-H-16 FRANKLIN COUNTY RE-
CORDER'S OFFICE.

TO ALL PERSONS INTERESTED IN THE TITLE TO THE PREMISES
SHOWN ON THIS PLOT PLAN:

I HEREBY CERTIFY THAT I PERSONALLY MADE AN ACTUAL SURVEY
OF THE PREMISES SHOWN ON THIS PLOT PLAN ON THE 29th DAY
OF Sept., 1986; THAT THIS PLOT PLAN IS A CORRECT
REPRESENTATION OF THE PREMISES AS DETERMINED BY SAID
SURVEY. I FURTHER CERTIFY THAT THERE ARE NO ENCROACHMENTS
OTHER WAY ACROSS ANY BOUNDARY LINE OF THE PREMISES EXCEPT
AS SHOWN HEREIN.


SIGNED AT REYNOLDSBURG, OHIO, THIS 2nd DAY OF Oct., 1986.

Paul K. Moore
PAUL K. MOORE
REGISTERED SURVEYOR NO. 5885

PAUL K. MOORE + ASSOC.
6515 E. LIVINGSTON AVE. - SUITE 11
REYNOLDSBURG OHIO 43068

AS-BUILT SURVEY OF ALUM CREEK
PLAZA FOR BUCKEYE FEDERAL S+B L.

SCALE 1" = 40'	REVISIONS	BY	DATE
DATE 10-2-86			
DR'N J.W.	CR'D VPL		
TITLE		NO. 8610-34	

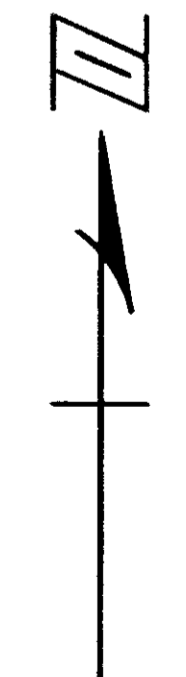

SCALE:
1" = 40'