


- F.P.P. Found Pinch-pipe (boundary)
- ground elevation
- top of creek bank
- ⊗ deciduous tree
- ⊗ pine tree
- ⊠ concrete patio stones
- ⊕ bushes
- wood power pole

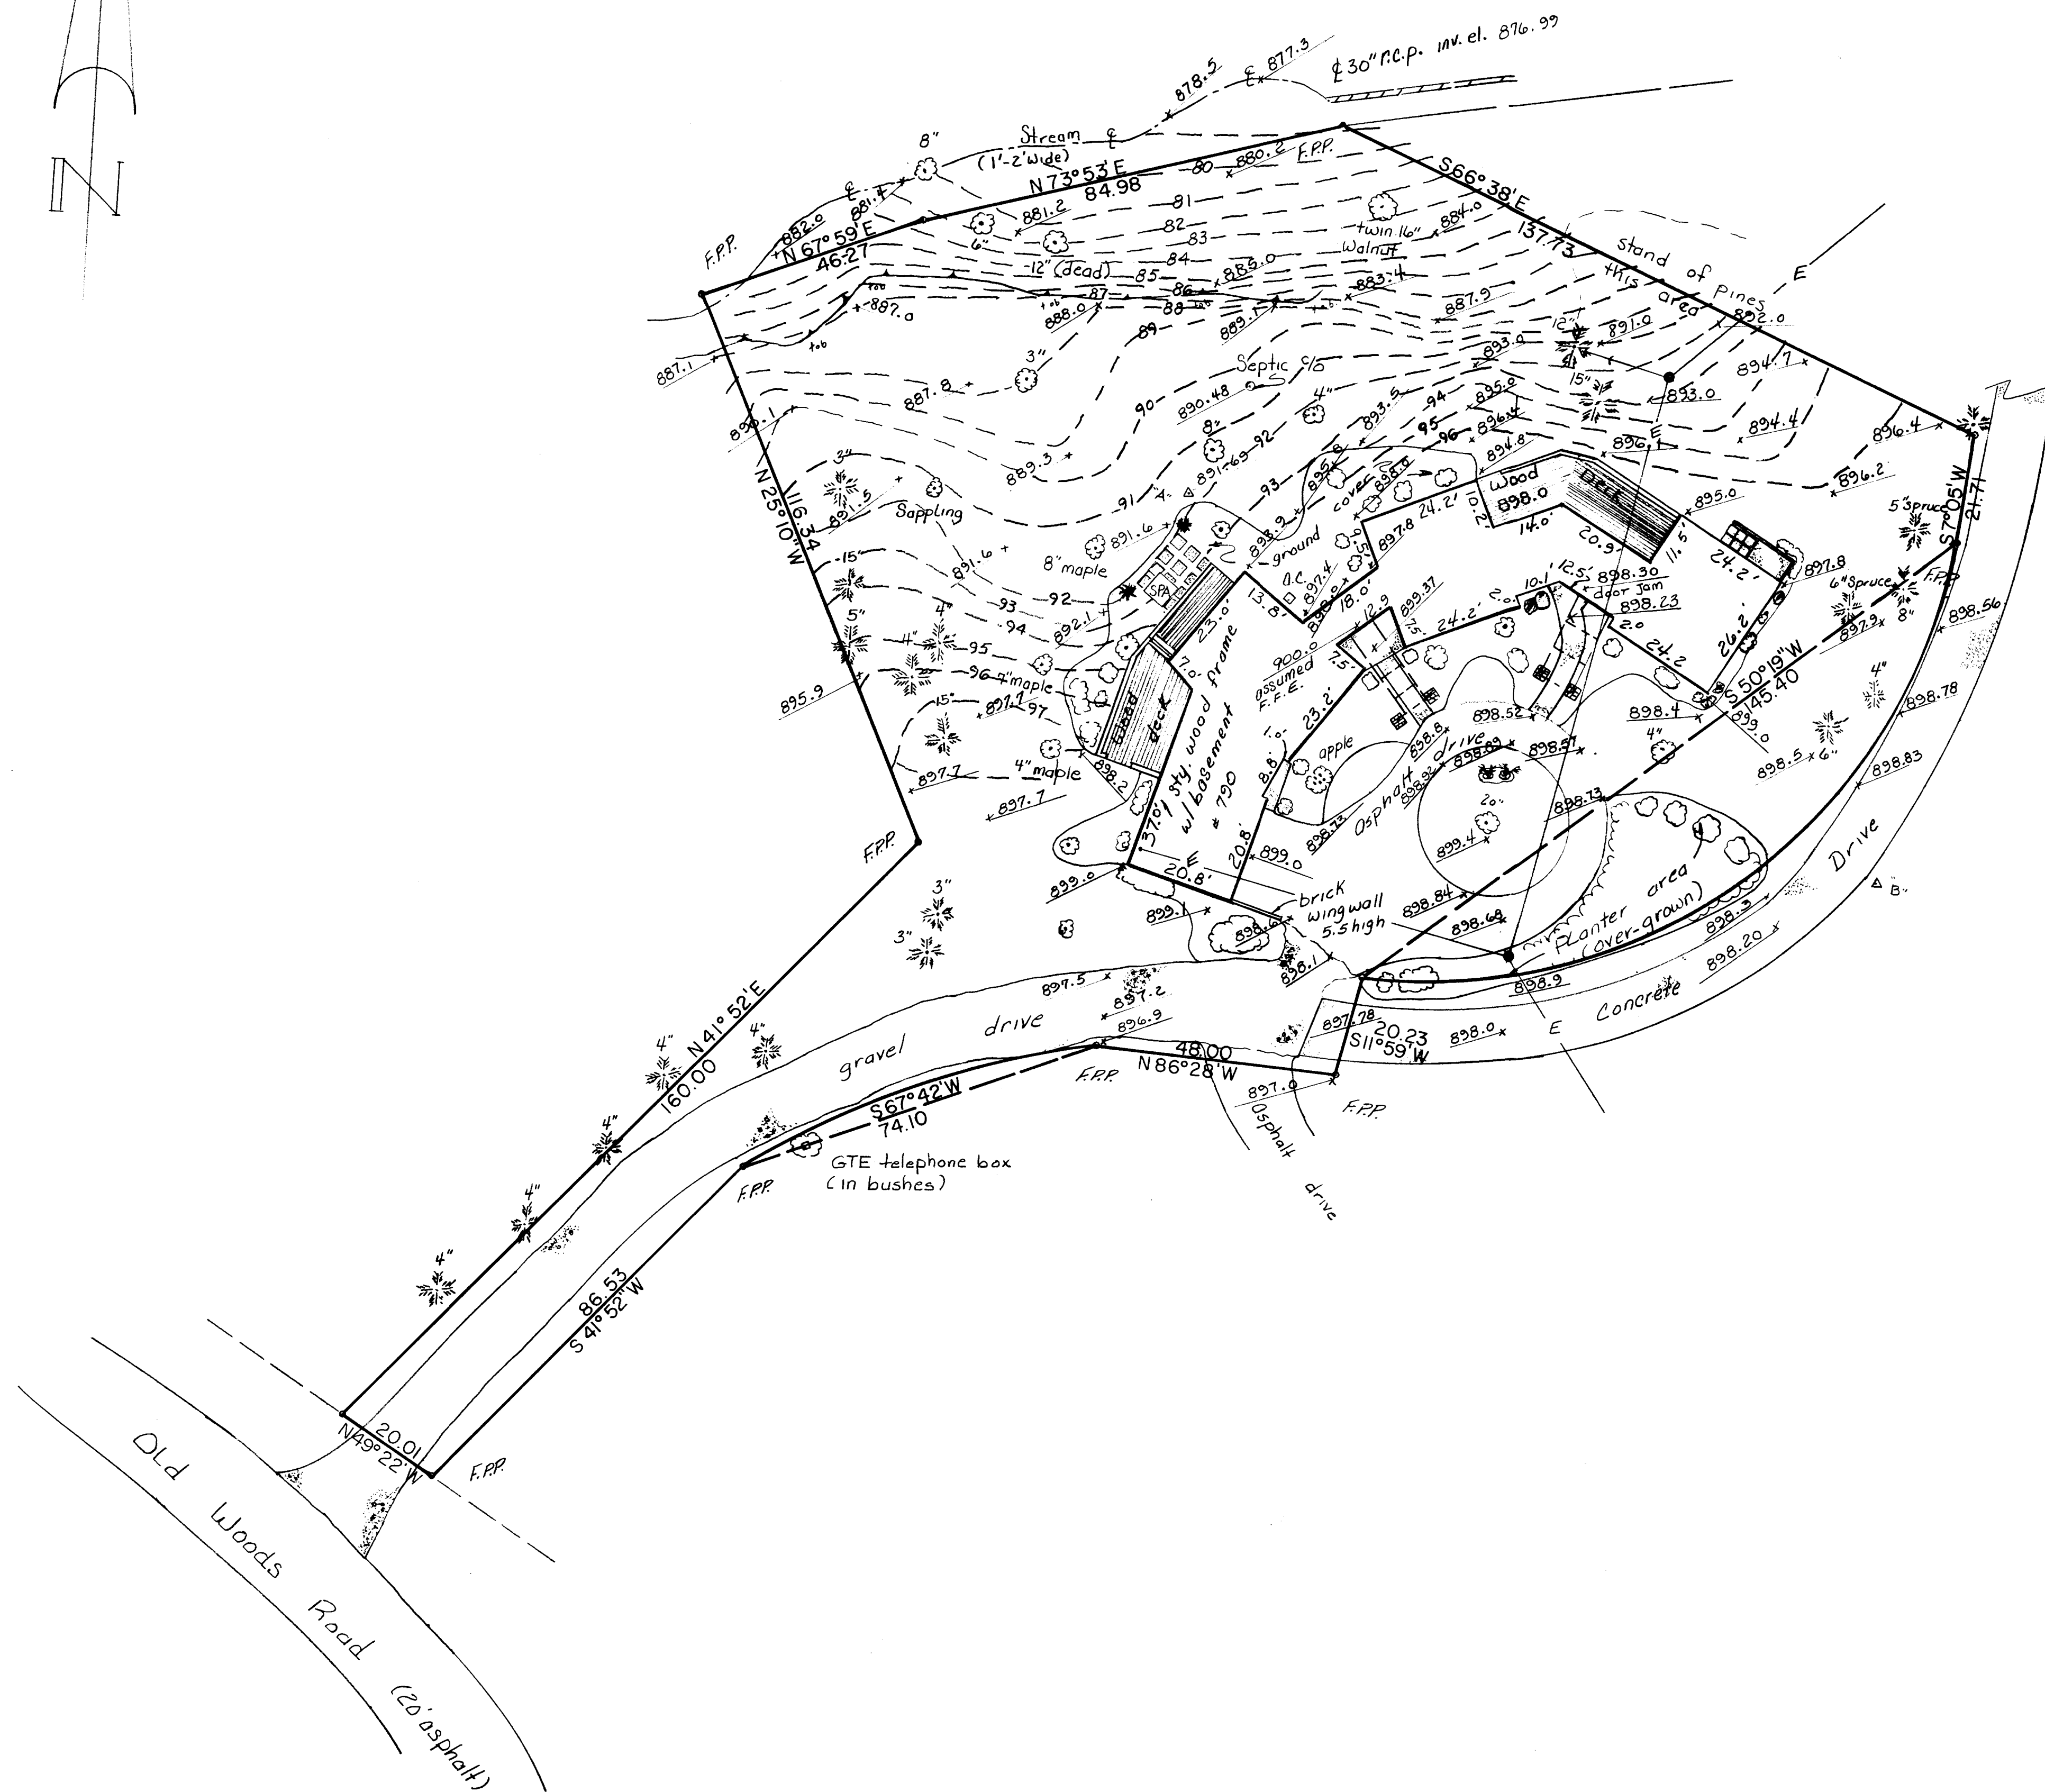

Plot showing Architectural As-built survey of
 790 Old Woods Road. Premises containing 0.803
 Acres. Worthington, Ohio

For: Kinman & Associates

Scale 1" = 20'

August 24 - 1988

Harry L. Greene
 Harry L. Greene Reg. Surveyor # 4058