
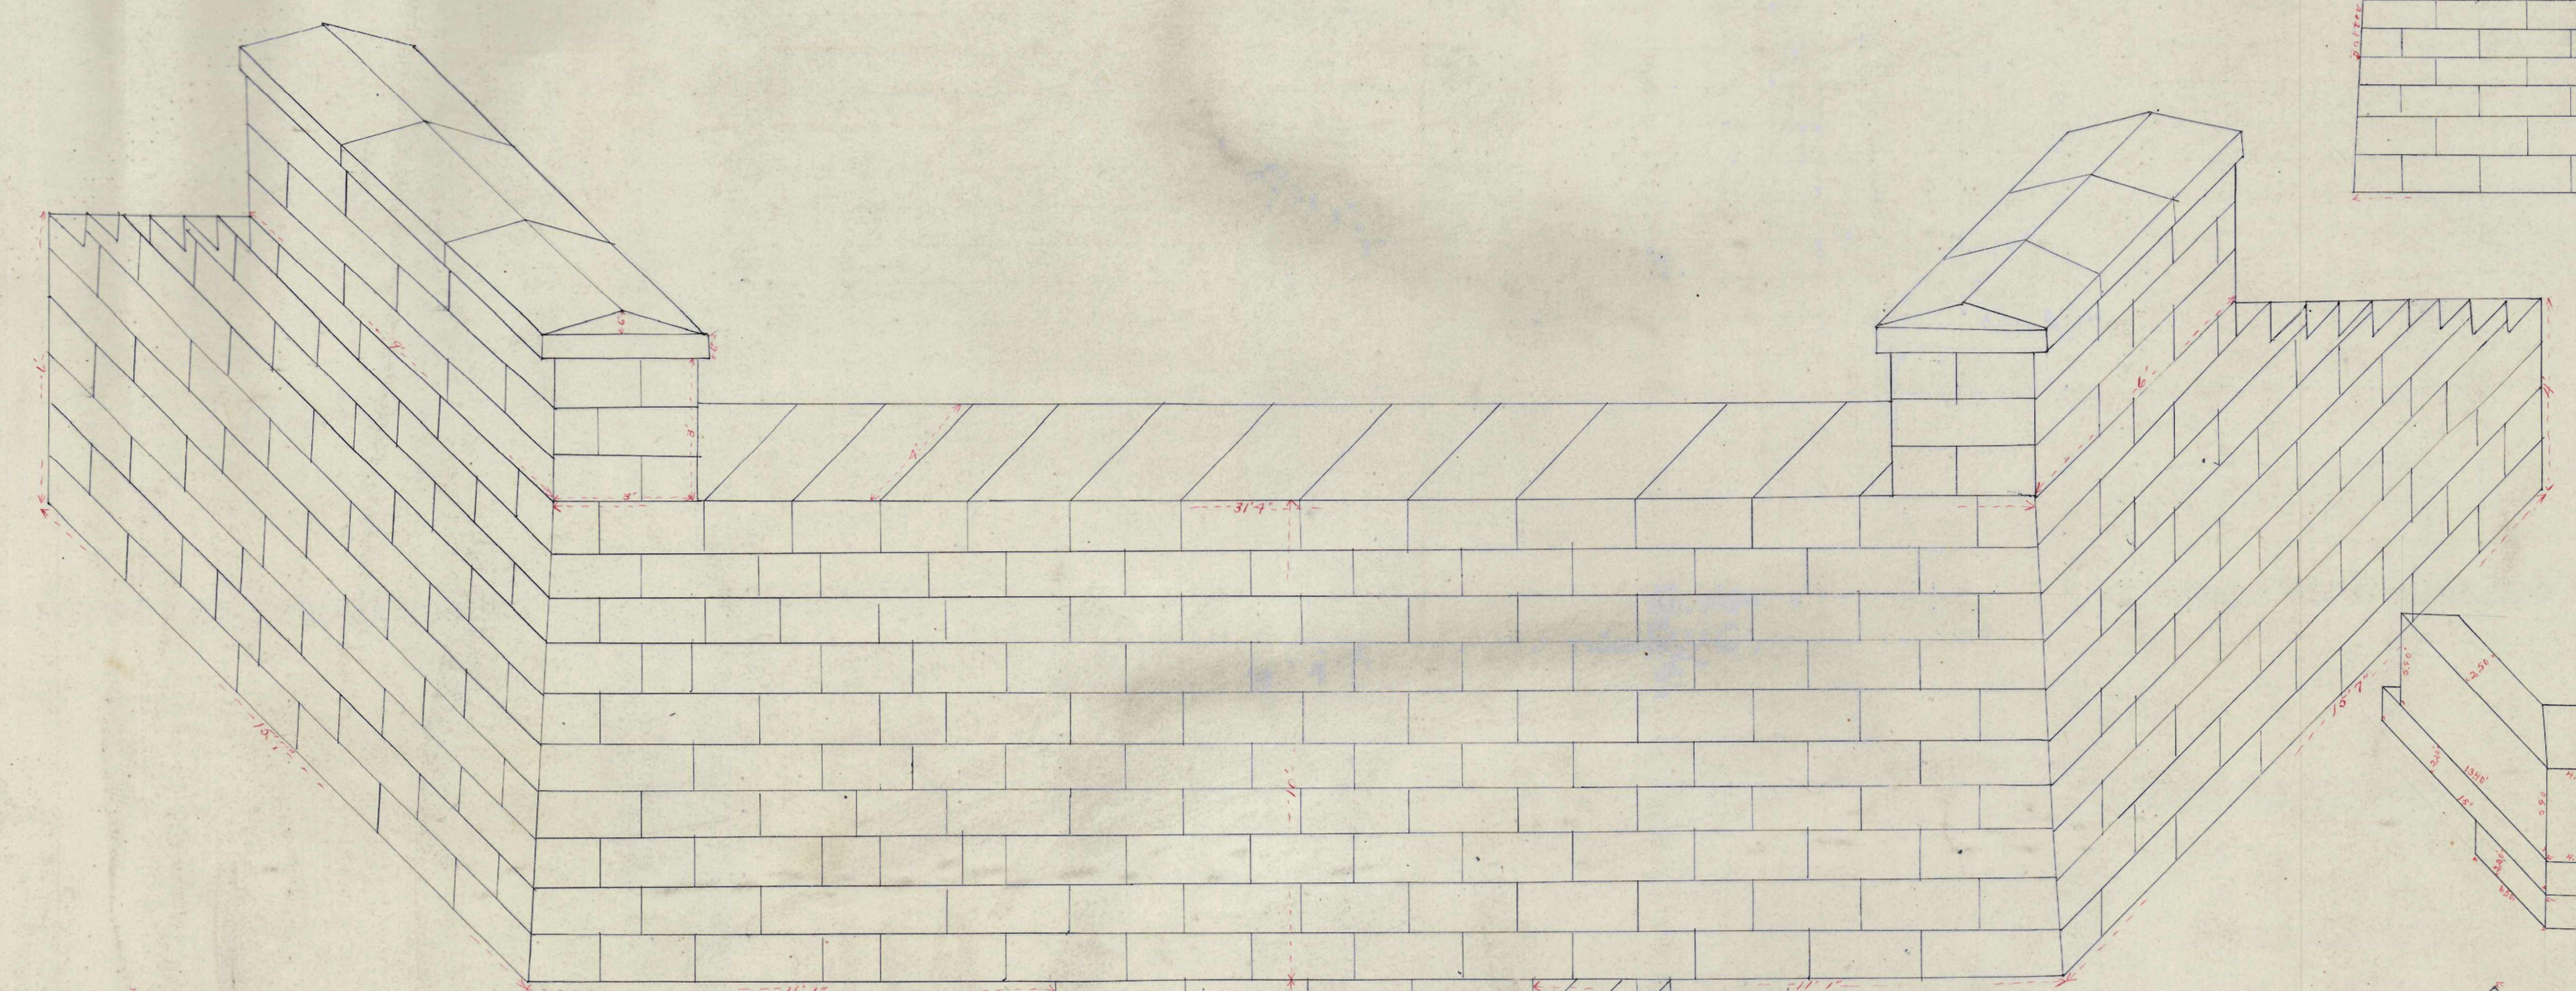


Plan of Masonry
South Abutment and
Wing Walls

→ DEHNER BRIDGE ←
INDEX

West Wing Wall
North Abutment

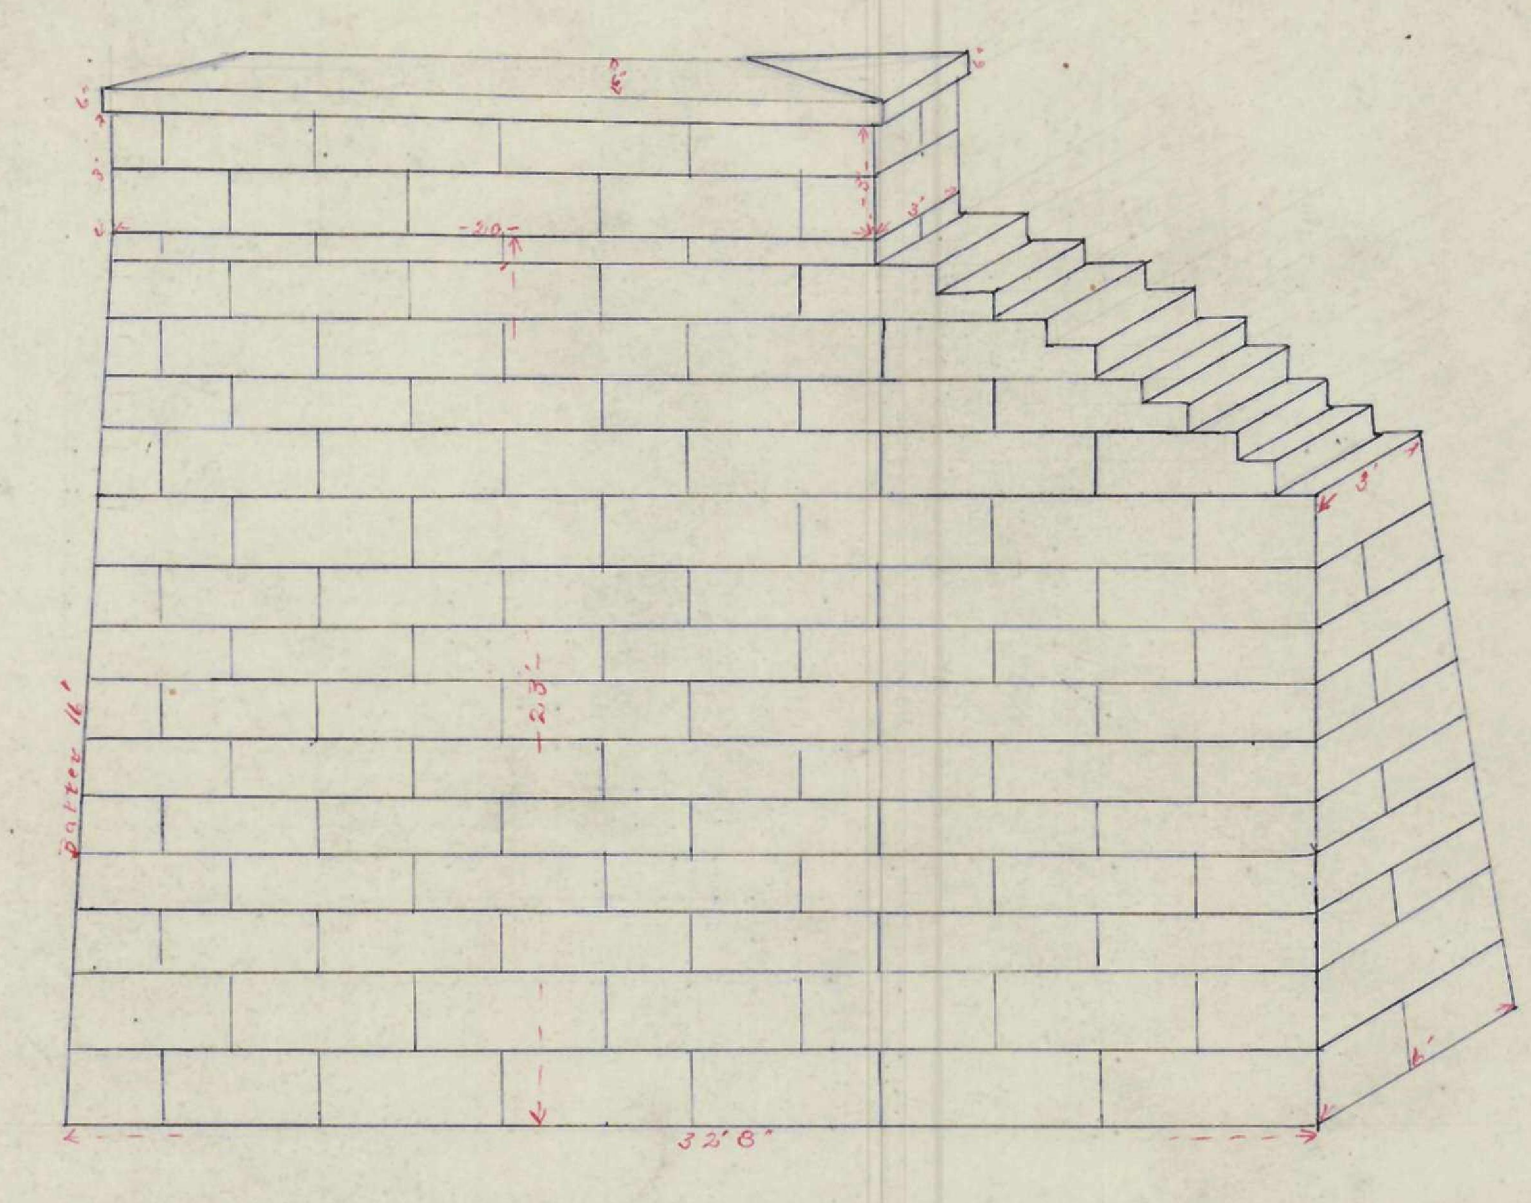

Plan of Masonry
South Abutment and
Wing Walls of
DEHNER BRIDGE
As Built

