

FRANKLIN COUNTY
C.R. 25 WILSON RD.




PROPOSED BRIDGE DATA

TYPE: Continuous Steel Beam Bridge
w/ Concrete Deck & Substructure
SPANS: 50'-0", 72'-6", 50'-0"
ROADWAY: 42'-4" 1/2 of Parapets
LOAD FREQUENCY: C.F. 2000 (57)
SKEW: 37° 59' 16" R.F.
WEARING SURFACE: 1" Monolithic
APPROACH SLABS: AS-1-54 (25' lg)
RAILING: Bridge Railing, Type 1
SUPERELEVATION: 0.049 ft
ALIGNMENT: 3° 00' 00" Simple Curve

1982 A.D.T. = 6,300

CURVE DATA
P.I. Sta. = 43+59.82
Δ = 16° 13' 42"
Dc = 3° 00' 00"
R = 1909.86'
T = 273.71'
Lc = 543.72'
E = 19.51'

DITCH DETAIL SECT. A-A

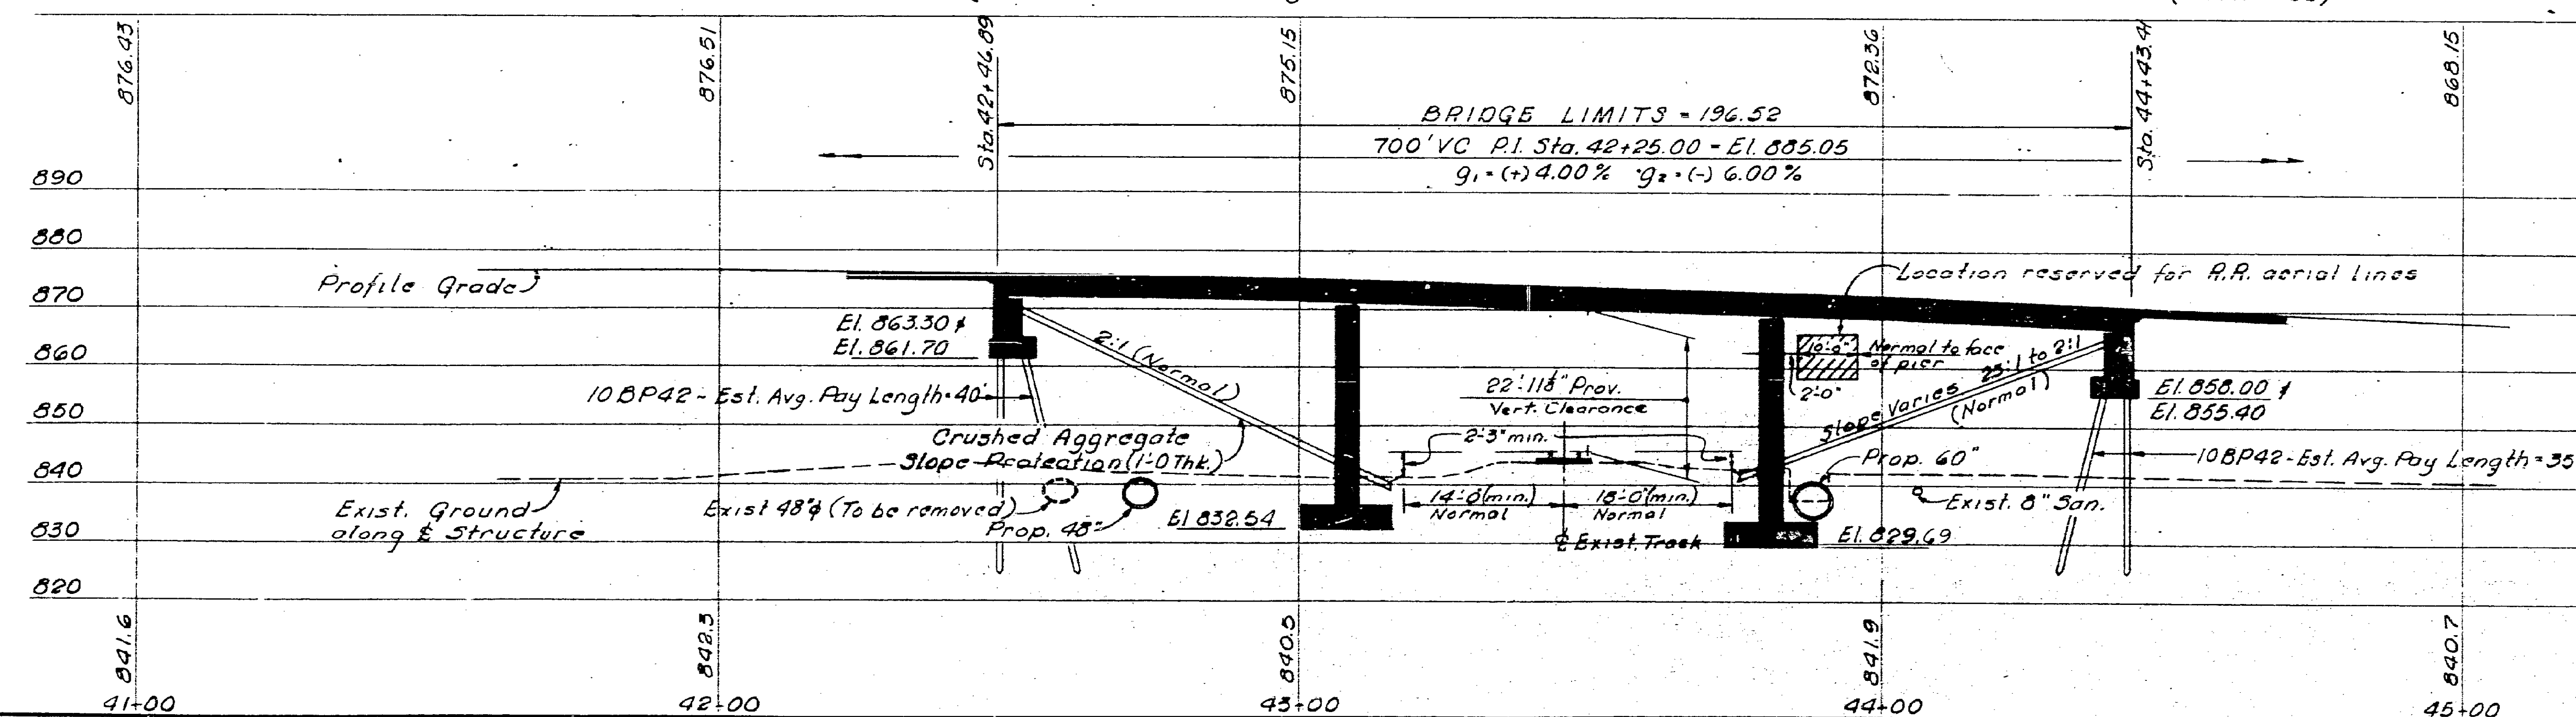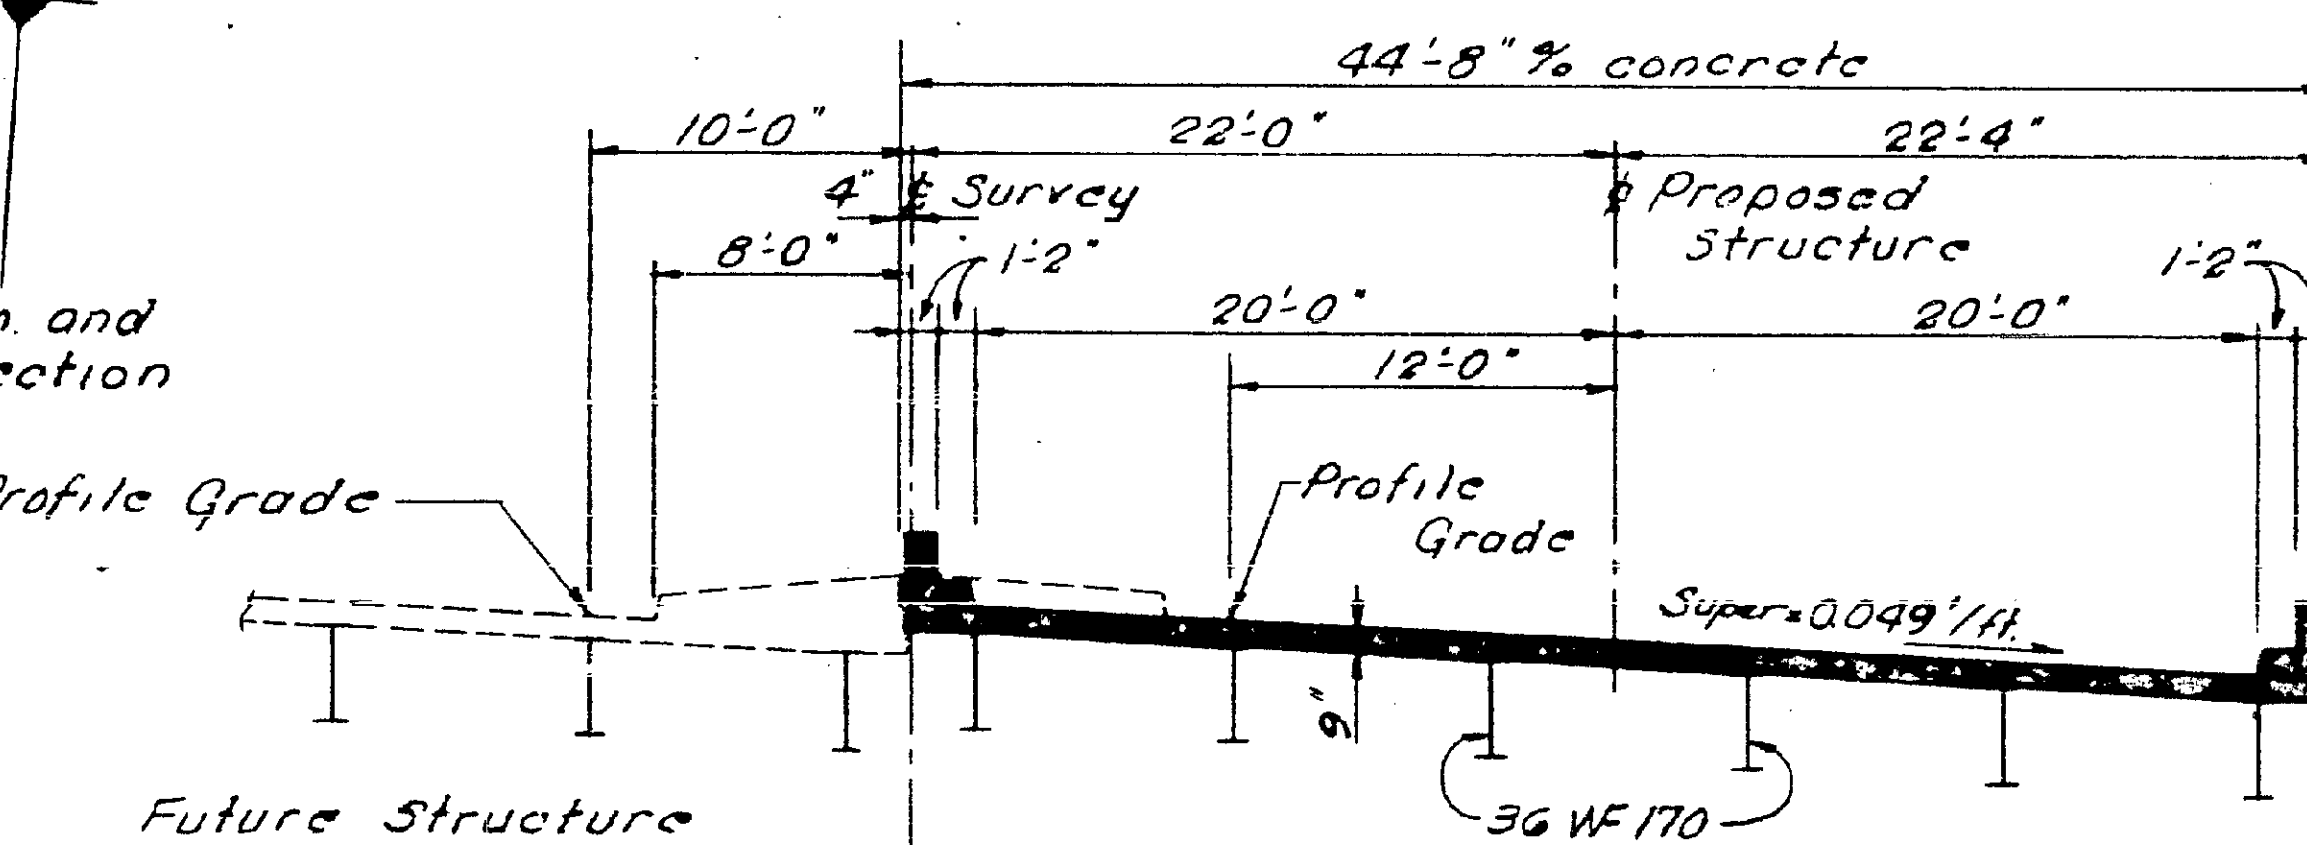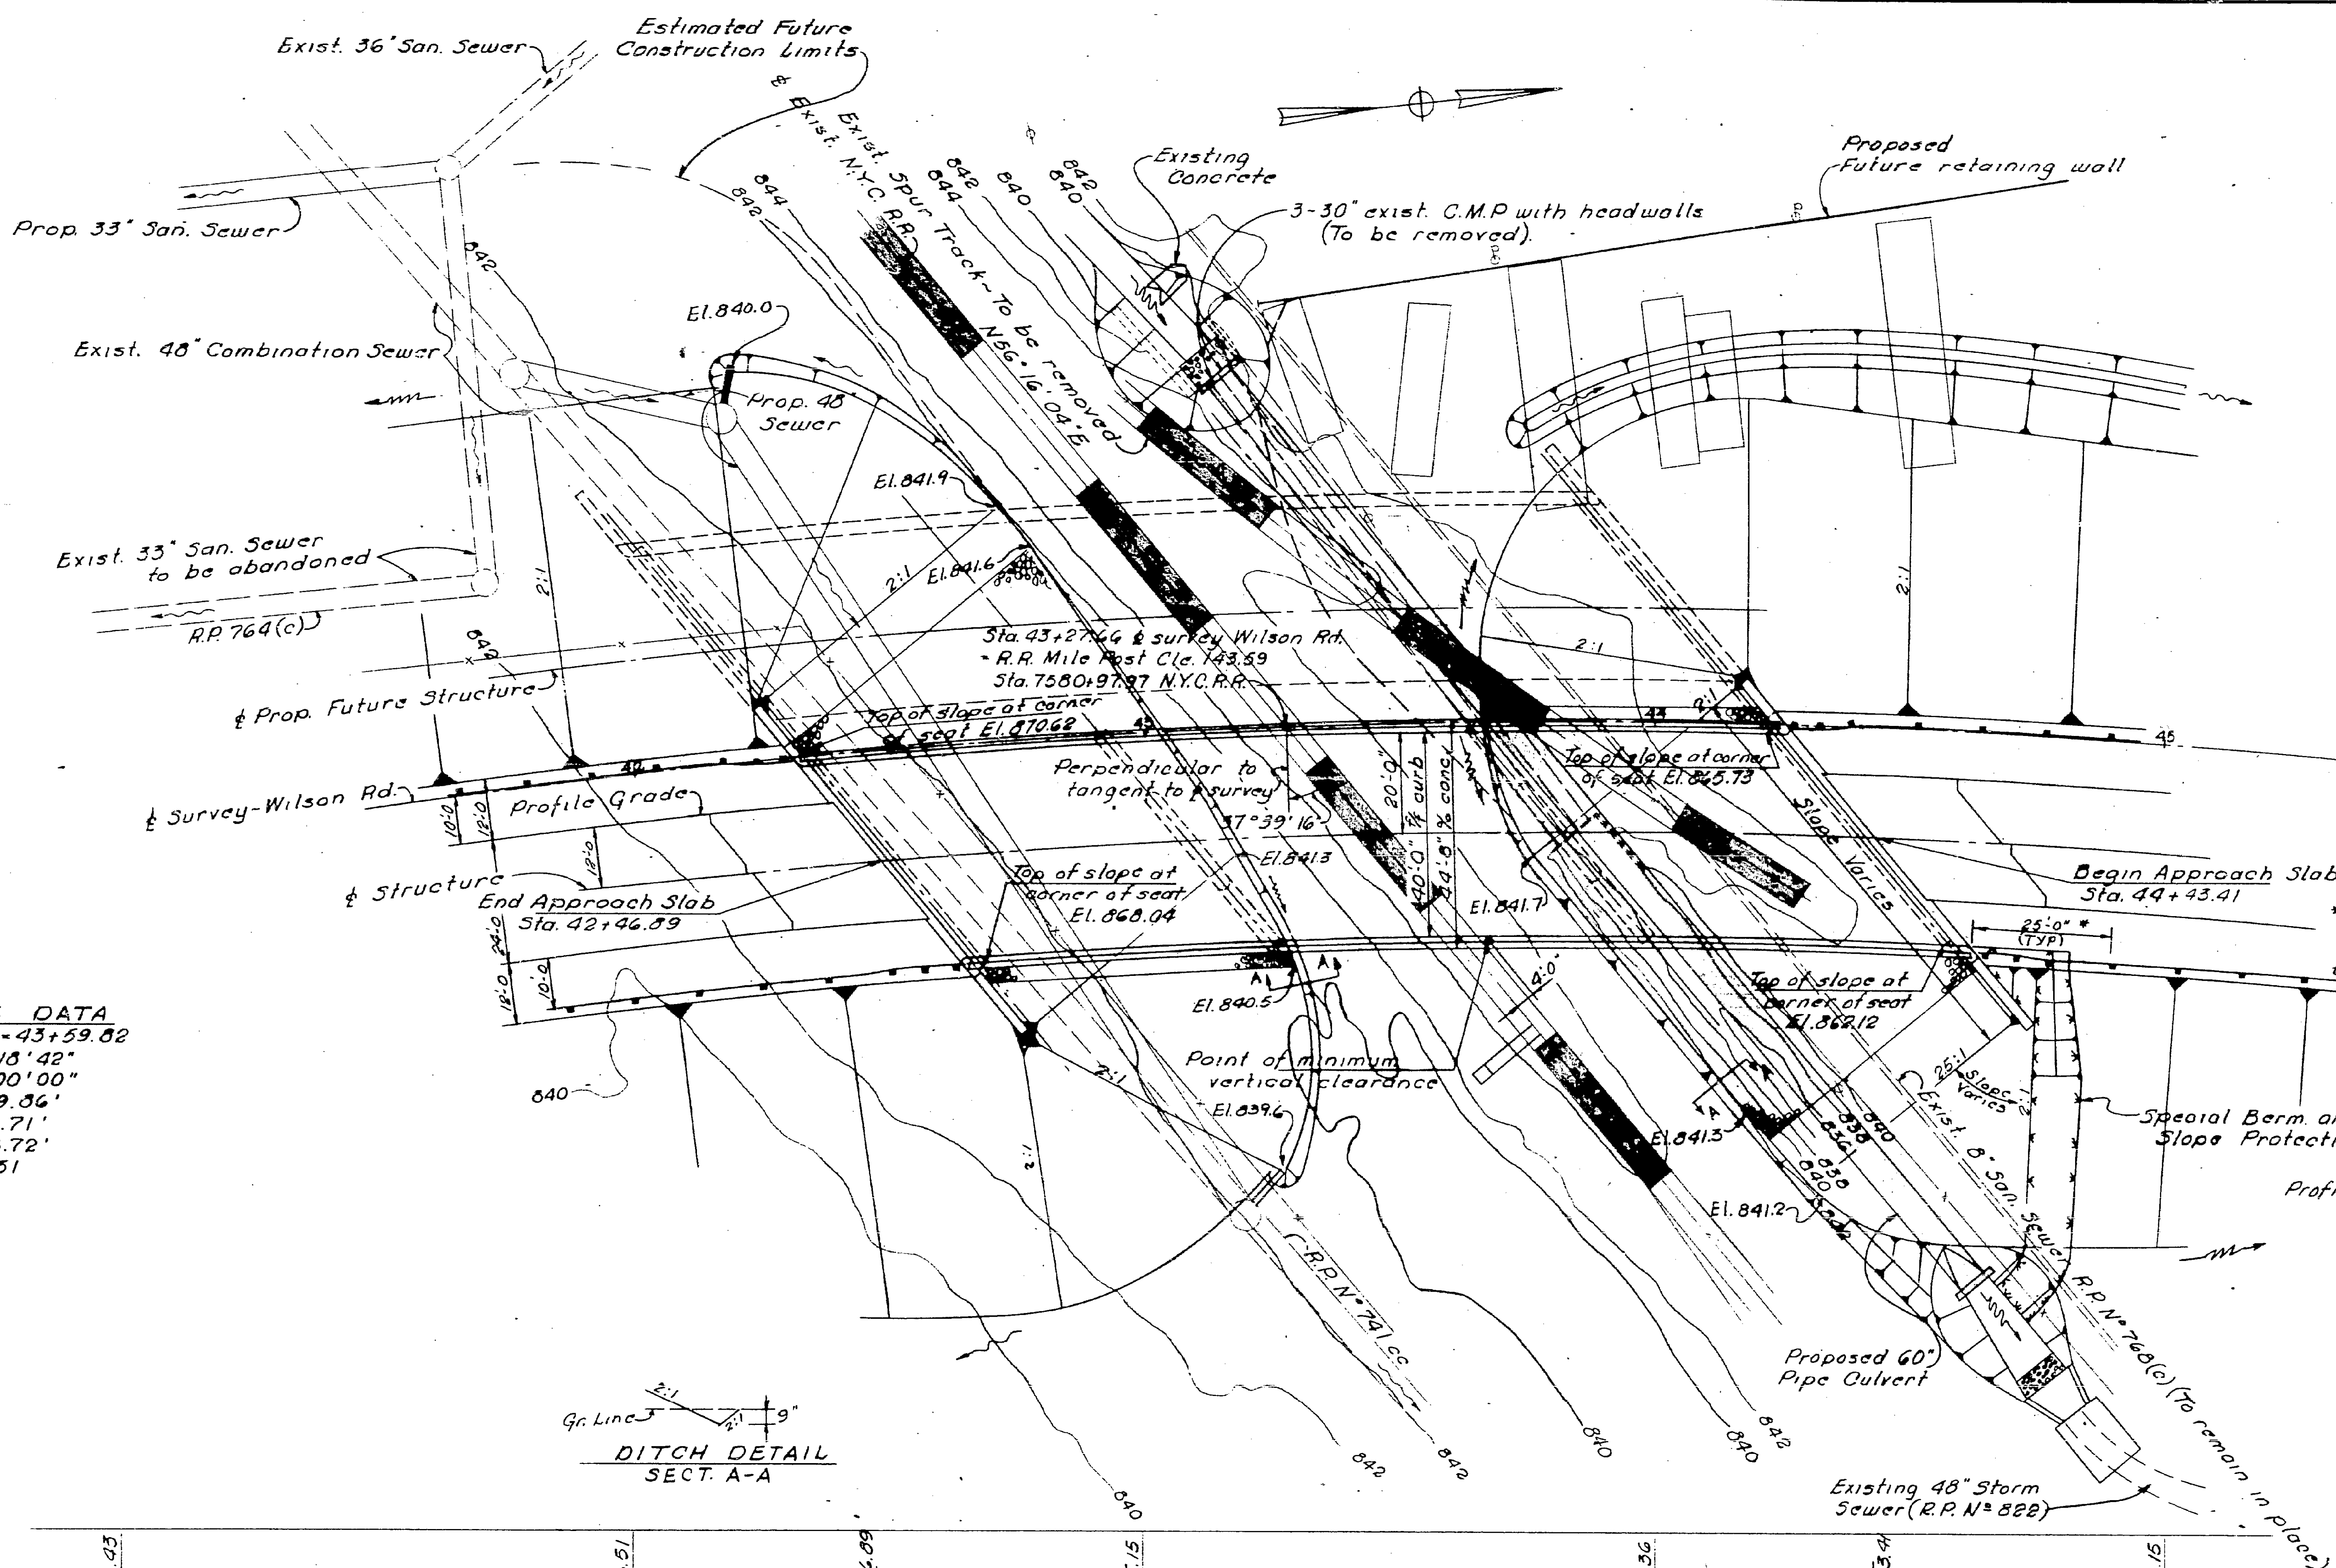

BENCH MARK
Spike in pole, S.E. corner of garage,
195' lt. Sta. 42+55 El. 844.02

BENCH MARK
Chiseled "a" on S.W. corner of conc.
manhole cover, 214' rt. Sta. 44+23 El. 842.08

BARRETT ASSOCIATED ENGINEERS, LIMITED
1500 W. FIRST AVE. COLUMBUS 12, OHIO

SITE PLAN WILSON RD OVER NYC.R.R.

Franklin County
Sta. 42+46.89 to Sta. 44+43.41

DESIGNED	DRAWN	TRACED	CHECKED	REVIEWED	DATE	REVISED
D.L.M.	K.J.B.		D.L.M.			

Fr 25-0.63
3-3-2
Wilson Rd.

GENERAL NOTES

DESIGN LOADING - CF 2000 (57)

CONCRETE CLASS C - BASIC UNIT STRESS 1,333 P.S.I.
CONCRETE CLASS E - BASIC UNIT STRESS 1,133 P.S.I.
STRUCTURAL STEEL - A.S.T.M. A36 - BASIC UNIT STRESS, 20,000 P.S.I. (A.S.T.M. A7 AND A373 STEEL NOT PERMITTED).
REINFORCING STEEL - A.S.T.M. A15, A16, A160, A408, DEFORMED, INTERMEDIATE OR HARD GRADE, BASIC UNIT STRESS 20,000 P.S.I.
HIGH STRENGTH BOLTS - A.S.T.M. A325
SHEAR 13,500 P.S.I.
BEARING 40,000 P.S.I.

REFERENCE SHALL BE MADE TO STANDARD DRAWINGS AS-1-54, REVISED 7-5-62; RR-1-65, SHEET NO. 1, DATED 2-1-65; RB-1-55, REVISED 2-2-59; SD-1-63, SHEETS 2, 3, AND 4 DATED 11-12-63; AND SD-2-64 DATED 11-25-64, AND SUPPLEMENTAL SPECIFICATION 808 DATED 7-15-65.

DESIGN SPECIFICATIONS: THIS STRUCTURE CONFORMS TO THE REQUIREMENTS OF "DESIGN SPECIFICATIONS FOR HIGHWAY STRUCTURES" OF THE STATE OF OHIO, DEPARTMENT OF HIGHWAYS, DATED 9-1-57, TOGETHER WITH CURRENT REVISIONS THEREOF.

EXCAVATION QUANTITY INCLUDES THE REMOVAL OF FILL MATERIAL REQUIRED FOR CONSTRUCTION OF THE ABUTMENTS AND PIERS.

FOUNDATION BEARING PRESSURE: PIER FOOTINGS ARE DESIGNED FOR A MAXIMUM BEARING PRESSURE OF 2.5 TONS PER SQ. FT. AT PIER NO. 1 AND 3.0 TONS PER SQ. FT. AT PIER NO. 2.

CONSTRUCTION CLEARANCE OF 20 FT. VERTICALLY ABOVE THE TOP OF THE RAILROAD RAILS AND 8 FT. HORIZONTALLY FROM THE CENTER OF TRACKS SHALL BE MAINTAINED AT ALL TIMES.

ALIGNING RAILROAD TRACKS: AFTER THE CONTRACTOR HAS COMPLETED ALL EXCAVATION AND BACK-FILL ADJACENT TO THE RAILROAD TRACKS IN COMPLIANCE WITH SEC. 503.04 AND 503.09 OF THE CONSTRUCTION AND MATERIAL SPECIFICATIONS, SUBJECT TO THE SUPERVISION OF THE RAILROAD COMPANY, NOTHING IN SEC. 503.04, 503.09 OR 108.04 OF THE SPECIFICATIONS SHALL BE CONSTRUED TO HOLD THE CONTRACTOR LIABLE FOR ALIGNING AND RESURFACING THE RAILROAD TRACKS.

SHEETING AND BRACING: BEFORE CONSTRUCTION IS STARTED, EIGHT SETS OF PRINTS SHOWING DETAILS OF THE SHEETING AND BRACING TO BE USED FOR EXCAVATION ADJACENT TO THE RAILROAD TRACKS, SHALL BE SUBMITTED TO THE DIRECTOR FOR APPROVAL BY THE DEPARTMENT OF HIGHWAYS AND BY THE RAILROAD COMPANY.

MACHINE FINISH: AT THE CONTRACTOR'S OPTION, THE CONCRETE DECK MAY BE FINISHED BY THE USE OF A FINISHING MACHINE.

RAILROAD AERIAL LINES WILL BE RELOCATED BY THE RAILROAD. THE CONTRACTOR SHALL USE ALL PRECAUTIONS NECESSARY TO SEE THAT THE LINES ARE NOT DISTURBED DURING THE CONSTRUCTION STAGE AND SHALL COOPERATE WITH THE RAILROAD IN THE RELOCATION OF THESE LINES. THE COST OF THE RELOCATION SHALL BE INCLUDED IN THE RAILROAD FORCE ACCOUNT WORK.

PILES SHALL BE DRIVEN TO A MINIMUM BEARING CAPACITY OF 35 TONS.

BOLTED SPlice FABRICATION: THE WEB SPlice PLATES SHALL BE BENT TO CONFORM TO THE ANGLE INDICATED ON THE SPlice DETAIL. RE-ENTRANT CUTS ON THE FLANGE SPlice PLATES WILL NOT BE PERMITTED.

PROTECTIVE COATING FOR PORTLAND CEMENT CONCRETE: TWO COATS OF A PROTECTIVE COATING SHALL BE APPLIED TO THE CONCRETE DECK, THE CURBS, THE ROADWAY SIDE AND THE TOP OF THE PARAPET WALL AND ABUTMENT BACKWALLS AND BRIDGE SEATS. THE FIRST COAT SHALL CONSIST OF ONE PART BOILED LINSEED OIL TO ONE PART THINNER WHICH MAY BE TURPENTINE OR MINERAL SPIRITS. THE SECOND COAT SHALL BE TWO PARTS LINSEED OIL TO ONE PART THINNER. THE BOILED LINSEED OIL SHALL CONFORM TO SEC. 708.02, TURPENTINE SHALL CONFORM TO SEC. 708.03 AND MINERAL SPIRITS SHALL CONFORM TO SEC. 708.04, OF THE STATE OF OHIO, DEPARTMENT OF HIGHWAYS, "CONSTRUCTION AND MATERIAL SPECIFICATIONS". THE APPLICATIONS SHALL BE BY HAND BRUSHING OR PRESSURE SPRAYING TO INSURE COMPLETE AND UNIFORM COVERAGE. THE RATE OF APPLICATION OF THE FIRST COAT SHALL NOT BE MORE THAN 50 SQUARE YARDS PER GALLON OF SOLUTION. THE AREA SHALL BE CLEAN AND DRY BEFORE APPLICATION IS BEGUN AND SHALL NOT BE SPRAYED UNLESS THE CONCRETE AND SURROUNDING AIR TEMPERATURE IS AT LEAST 50° F. THE SECOND COAT SHALL BE APPLIED AFTER THE FIRST COAT HAS BEEN ABSORBED AS INDICATED BY THE AREA REGAINING ITS ORIGINAL DRY APPEARANCE. APPLICATION RATE FOR THE SECOND COAT SHALL NOT BE MORE THAN 70 SQUARE YARDS PER GALLON. DURING THE PROGRESS OF THIS WORK, NO SMOKING BY WORKMEN WILL BE PERMITTED AND ALL FIRES AND OTHER SOURCES OF IGNITION SHALL BE PROHIBITED DUE TO THE HIGHLY FLAMMABLE NATURE OF THE OIL MIXTURE.

THE UNIT BID PRICE PER SQUARE YARD FOR ITEM SPECIAL, PROTECTIVE COATING FOR PORTLAND CEMENT CONCRETE SHALL INCLUDE THE FURNISHING OF ALL MATERIALS, LABOR AND INCIDENTALS NECESSARY TO COMPLETE THIS ITEM.




BARRETT ASSOCIATED ENGINEERS, LIMITED
1500 W. FIRST AVE. COLUMBUS 12, OHIO

GENERAL PLAN AND
GENERAL NOTES
WILSON RD. OVER N.Y.C.R.R.

FRANKLIN COUNTY

Sta. 42+49.68 to Sta. 44+40.39

DESIGNED	DRAWN	TRACED	CHECKED	REVIEWED	DATE	REVISED
D.L.M.	H.J.B.		H.M.			

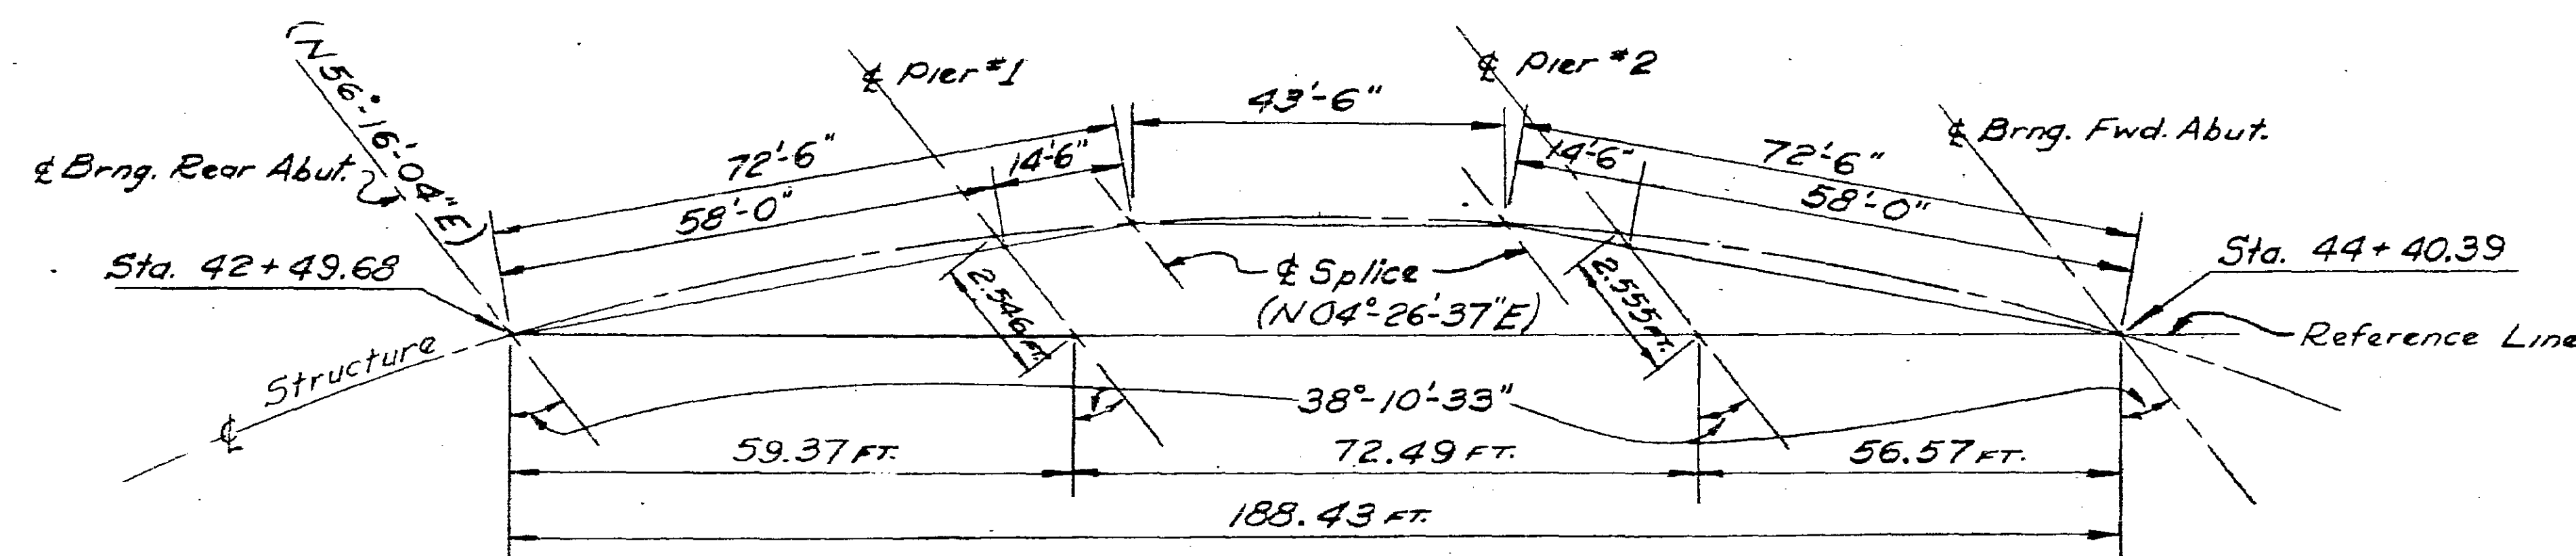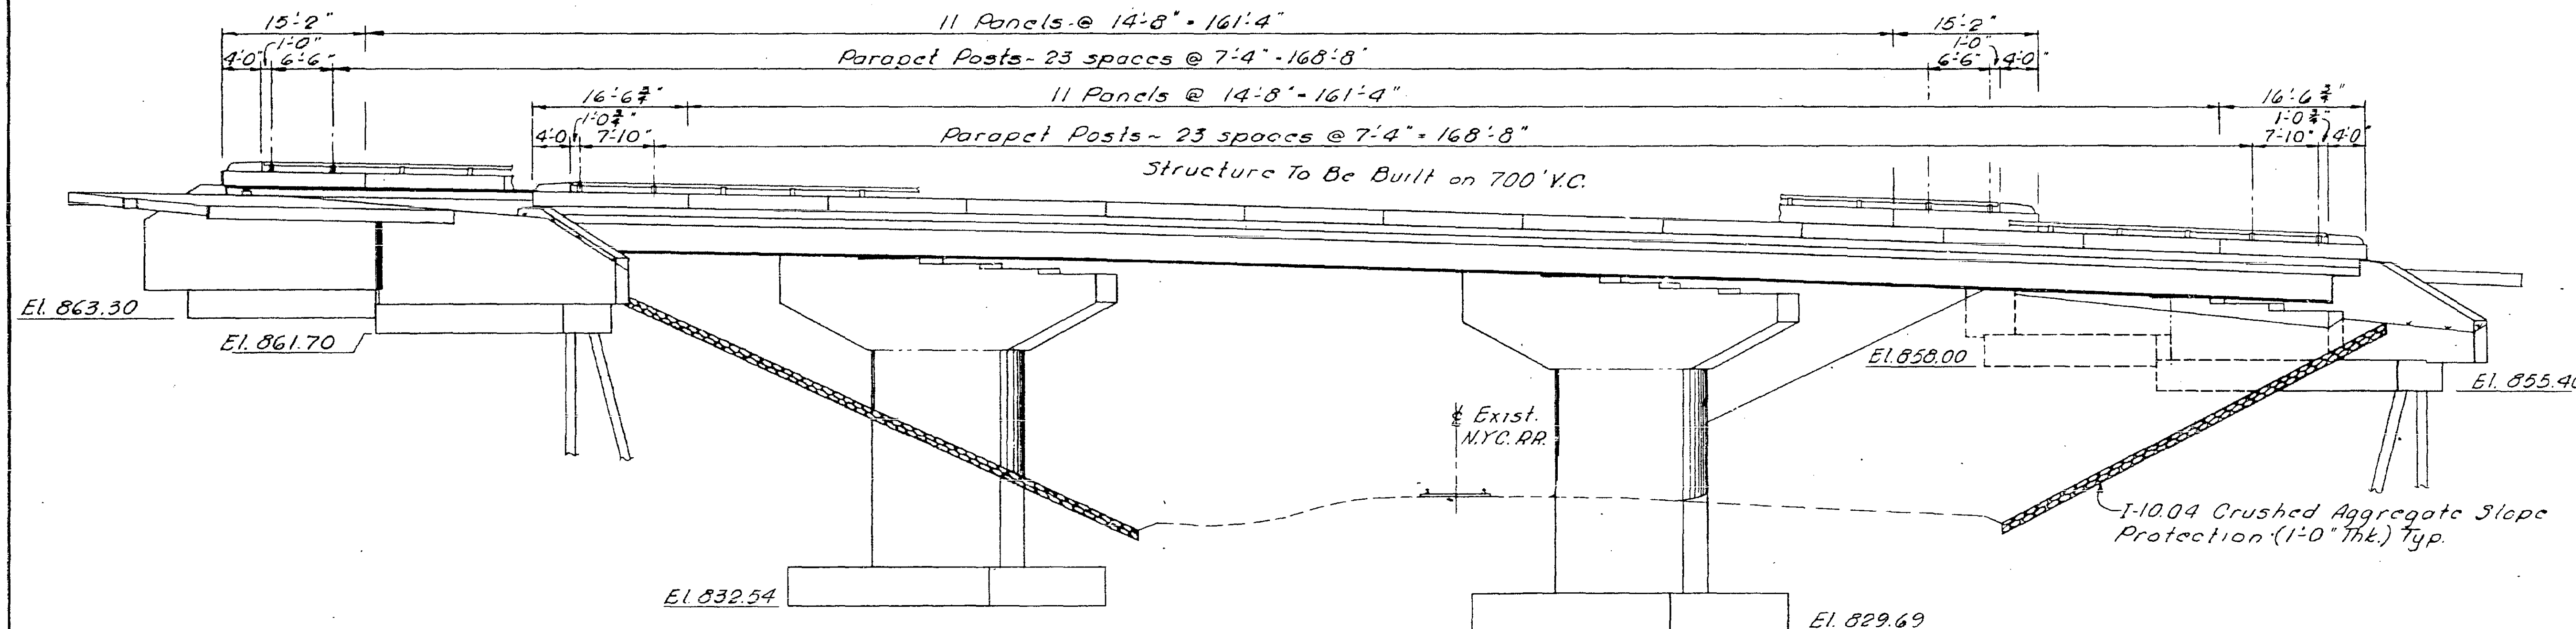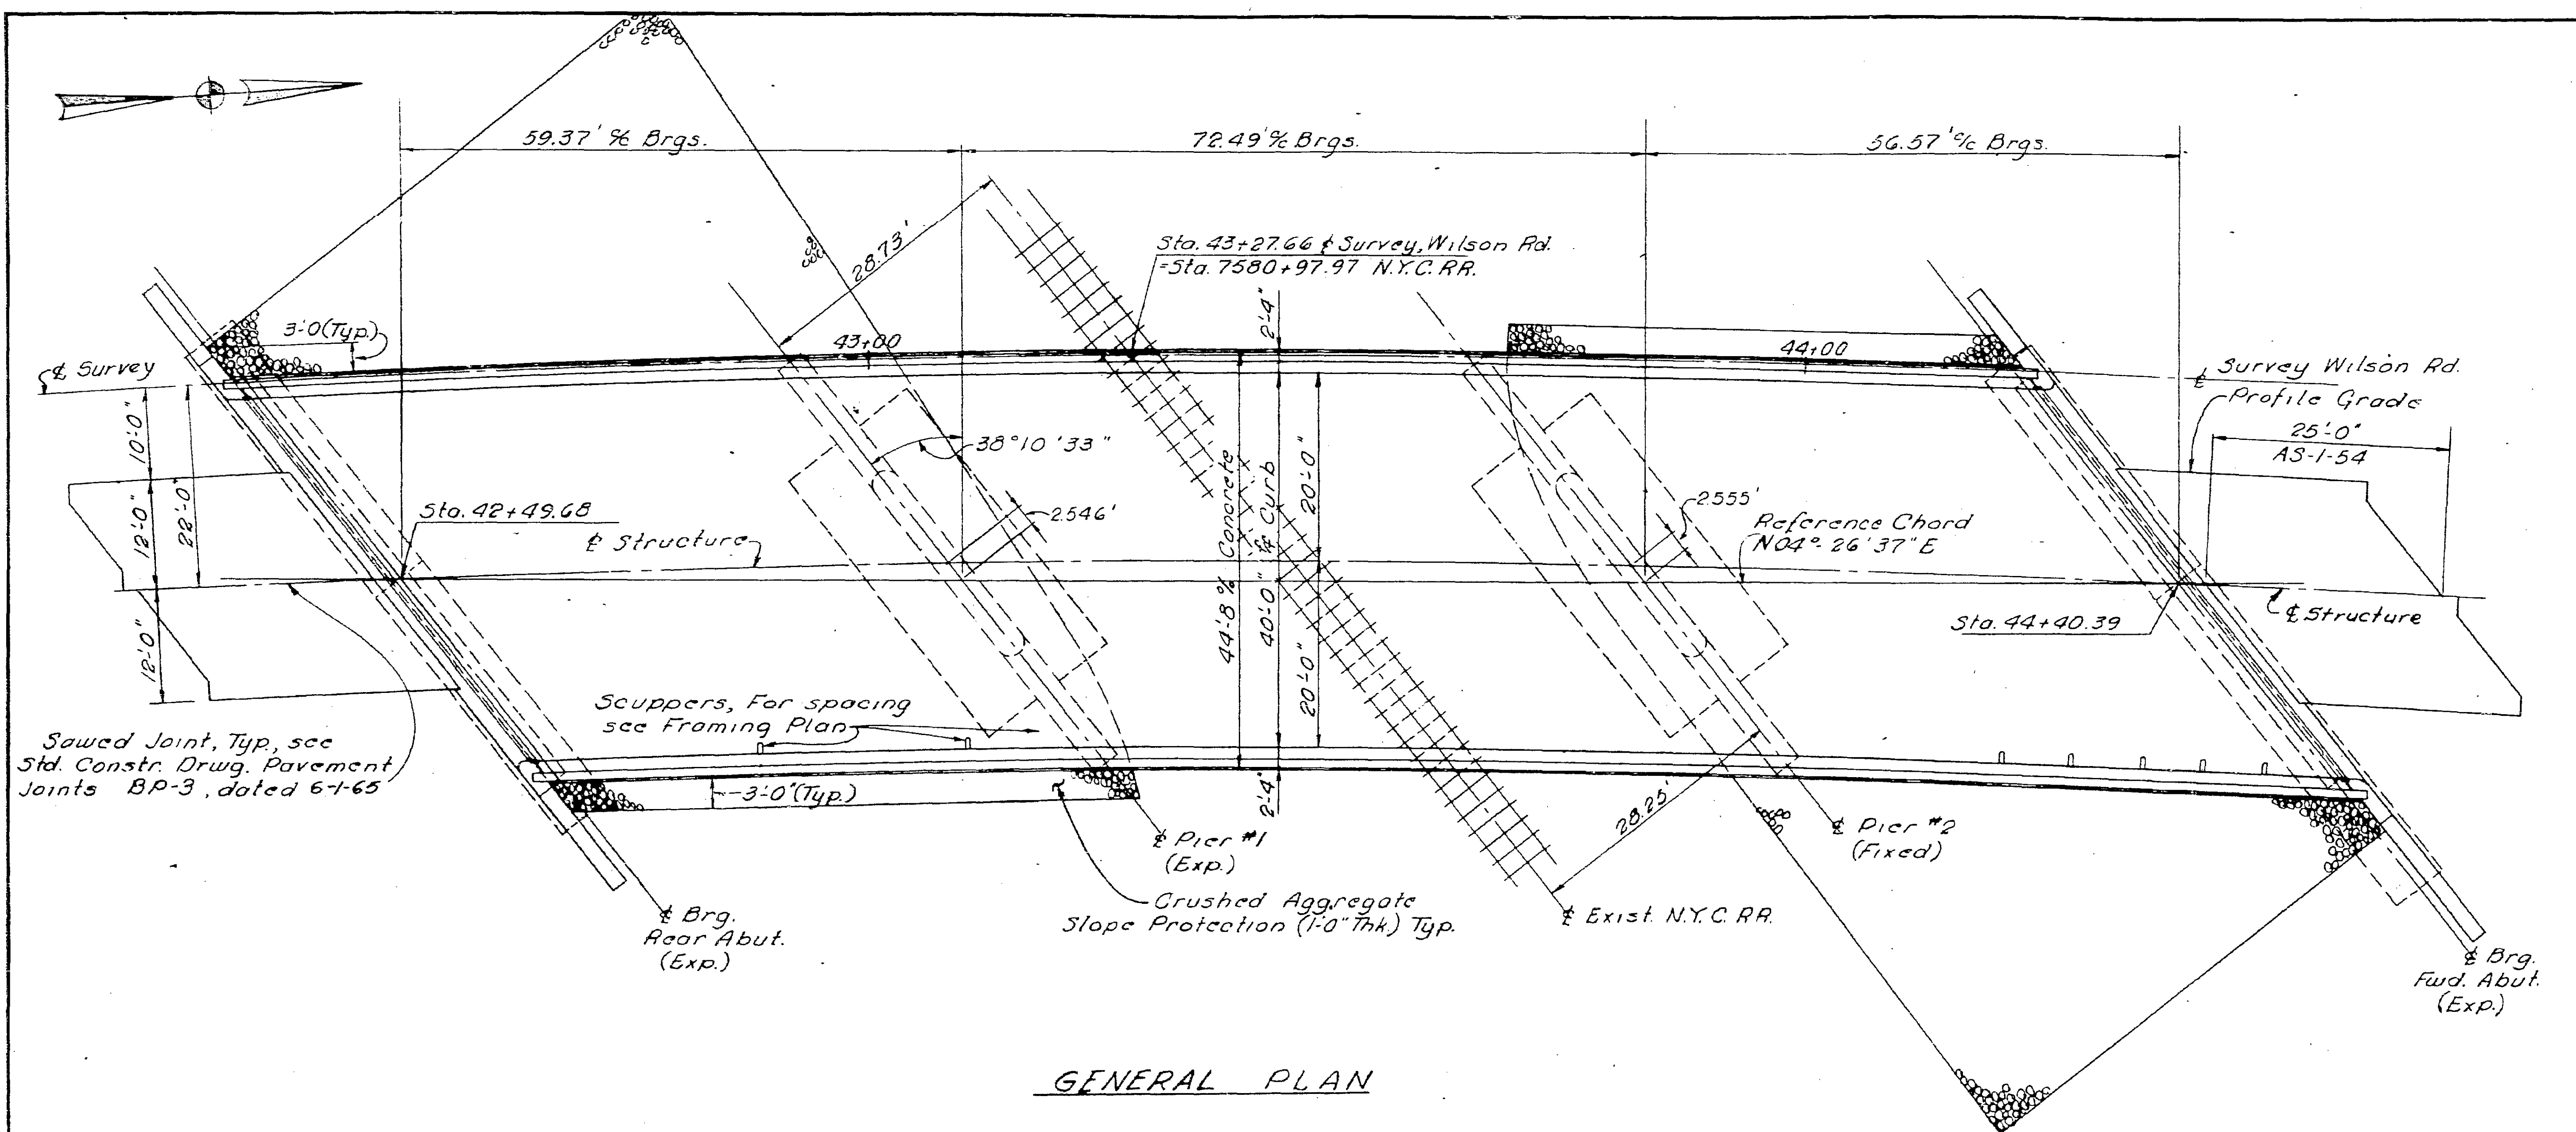

REINFORCING STEEL LIST

FRANKLIN COUNTY
C.R. 25 WILSON RD.

REAR ABUTMENT					FORWARD ABUTMENT					PIERS #1 & #2					SUPERSTRUCTURE								
Mark	No	Length	Shpc	Weight	Bending Diagrams	Mark	No	Length	Shpc	Weight	Bending Diagrams	Mark	No	Length	Shpc	Weight	Bending Diagrams	Mark	No	Length	Shpc	Weight	Bending Diagrams
A801	7	31'-8"	Str.	592		B801	7	29'-3"	Str.	547		P14301	32	29'-0"	Str.	7,099		S701	220	44'-0"	Str.	19,786	
A802	7	31'-11"	"	597		B802	7	41'-1"	"	768		P14302	4	30'-9"	Bt.	941		S702	12	6'-0"	Incr. of 1'-0"	147	
												P14303	2	33'-7"	"	514		S703	12	6'-0"	"	147	
												P14304	2	33'-11"	"	519		S704	12	6'-0"	Incr. of Approx. 9 3/4"	2347	
A601	20	14'-6"	Bt.	436		B601	21	15'-3"	Bt.	481		P1001	92	15'-8"	Str.	6,202		S601	220	44'-0"	Str.	14,539	
A602	20	13'-10"	"	416		B602	20	14'-0"	"	421		P1002	160	8'-0"	Bt.	5,508		S602	332	38'-0"	"	18,949	
A603	32	15'-2"	"	683		B603	33	15'-2"	"	752		P1003	80	10'-3"	Str.	3,528		S603	83	45'-5"	"	5,662	
A604	24	13'-9"	"	496		B604	21	13'-9"	"	434		P1004	40	26'-0"	"	4,475		S604	68	29'-0"	"	2,962	
A605	8	11'-10"	"	142		B605	13	11'-10"	"	231		P1005	40	26'-11"	"	4,633		S605	12	6'-0"	Incr. of 1'-0"	1,408	
A501	48	9'-4"	Bt.	467		B501	54	9'-4"	Bt.	526		P901	28	33'-8"	Str.	2,518		S606	12	6'-0"	"	108	
A502	20	8'-6"	"	177		B502	21	9'-2"	"	201		P902	40	9'-2"	"	1,247		S607	12	6'-0"	Incr. of Approx. 9 3/4"	1,724	
A503	20	9'-6"	"	198		B503	20	10'-2"	"	212													
A504	20	7'-10"	"	163		B504	21	8'-7"	"	188													
A505	20	7'-2"	"	150		B505	20	7'-4"	"	153													
A506	18	26'-8"	Str.	501		B506	36	26'-8"	Str.	1,001		P601	8	17'-5"	Bt.	209		S501	284	5'-7"	Bt.	1,654	
A507	6	14'-7"	"	91		B507	1	26'-10"	Bt.	28		P501	48	21'-0"	Str.	1,051		S502	254	2'-8"	"	706	
A508	2	39'-8"	"	83		B508	1	26'-10"	"	28		P502	48	7'-0"	Bt.	350		S503	254	5'-1"	"	1,347	
A509	2	37'-6"	"	78		B509	10	12'-8"	Str.	127		P503	4	23'-8"	Str.	99		RAILING					
A510	2	33'-11"	"	71		B510	2	10'-7"	"	22		P504	8	19'-5"	"	162		R501	8	14'-10"	Str.	---	
A511	1	30'-6"	"	32		B511	2	8'-2"	"	17		P505	8	25'-5"	"	212	R502	88	14'-4"	"	---		
A512	1	30'-8"	Bt.	32		B512	2	5'-7"	"	12		P506	16	27'-8"	"	462	R507	8	16'-2"	"	---		
A513	1	32'-7"	"	34		B513	6	24'-0"	"	150		P507	8	10'-3"	Bt.	86	NOTE: FOR ADDITIONAL REINFORCING IN RAILING END POSTS SEE STD. DWG. BR-1-65.						
A514	1	32'-5"	Str.	34		B514	2	23'-1"	"	48		P508	16	11'-1"	"	185							
A515	2	35'-3"	"	74		B515	2	20'-3"	"	42		P509	8	11'-11"	"	99							
A516	2	38'-3"	"	80		B516	2	16'-4"	"	34		P510	8	12'-9"	"	106							
A517	2	39'-11"	"	83		B517	2	12'-5"	"	26		P511	8	13'-7"	"	113							
A518	6	14'-10"	"	93		B518	2	12'-5"	"	26		P512	8	12'-3"	"	102							
A519	2 SETS OF 9	Incr. of 7 3/4"				B519	4	11'-4"	"	47		P513	8	9'-11"	"	83							
	from 4'-11" to 9'-10"	Str.		138		B520	8	10'-4"	"	56		P514	8	8'-9"	"	73							
A520	6	10'-8"	"	67		B521	2	9'-7"	"	20		P515	8	7'-7"	"	63							
A521	2 SETS OF 6	Incr. of 8"				B522	2	9'-7"	"	20		P516	8	6'-11"	"	58							
	from 7'-3" to 10'-7"	Str.		112		B523	2	9'-7"	"	20		P517	72	3'-8"	"	275							
						B524	2	9'-7"	"	20		P518	38	19'-7"	Bt.	756							

ESTIMATED QUANTITIES (1965 SPECIFICATIONS)									
ITEM	QUANT.	UNIT	DESCRIPTION	ABUTS.	PIERS	SUPER.	GEN.		
503	Lump Sum	L.S.	Cofferdams, Cribbs and Sheeting				Lump Sum		
503	959	Cu.Yds.	Unclassified Excavation	344	615				
511	266	Cu.Yds.	Class "C" Concrete, Superstructure			266			
511	219	Cu.Yds.	Class "C" Concrete, Piers above footings		219				
511	261	Cu.Yds.	Class "E" Concrete, Footings	100	161				
511	145	Cu.Yds.	Class "E" Concrete, Abutments above footings	145					
512	20	Lin.Ft.	Waterproofing, Premolded Sealing Strip	20					
509	127,962	Lbs.	Reinforcing Steel	12,979	41,728	73,255			
513	244,781	Lbs.	Structural Steel			244,781			
514	244,781	Lbs.	Field Painting of Structural Steel			244,781			
517	386.12	Lin.Ft.	Bridge Railing, Type 1			386.12			
505	Lump Sum	L.S.	First Test Pile				Lump Sum		
507	1,300	Lin.Ft.	Steel Piles, 10B42	1,300					
518	7	Each	Scupper, including supports			7			
518	82	Lin.Ft.	6" Helical CMP, 70706, Non-perforated	82					
518	108	Lin.Ft.	6" Perforated Helical CMP, 70706, incl. specials	108					
518	94	Cu.Yds.	Porous Backfill	94					
803	266	Each	Water-reducing, Set-retarding Admixture			266			
601	1,050	Sq.Yds.	Crushed Aggregate Slope Protection (1'-0" Thick)				1,050		
Special	1,130	Sq.Yds.	Protective Coating for Portland Cement Concrete				1,130		

BAR SIZE IS INDICATED IN THE BAR MARK. THE FIRST DIGIT WHERE THREE DIGITS ARE USED AND THE FIRST TWO DIGITS WHERE FOUR DIGITS ARE USED INDICATE THE BAR SIZE NUMBER. FOR EXAMPLE A801 IS A NO. 8 SIZE BAR AND P1001 IS A NO. 10 SIZE BAR.


REINFORCING BARS NO. 14.S SHALL BE OF INTERMEDIATE OR HARD GRADE CONFORMING TO ASTM A-408.

RAILING BARS, R501, R502 and R507 ARE INCLUDED WITH RAILING FOR PAYMENT.

REPLACEMENT BARS			
Mark	No.	Length	Shape
RE14301	1	8'-3"	Str.
RE1001	2	7'-2"	Str.
RE901	1	6'-10"	Str.
RE801	1	6'-6"	Str.
RE701	2	6'-2"	Str.
RE601	3	5'-11"	Str.
RE501	1	5'-7"	Str.

BARRETT ASSOCIATED ENGINEERS, LIMITED			
1500 W. FIRST AVE.		COLUMBUS 12, OHIO	
ESTIMATED QUANTITIES & REINFORCING STEEL LIST			
WILSON RD. OVER N.Y.C.R.R.			
FRANKLIN COUNTY			
Sta. 42+46.89 to Sta. 44+43.41			
DESIGNED	DRAWN	CHECKED	APPROVED
K.L.B.		D.L.M.	

Elevations given along
end dam @ this location

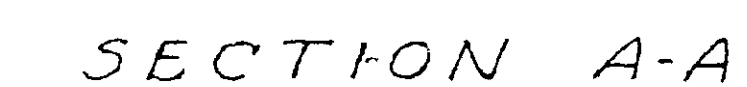

(n. f.) Denotes, "near face"
(f. f.) Denotes, "for face"
(e. f.) Denotes, "each face"


POROUS BACKFILL 1'-6" THICK SHALL EXTEND FROM THE TOP OF THE FOOTINGS UPWARD TO THE UNDERSIDE OF THE APPROACH SLAB AND TO THE EARTH SHOULDERS, AND OUTWARD TO THE SURFACE OF THE EMBANKMENT SLOPES. EXCAVATION THEREFOR, IN EXCESS OF THAT REQUIRED FOR CONSTRUCTION OF THE ABUTMENT SHALL BE CONSIDERED AS PAID FOR IN THE BID PRICE PER CU. YD. PAID FOR POROUS BACKFILL.

REAR ABUTMENT DETAILS
WILSON RD. OVER N.Y.C.R.R.
FRANKLIN COUNTY


Sta. 42+46.89 to Sta. 44+43.41

DESIGNED	DRAWN	TRACED	CHECKED	REVIEWED	DATE	REV
HM	KJB	-	HM			

PROCEDURE: THE EMBANKMENT SHALL BE PLACED AND COMPACTED UP TO THE FINISHED SPILL-THRU SLOPE AND TO THE LEVEL OF THE SUBGRADE FOR A DISTANCE OF 200 FEET BACK OF THE ABUTMENTS, AFTER WHICH EXCAVATION SHALL BE MADE FOR THE ABUTMENTS AND THE PIERS.

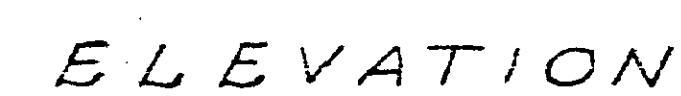


FRANKLIN COUNTY
C.R. 25 WILSON POOL

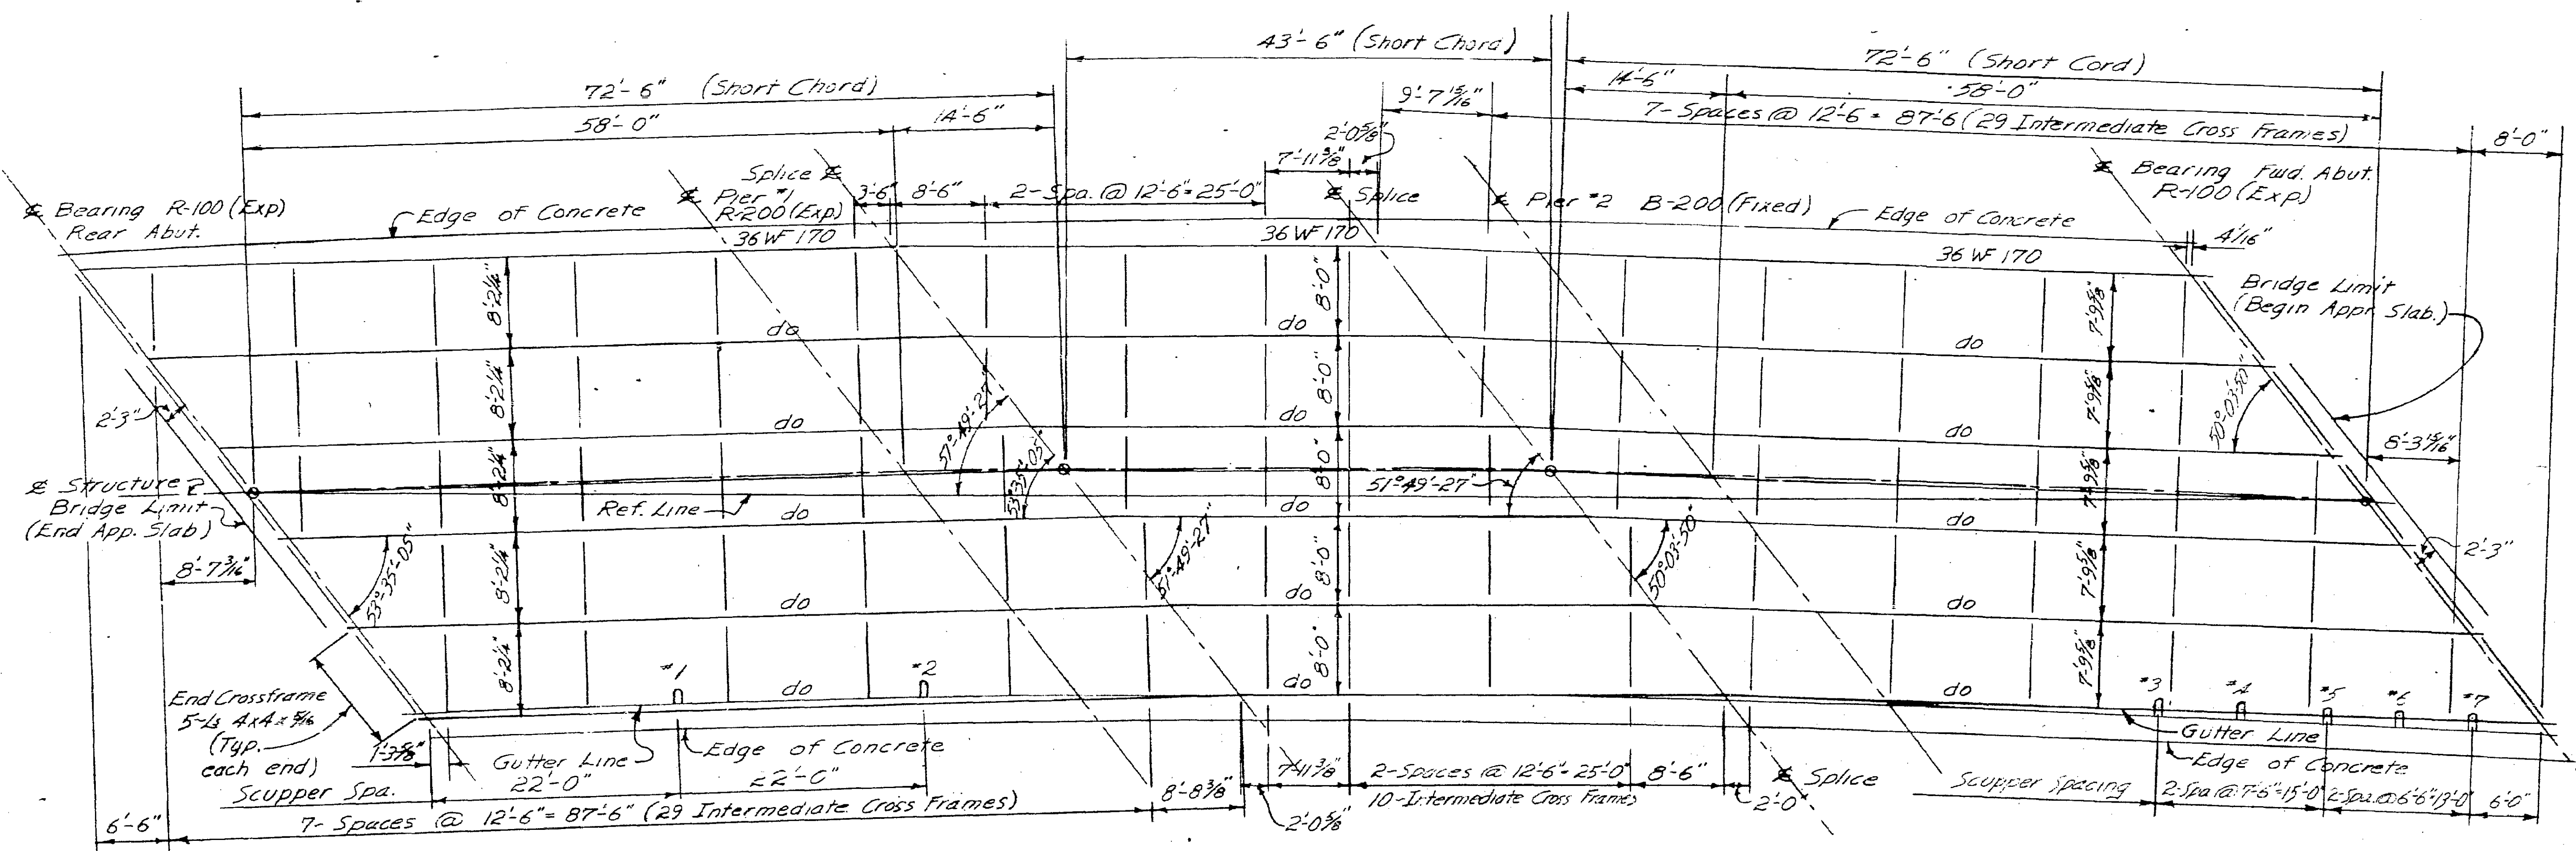


FRAMING PLAN

SCUPPER DIMENSIONS		
Scupper Number	Dimension "A"	Dimension "B"
1	2 1/2"	—
2	3 3/4"	—
3	—	2 3/8"
4	—	4 1/8"
5	—	5 3/8"
6	—	6 3/8"
7	—	8 3/8"

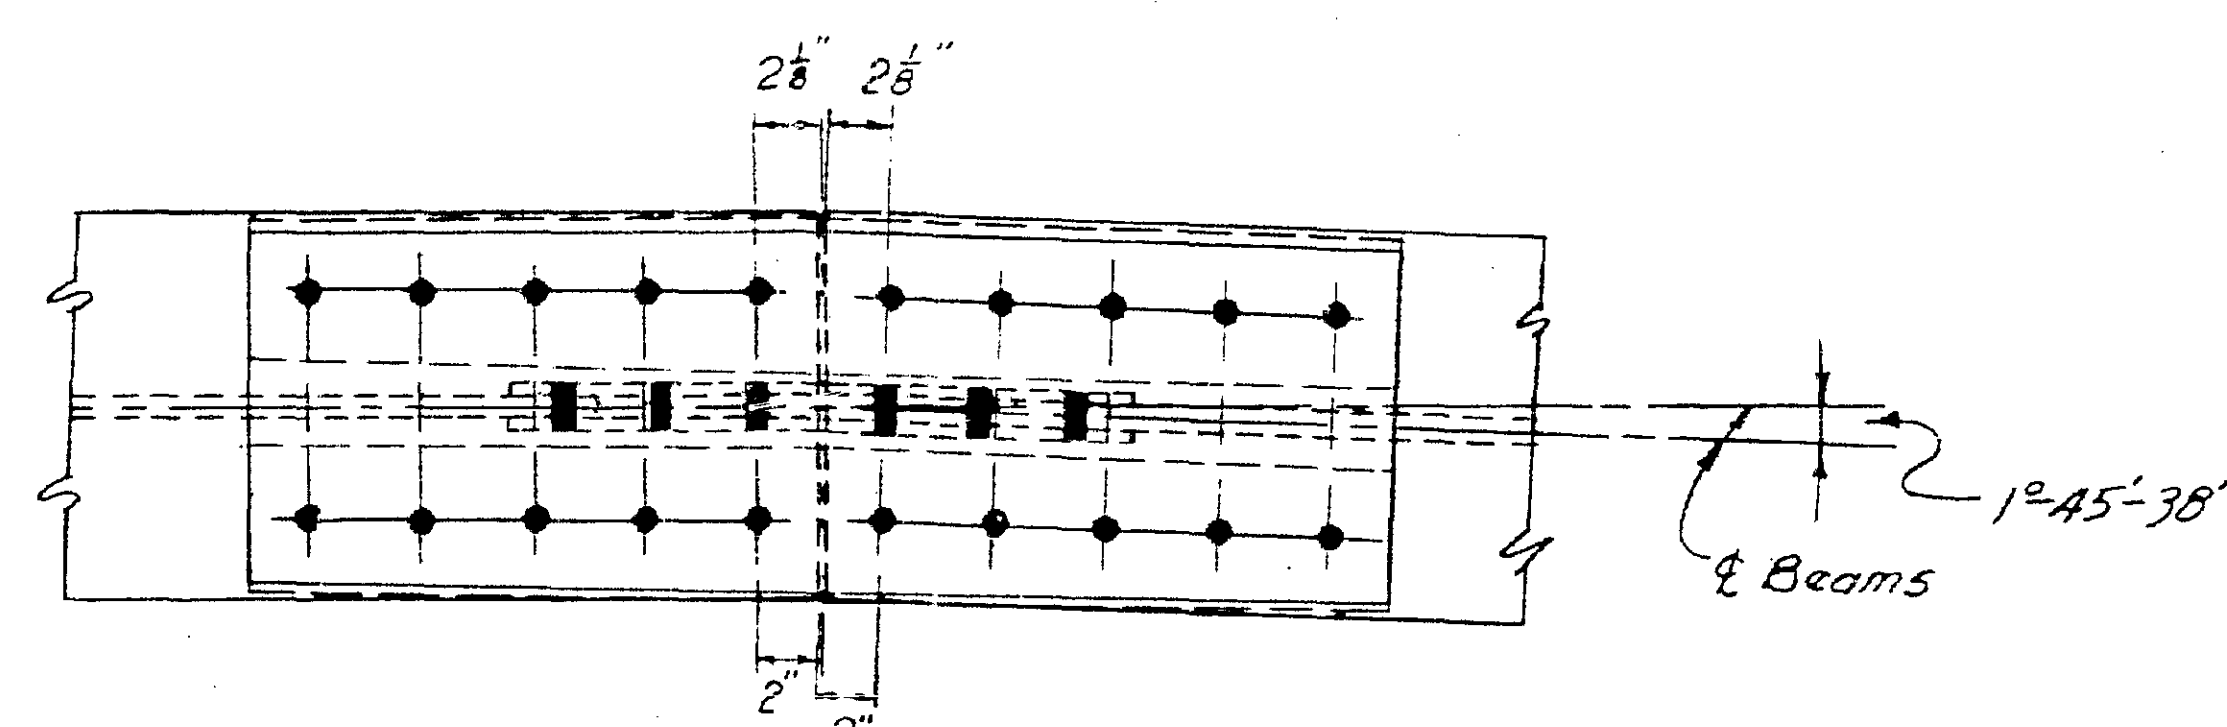

FLANGE SPLICE DETAIL


For Additional Splice Details
See Std. Dwg. SD-2-64

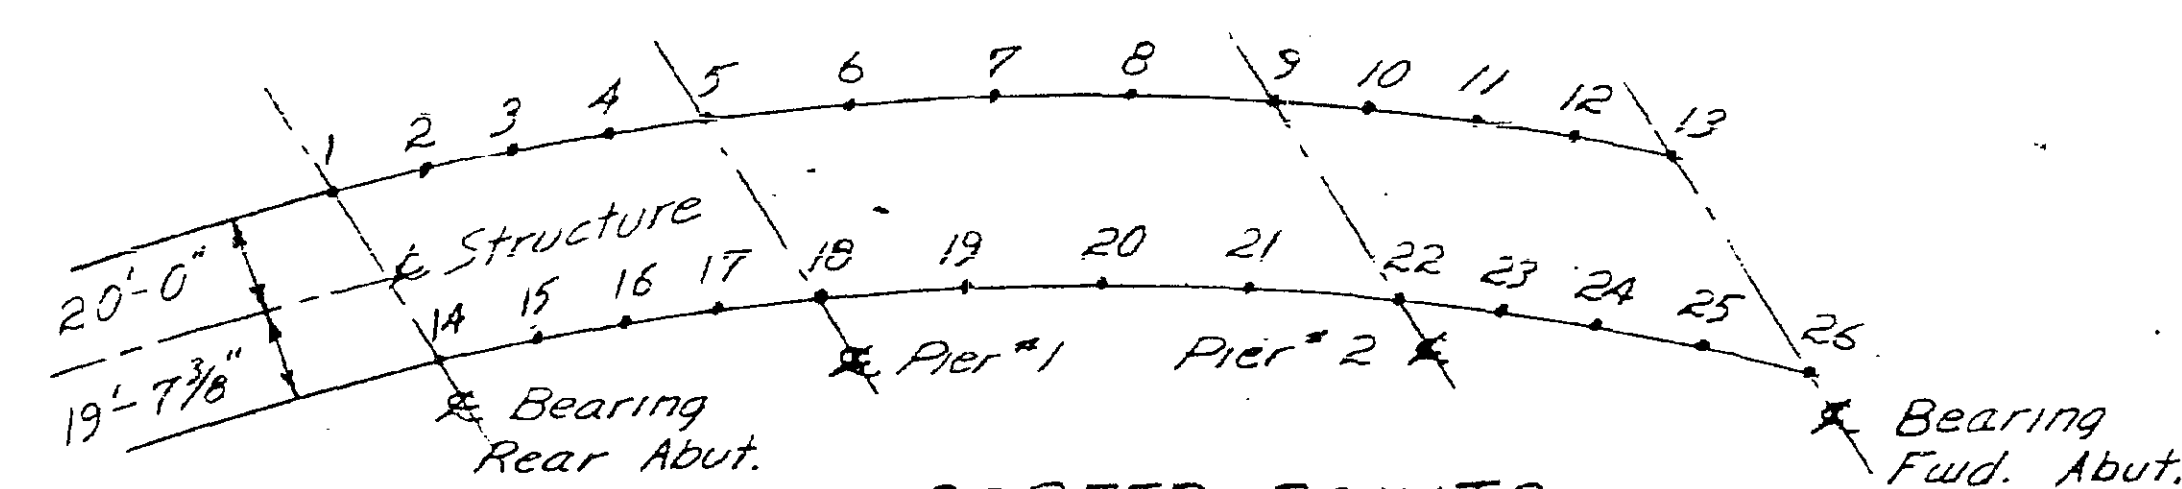


SCREED POINTS

QUARTER POINT			
SCREEN ELEVATIONS			
1	876.58	14	874.25
2	876.42	15	874.03
3	876.22	16	873.75
4	875.96	17	873.43
5	875.68	18	873.08
6	875.32	19	872.62
7	874.91	20	872.12
8	874.42	21	871.53
9	873.89	22	870.88
10	873.45	23	870.36
11	872.98	24	869.81
12	872.47	25	869.20
13	871.91	26	868.55


DEFLECTION & CAMBER											
LOCATION	SPAN 'A'				SPAN 'B'				SPAN 'C'		
	1/4 Pt	1/2 Pt	3/4 Pt	Full Pt	1/4 Pt	1/2 Pt	3/4 Pt	Full Pt	1/4 Pt	1/2 Pt	Full Pt
Deflection due to weight of Steel	1/16	1/16	1/32	1/32	1/16	1/32	1/32	1/16	1/16		
Deflection due to remaining dead load	1/4	3/32	1/8	1/8	3/32	1/8	3/32	1/4	3/32		
Adjustment required for vertical curve	1/32	3/32	1/32	3/32	1/8	3/32	1/32	3/32	1/32		
Adj. required for sweep of beam & super-elevation	1/16	1/16	1/16	0	1/16	0	1/16	1/16	1/16	1/16	
Required Shop Camber	2/32	1/8	1/8	3/32	1/16	1/32	1/32	1/8	1/32		

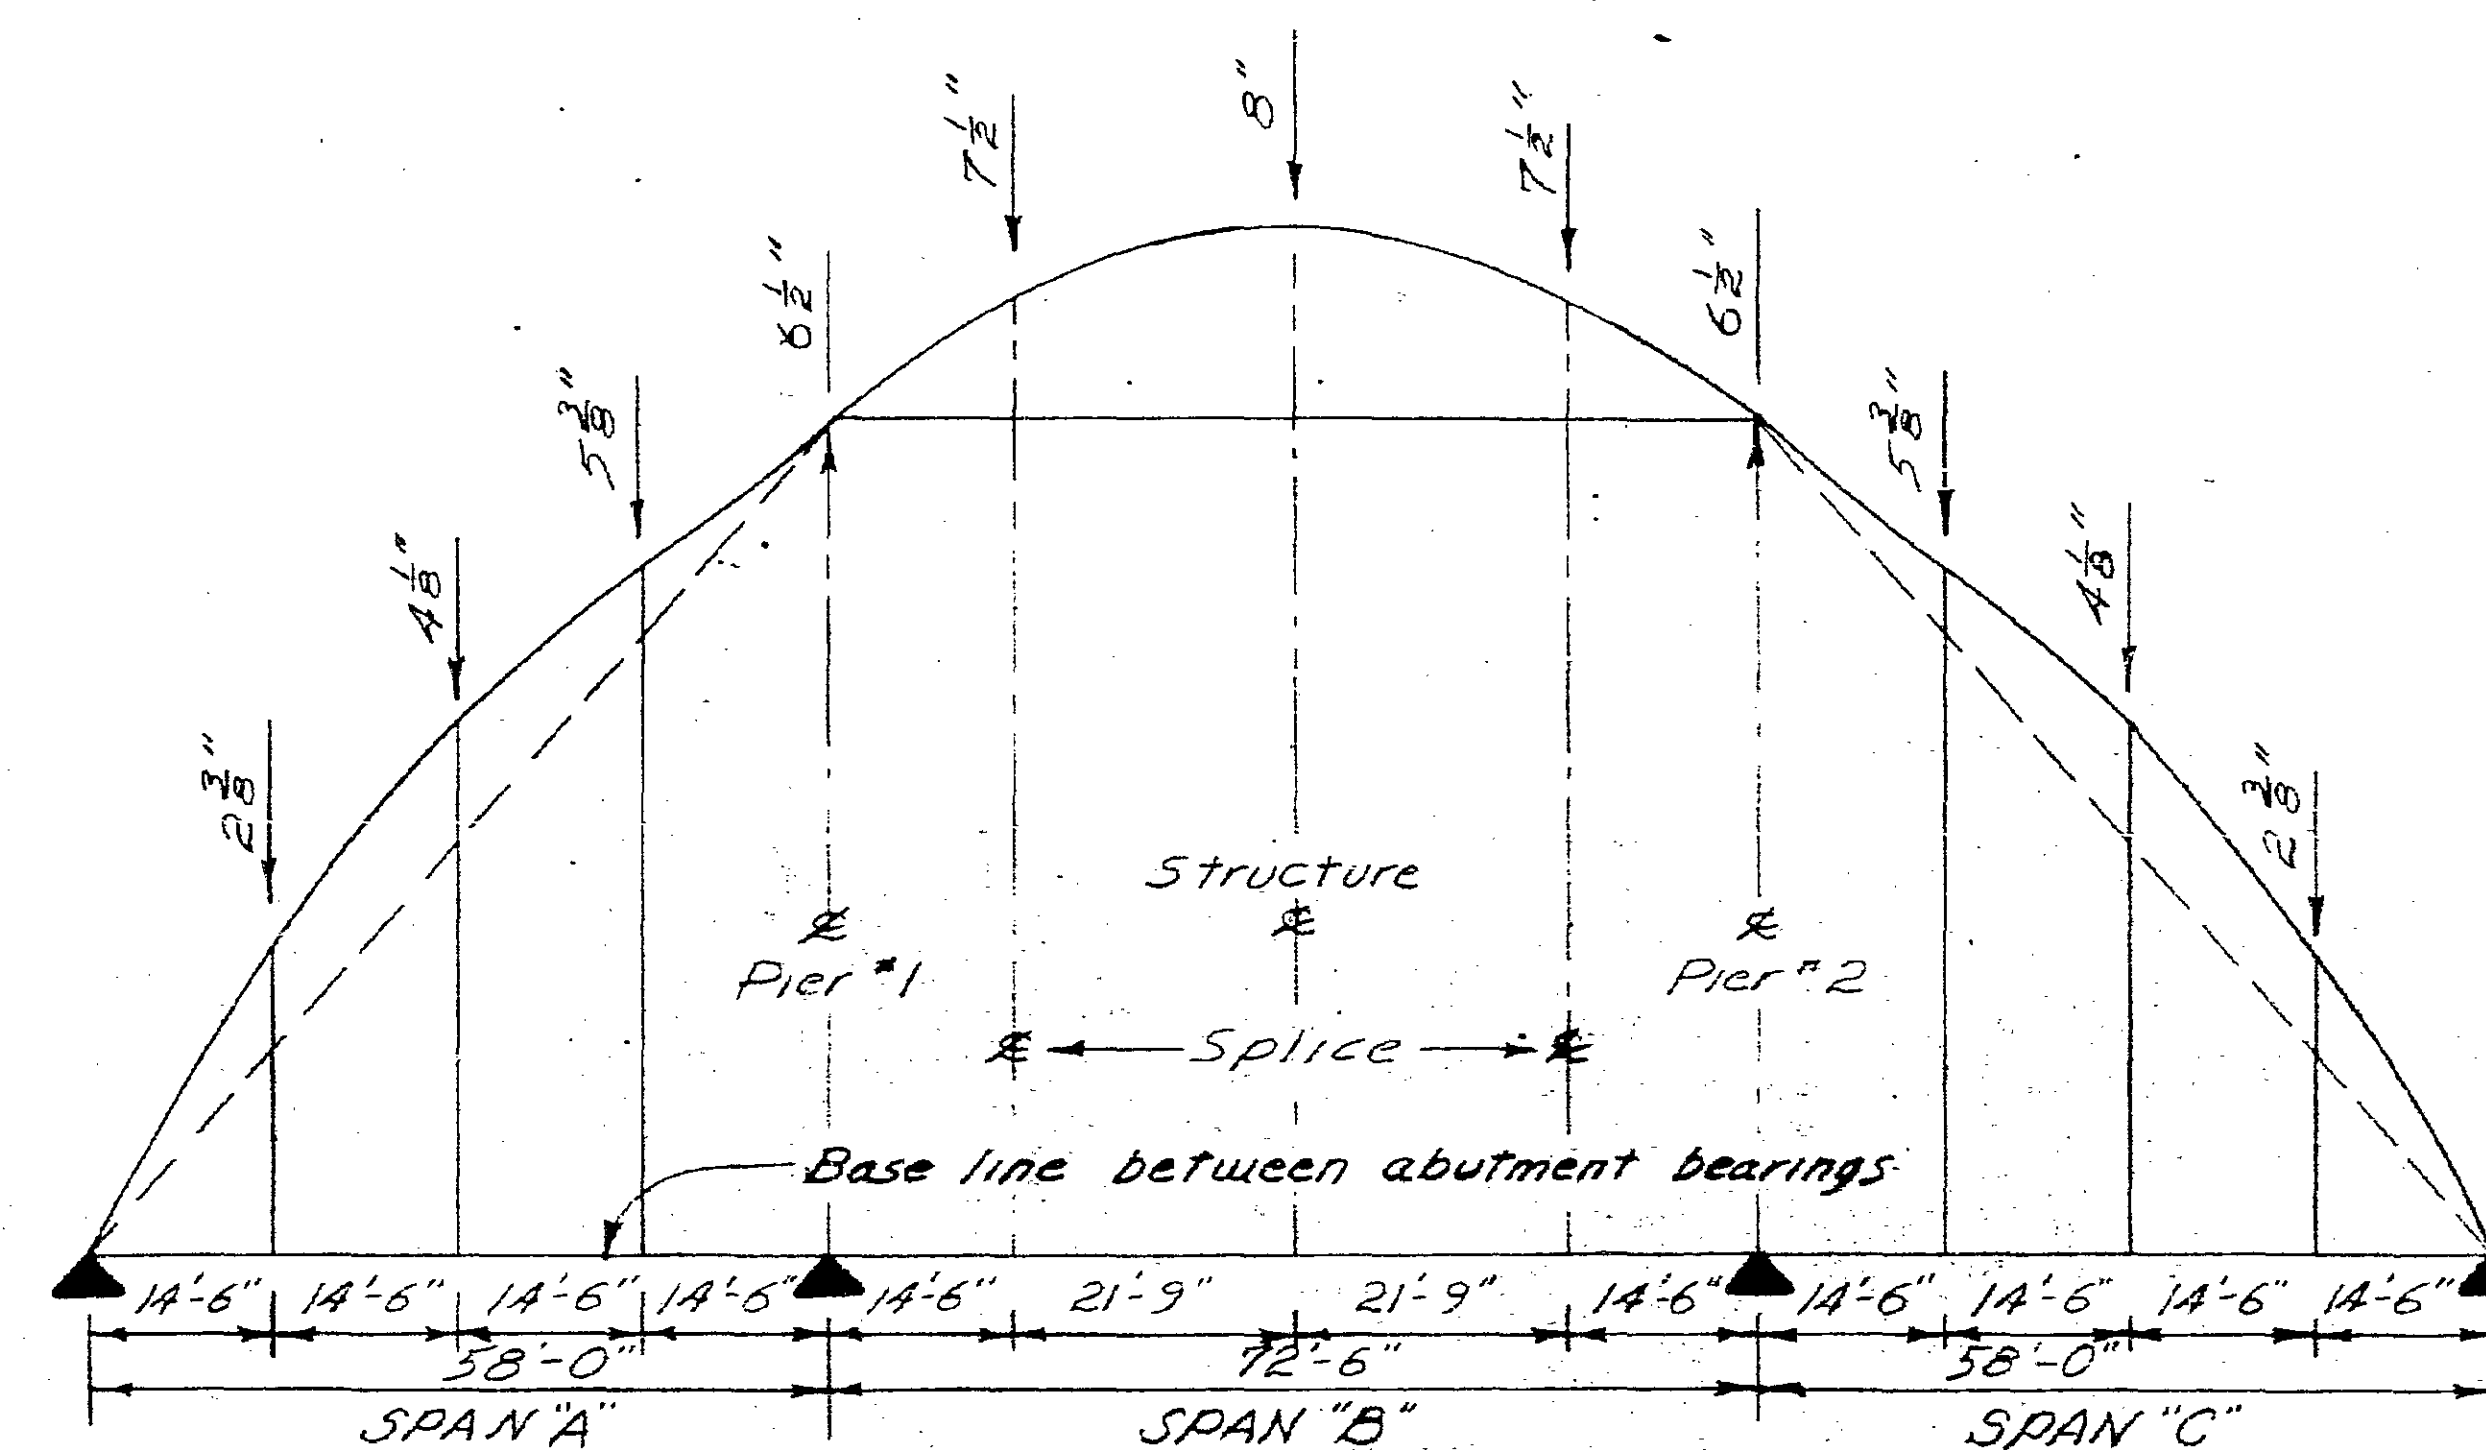


CAMBER DIAGRAM

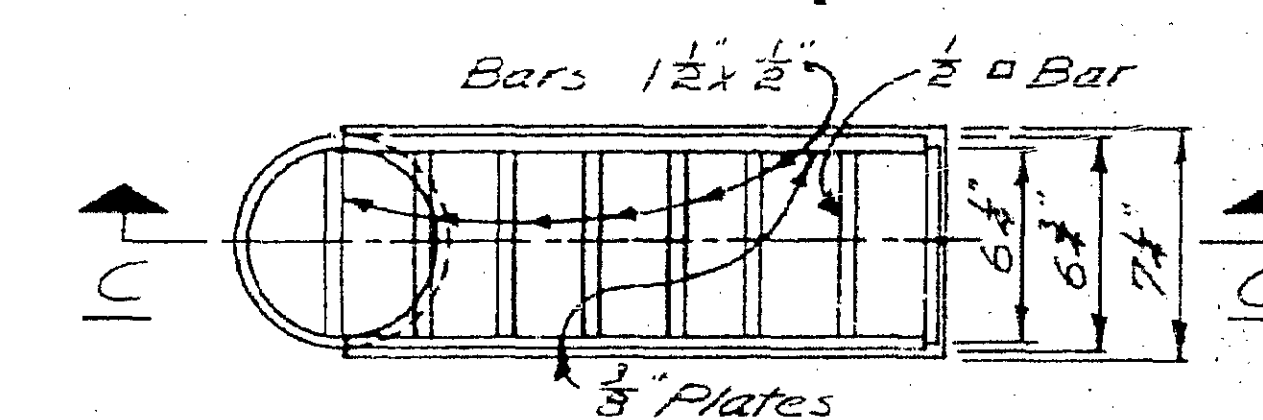


PLAN - SCUPPERS 3,4,5,6, & 7

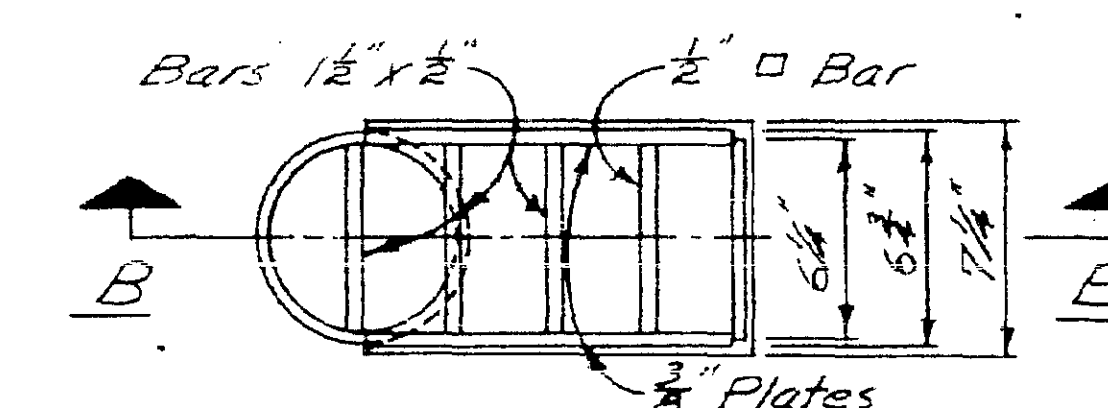

PLAN - SCUPPERS 1&2

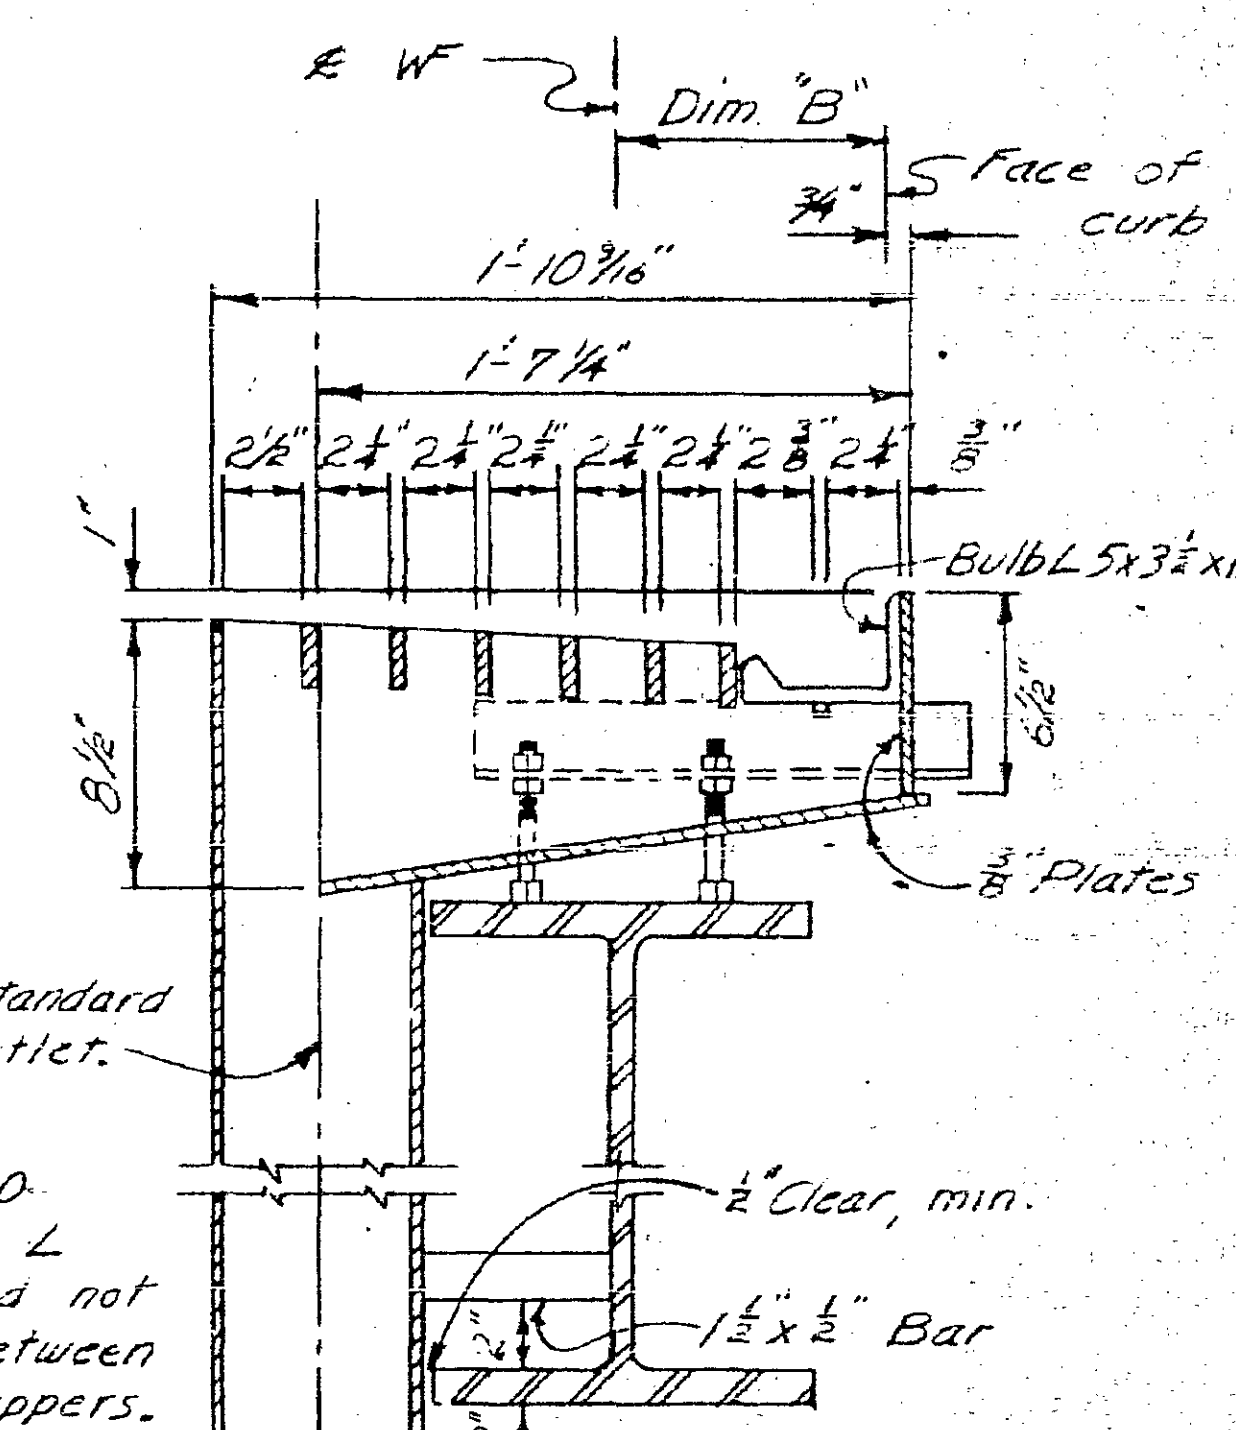

SECTION C-C

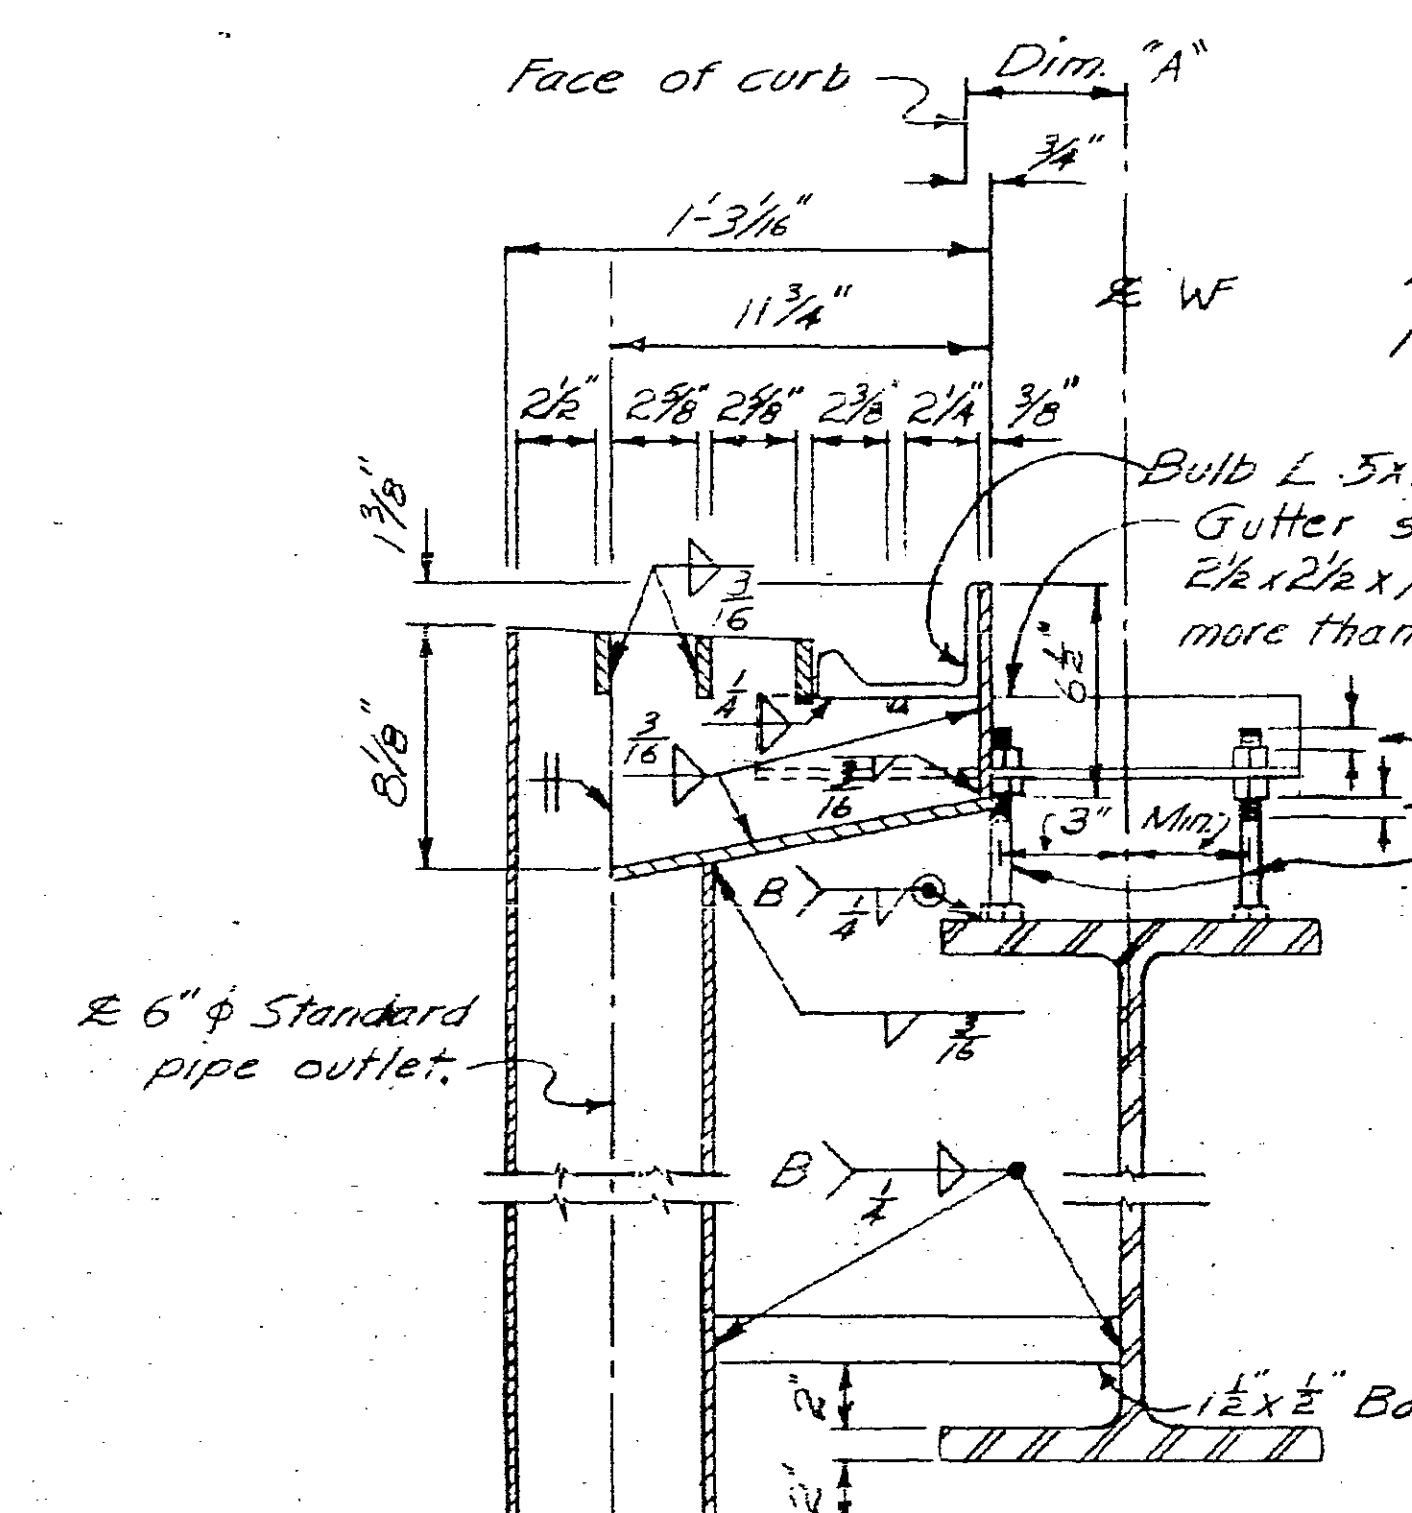


SECTION B-B

BARRETT ASSOCIATED ENGINEERS, LIMITED					
1500 W. FIRST AVE.			COLUMBUS 12, OH.		
SUPERSTRUCTURE DETAILS					
WILSON RD. OVER N.Y.C. R.R.					
FRANKLIN COUNTY					
Sta. 42+46.89 To Sta. 44+43.41					
DESIGNED	DRAWN	TRACED	CHECKED	REVIEWED	DATE
D.L.M.	JTB		HM		


REINFORCING NOTE

All longitudinal bars are 5602, 5603 or 5604 unless otherwise shown. Longitudinal bars between $\frac{1}{2}$ curbs, except the 5604 bar adjacent to each curb, run parallel to beams in each span. Remaining longitudinal bars run parallel to Σ Structure

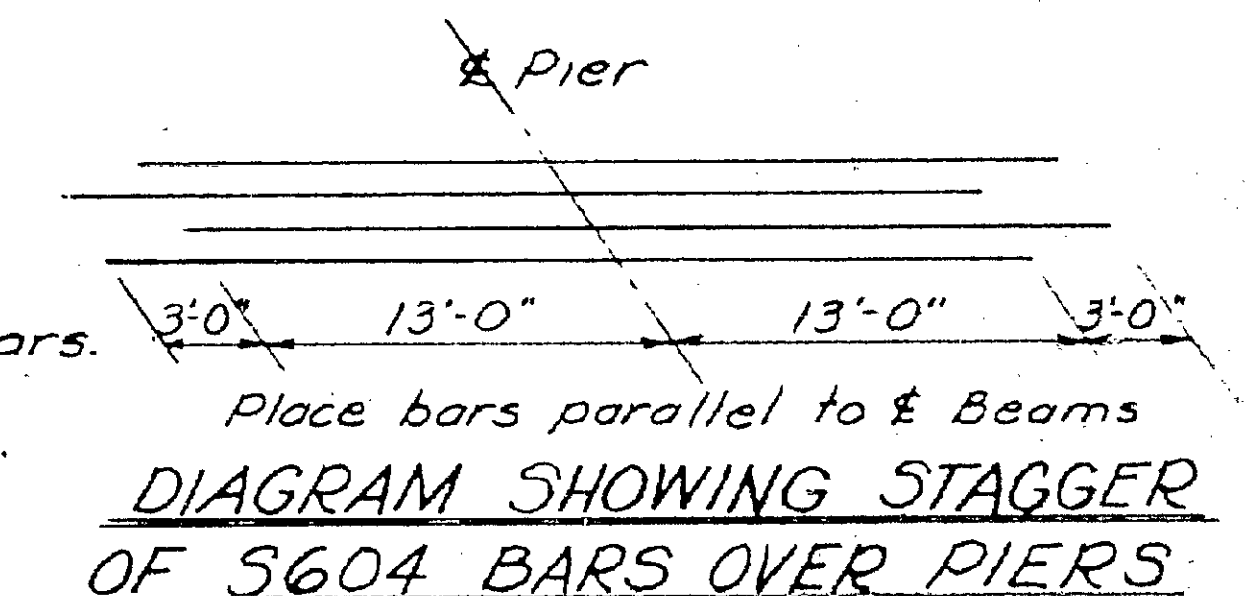

DECK SLAB HAUNCH: The haunch in the super-elevated deck slab adjacent to the top of steel beams, which is shown as 9' wide, may vary from this dimension between the limits of 6' and 12' on the low side and between 9' and 12' on the high side. Except on the high side, the maximum slope shall not exceed 3 inches per foot. Payment for deck slab concrete shall be based on the 9' width.

NOTE:
* This is a nominal dimension. The quantity of deck concrete to be paid for shall be based on this dimension, even though deviation from it may be necessary, because the top flange of the beam may not have the exact camber or conformation required to place it parallel to the finished grade.

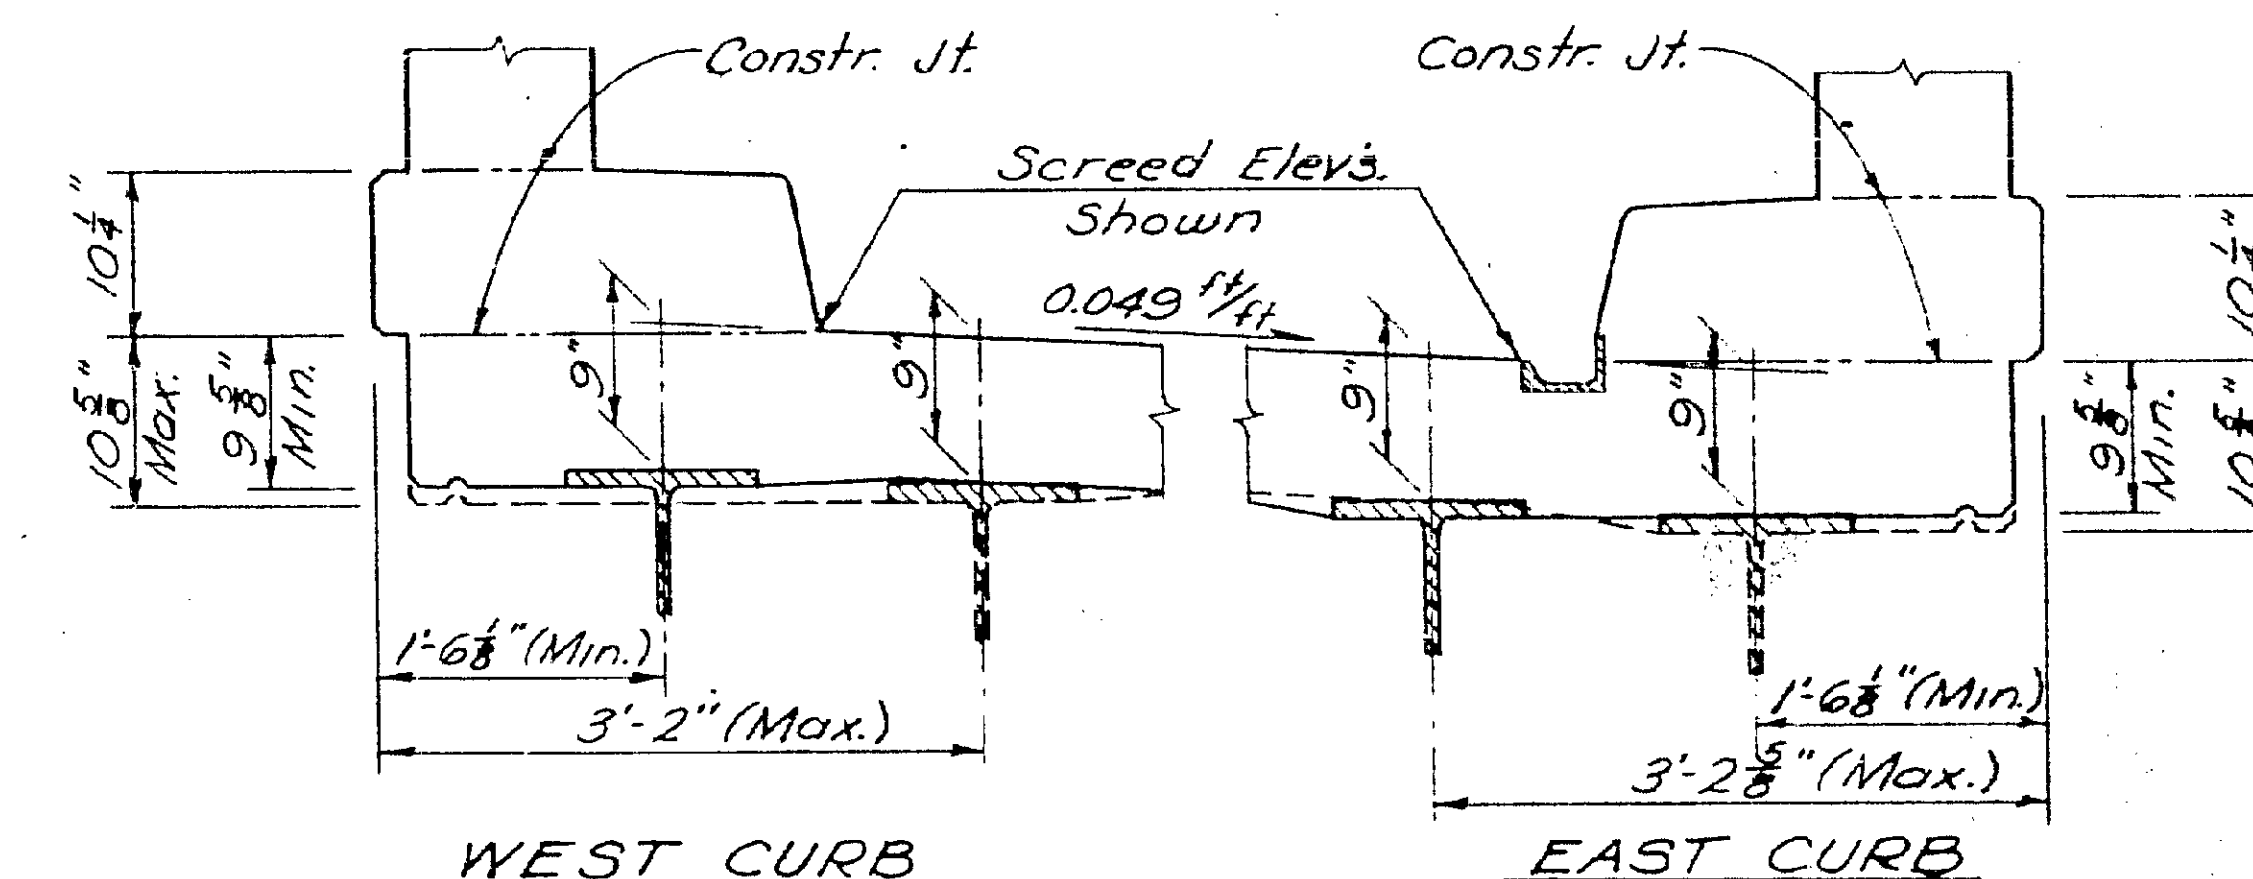


15'-2" 14'-8" 16'-6³/₄"

2'-0" 9 equal spcs. = 12'-11" 10 equal spaces = 14'-2" 10 equal spcs. = 14'-3³/₄" 2'-0"

10-5501 11-5501 11-5501

2-R501 2-R502 2-R507

EXTERIOR PARAPET TYPICAL INTERIOR EXTERIOR PARAPET
PANEL ~ WEST SIDE PARAPET PANEL PANEL ~ EAST SIDE
 (2 Required) (22 Required) (2 Required)

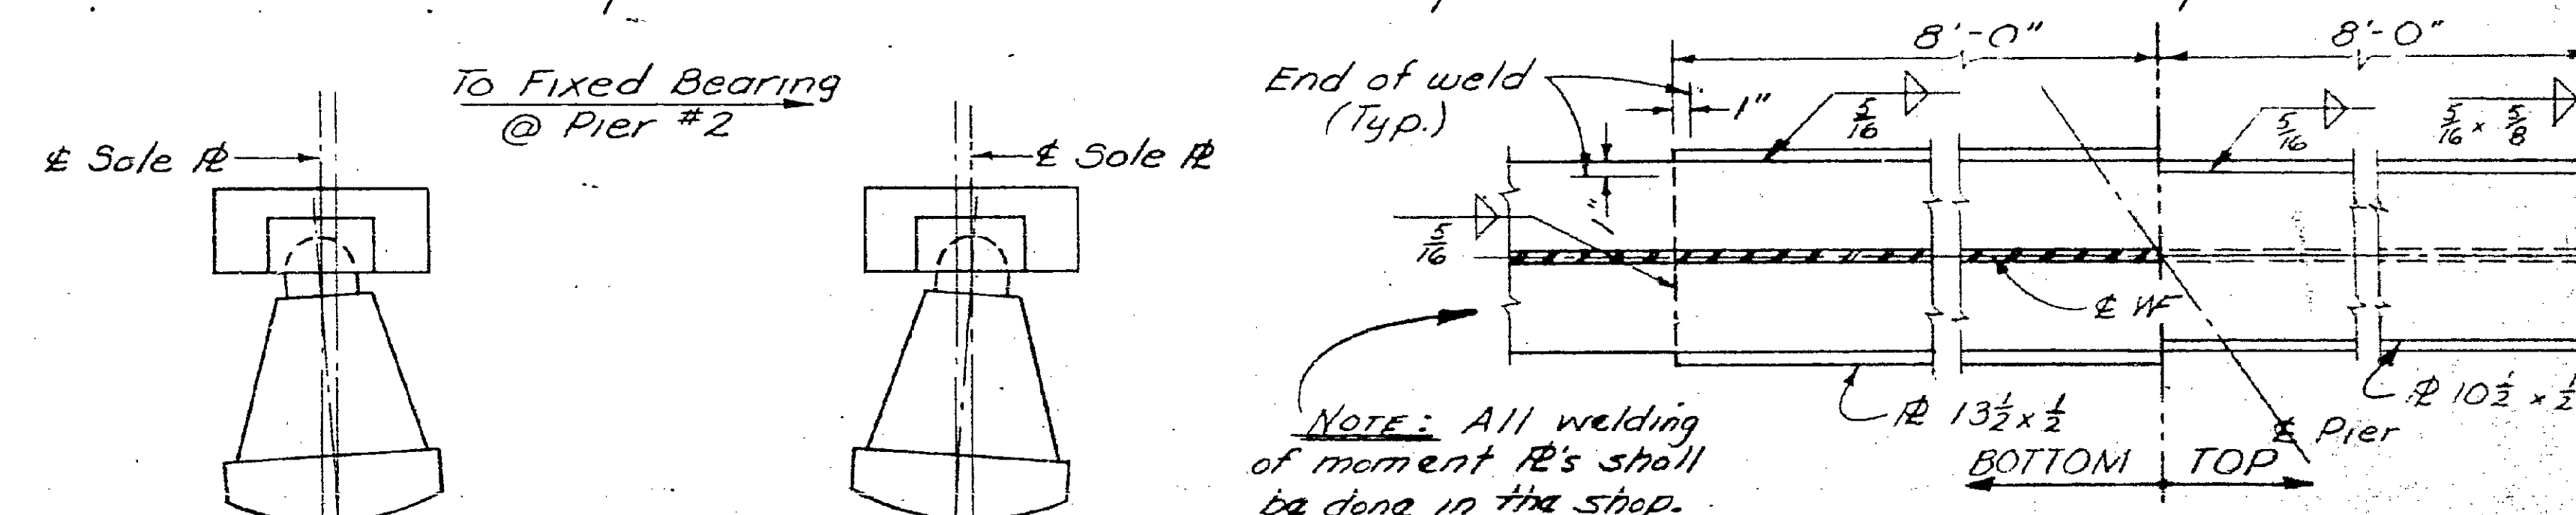

Location	"B"				"A"			
	0°	20°	40°	60°	80°	100°	120°	
Rear Abutment	9/16	3/8	3/16	0	3/16	3/8	9/16	
Pier #1	5/16	3/16	1/8	0	1/8	3/16	5/16	
Forward Abutment	1/4	3/16	1/16	0	1/16	3/16	1/4	

Dimension "A" & "B" to be measured parallel to & beam.

NOTE: After the bolsters at Pier #2 have been placed, splices completed and anchor bolts placed, the rockers at Pier #1 and at the Abutments shall be adjusted by the amount shown in the Table according to the prevailing temperature at time of erection.

BARRETT ASSOCIATED ENGINEERS, LIMITED
1500 W. FIRST AVE. COLUMBUS 12, OHIO


*SUPERSTRUCTURE DETAILS
WILSON RD OVER NYC RR.
FRANKLIN COUNTY
Sta. 42+46.89 to Sta. 44+43.41*

DESIGNED	DRAWN	TRACED	CHECKED	REVIEWED	DATE	REVISED
DM	WL		HM			

DETAIL OF TRANSVERSE DECK REINFORCING

5080	010	SUPERSTRUCTURE DETAILS			0063	1968	0080	060
------	-----	------------------------	--	--	------	------	------	-----

This drawing does not meet minimum filing standards! **MICRO-DATA** does not accept responsibility for the inferior results due to the condition of this drawing.

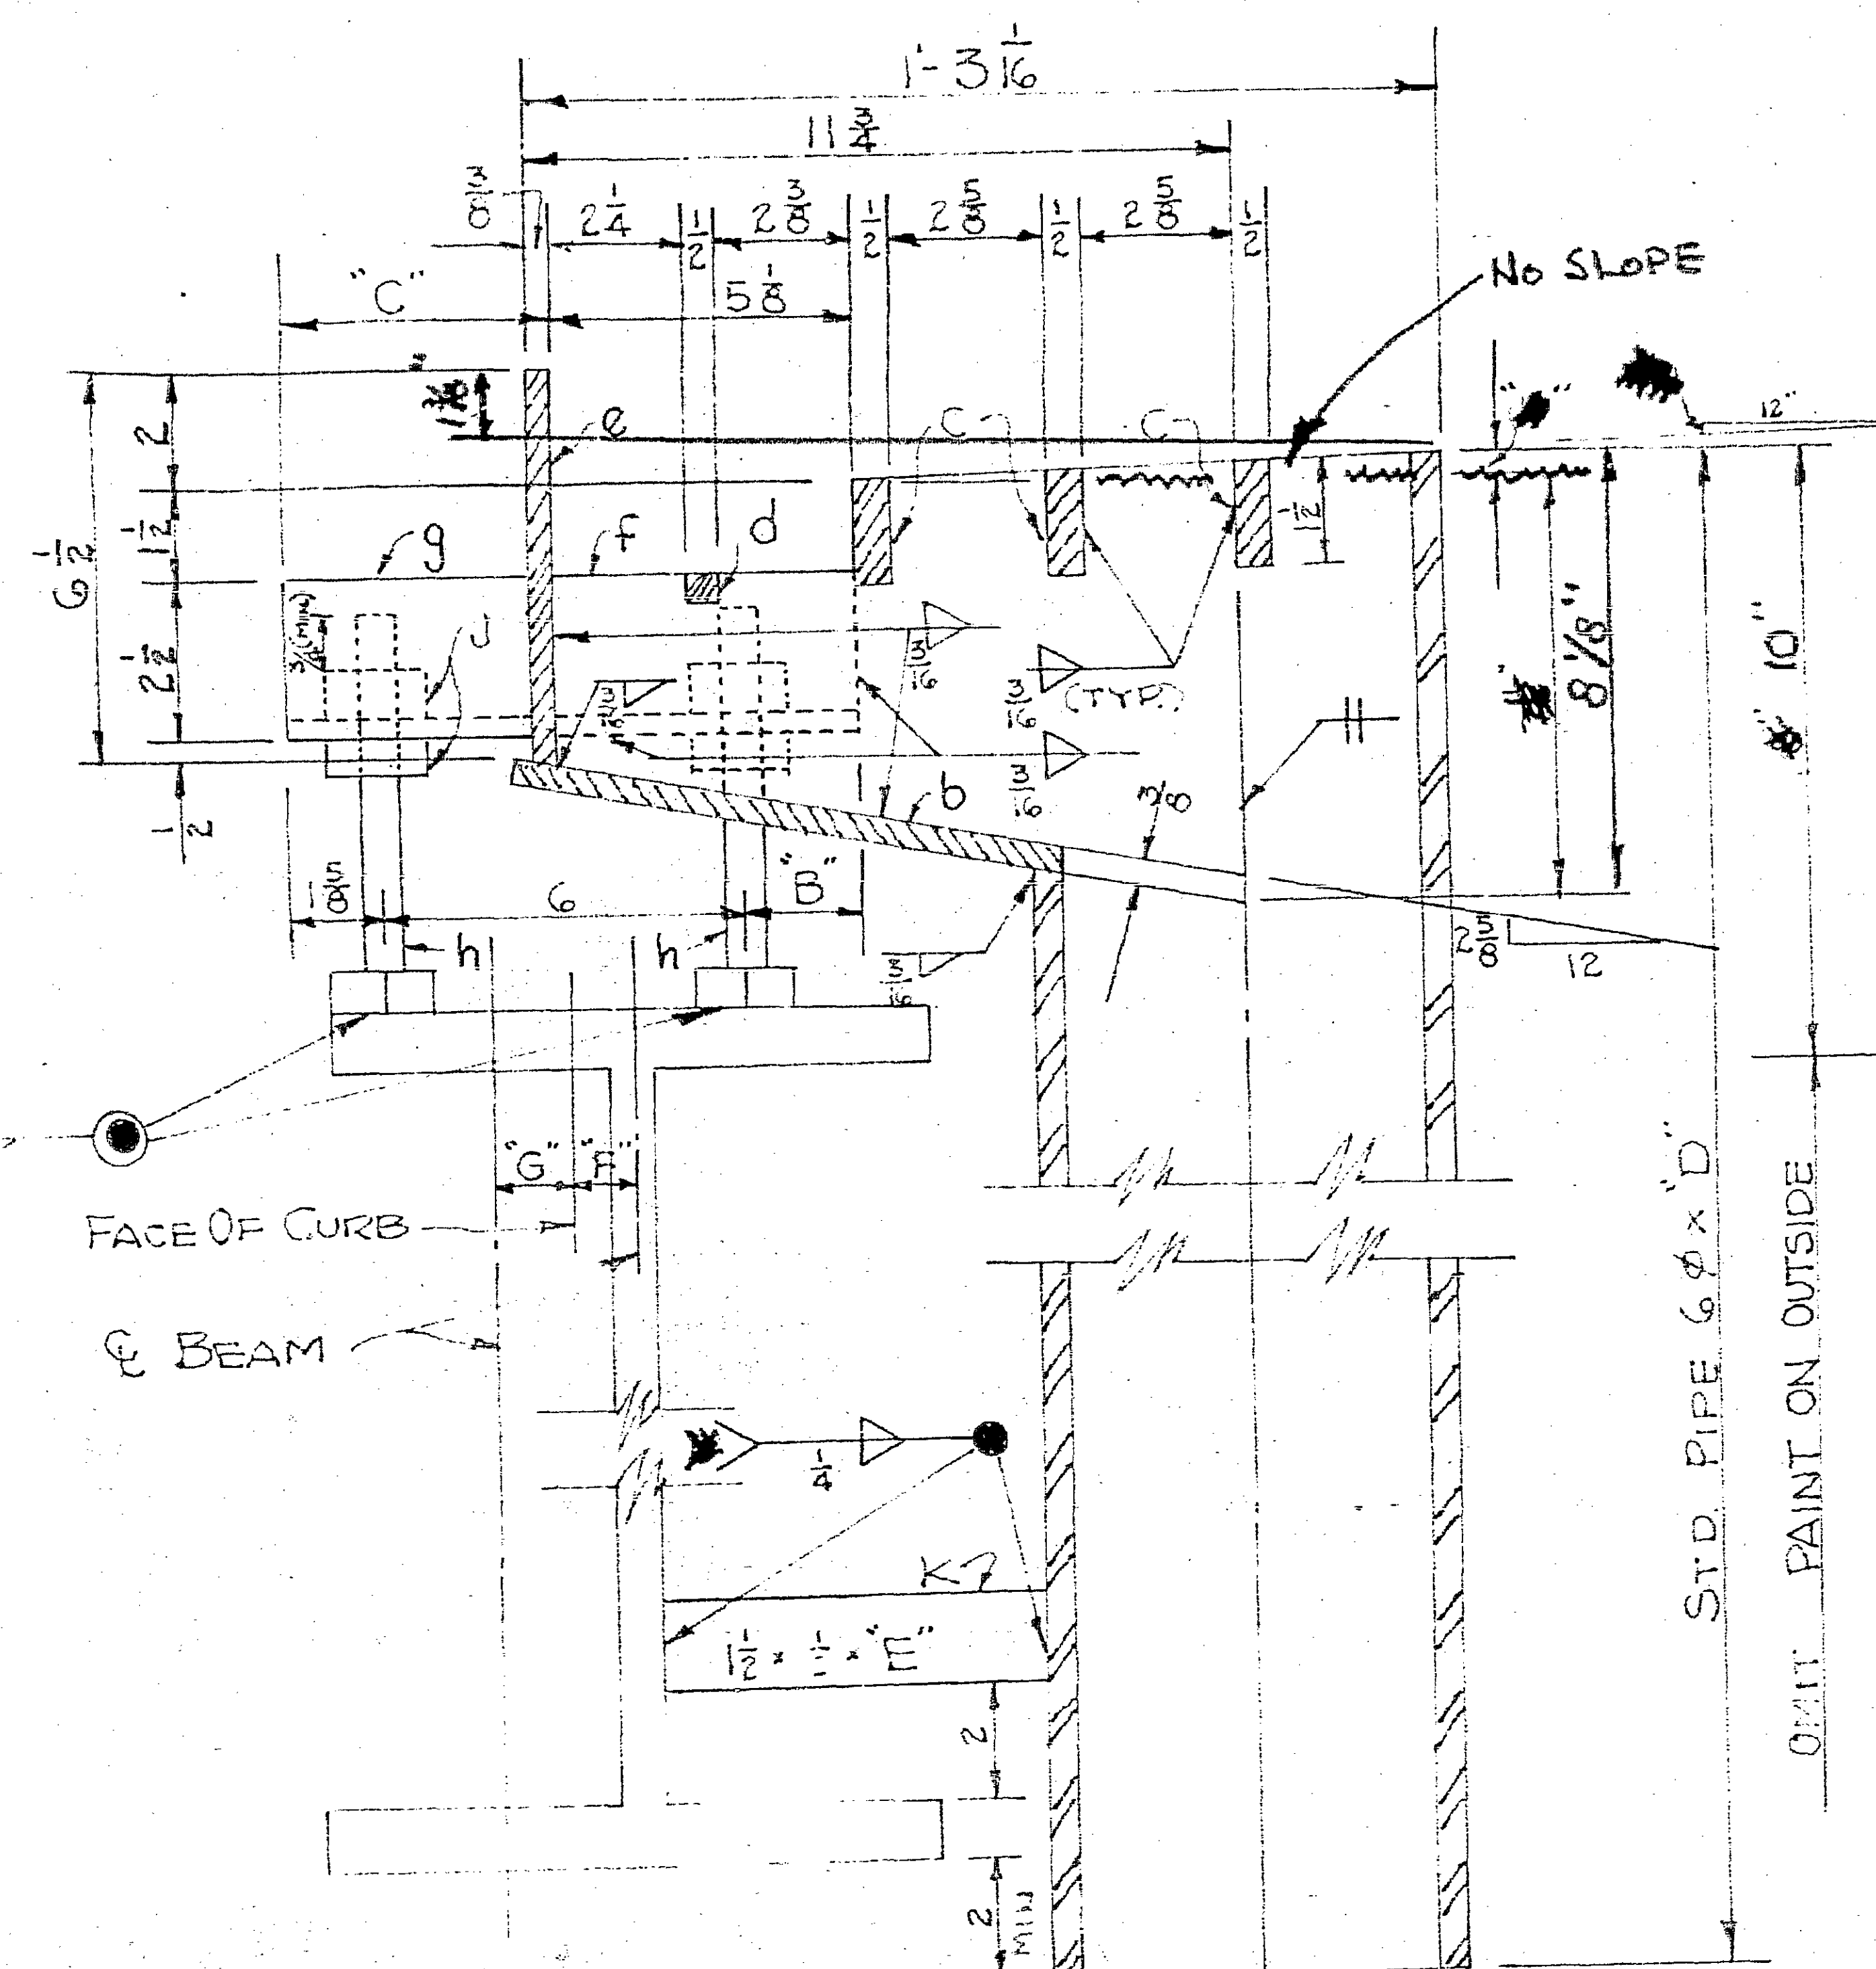

NOTE: ALL STEEL SHALL MEET REQUIREMENTS OF ASTM A-36
PIPE SHALL MEET REQUIREMENTS OF ASTM A 53

MARK BRIDGE & SCUPPER NO. ON SIDE OF PIPE.


BUREAU OF BRIDGES			
<i>C. H. Roberts</i>		Engineer of Bridges	
APPROVED	<i>11/2/40</i>	<i>RDM</i>	
APPROVED AS NOTED			
NOT APPROVED			
for general conformance with design plans and specifications only. Does not relieve contractor from responsibility for errors or			

SCUPPER DETAIL FOR
VISINTINE & CO.

Wilson Rd.

SUBSTANDARD DRAWING

This drawing does not meet minimum filming standards: MICRO-DATA does not accept responsibility for the inferior results due to the condition of this drawing.

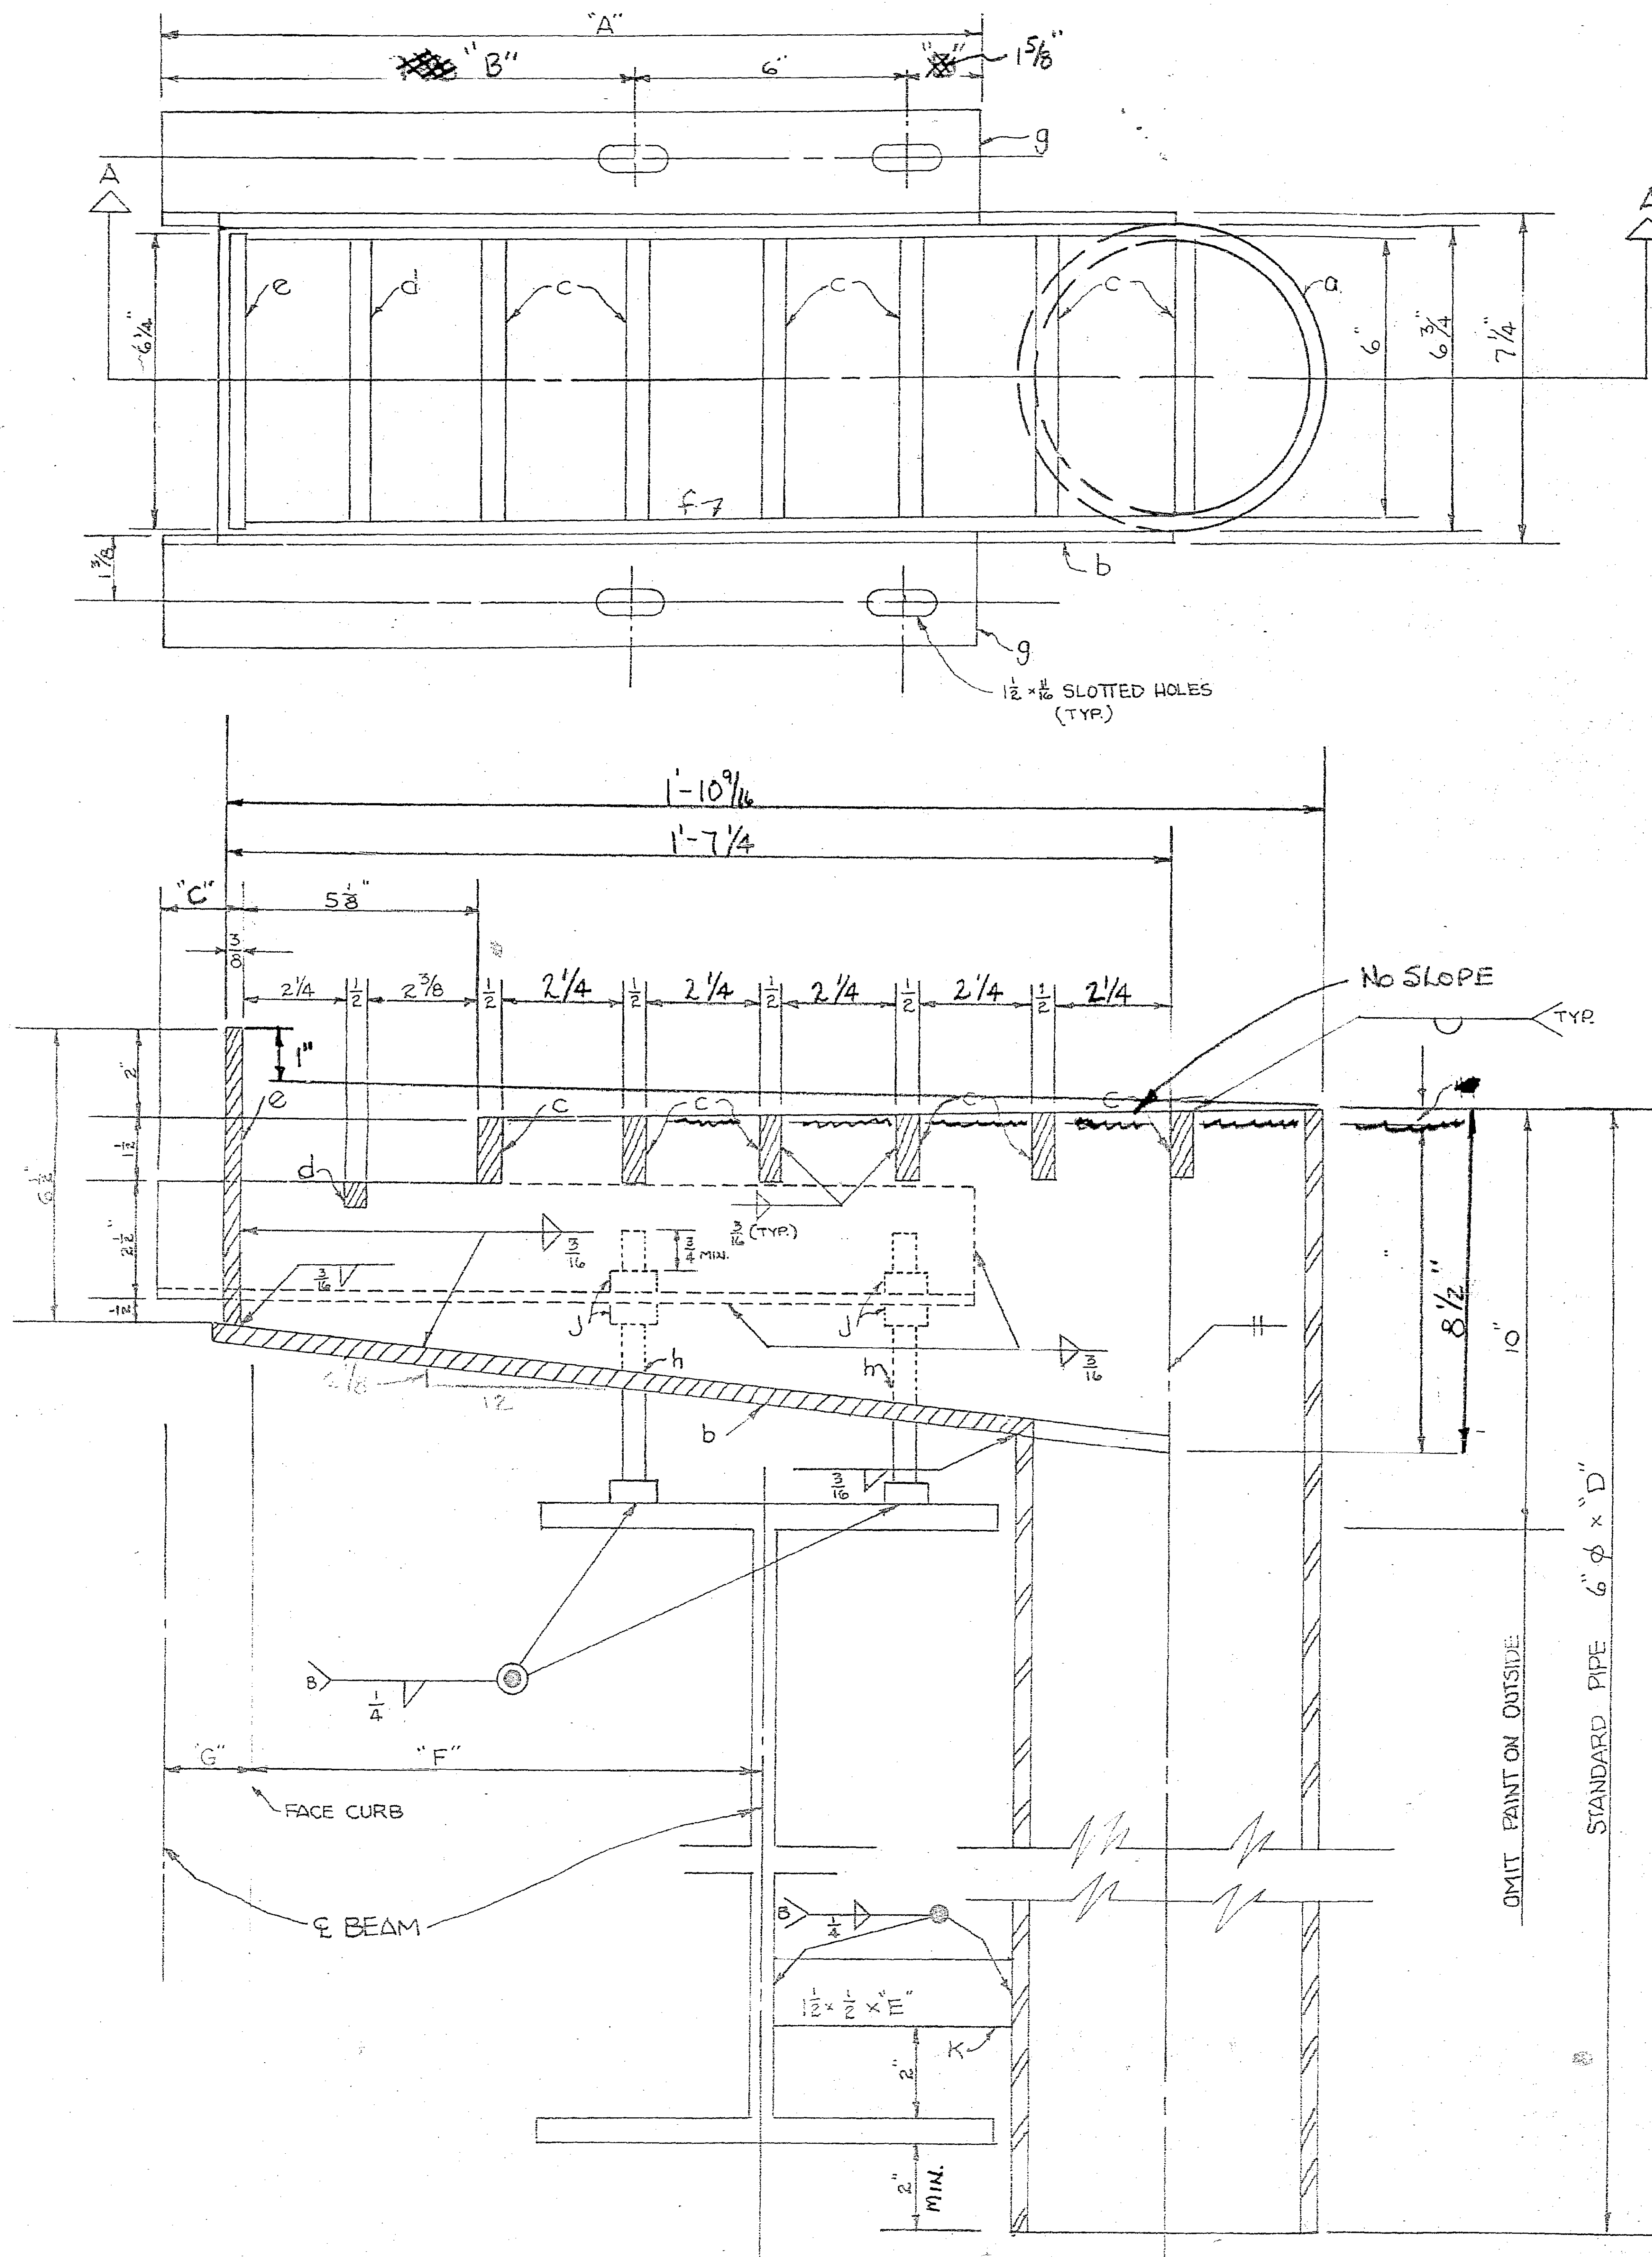

SECTION A-A

ITEM	NO.	MATERIAL
a	1	6" ϕ STANDARD BLACK IRON PIPE $\times$ "D"
b	1	HOT ROLLED STEEL $\frac{3}{8} \times 7\frac{1}{4} \times 1'-7\frac{3}{4}"$
c	6	HOT ROLLED STEEL $\frac{1}{2} \times 1\frac{1}{2} \times 6"$
d	1	HOT ROLLED STEEL $\frac{1}{2} \times \frac{1}{2} \times 6"$
e	1	HOT ROLLED STEEL $\frac{3}{8} \times 6\frac{1}{4} \times 6\frac{9}{16}"$
f	2	HOT ROLLED STEEL $\frac{3}{8} \times 6\frac{1}{4} \times 1'-6\frac{7}{8}"$
g	2	ANGLE IRON $2\frac{1}{2} \times 2\frac{1}{2} \times \frac{1}{4} \times "A" - 8\frac{1}{8}"$
h	4	STANDARD $\frac{5}{8} \times 6"$ BOLTS
j	8	STANDARD $\frac{5}{8}$ HEX NUT
k	1	HOT ROLLED STEEL $\frac{1}{2} \times 1\frac{1}{2} \times "E" (SHIP LOOSE) (CUT TO FIT IN FIELD)$

NOTE: ALL STEEL SHALL MEET REQUIREMENTS OF ASTM A-36
PIPE SHALL MEET REQUIREMENTS OF ASTM A-53

NOTE: PAINT INSIDE & OUTSIDE OF SCUPPER COMPLETE
EXCEPT PORTION IN CONTACT WITH CONCRETE
AS PER O.S.H.D. SPEC. ~~514.04~~ 514.04
USING SEC-708.07

MARK BRIDGE & SCUPPER NO. ON SIDE OF PIPE.

SCUPPER		SCHEDULE							
NO.	SCUPPER	DIMENSIONS							
REQD	NO.	"A"	"B"	"C"	"D"	"E"	"F"	"G"	"H"
1EA	25-3	9/4	1 5/8	1 3/8	4'-0 1/2	1'-0 3/8	2 3/16	-	-
1EA	25-4	10	2 3/8	0	4'-0 1/2	10/8	4 15/16	-	-
1EA	25-5	10 3/8	2 3/4	0	4'-0 1/2	9 3/4	5 3/8	-	-
1EA	25-6	11 7/8	4 1/4	0	4'-0 1/2	8 1/4	6 7/8	-	-
1EA	25-7	1'-1 3/4	6 1/8	0	4'-0 1/2	6 1/2	8 1/16	-	-

NOTE:
ALL FIG. "F" OR "G" ARE
APPROX ONLY AND SCUPPERS
TO BE SET BY ADJUSTMENT
OF BOLTS ON BEAM FLANGE

BUREAU OF BRIDGES	
APPROVED	1/2/66 RDM
APPROVED AS NOTED	
NOT APPROVED	
for general conformance with design plans and specifications only. Does not relieve contractor from responsibility for errors or omissions.	

DRAWING NO 2 OF 2

SIDNEY MACHINE MANUFACTURING
SIDNEY, OHIO

SCUPPER DETAIL FOR
VISINTINE & CO.

BUREAU OF BRIDGES
DATE APPROVED
10-19-66


DRAWN BY
A.R.W.
CHECKED BY
J.F.

10-4-66


BRIDGE NO.
FRANKLIN COUNTY #25

PROJECT NO.
171(66)


5080 010 SHOP DWG. SCUPPER DETAILS 0063 1968 0100 060

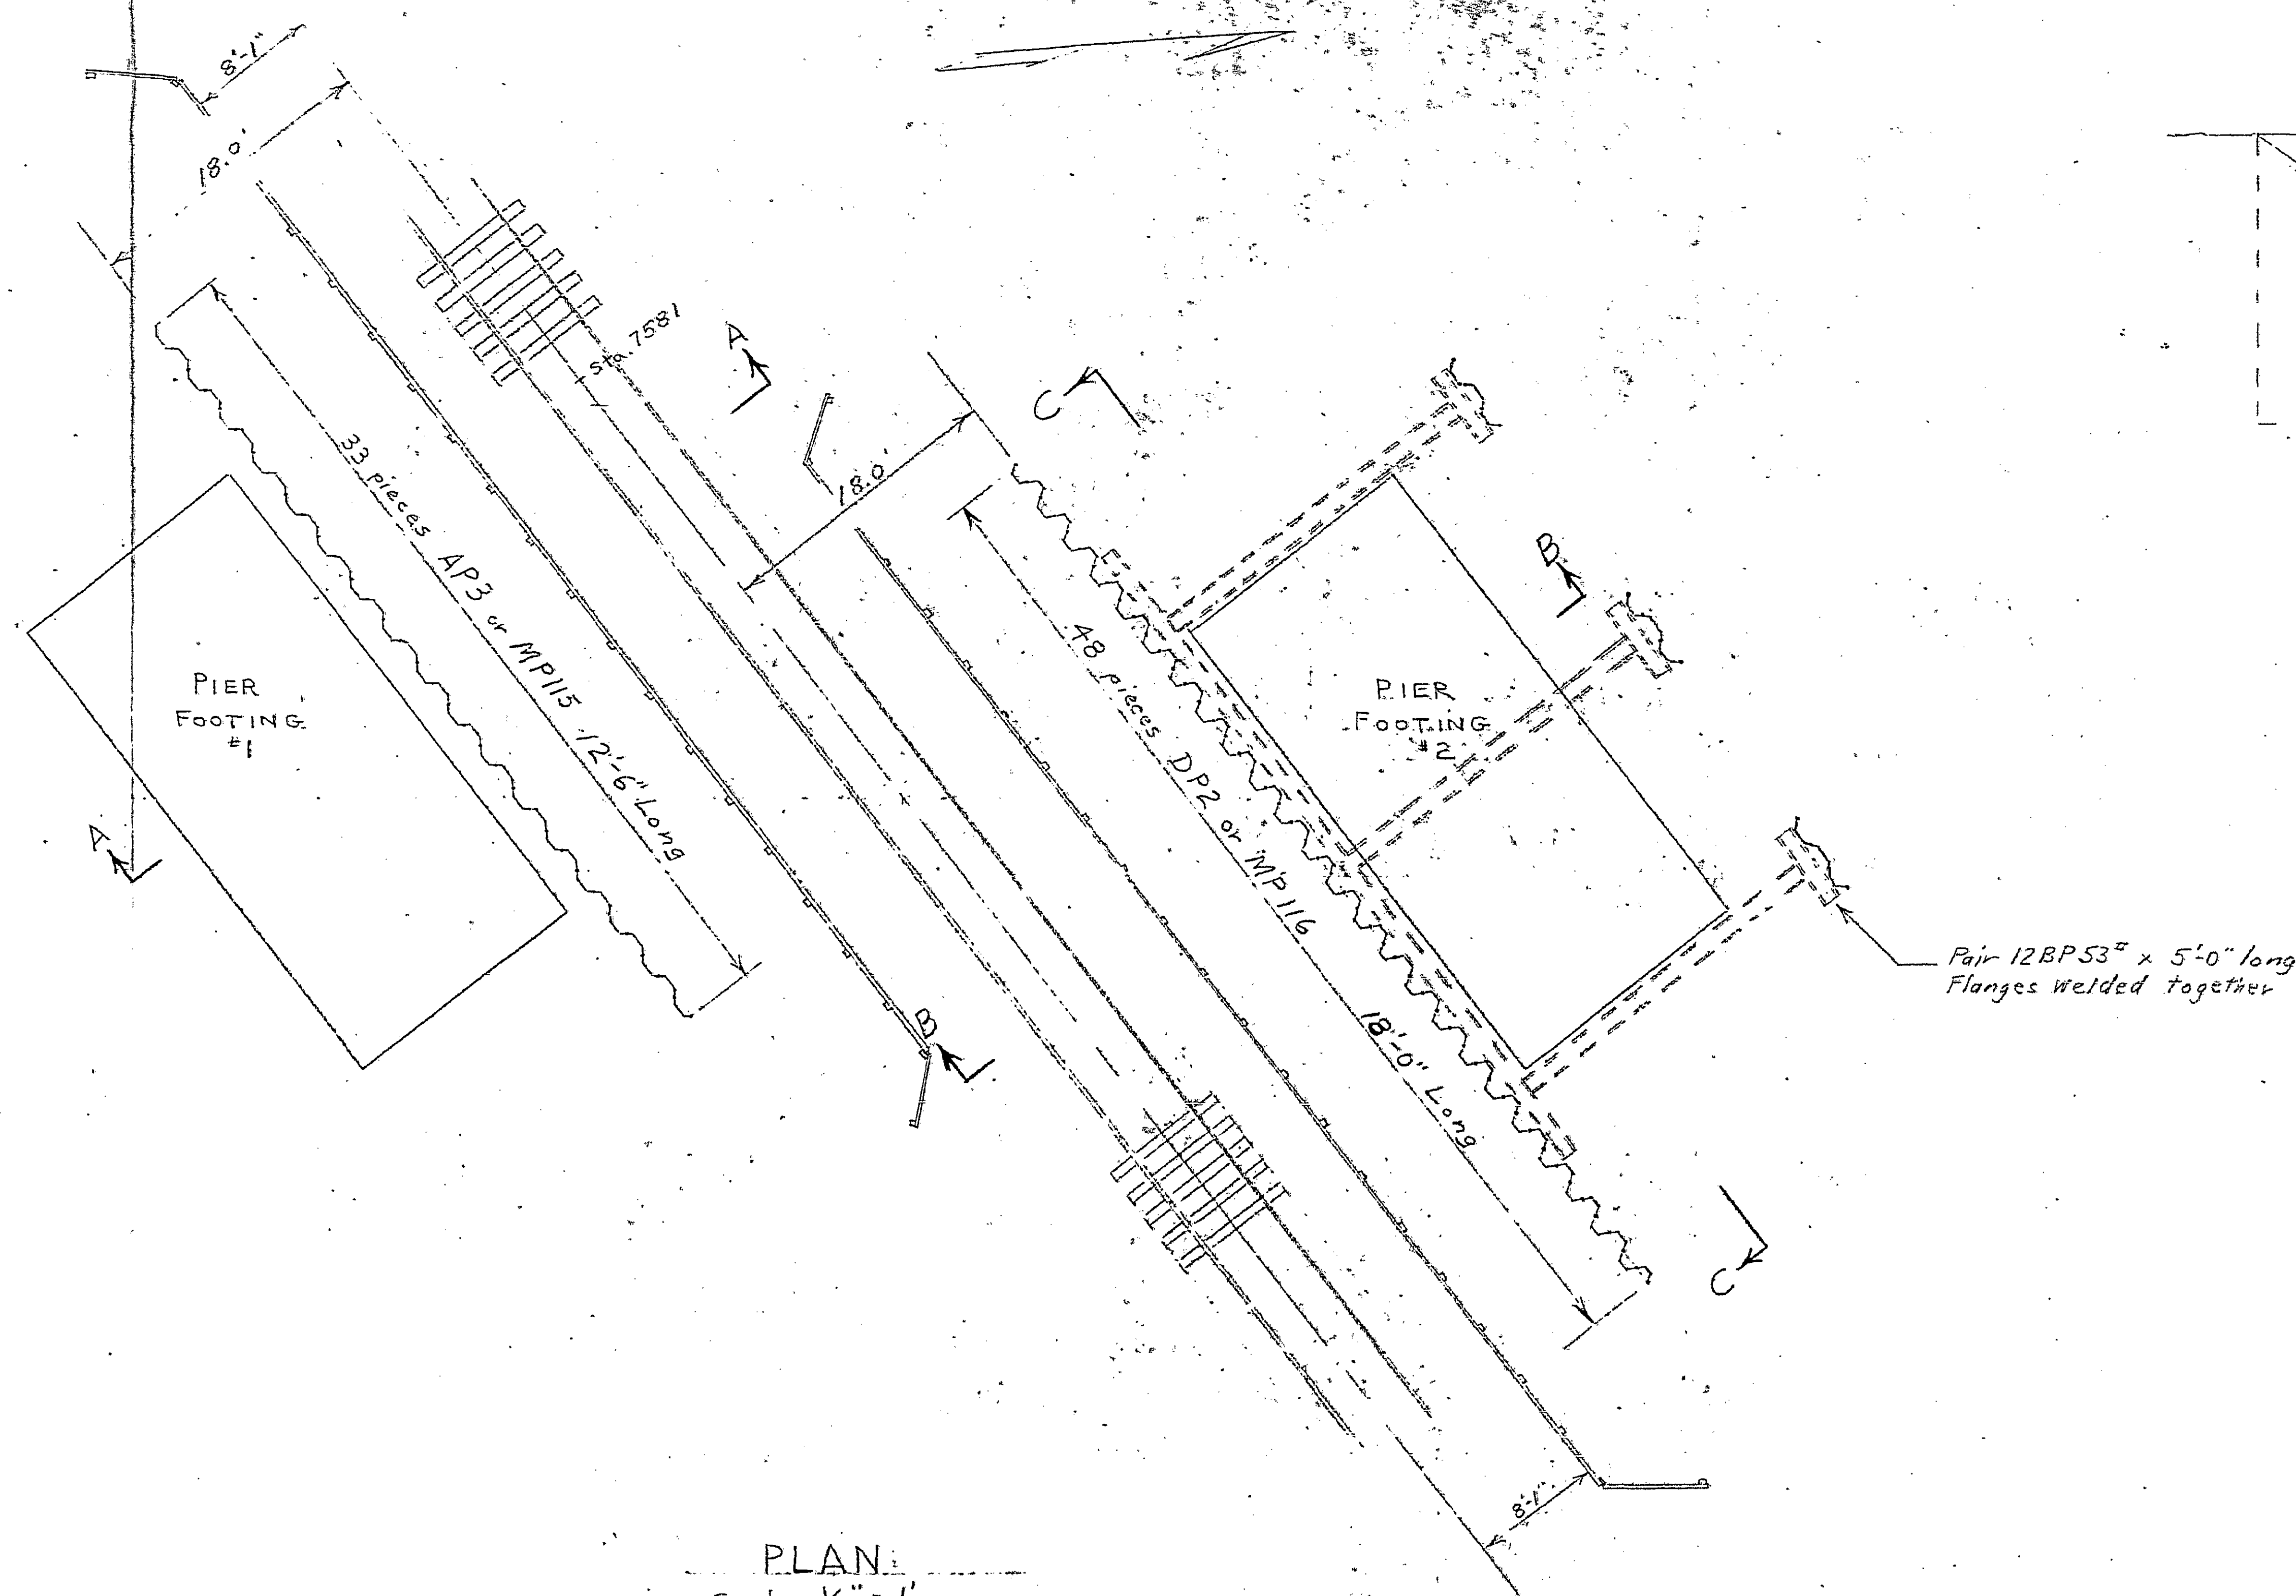

PLAN
Scale 1/8" = 1'

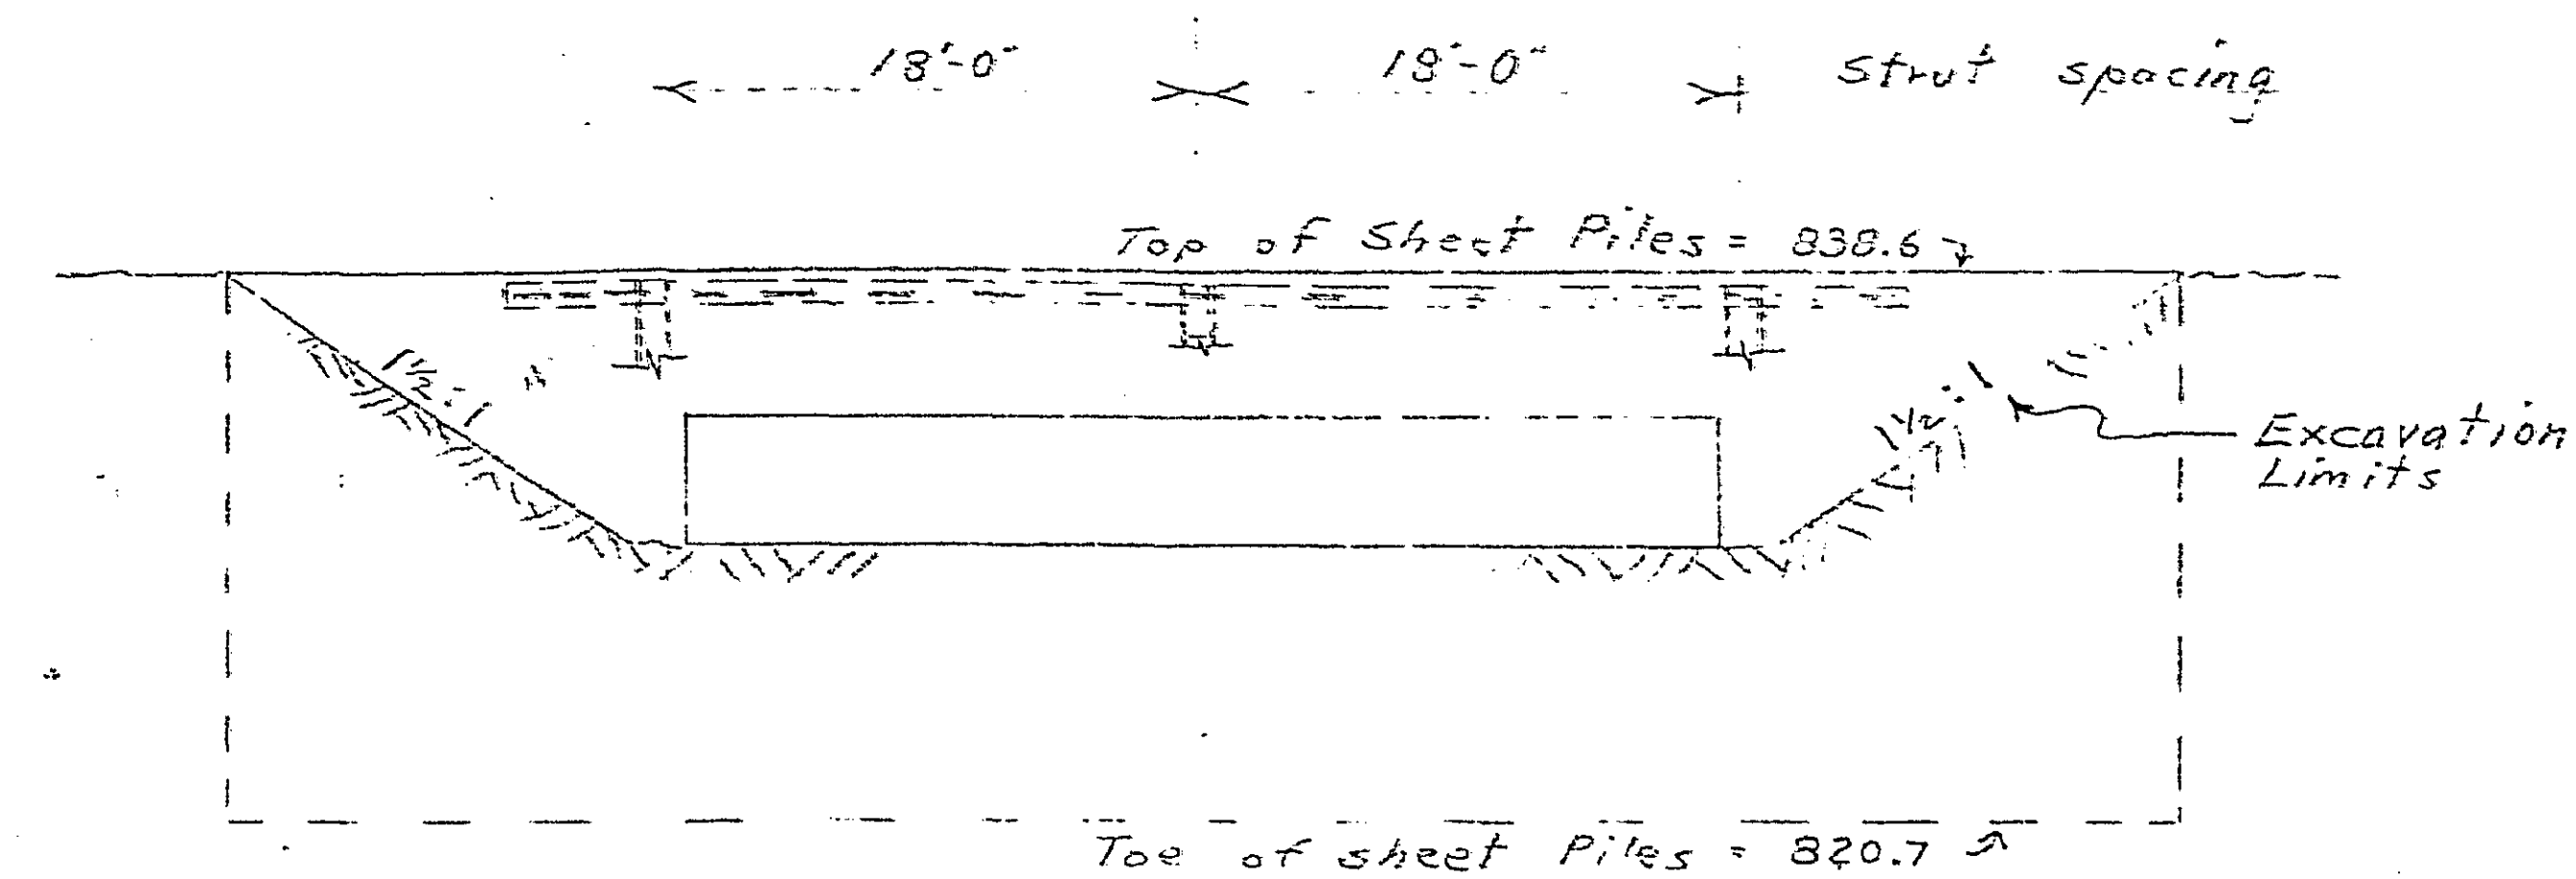


SECTION CC
1/8" = 1'

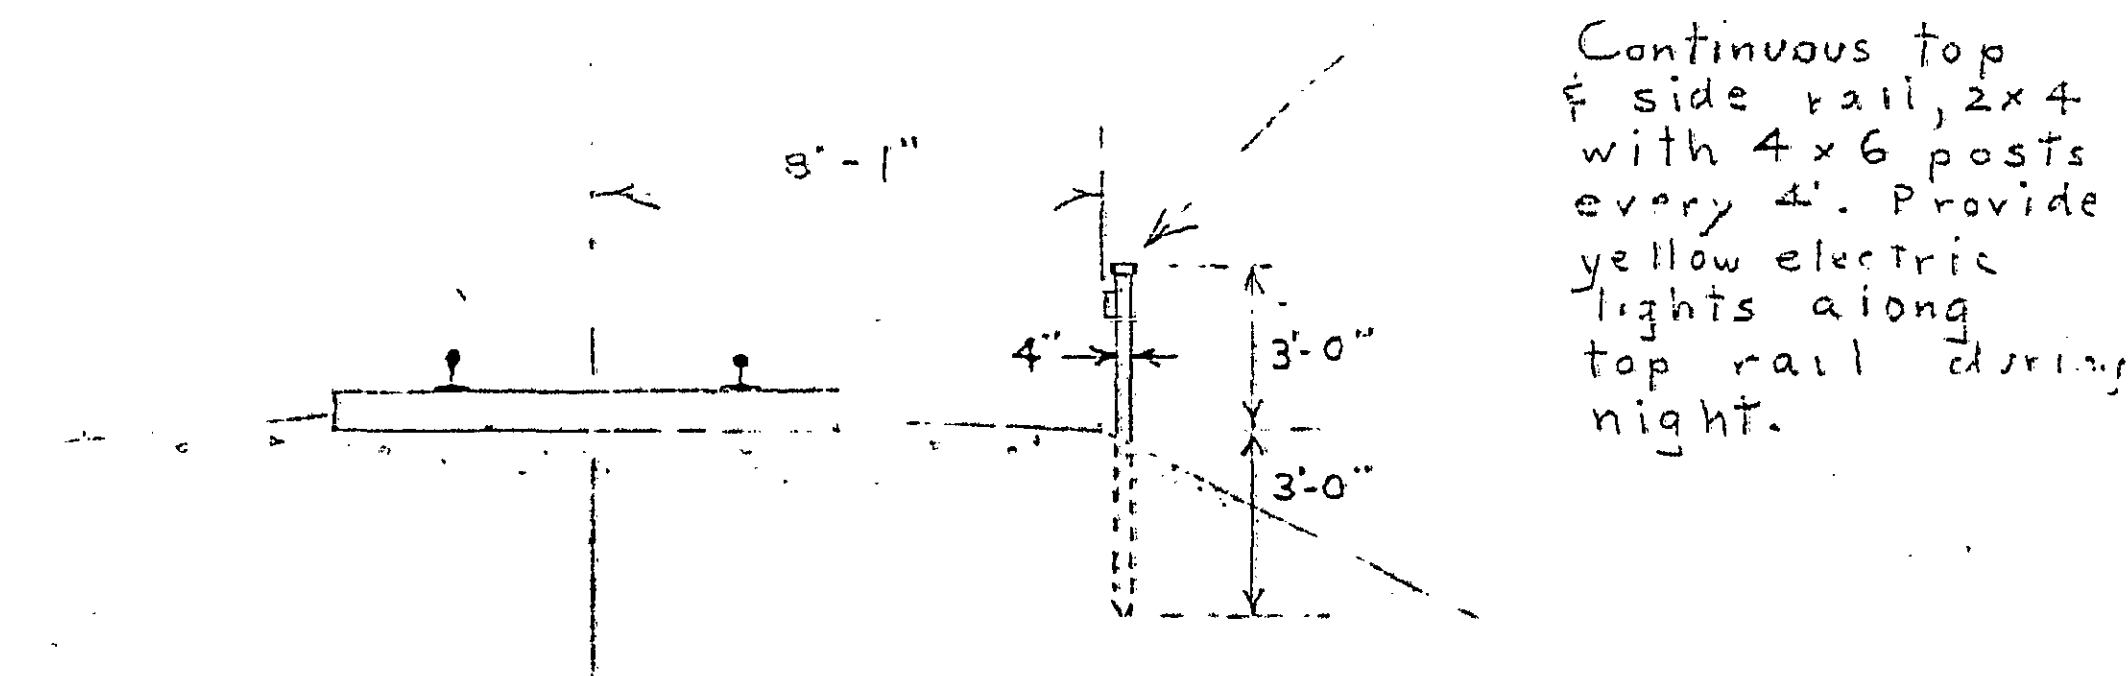

HANDRAIL DETAIL

NOTE

Wale & Strut system to be required at pier #2 if ground water is present at Elevation 829.69.
Struts to be attached by minimum of 30" of 3/16" fillet weld (outside of flanges & one side of web) at each end.
Place two stiffeners 1/2"x4" each side of wale web opposite strut flanges & weld all around with 3/16" fillet.

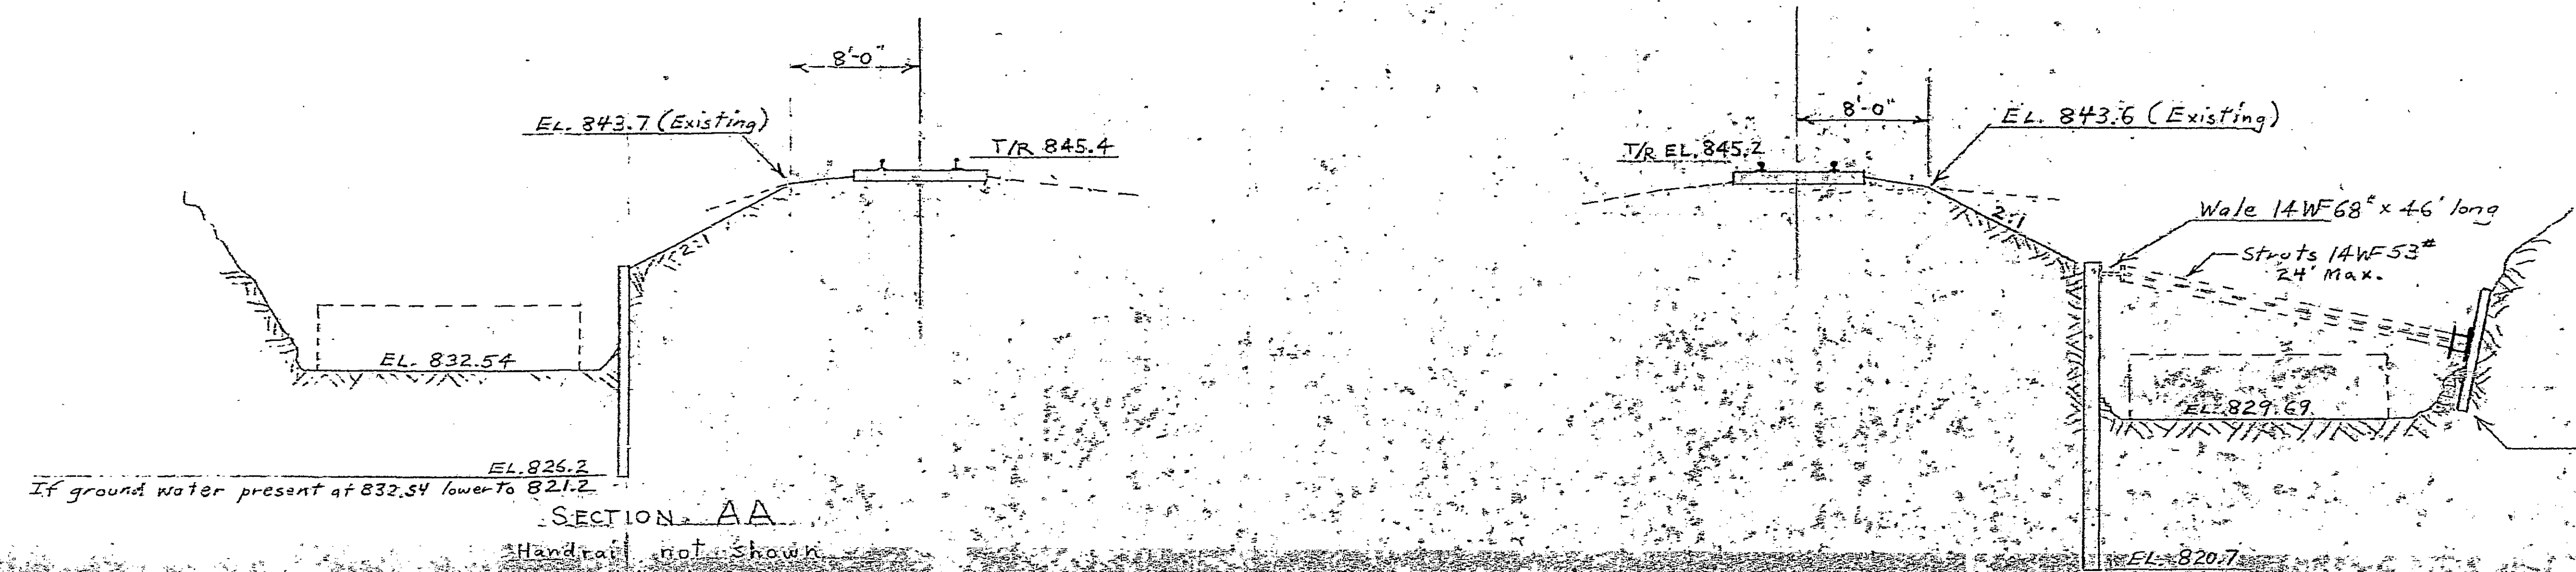

SECTION AA
Handrail not shown

SECTION BB
Handrail not shown


BUREAU OF BRIDGES		
C.H. Appert, Engineer of Bridges		
APPROVED	BFG	SEP 13 1966
APPROVED A.C. 1966		
NOT APPROVED		
for general construction with design plans and specifications only. Does not relieve contractor from responsibility for errors or omissions.		

063
Fra 25-
Wilson Rd
3-3-2


SHEETING & PROTECTION FOR
NEW YORK CENTRAL RAILROAD
Project 171-1966
Franklin County Road 25
Vigilant Company
John A. Chapman, PE. July 14, 1966
Revised July 26, 1966 - Rev. Aug. 29, 1966

a
b
c
d
e
f
g
h
i
j
k
l
m
n
o
p
q
r
s
t
u
v
w
x
y

CONTRACT 20352-B/1

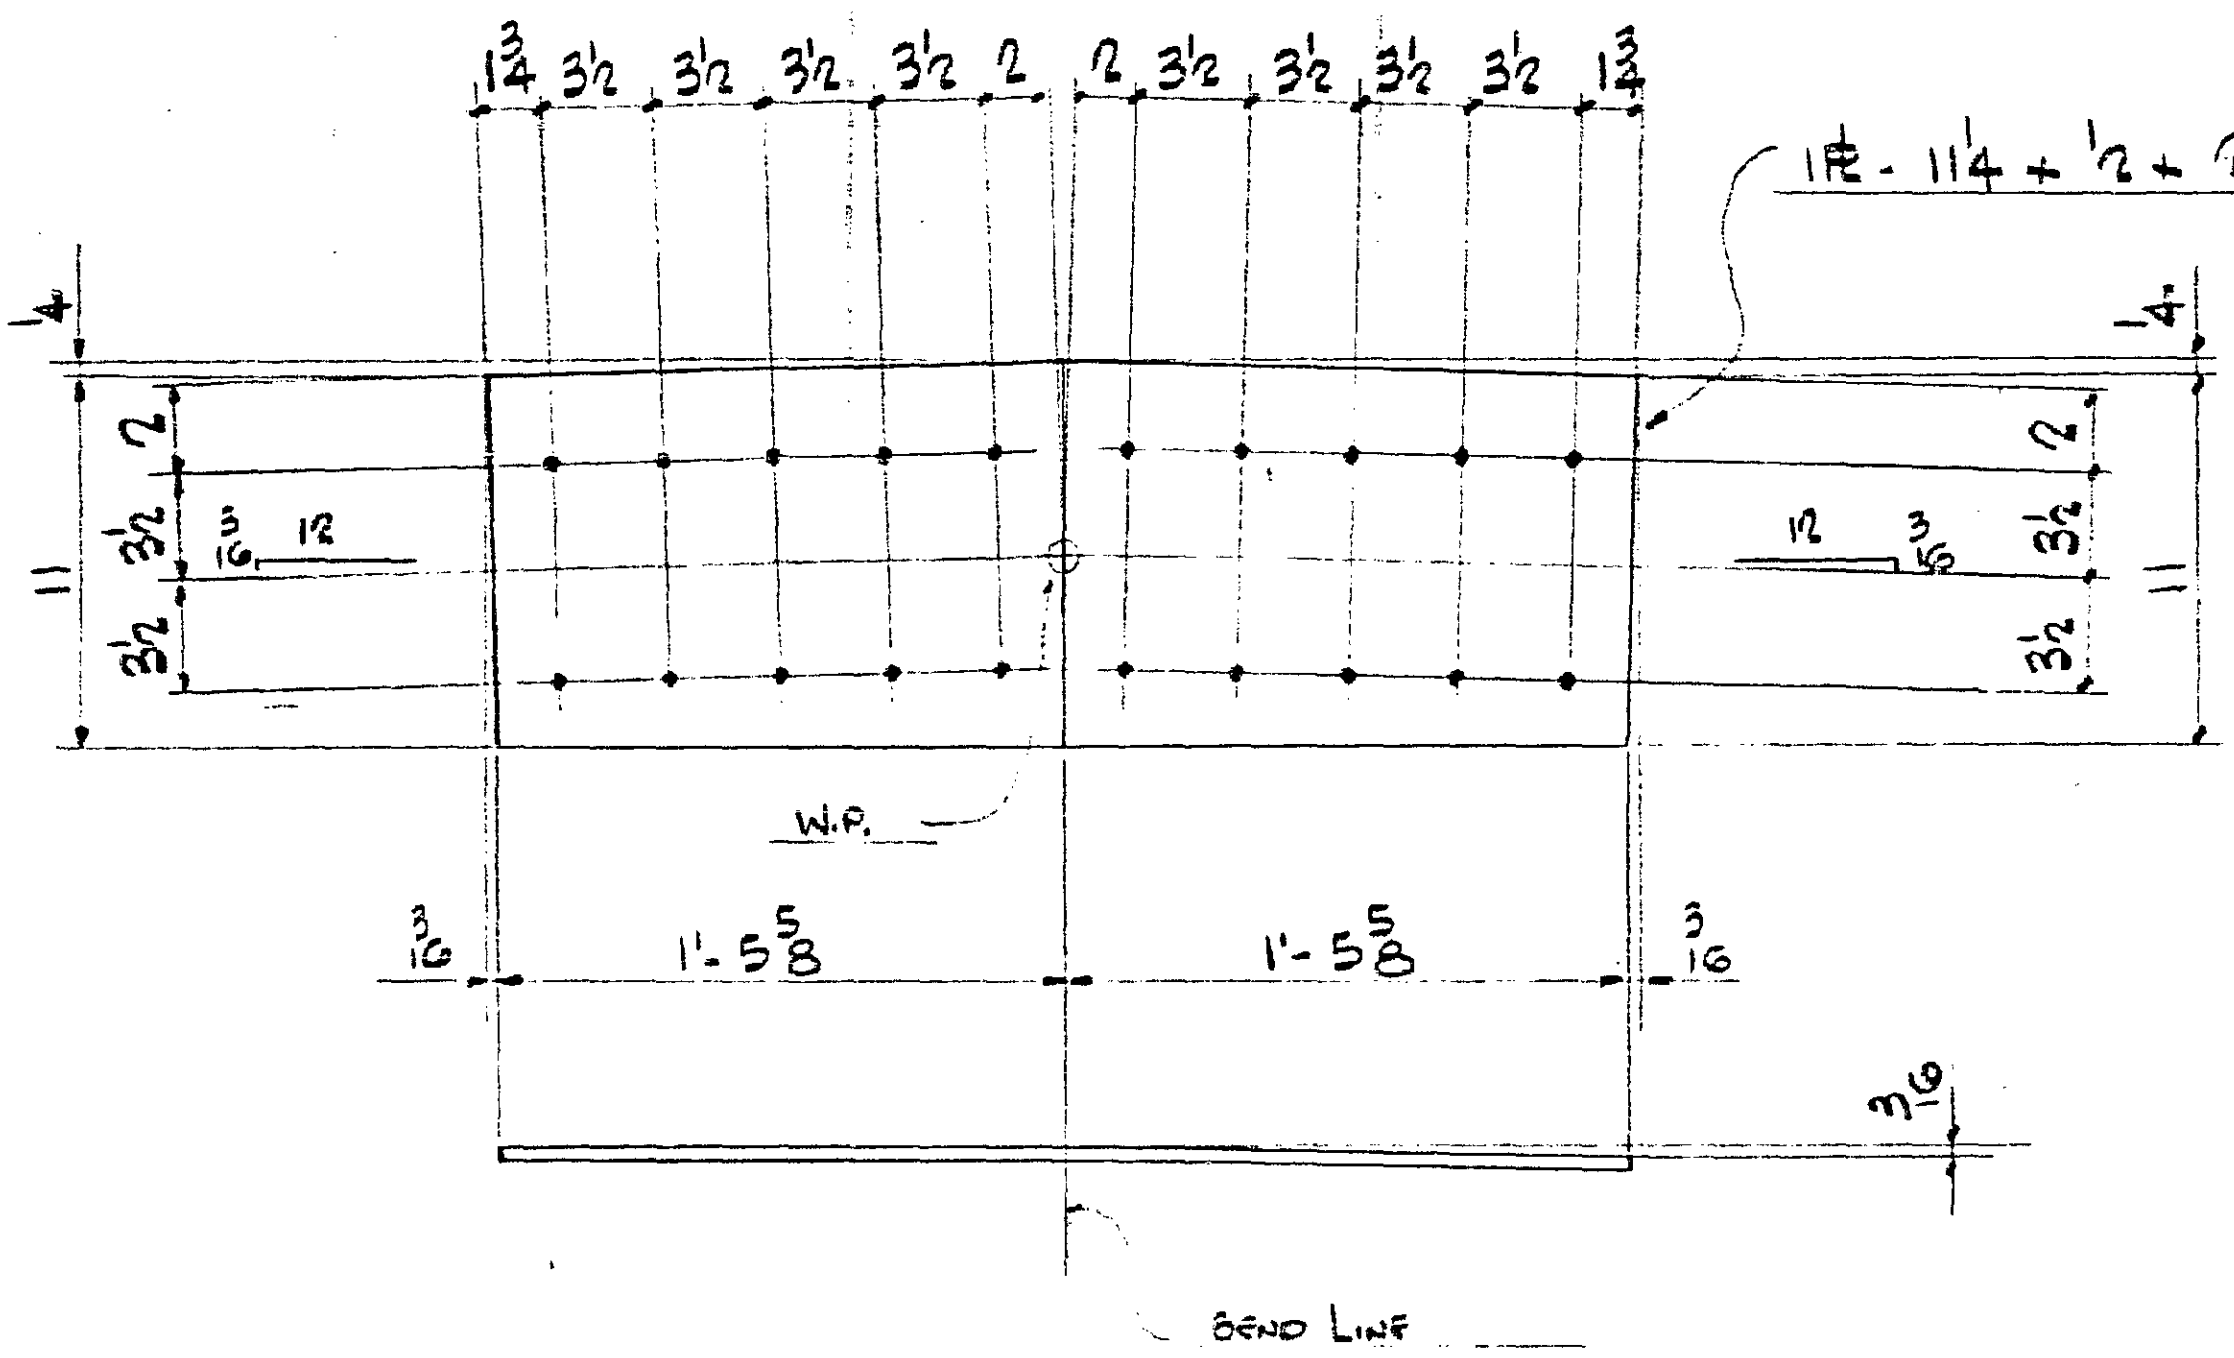


24 - SPLICE PLATES - P1

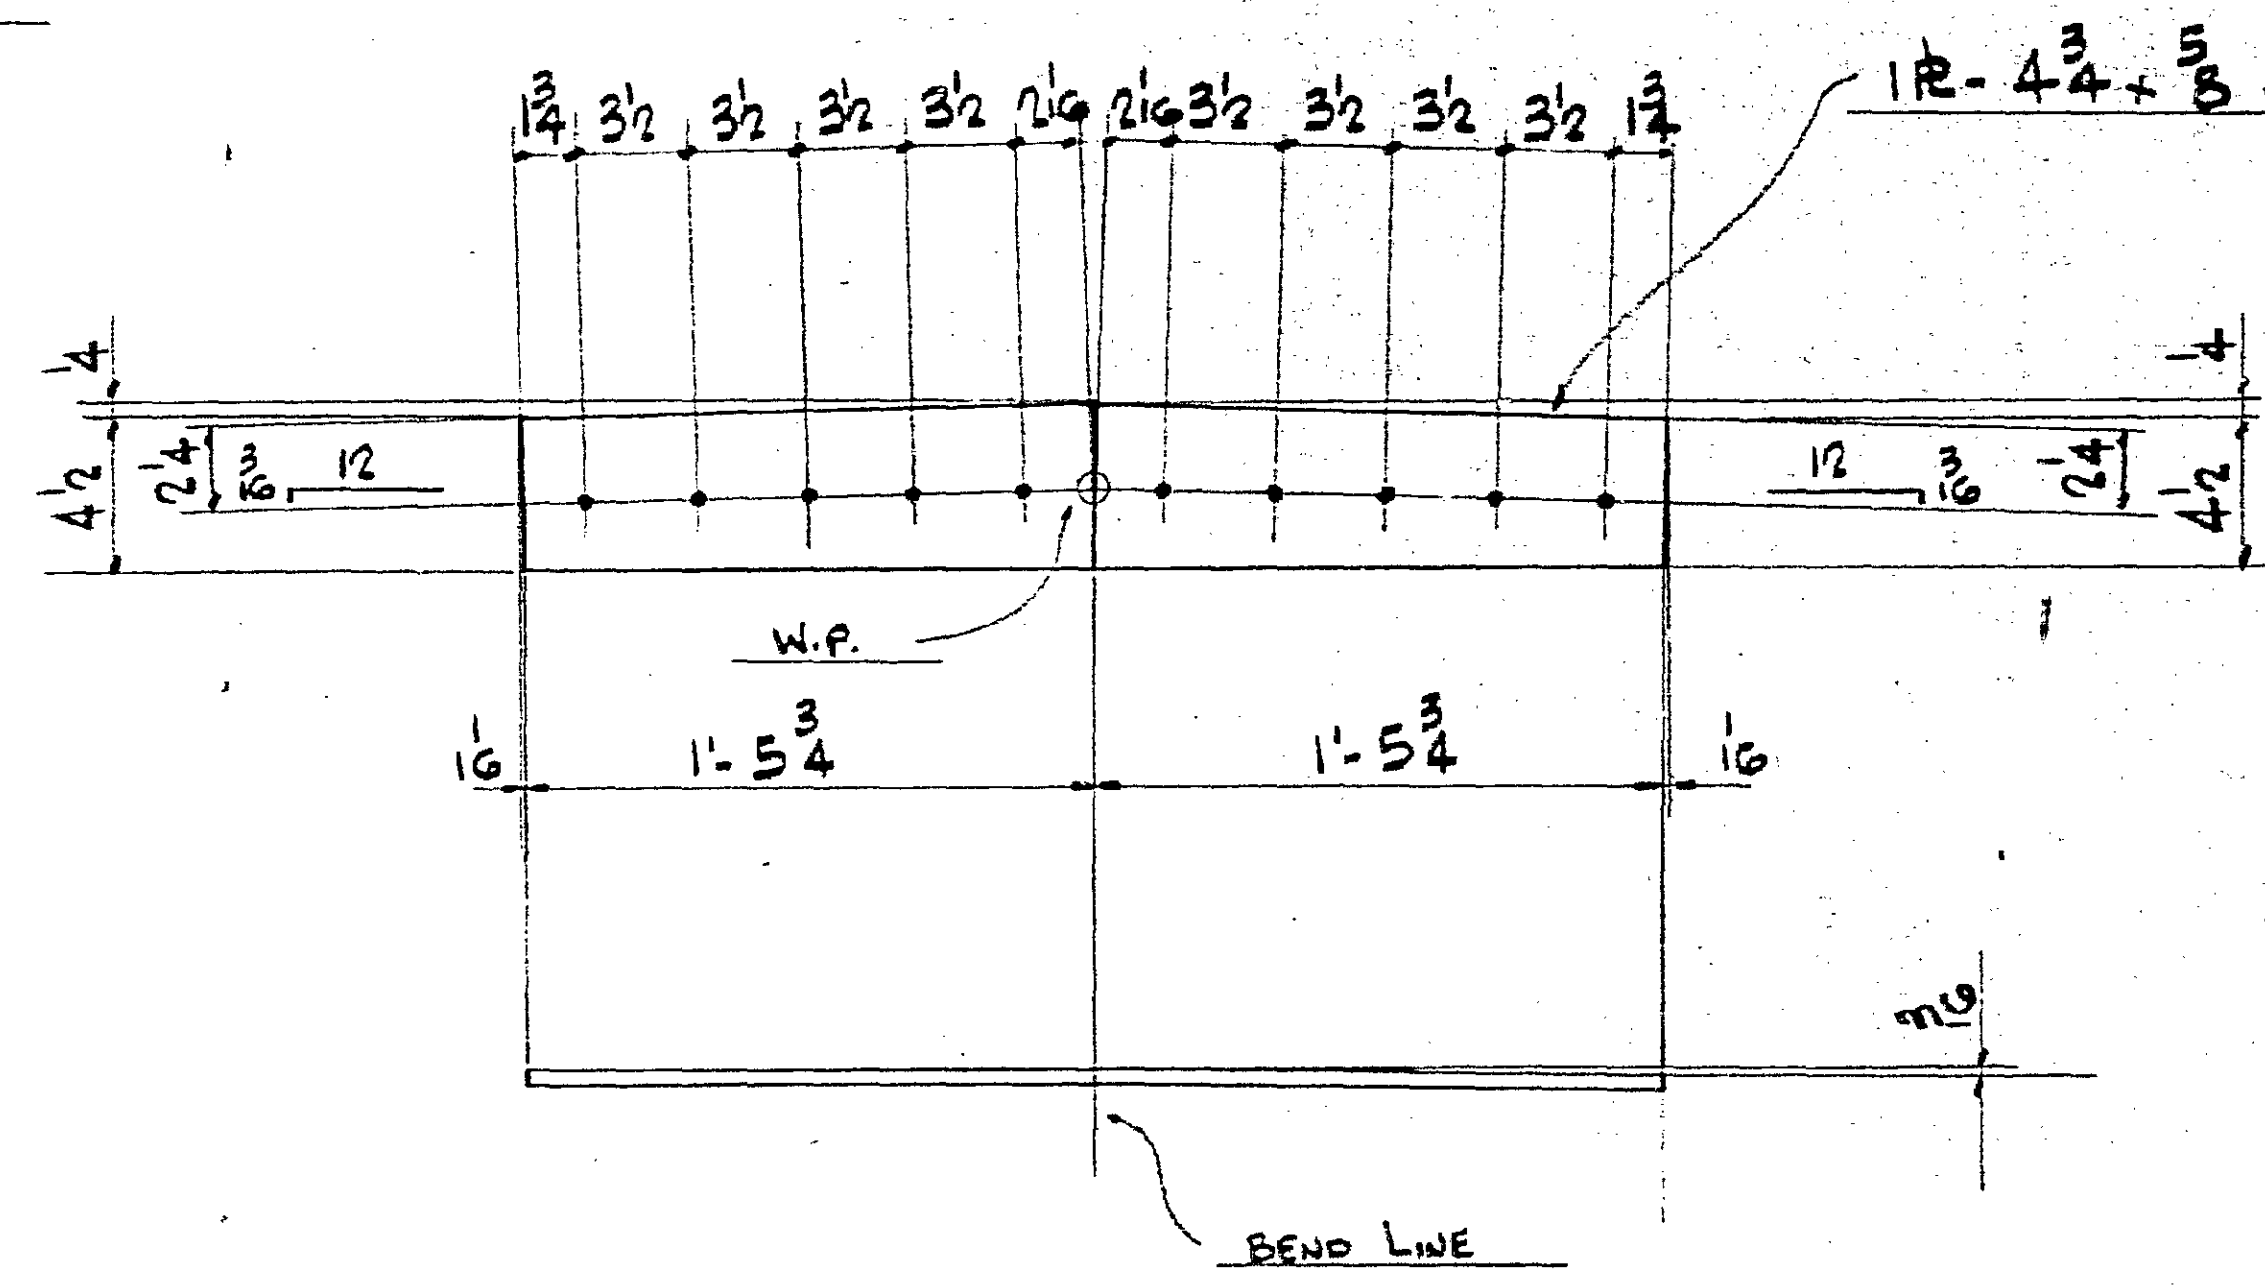


24 - SPLICE PLATES - P2

SHOP NOTES!
ALL MATERIAL A36 STEEL
HOLES SUB-PUNCHED OR SUB-DRILLED 1/8" & REAM
HOLES TO 1/8"
HOLES MAY BE DRILLED FULL SIZE IF ALL SPLICE PLATES
ARE HELD IN PLACE DURING DRILLING (DRILL THRU BEAM &
PLATES TOGETHER) REMOVE ALL BURRS

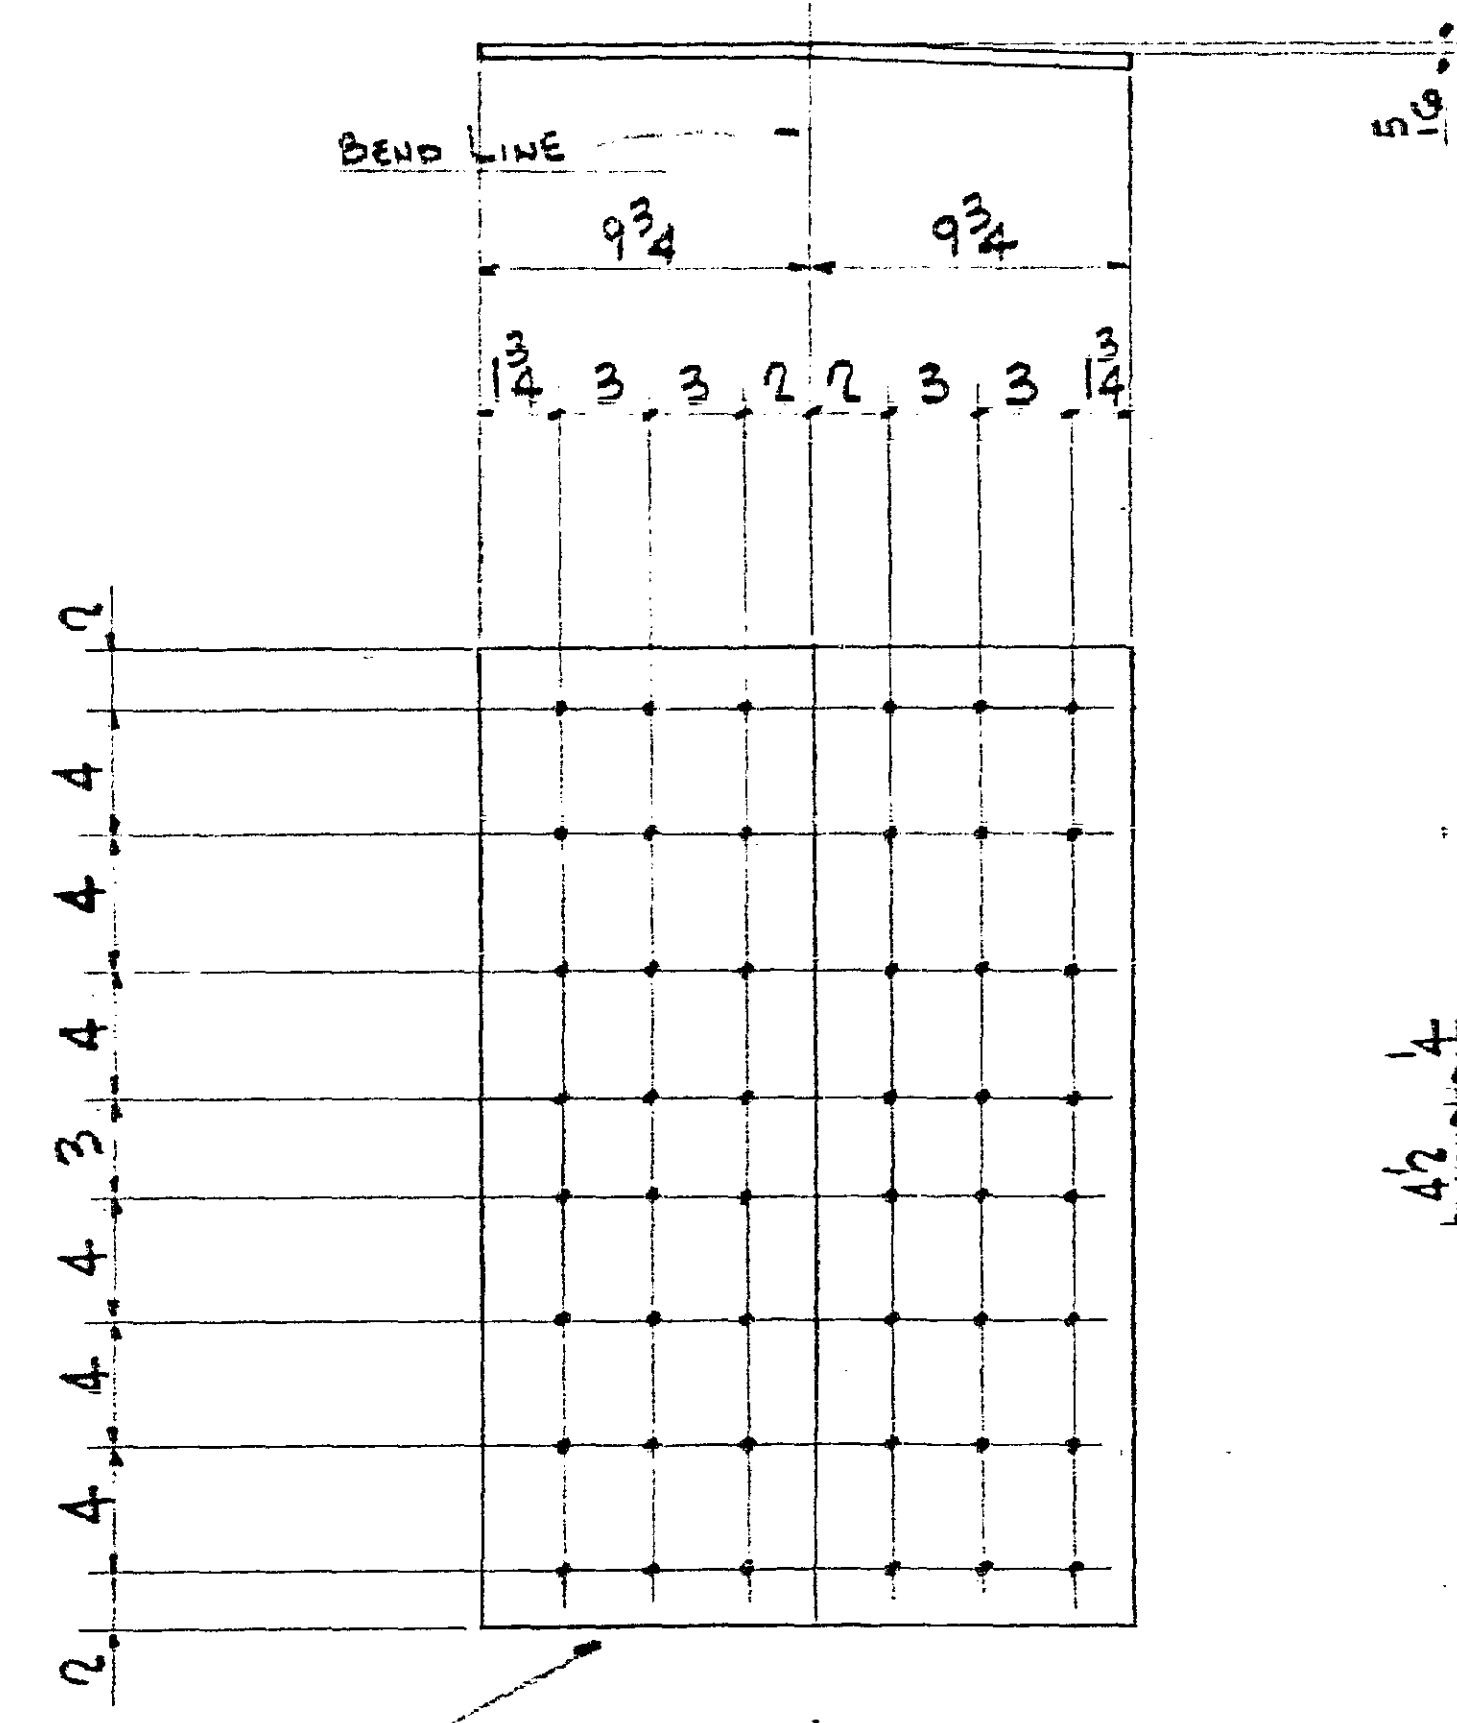

24 - SPLICE PLATES - P3

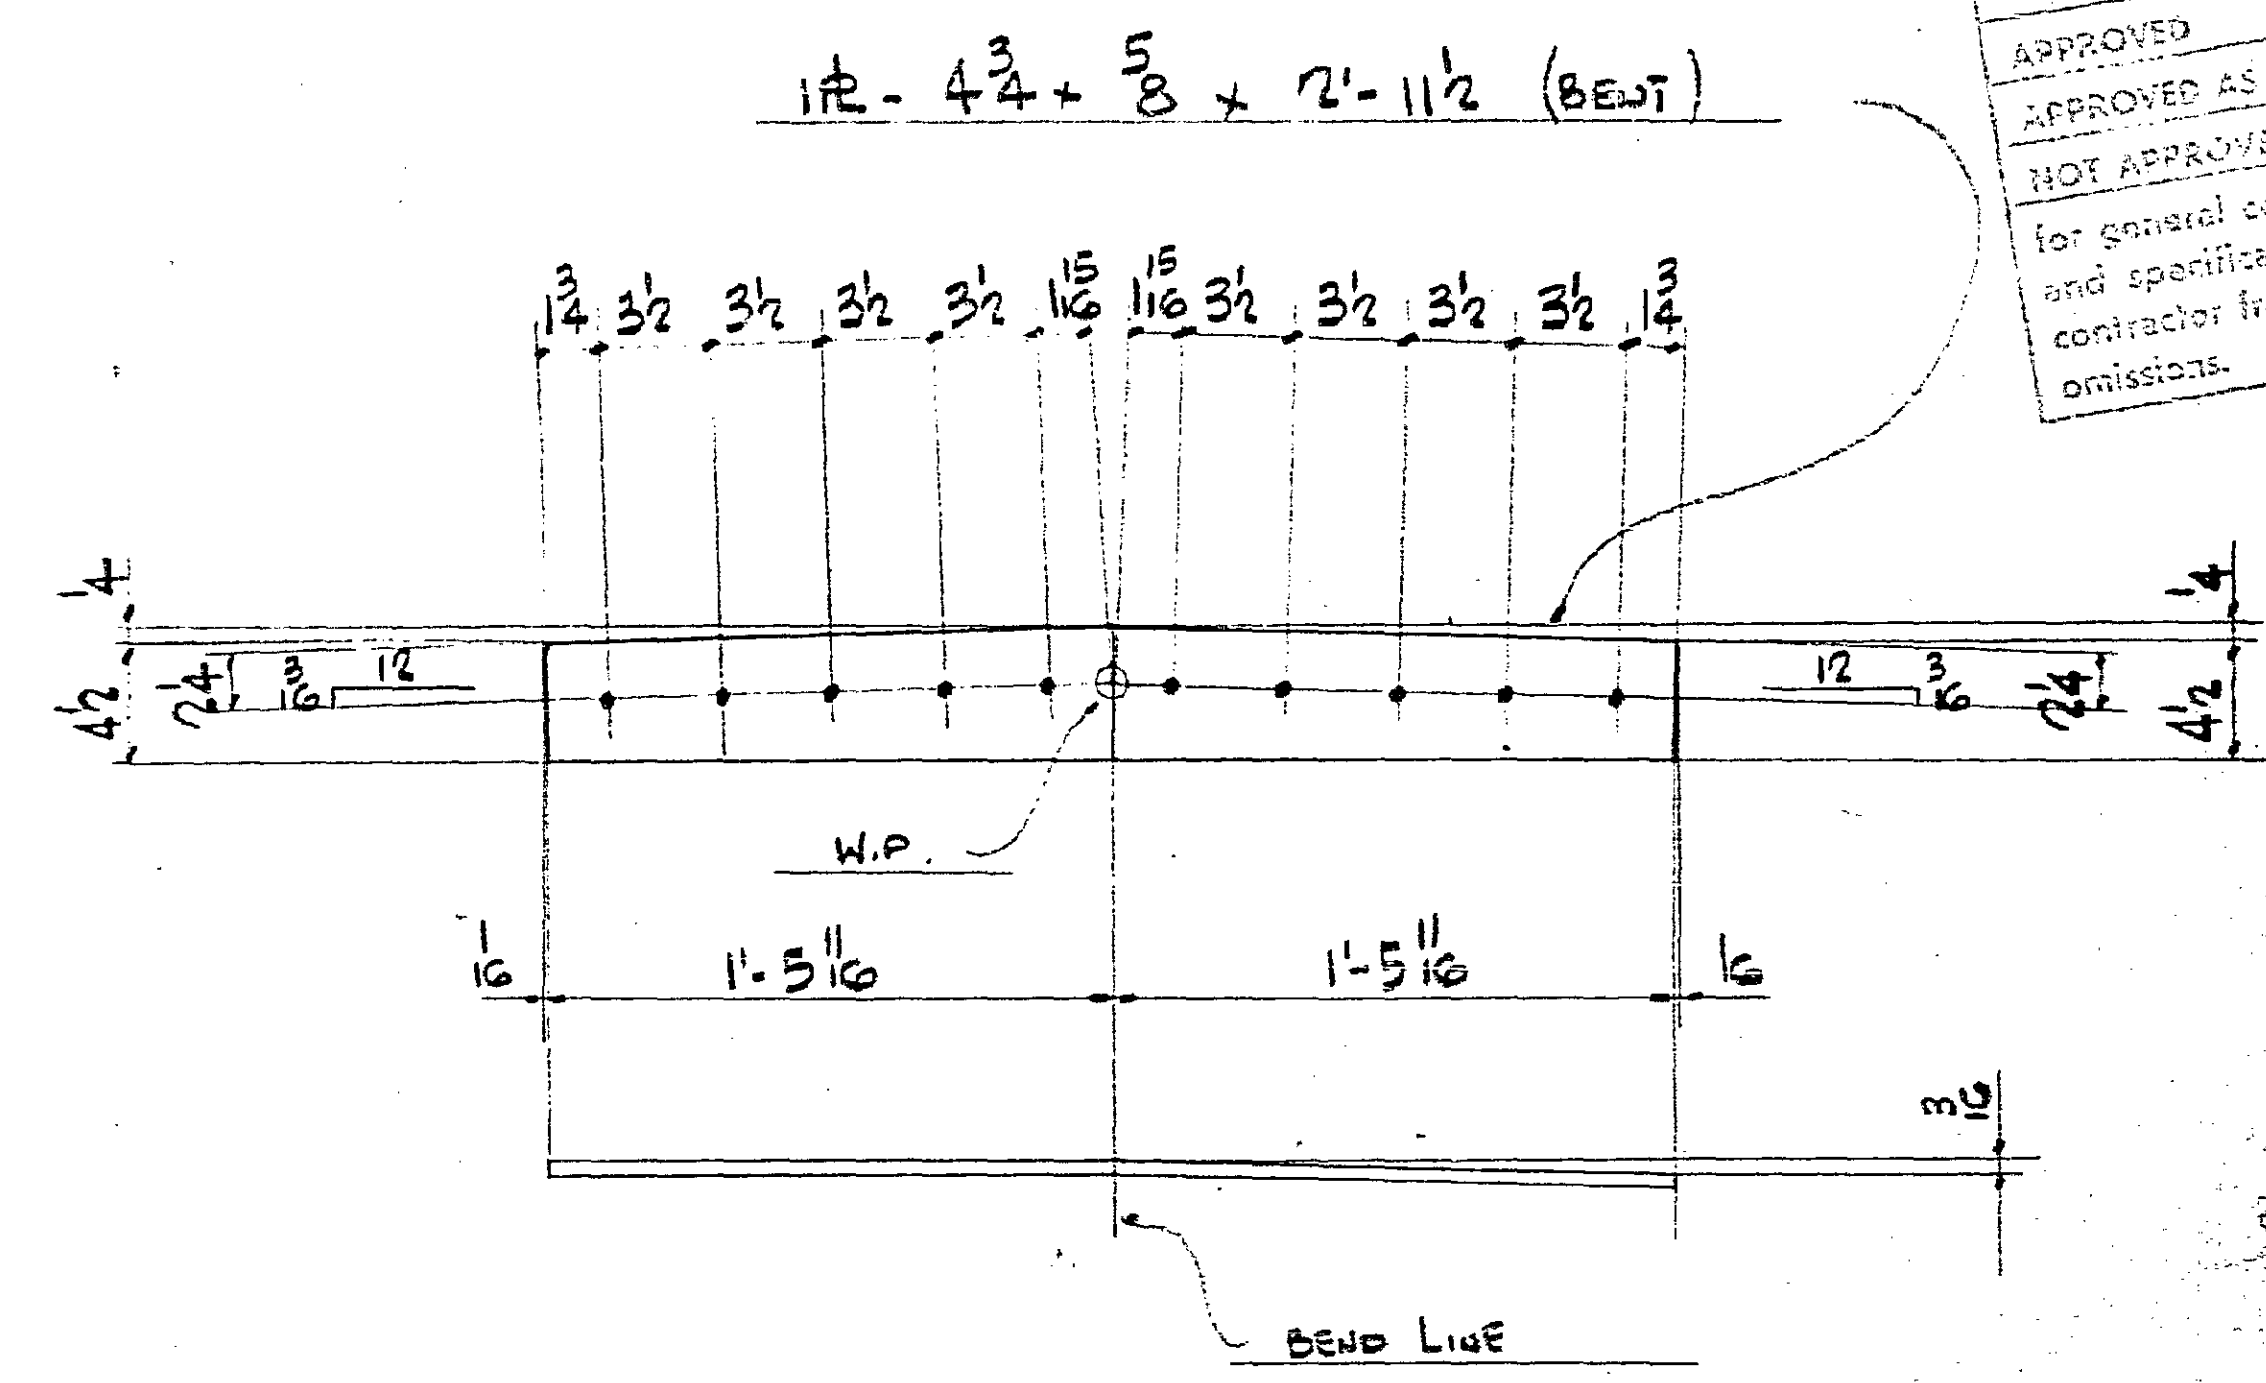


24 - SPLICE PLATES - P4

BUREAU OF BRIDGES
Engineer of District
APPROVED
APPROVED AS NOTED
NOT APPROVED
for general use
and specific
contractor
omissions.

FOR REFERENCE

DATE		NO.	REVISION		BY	CH. BY
HOLE AS NOTED		FINISH UNLESS NOTED				
SHOP CONNECTIONS		BOLTED				
FIELD CONNECTIONS		OTHERS				
ISSUE FOR NO. DATE APPR 3 8-2 SHOP 3 8-11-66 DESIGN 4 8-11-66 CONTR 5 8-23-66						
The J.T. Edwards Company 1241 MCKINLEY AVENUE COLUMBUS, OHIO 43222						
BRIDGE #171 - CR-75 Wilson Rd. NYC, R.R. FRANKLIN COUNTY						
WHITAKER MERRILL CO. CONTRACTOR						
O.S.H.D. (BARRETT ASSOCIATED ENG.) ARCHITECT-ENGINEER						
CONTRACT NO.	DRAWN	CHECKED	APPROVED	B 11 OF		
20352	JB	LC	O.S.H.D.			
	JULY-66		8-20-66			

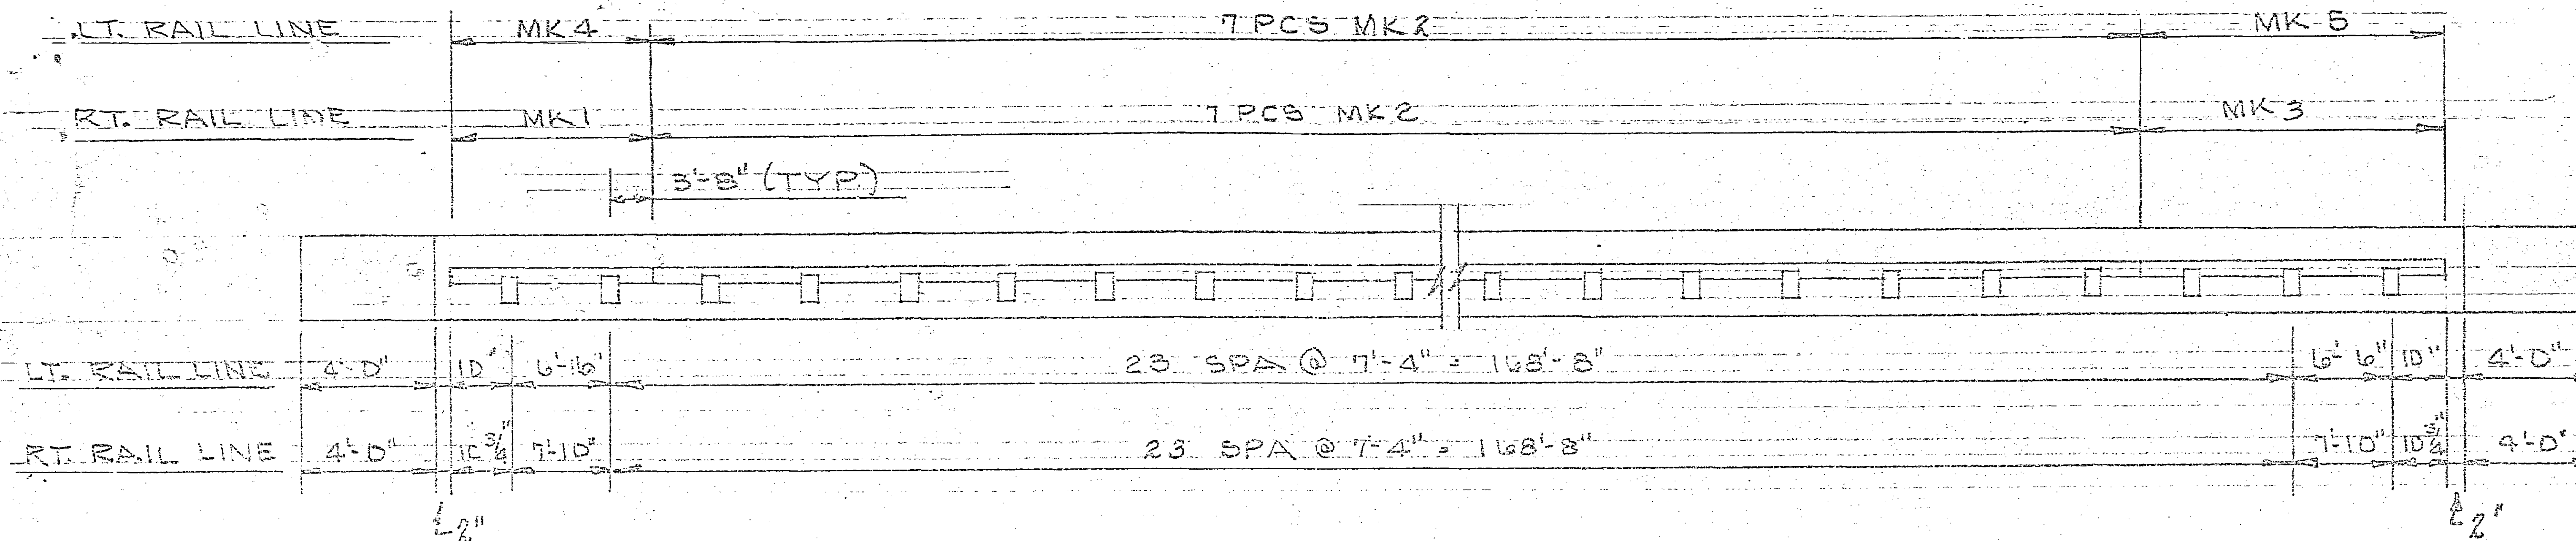

BR. NO. WILSON RD. OVER N.Y.C. RR. TYPE 1 ALUMINUM RAILING PLAN


ALL ENDS
CAPPED (TYP)

BILL OF MATERIAL

QUAN.	DESCRIPTION
52	TYPE 1 ALUMINUM CASTING
208	3/4" x 1'-0" GALV. STEEL ANCHOR BOLTS, NUTS & WASHERS
24	1/4" THK. GRAY SPONGE RUBBER JT.
4	4 1/2" RAIL CAPS PER STD. DWG. BR-1-65
16	TUBE SPLICE, COMPLETE, PER STD. DWG. BR-1-65
1	GAL. ALUMILASTIC
PAY LENGTH: 236'-6 3/4" LF	
4 1/2" O.D. x .297" WALL ALUMINUM TUBE WITH ANCHOR CHANNEL	
1	M A R K 1 12'-4 3/4"
14	M A R K 2 28'-0"
1	M A R K 3 18'-8 3/4"
1	M A R K 4 11'-0"
1	M A R K 5 18'-4"

SHIMS FURNISHED AS REQUIRED

FOR DETAILS NOT SHOWN SEE
PROJECT PLANS & STD. DWG.
BR-1-65 DATED 12-1-65
REVISED 11-24-65
ALL MATERIAL IN ACCORDANCE WITH
STD. DWG. BR-1-65 & O.S.H.D.
CONSTR. & MATERIAL SPECIFICATIONS
DATED 1-1-65

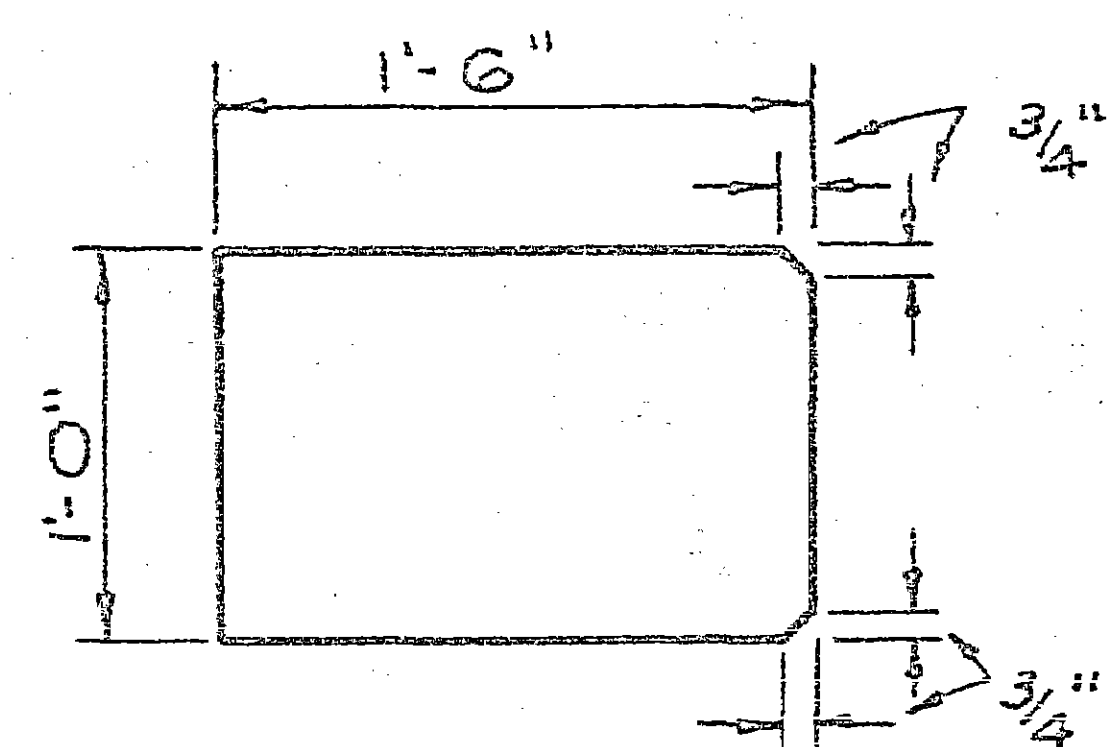

GRAY SPONGE RUBBER JT.

APPROVED: *PRS 8-24-66*

APPROVED AS NOTED

NOT APPROVED

for general conformance with design plans

6 PRINTS FOR DISTRIBUTION


REV.	PROJECT 17166 FRANKLIN CO.
	TYPE 1 ALUM. RAIL DETAILS
	CONTRACTOR:
	VISINTINE & CO.
	BR. NO. WILSON RD. OVER NYC RR.
	FURN. BY ALCOA THRU WHITAKER-MERRELL CO.
SHT. 1-1	DRAWN CM CHECKED DC NO. SCALE 1/8" = 1'-0" 11-24-66

5080 010 SHOT DWG. RAILING DETAILS 0063 1968 0130 060


SUBSTANDARD DRAWING

This drawing does not meet minimum filming standards! **MICRO-DATA** does not accept responsibility for the inferior results due to the condition of this drawing.


a aa ba
b ab bb
c
d
e
f
g
h
i
j
k
l
m
n
o
p
q
r
s
t
u
v
w
x
y

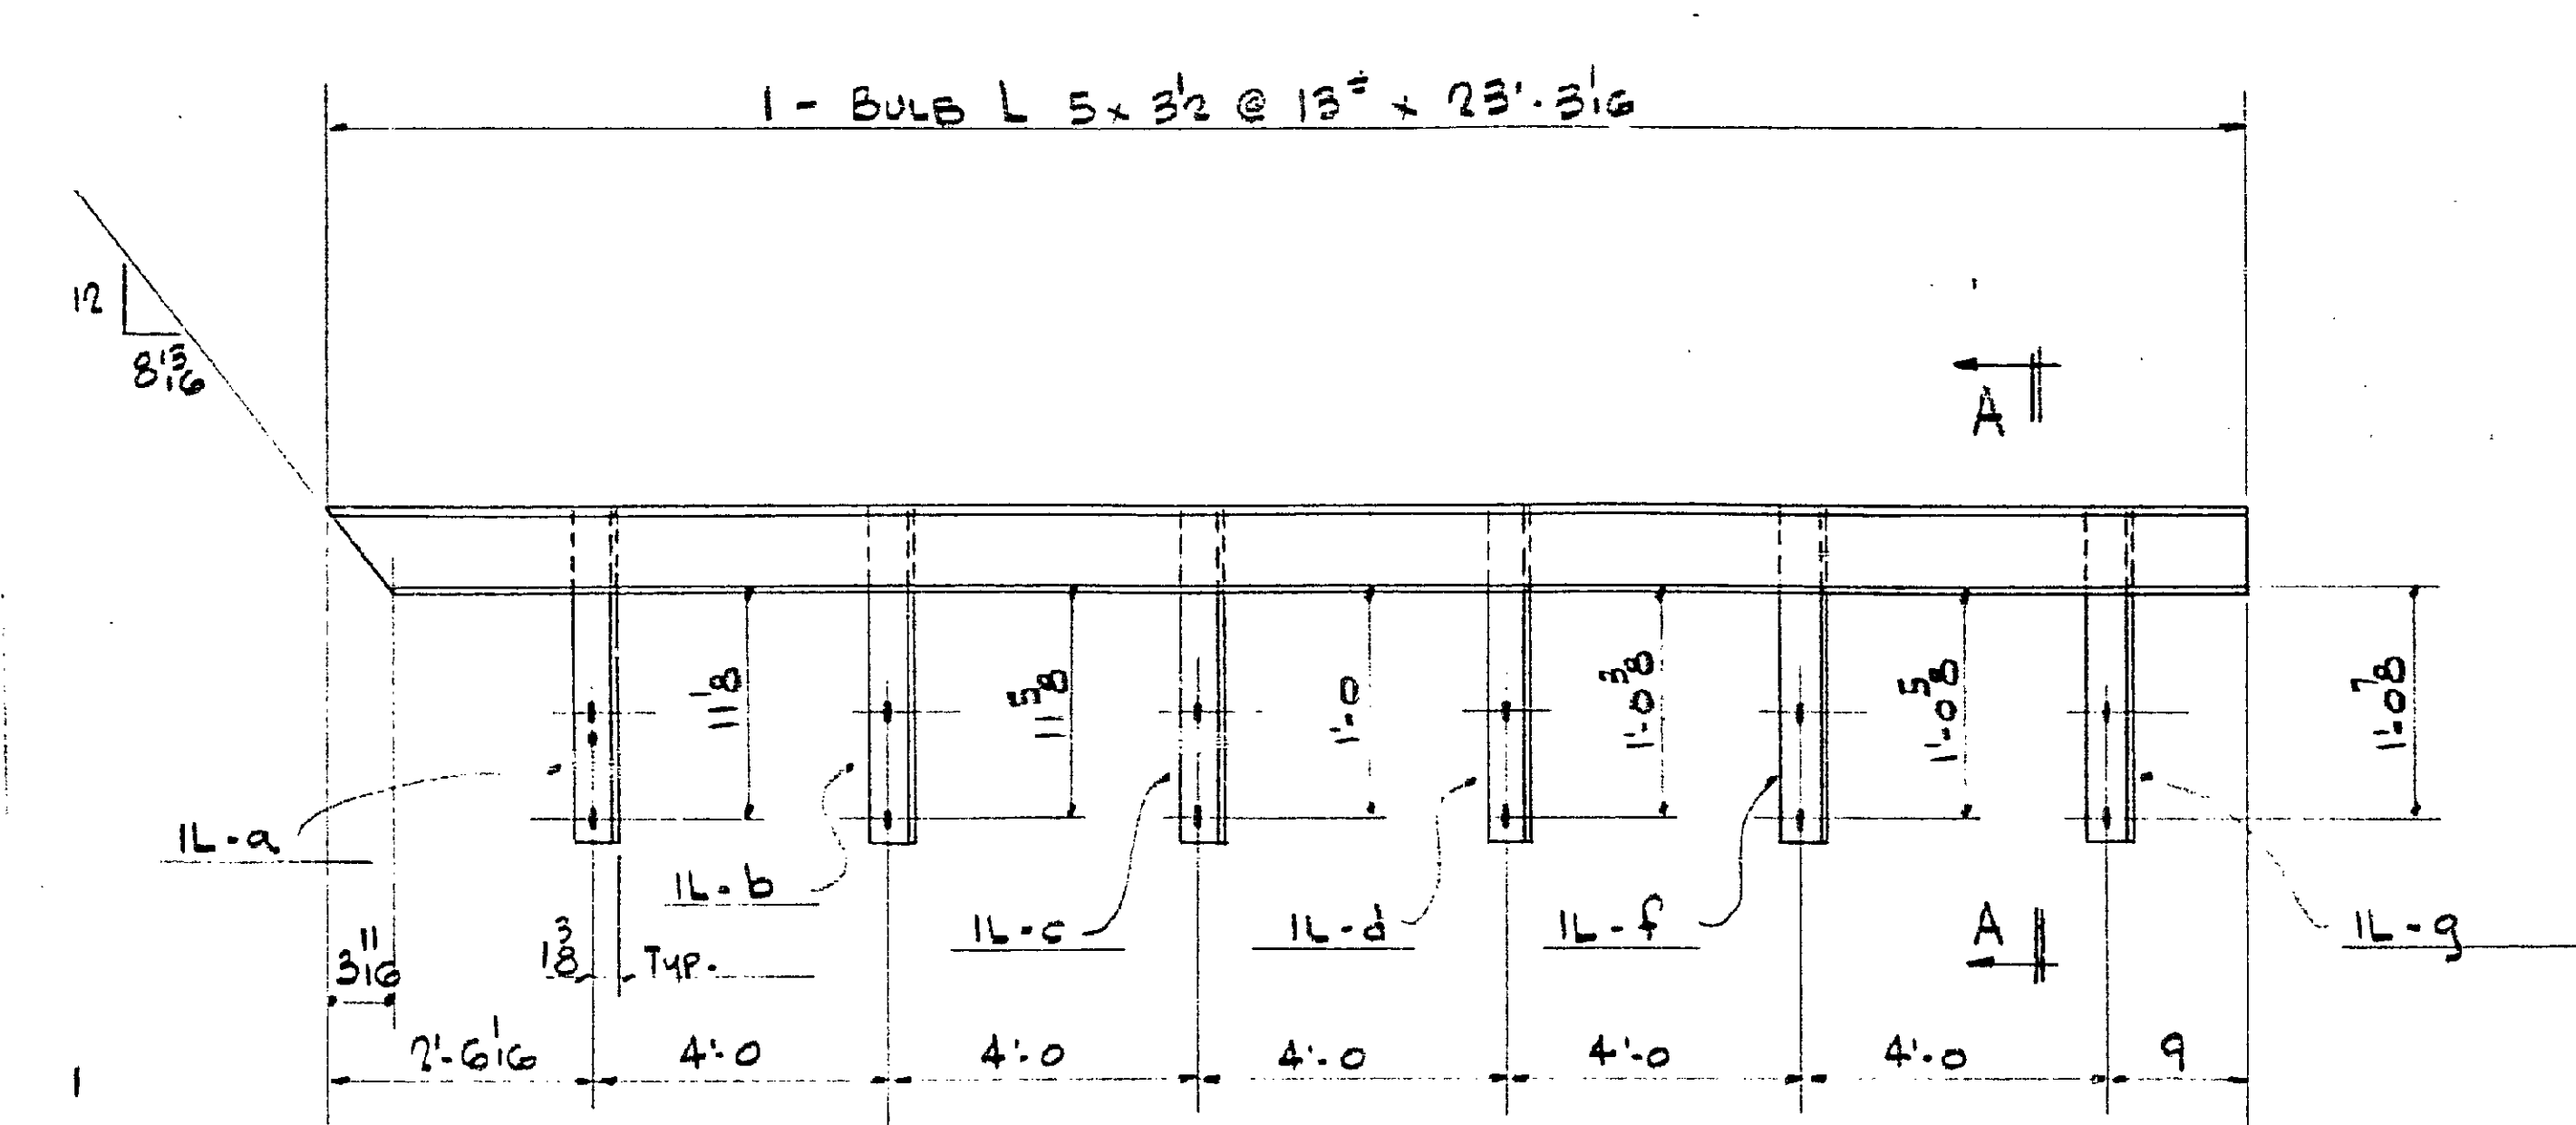


ONE - GUTTER - G1

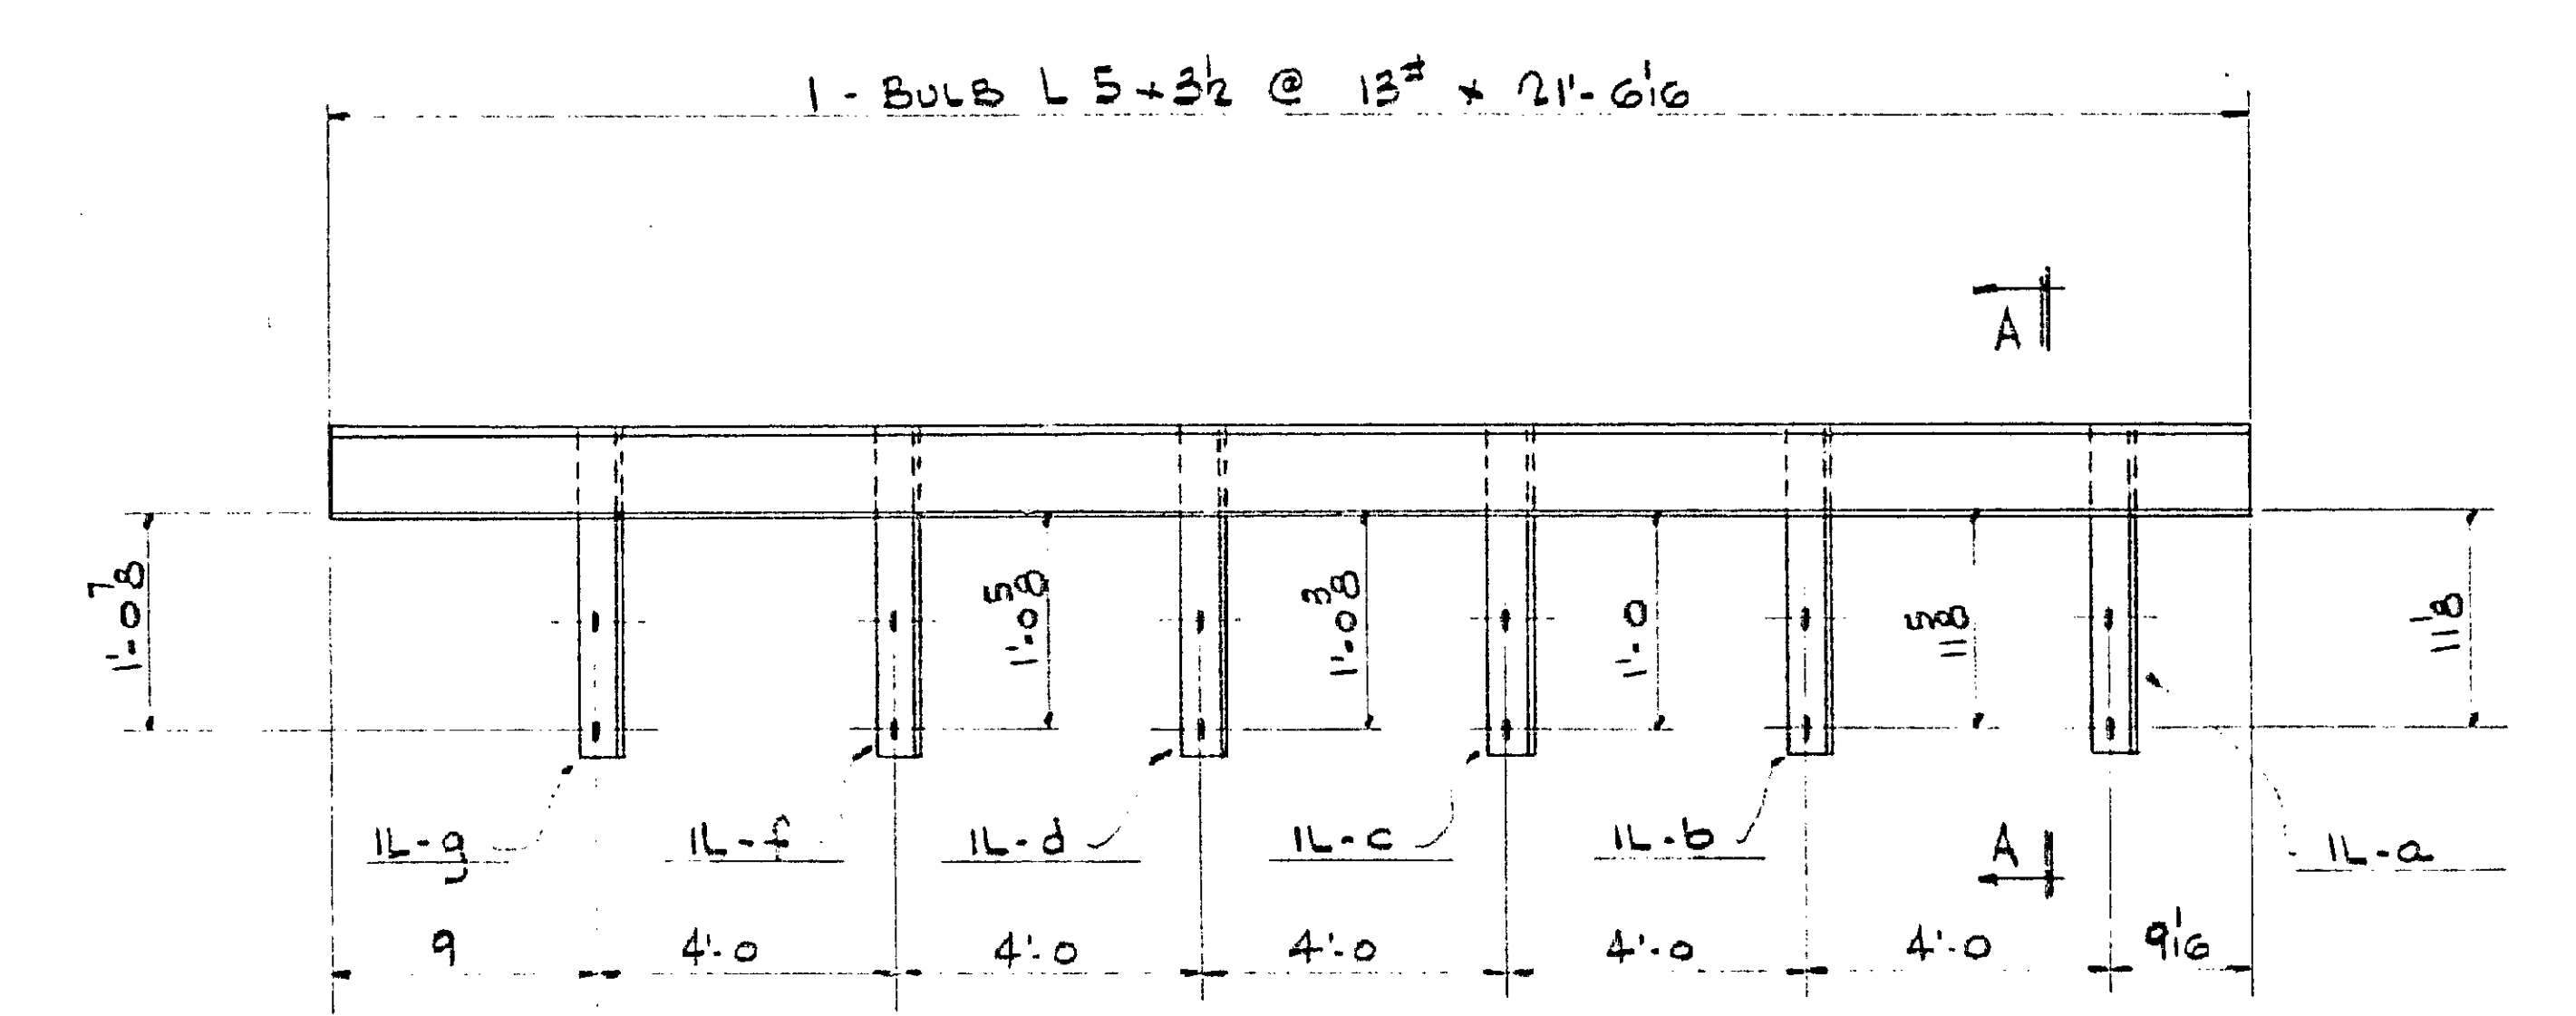


ONE - GUTTER - G2

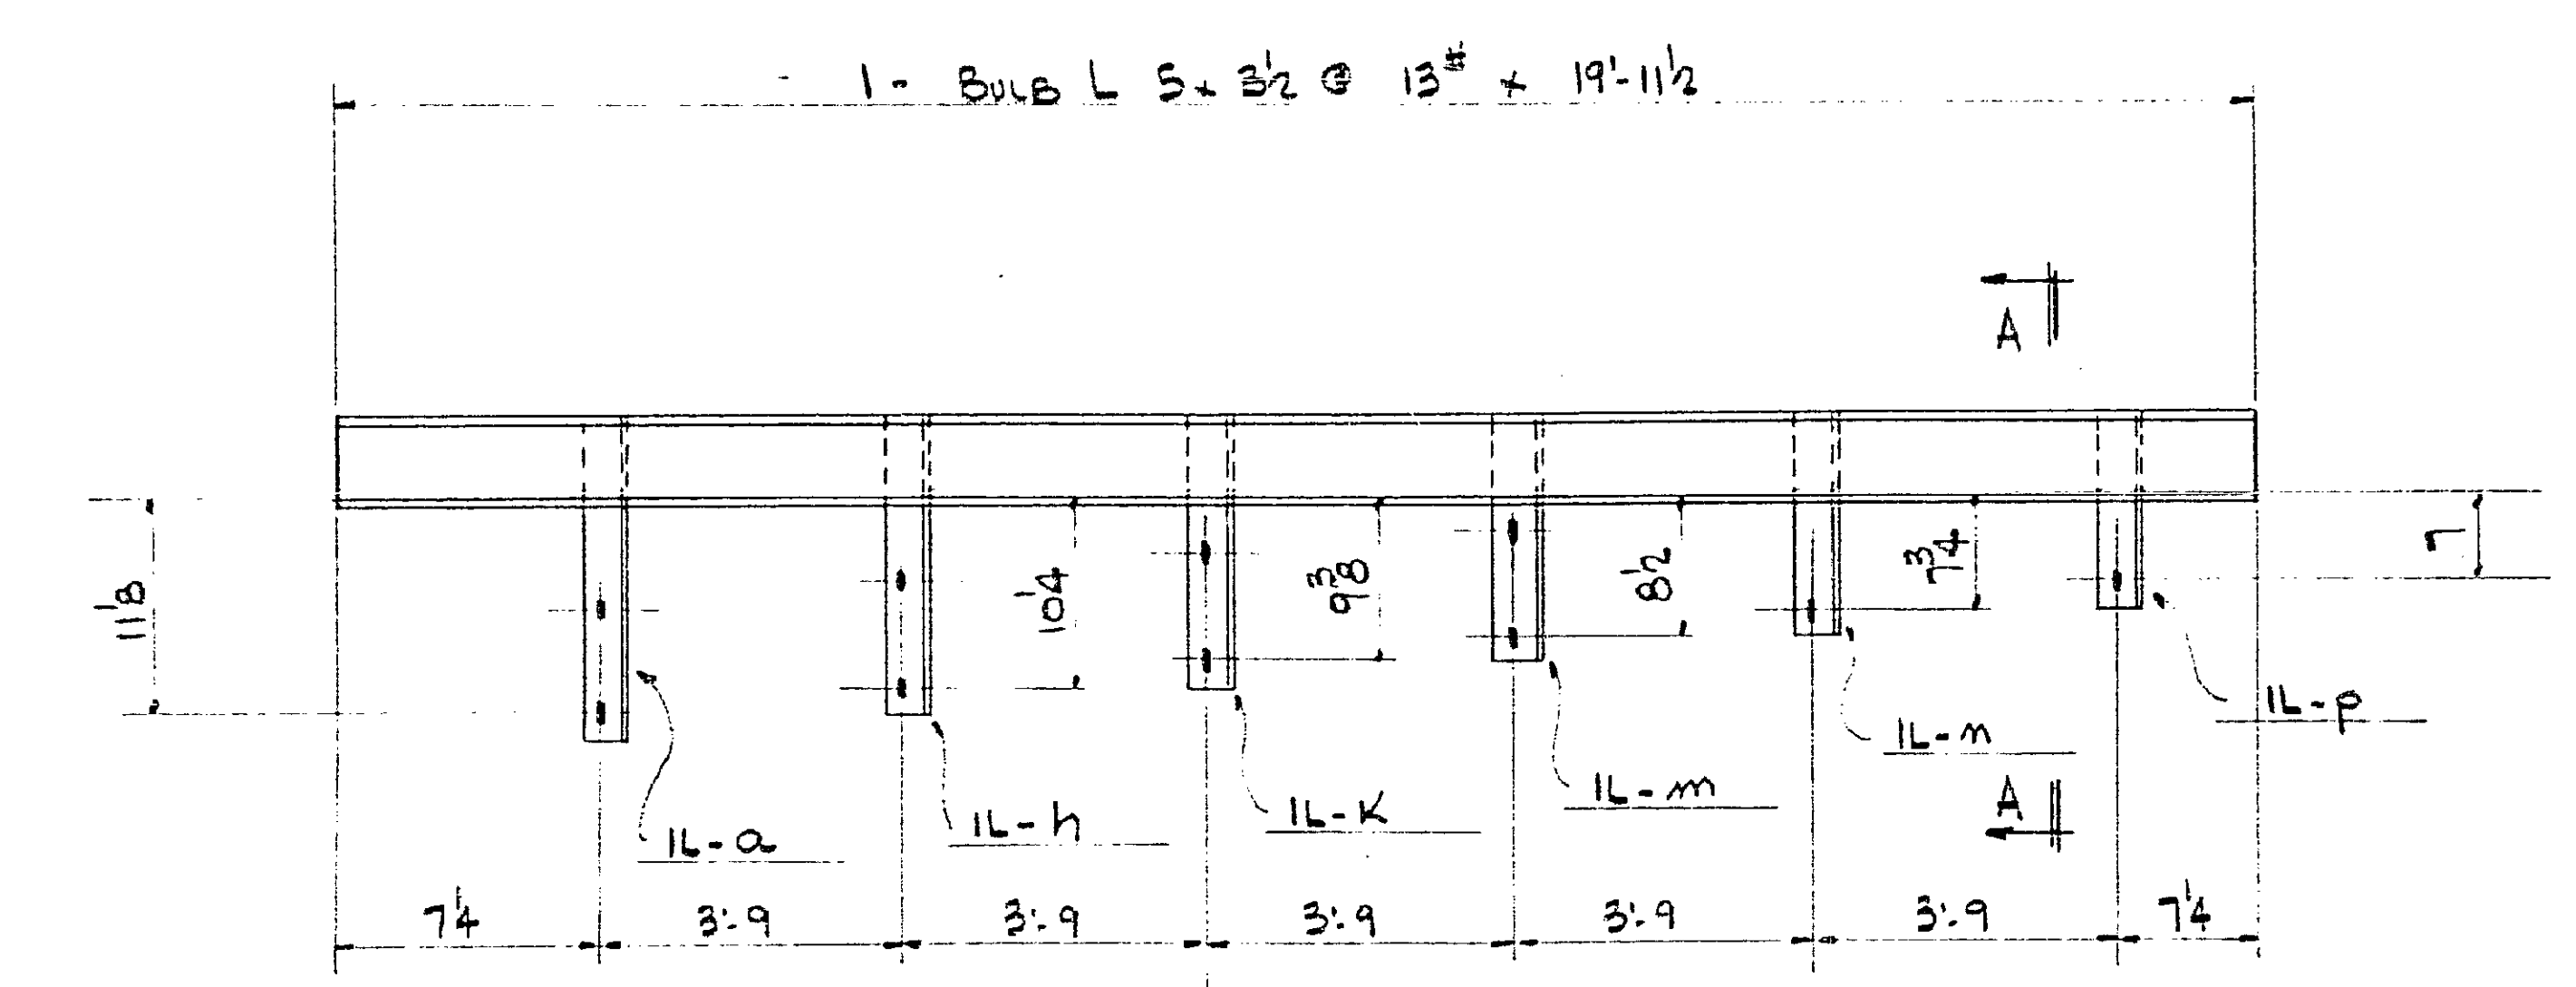


ONE - GUTTER - G3

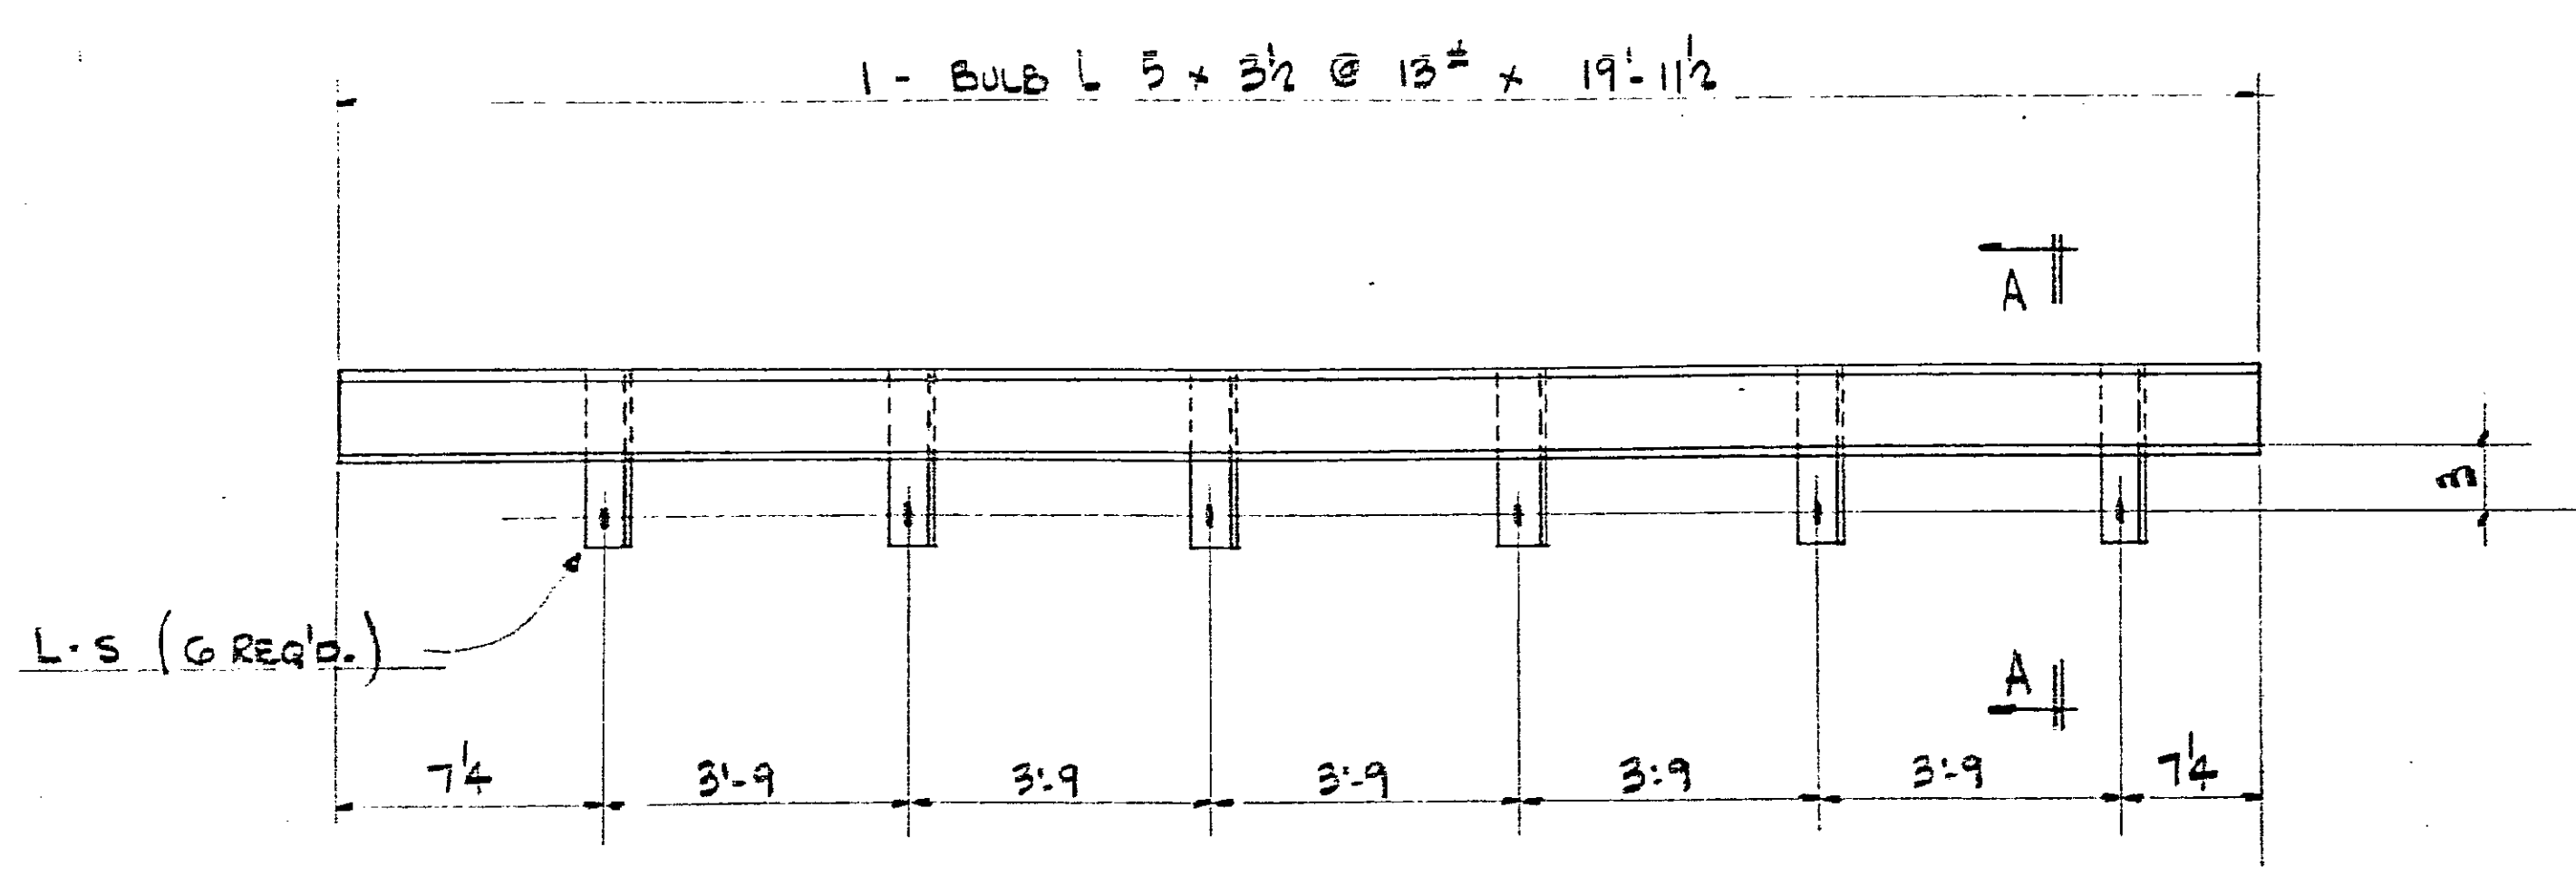


2 - GUTTERS - G4

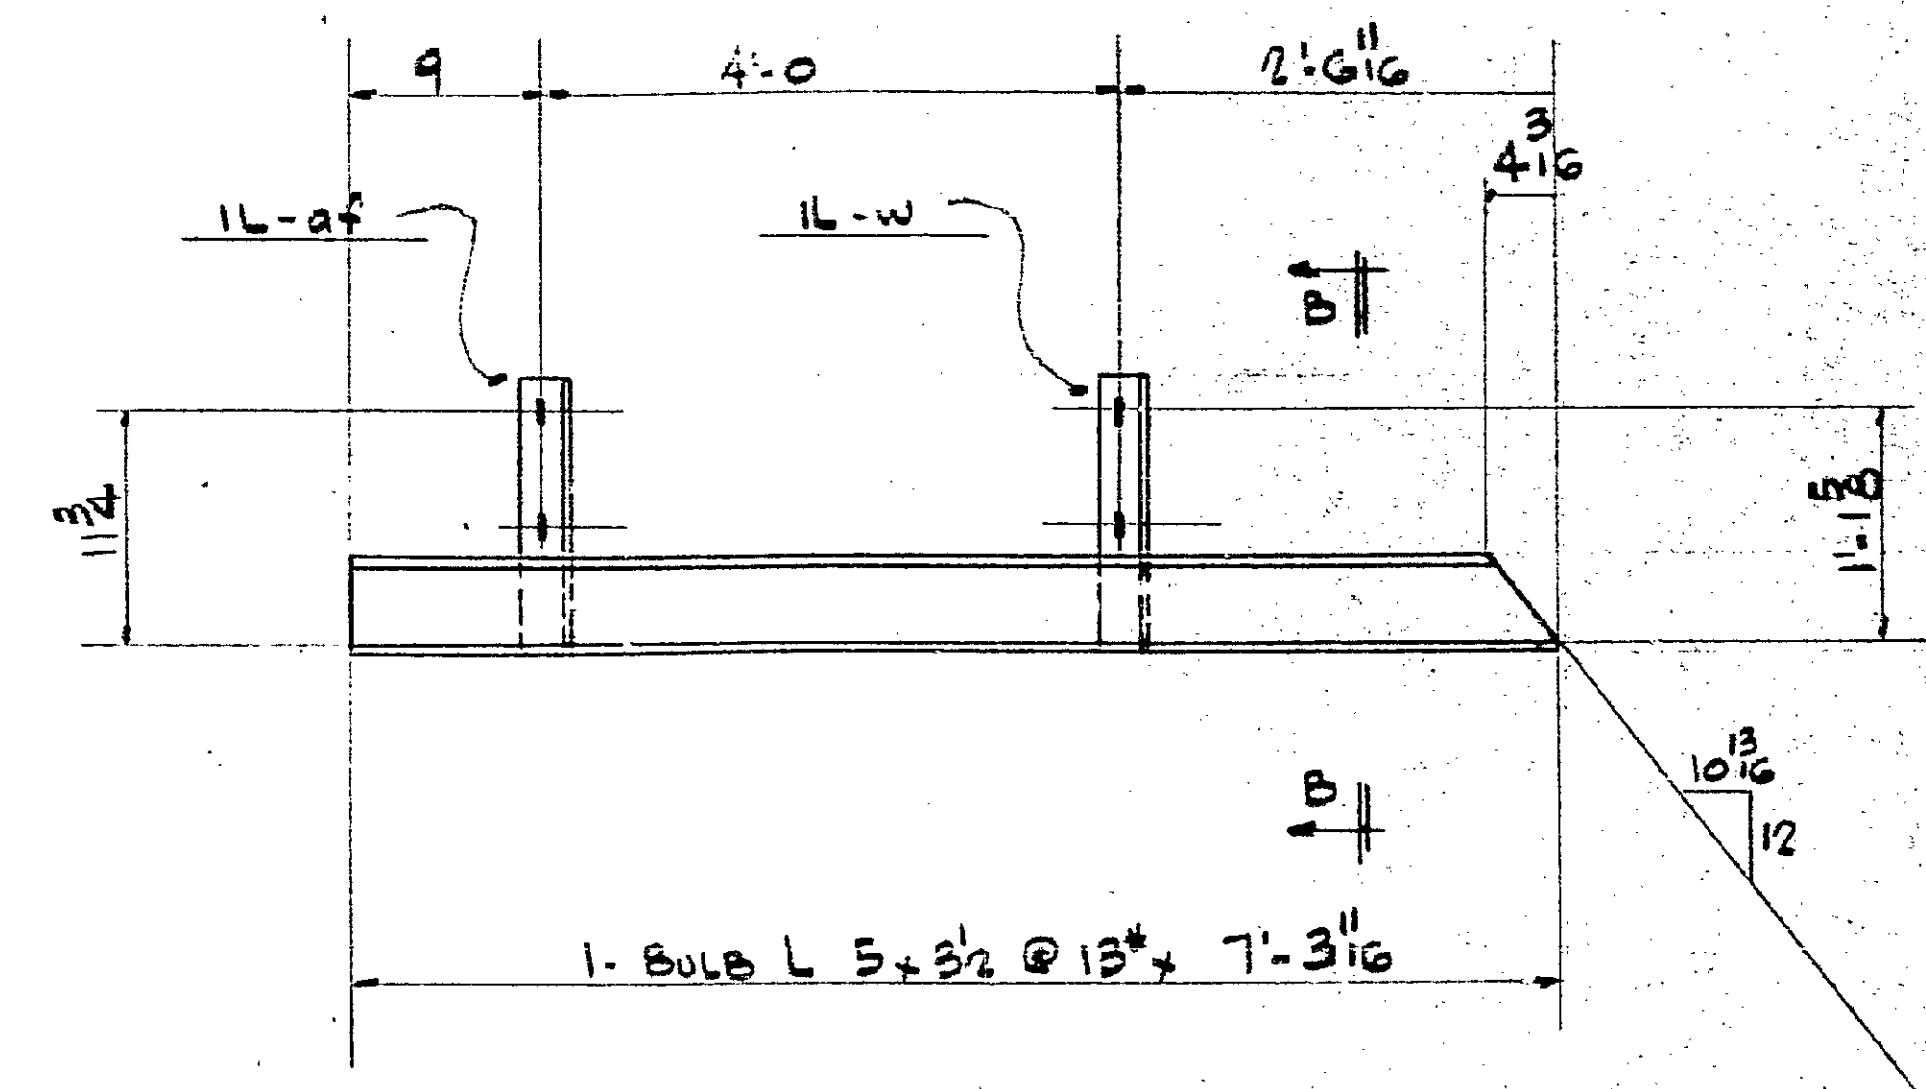


ONE - GUTTER - G10

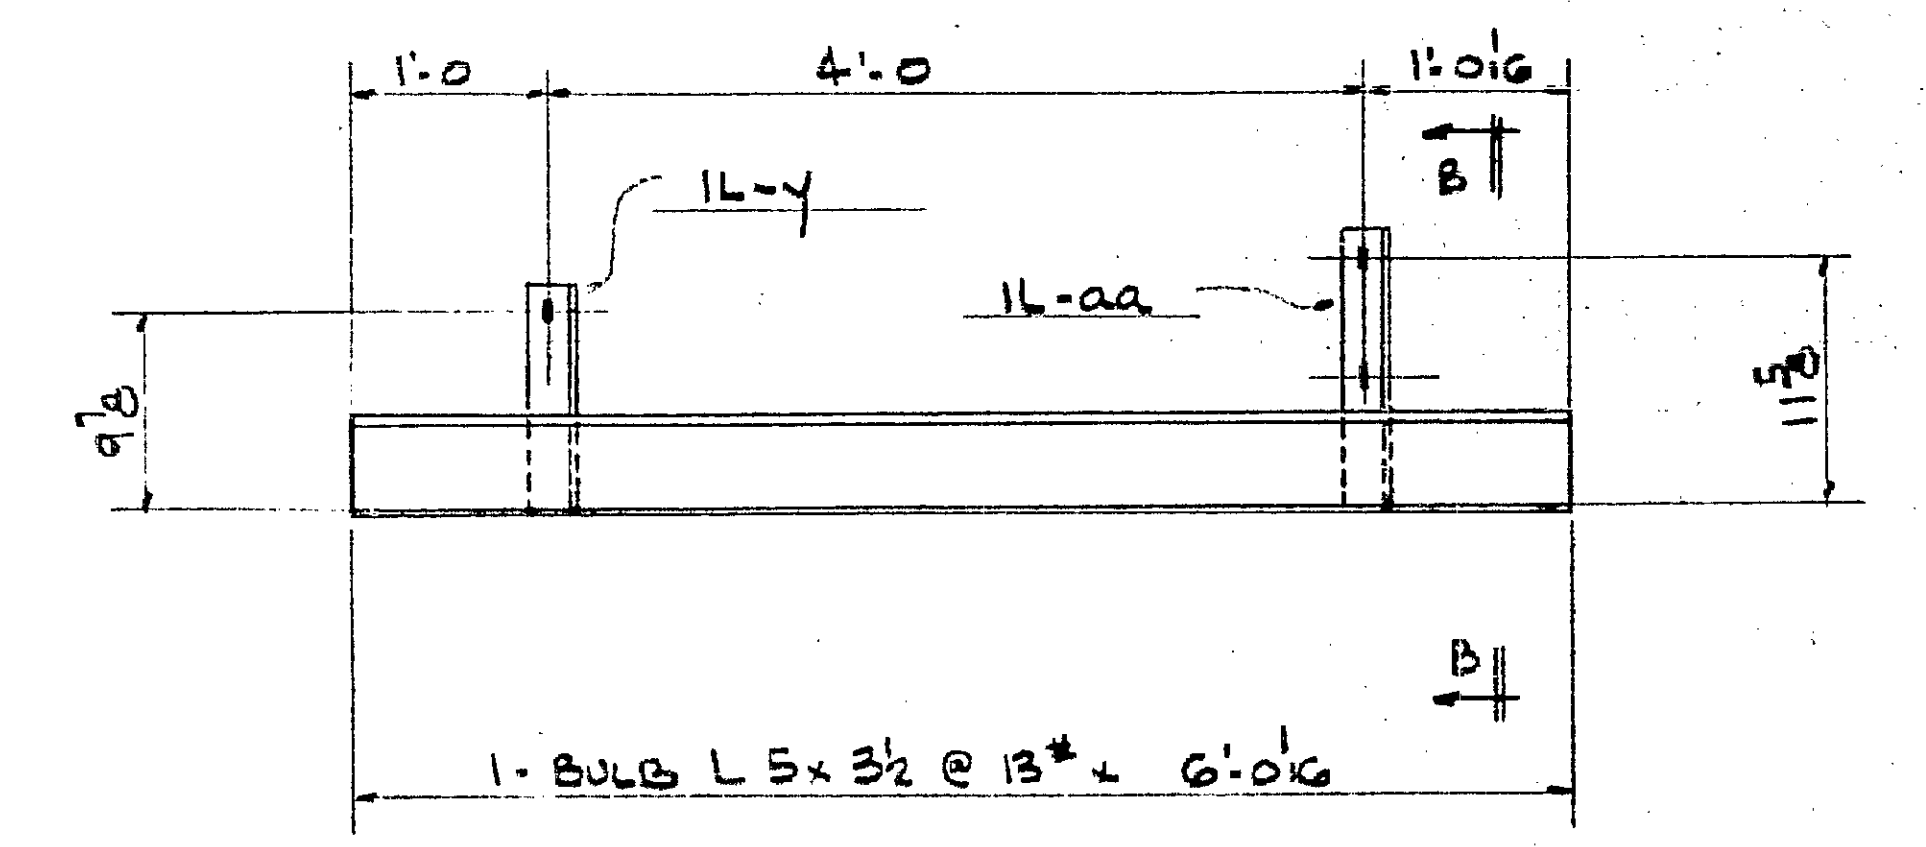


ONE - GUTTER - G9

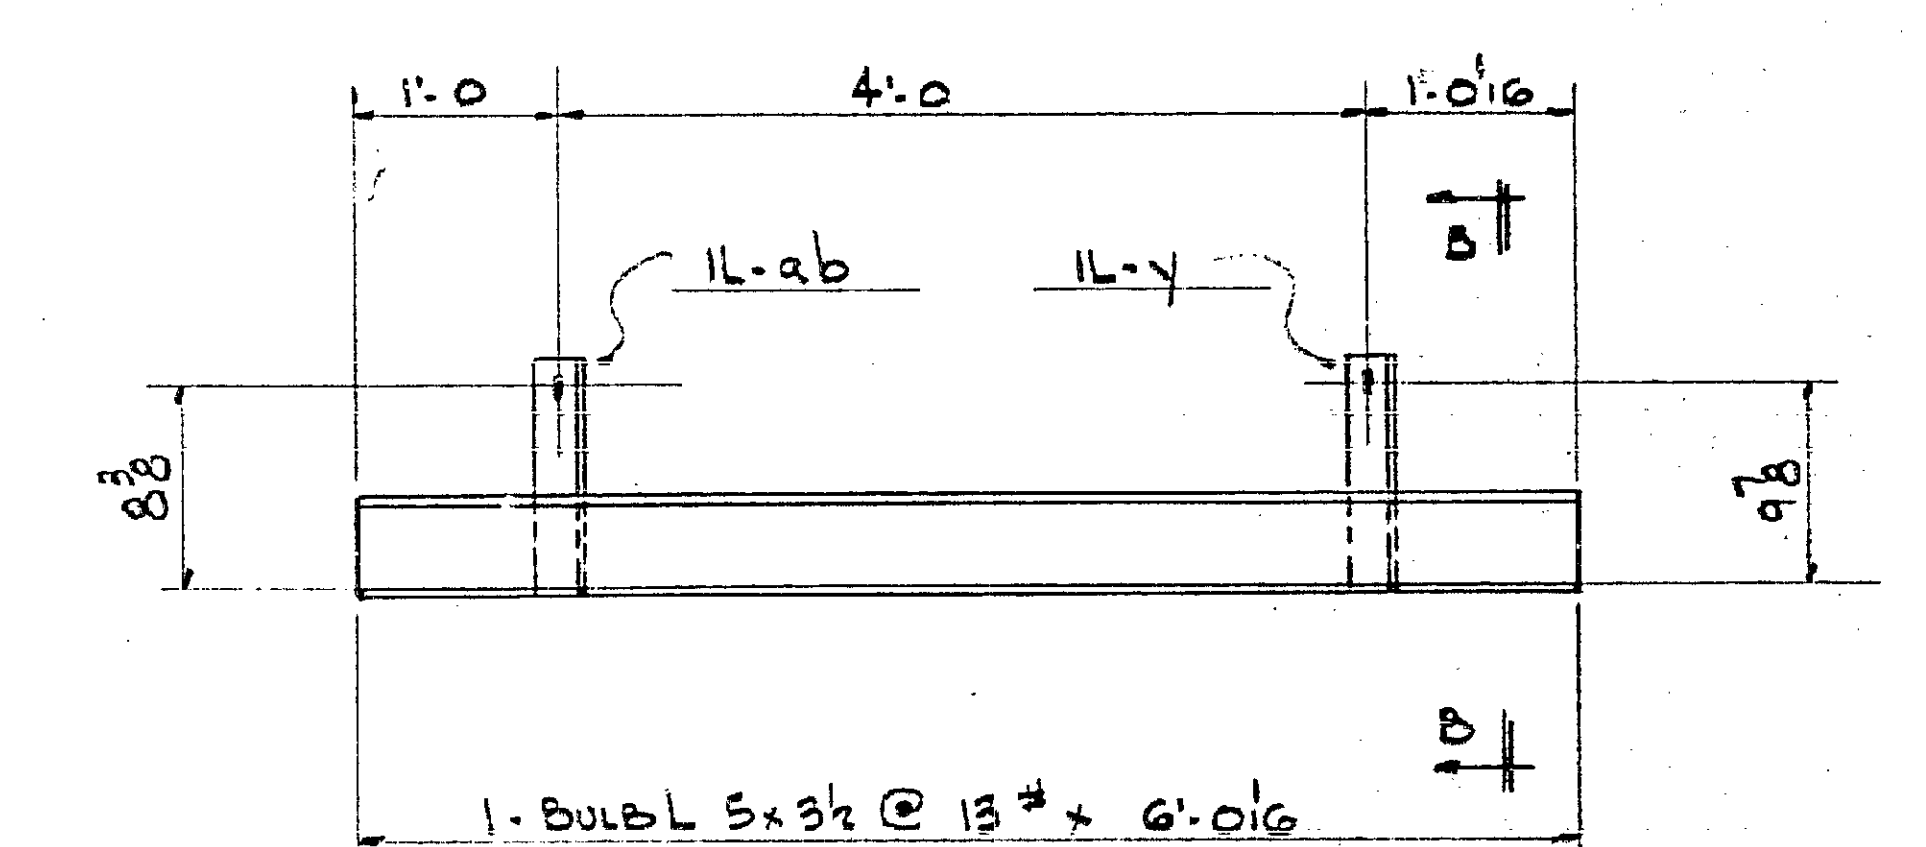


ONE - GUTTER - G8

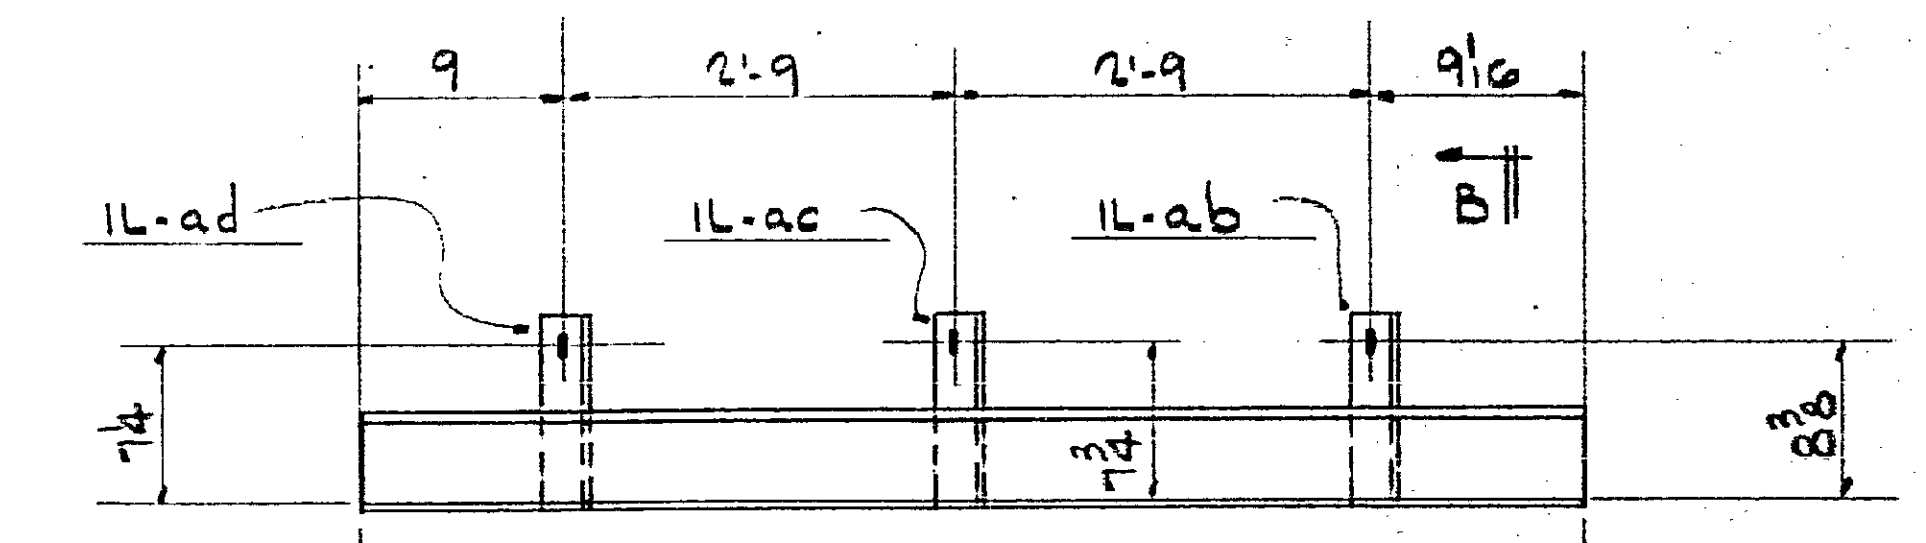


ONE - GUTTER - G7

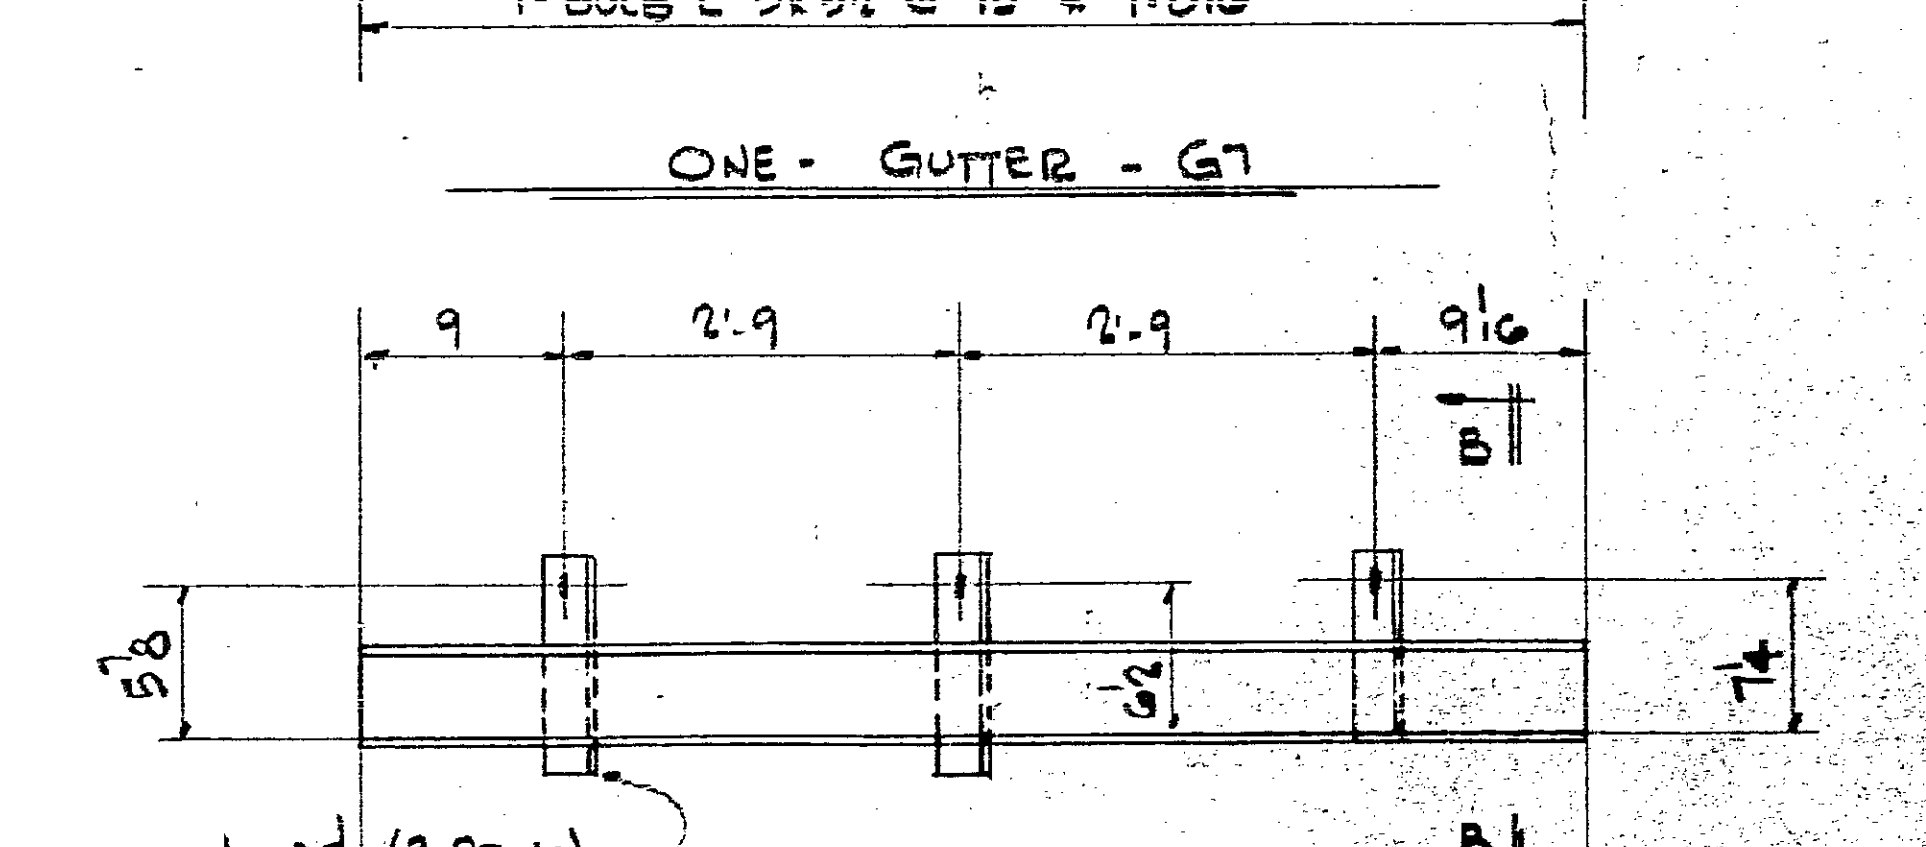

ONE - GUTTER - G6


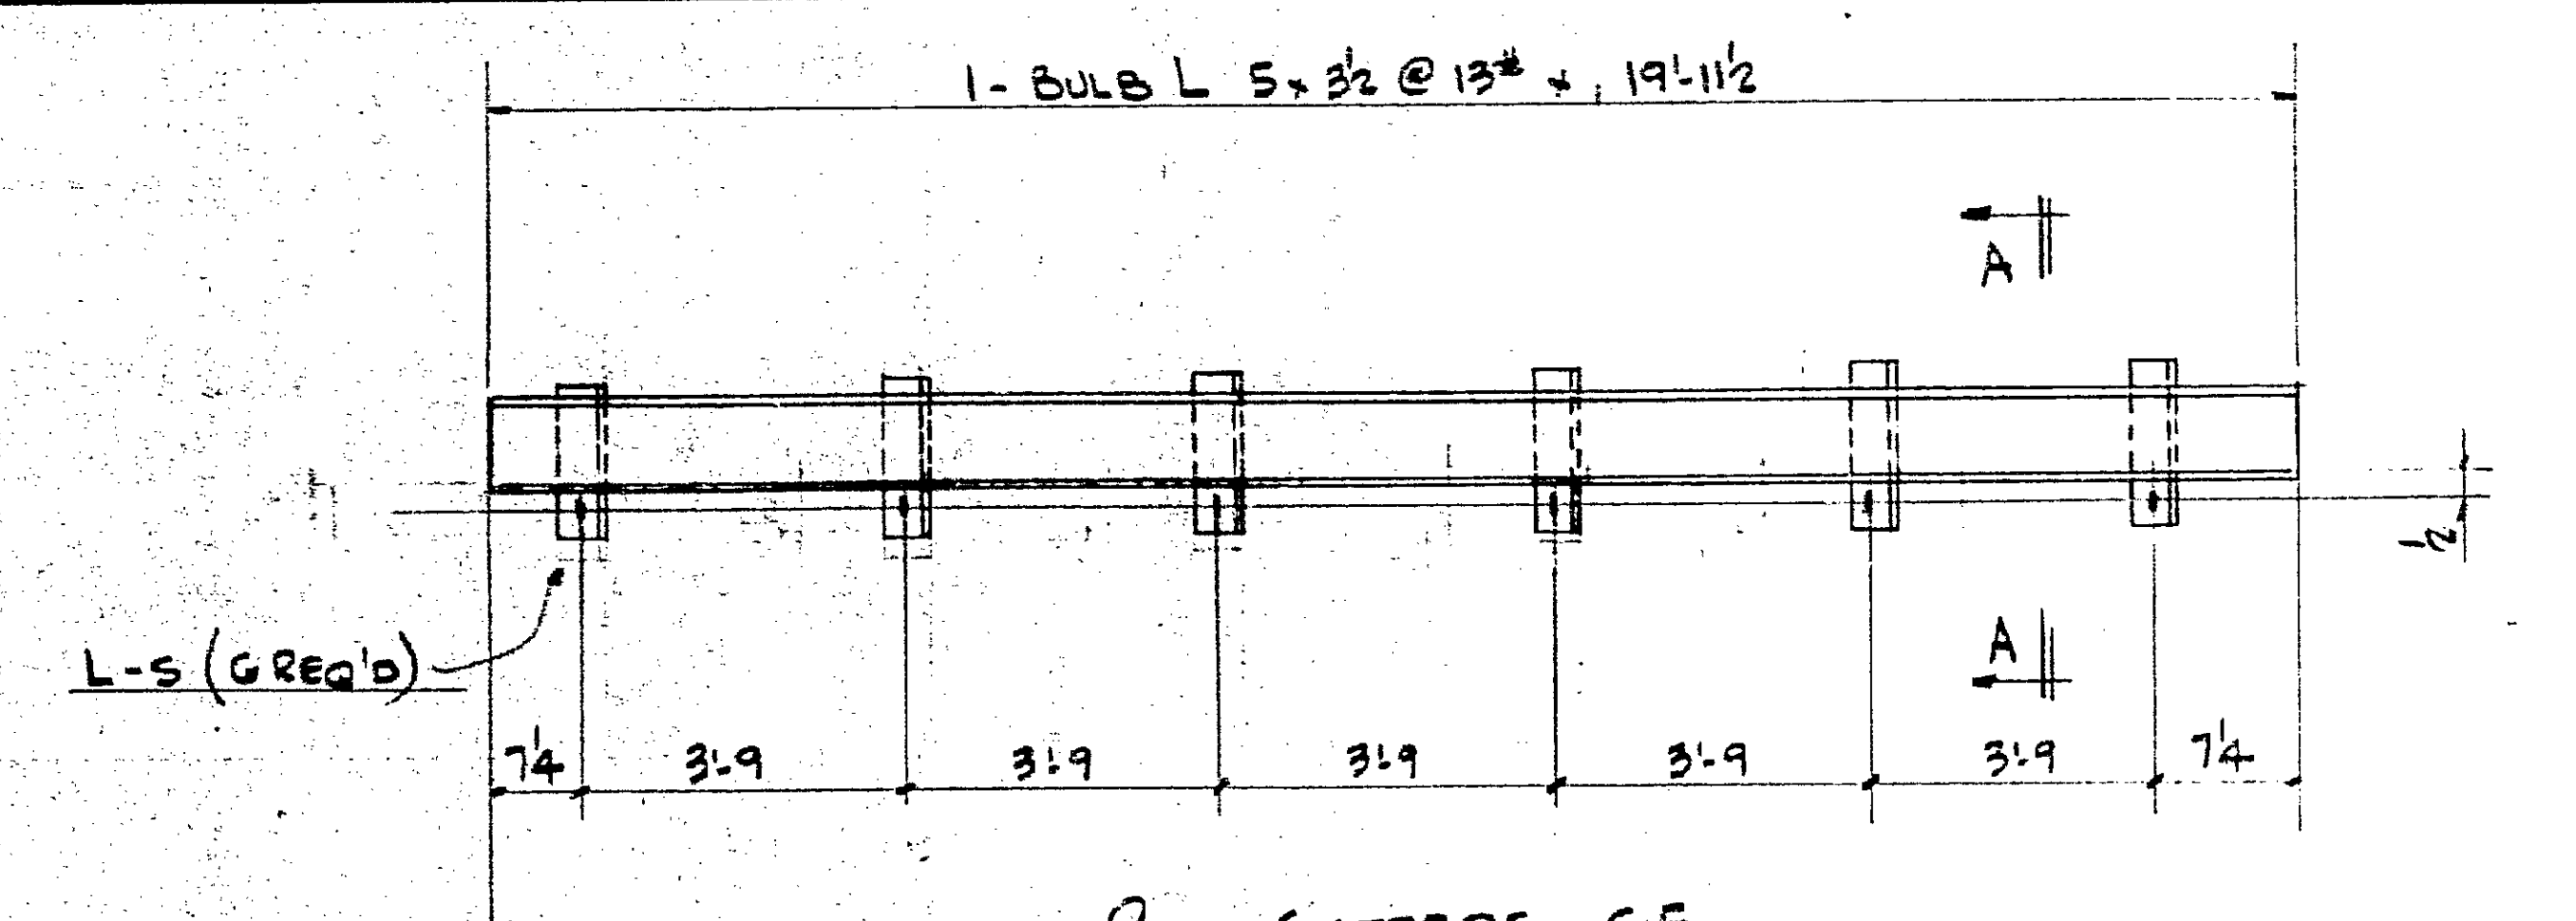


2 - GUTTERS - G5

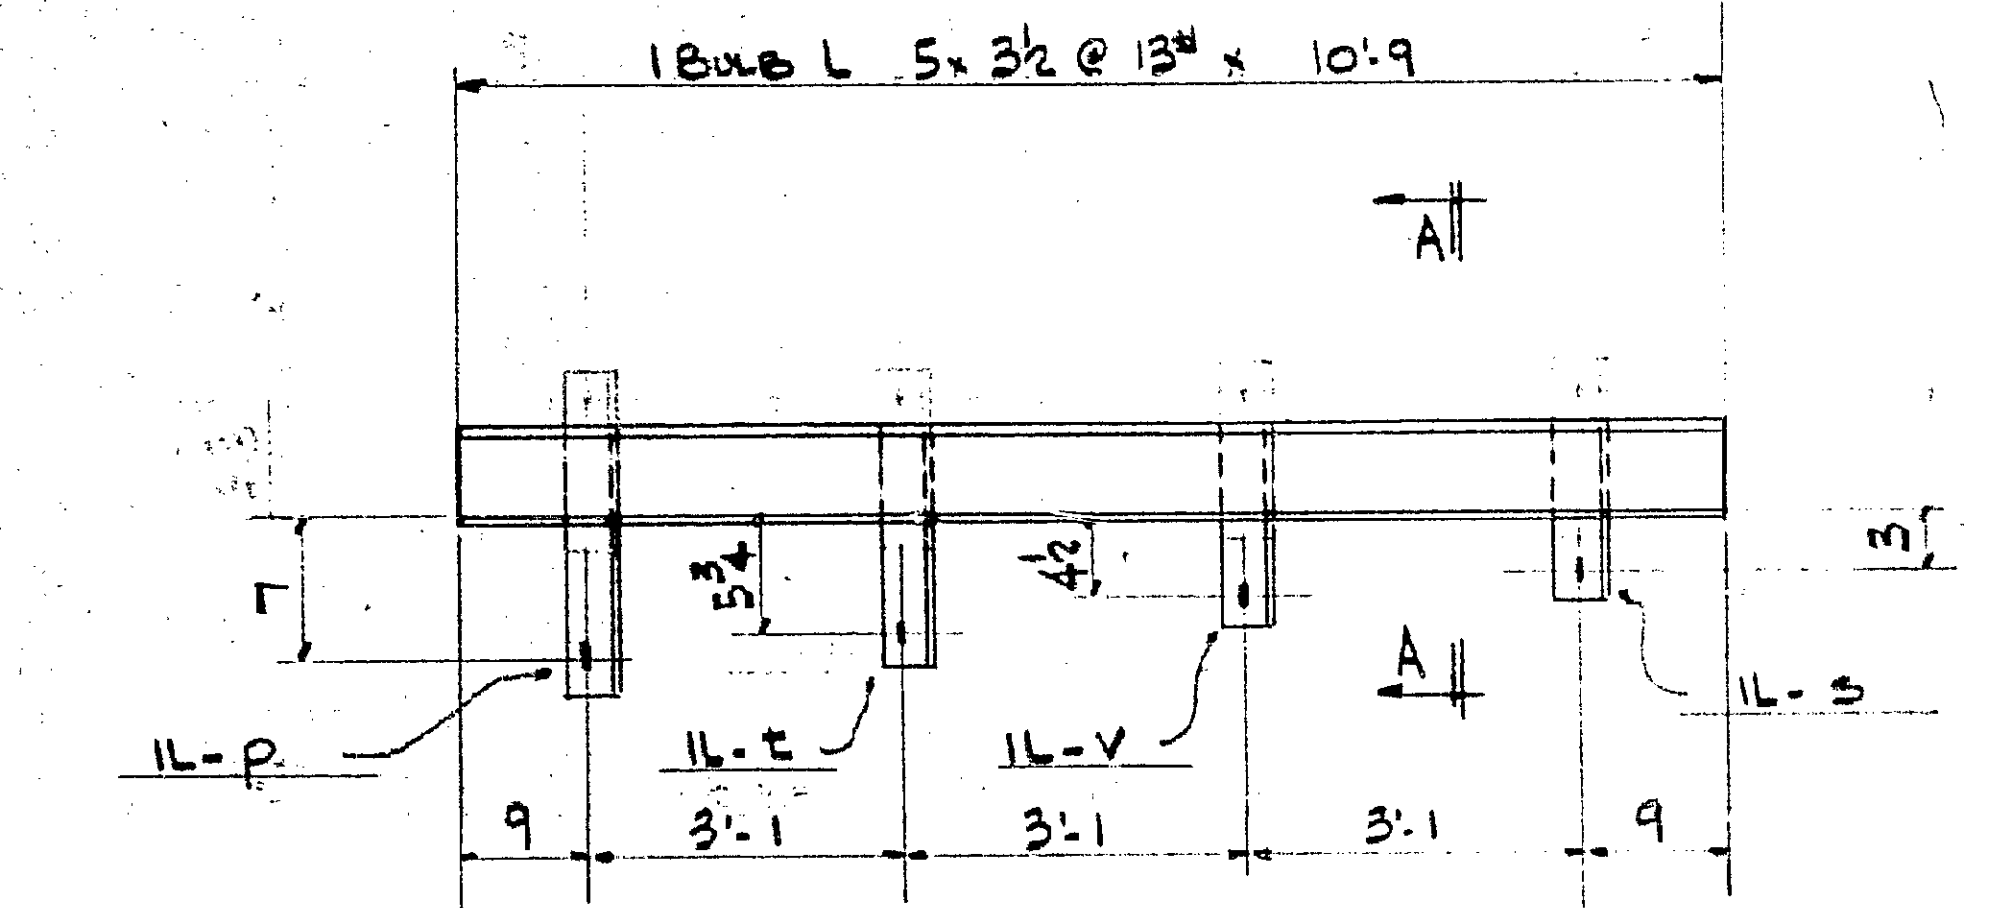

ONE - GUTTER - G11

MARK	DIMENSIONS		
	(A)	(B)	(C)
a	11 1/2	9 3/4	11 5/8
b	11 1/2	10 1/4	11 5/8
c	11 0	10 5/8	11 6 1/4
d	11 0 3/8	11	11 6 3/8
e	11 0 3/8	11 1/4	11 6 3/8
f	11 0 3/8	11 1/2	11 6 3/8
g	11 0 3/8	11 3/4	11 6 3/8
h	10 4	8 3/8	11 4 1/2
k	9 3/8	8	11 3 5/8
m	8 1/2	7 3/8	11 2 3/4
n	7 3/4	6 3/8	11 2
p	7	5 3/8	11 1 1/4
s	VARIES	1 1/8	9 1/4
t	5 3/4	4 3/8	11 0
v	4 1/2	3 3/8	10 3/4
w	11 1 1/8	8	11 3 3/8
y	9 3/8	4 1/4	11 3/8
aa	11 5/8	6	11 1 3/8
ab	8 3/8	2 3/4	10 3/8
ac	7 3/4	2 3/8	9 3/4
ad	VARIES	1 5/8	9 1/4
af	11 3/4	6 3/8	11 1 3/4

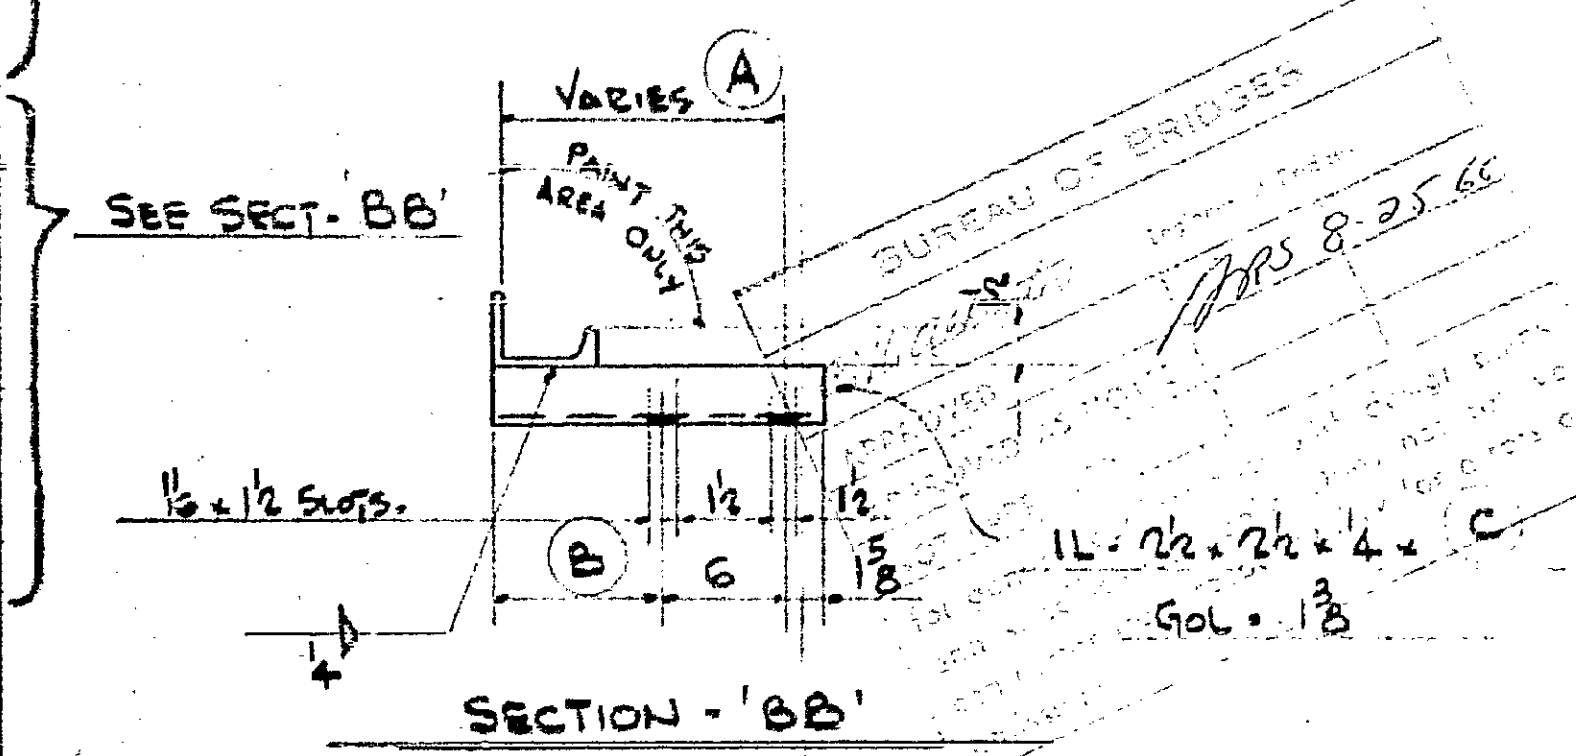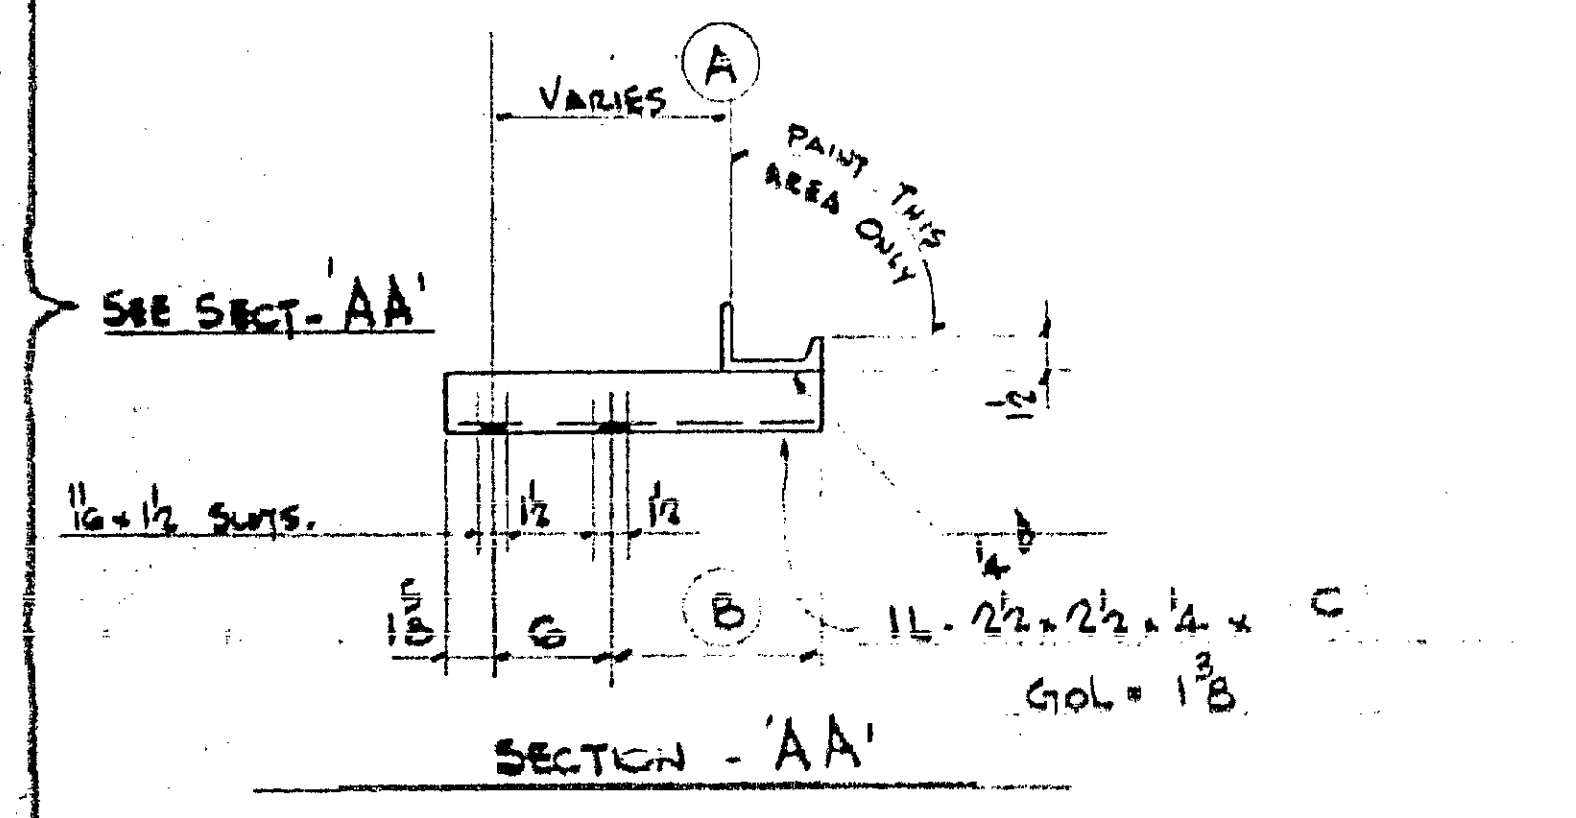

SHOP NOTE!
ALL MATERIAL A36 GR7


GUTTERS			
DATE	NO.	REVISION	BY
HOLES AS NOTED		FINISH UNLESS NOTED	
SHOP CONNECTIONS WELDED		ONE SHOP COAT 70B.07	
FIELD CONNECTIONS WELDED & BOLTED		BRUSHED ON	
ERECTION BY OTHERS		BRUSHED ON	
The J.T. Edwards Company 1241 MCINLEY AVENUE COLUMBUS, OHIO 43222 BRIDGE # 171 - CE. 25 Wilson Rd. OVER N.Y.C. R.R. FRANKLIN COUNTY WHITAKER HERRELL Co. CONTRACTOR			
O.S.H.D. (Barrett Associated Eng.) ARCHITECT-ENGINEER CONTRACT NO. 70B52 DRAWN JB CHECKED LC APPROVED O.S.H.D. DATE JULY - 66			

SUBSTANDARD DRAWING

This drawing does not meet minimum filing standards! MICRO-DATA does not accept responsibility for the inferior results due to the condition of this drawing.

01080 0110 SHOP DWG. STR. STEEL 00613 71968 0150 060

Wilson Rd.

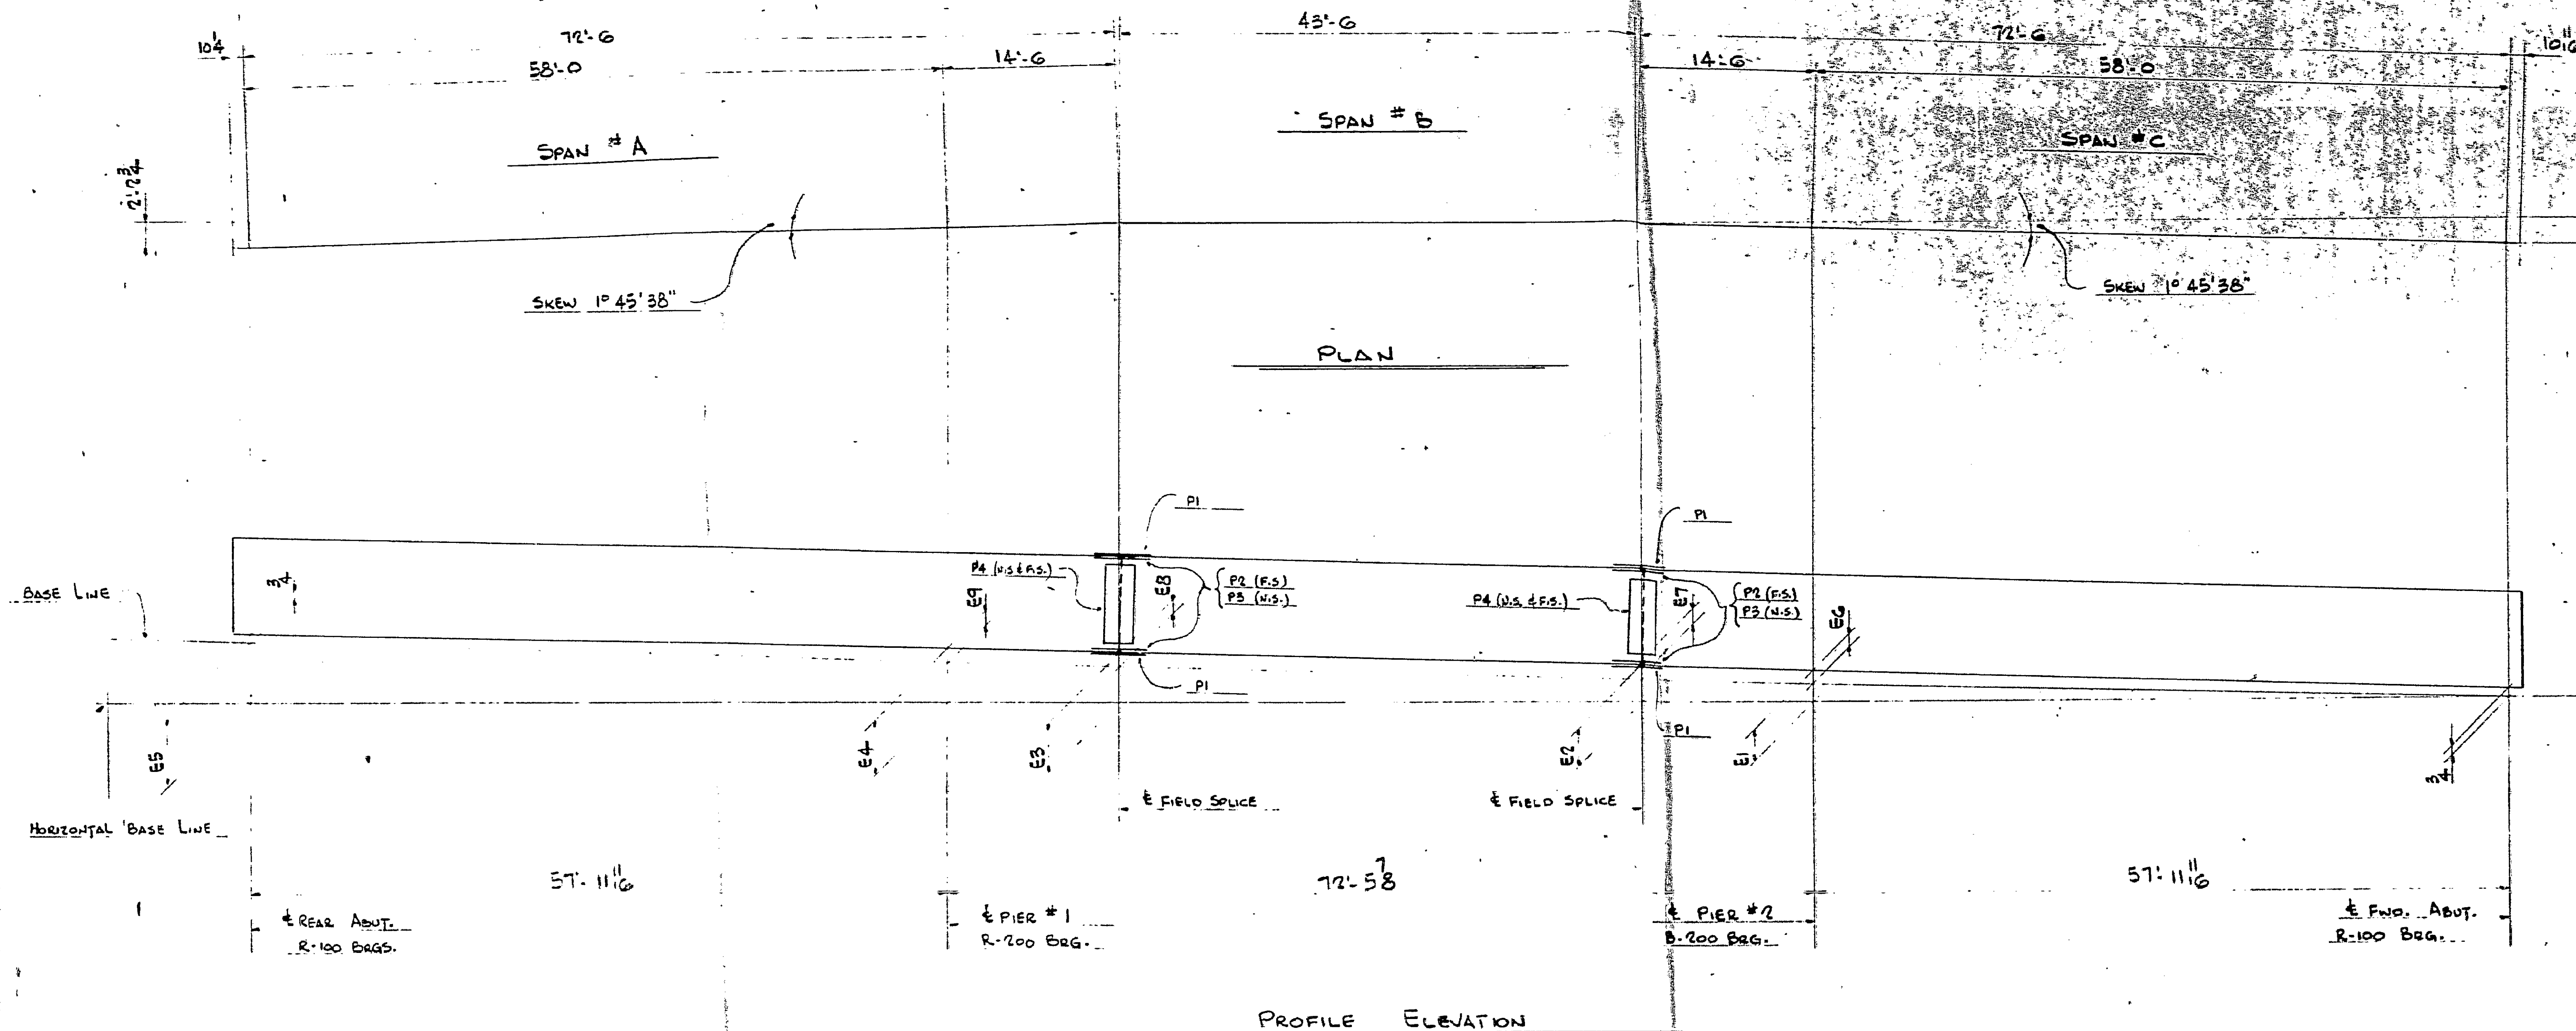

LINE	OFF SET DIMENSIONS									
	E1	E2	E3	E4	E5	E6	E7	E8	E9	
1	2'-0 3/4	2'-6 5/8	3'-7 1/4	3'-10 3/4	4'-10 3/8	7 3/8	8 5/8	8	7	
2	2'-1 1/2	2'-7 1/8	3'-8 1/8	4'-0 3/8	5'-0	7 1/4	8 1/4	8 3/8	7 1/8	
3	2'-2	2'-7 1/8	3'-9 1/8	4'-1 3/8	5'-1 3/8	7 1/8	8 1/8	8 1/8	7 1/8	
4	2'-2 1/2	2'-8 1/8	3'-10 3/8	4'-2 3/4	5'-3 3/8	7 1/8	8 1/8	8 1/8	7 1/8	
5	2'-3 1/4	2'-9 1/4	4'-0 3/8	4'-4 3/8	5'-5 3/8	7 1/8	8 1/8	8 1/8	7 1/8	
6	2'-4 1/8	2'-10 3/8	4'-1 3/4	4'-5 3/8	5'-7 1/8	7 1/8	8 1/8	8 1/8	7 1/8	

NOTES!

ALL OFFSET DIMENSIONS ARE TO THE BOTTOM OF BEAM FLANGE.
 BASE LINE IS A STRAIGHT LINE BELOW ABUTMENT BEARING POINTS.
 FIT-UP GAP BETWEEN BEAMS 5 MIN. & MAX.
 MATCH MARK SPICE PLATES AND BEAMS, AFTER DRILLING.
 SHIP SPICE PLATES BOLTED TO BEAMS IN CORRECT POSITION.
 WITH TWO BOLTS IN EACH SPICE. WIRE LOOSE FILL PLATES
 FOR SHIPPING -
 IN THE FINAL SHOP ASSEMBLY, FILLS SHALL BE FURNISHED
 WITH THICKNESS SUFFICIENT TO COMPENSATE FOR ANY
 MISALIGNMENT OF ABUTTING FLANGES & WEBS DUE TO
 STANDARD ROLLING MILL TOLERANCES. (THAT VARY
 BY MORE THAN 1/16 INCH)
 OFFSET DIMENSIONS INCLUDE SHOP CAMBER

BUREAU OF BRIDGES	
Engineer of Bridges	
APPROVED	APPROVED AS NOTED
NOT APPROVED	NOT APPROVED
for general conformance with design plans and specifications only. Does not relieve contractor of responsibility for errors or omissions.	

FOR REFERENCE





SHOP BOLTS.

24 - S.H.M.B. w/ S.W. 1" x 2 3/4
 48 - S.H.M.B. w/ S.W. 1" x 3 1/2


BEAM FIT UP & SPICE PLATE LOCATION			
DATE	NO.	REVISION	BY CH. BY
HOLES UNLESS NOTED		FINISH UNLESS NOTED	
SHOP CONNECTIONS BOLTED		FIELD CONNECTIONS BOLTED	
ERECTOR BY		OTHERS	
FOR	NO.	DATE	
ADDD	3	8-7	
SHED	3	8-11-64	
OSHD	4	8-21	
CONTR	3	8-21	
BRIDGE # 11 - CR - 25 WILSON RD. OVER N.Y.C. R.R. FRANKLIN COUNTY WHITAKER MERRELL CO. CONTRACTOR O.S.H.O. (BARETT ASSOCIATED ENG.) ARCHITECT-ENGINEER CONTRACT NO. 10857 DRAWN JB CHECKED LC. APPROVED O.S.H.D. 8-20-64 A 10 OF			

5082 0110 SHOP BLDG STR STEEL 0063 11968 0160 060






Technical drawing of a ship's hull section, showing the end fin and bracing. The drawing includes a plan view at the top and a side view below. The plan view shows a rectangular hull section with a central fin and bracing structure. The side view shows the hull's profile with a fin and bracing structure. The drawing is labeled "END FIN AND BRACING" at the bottom.

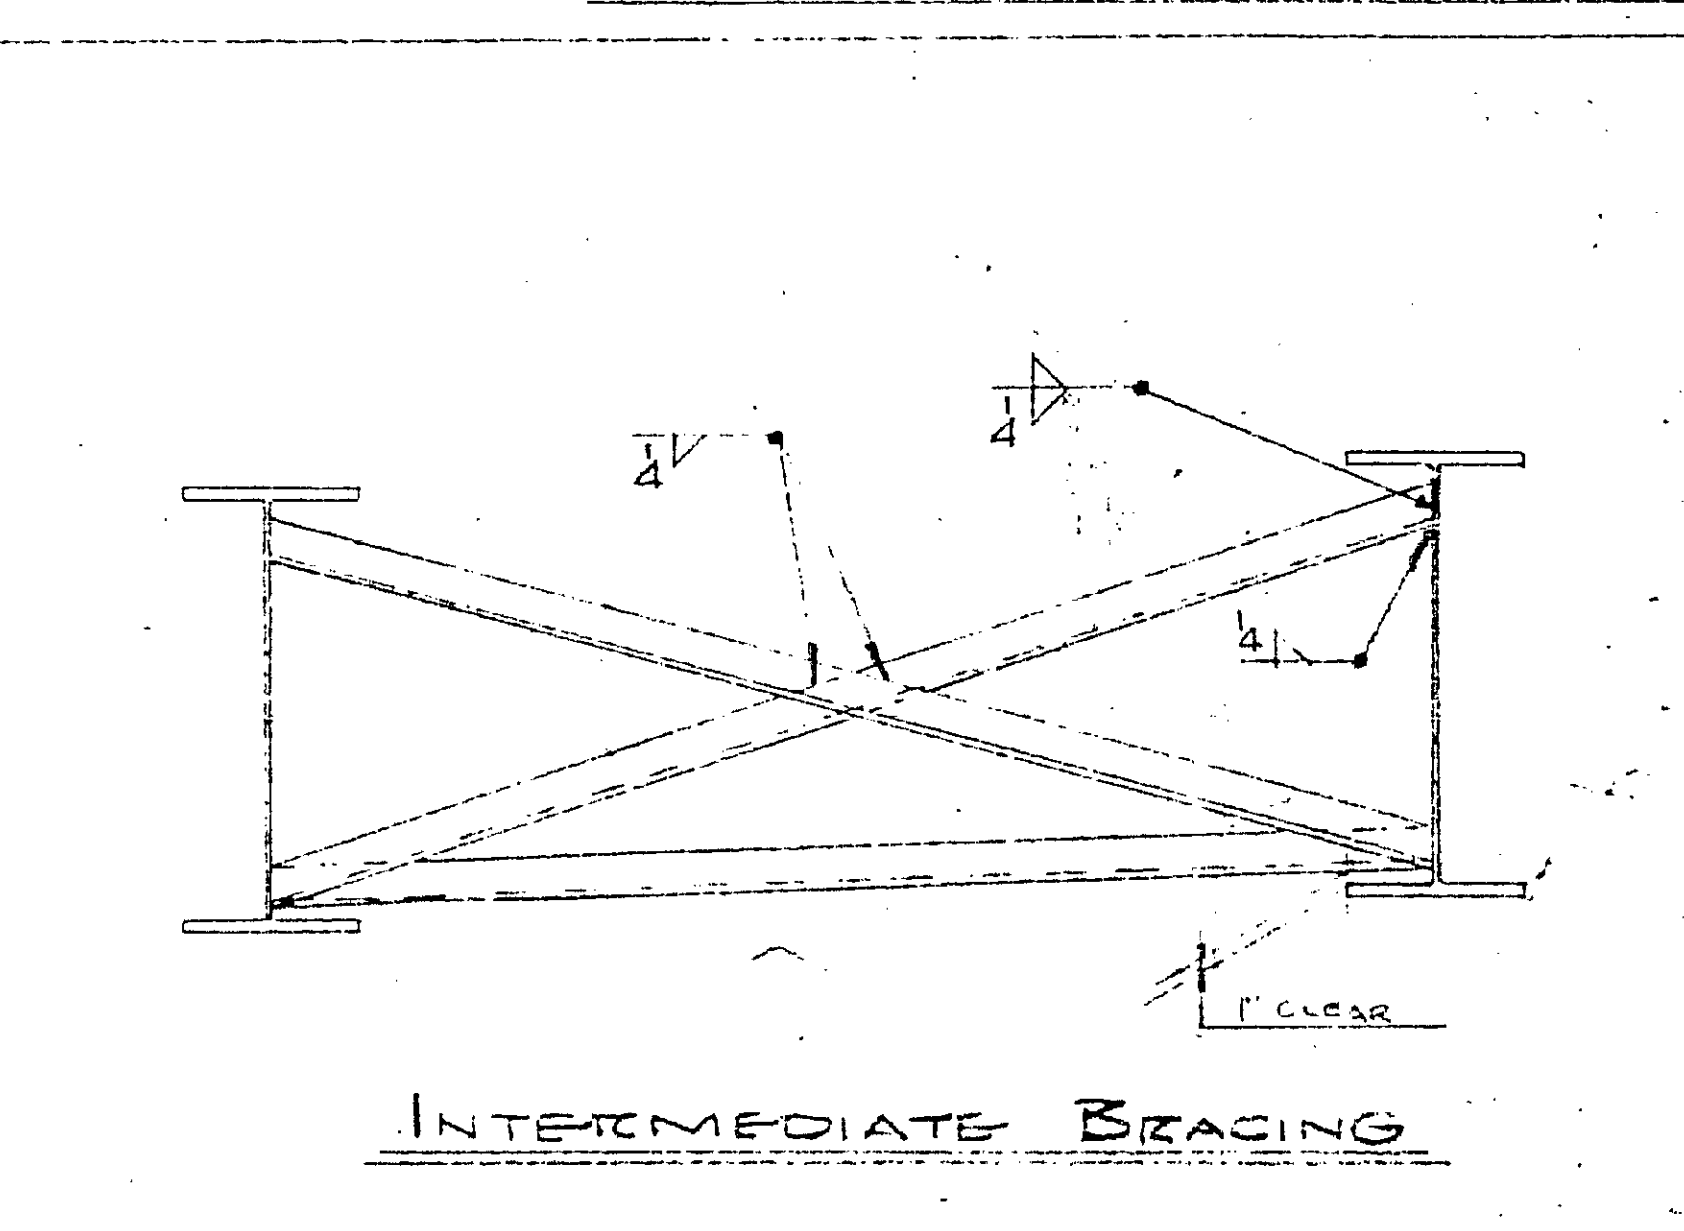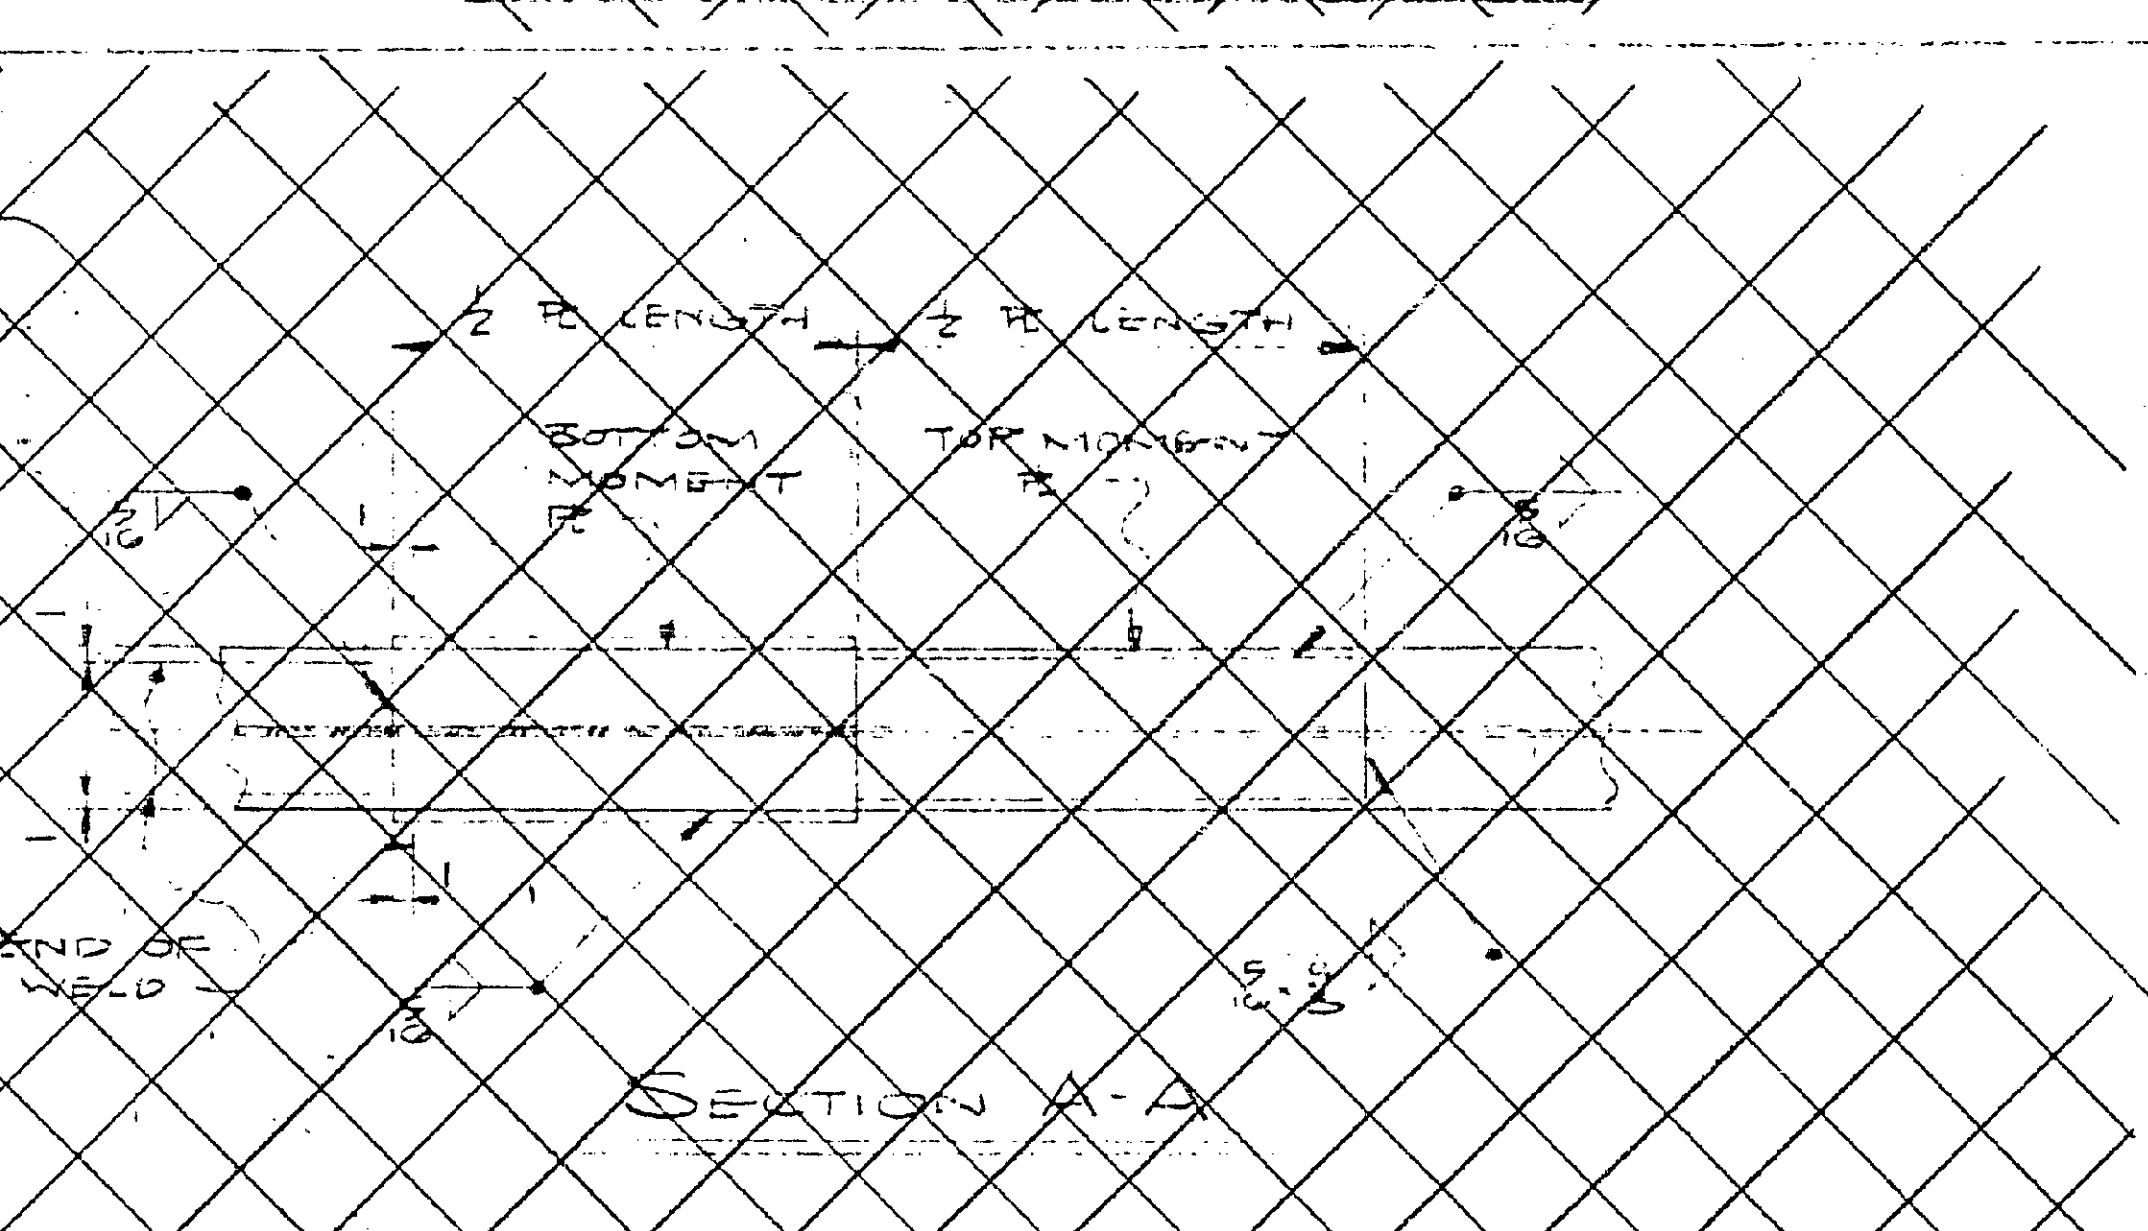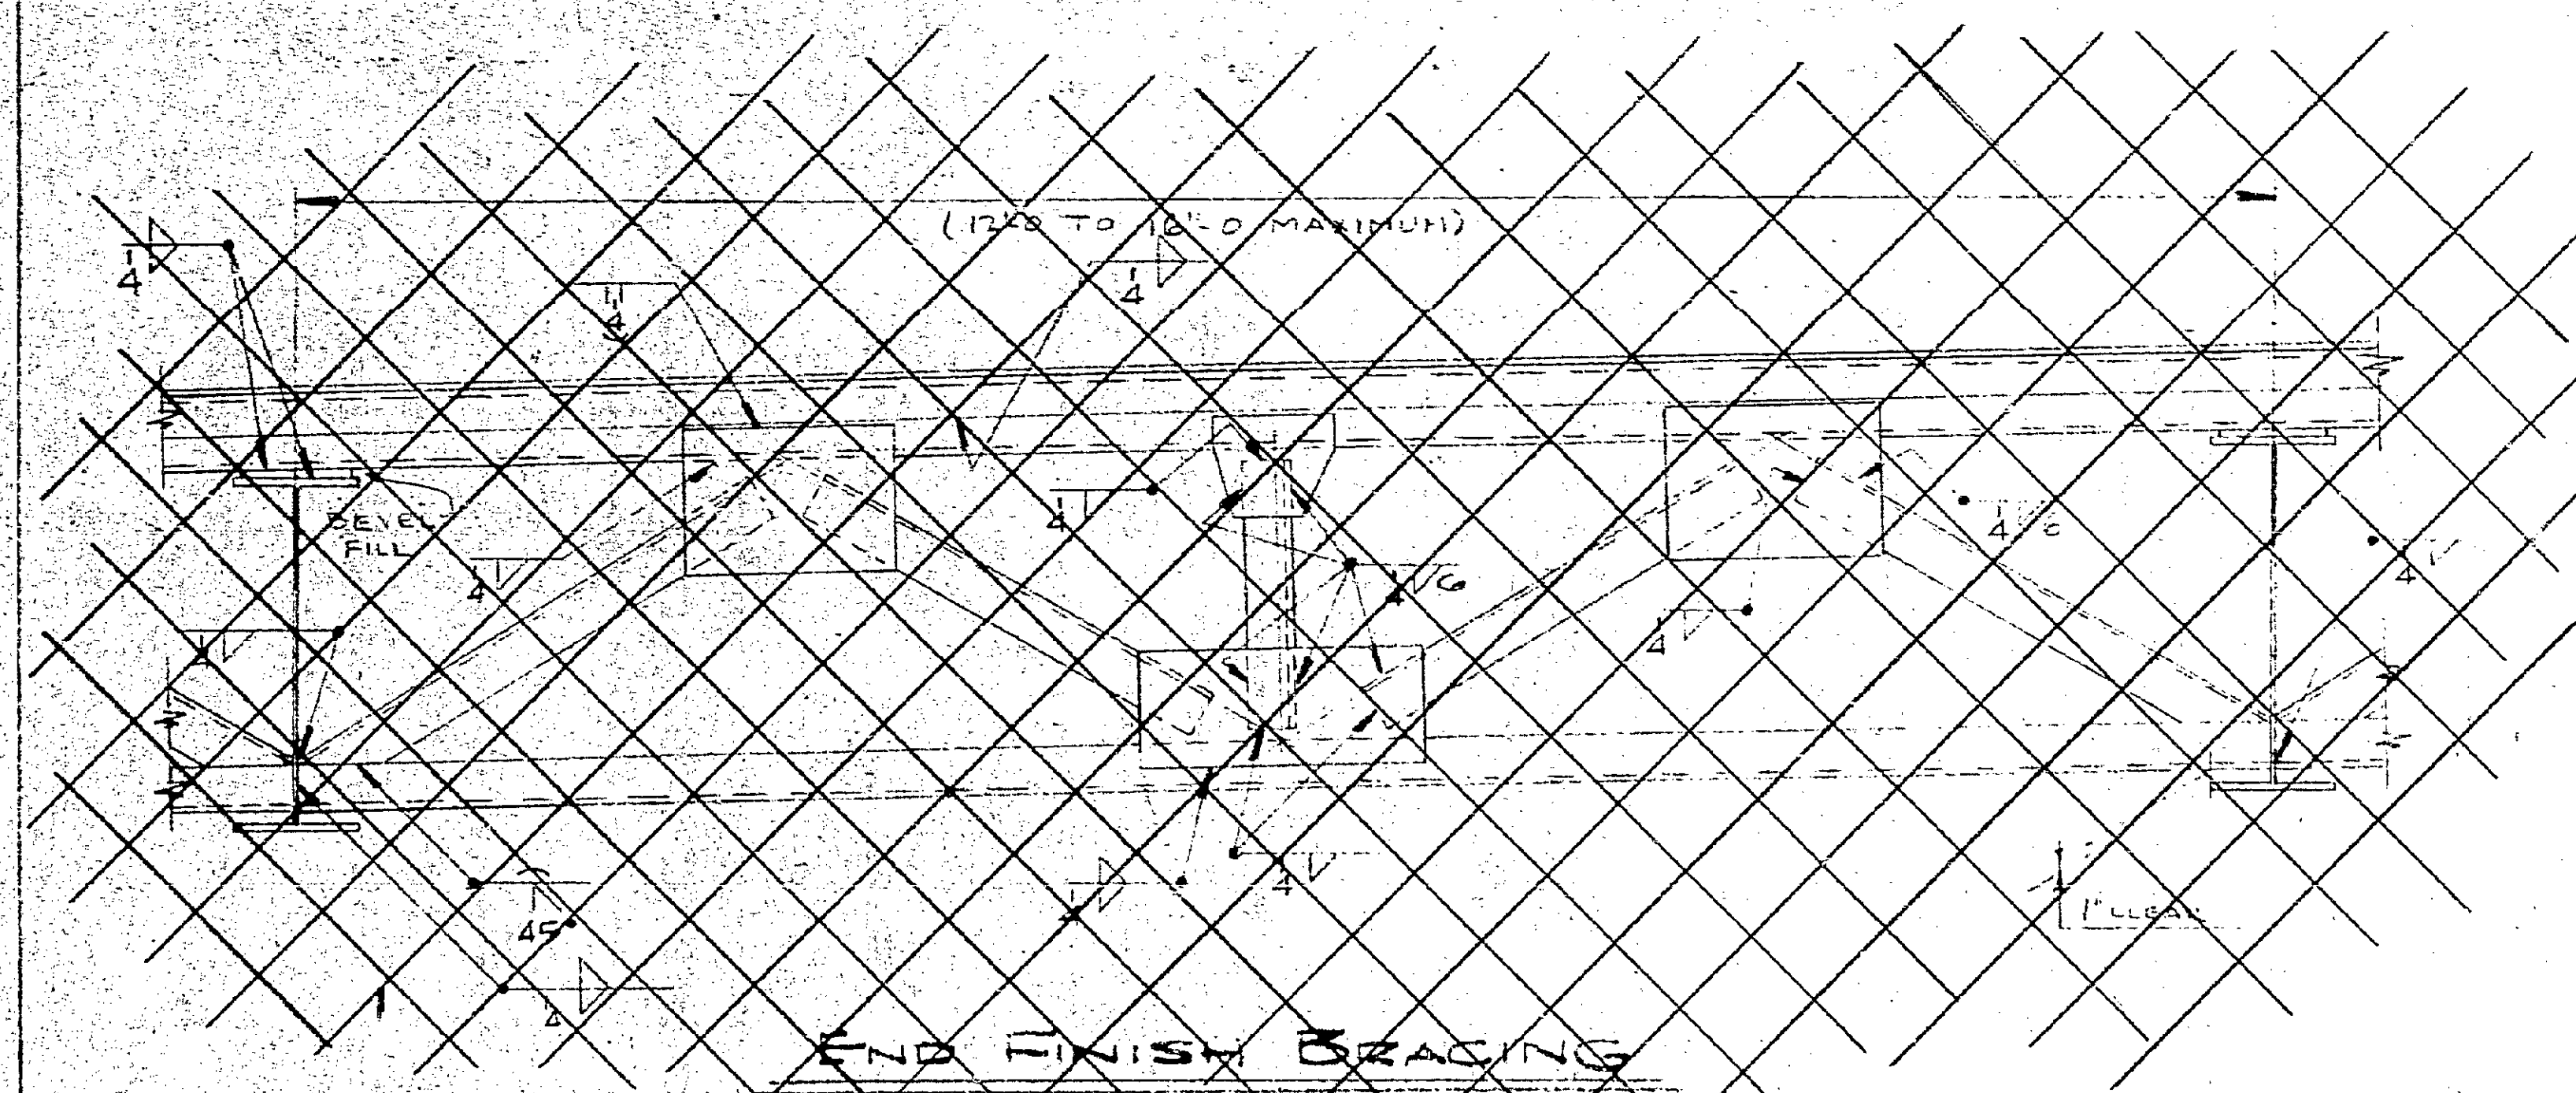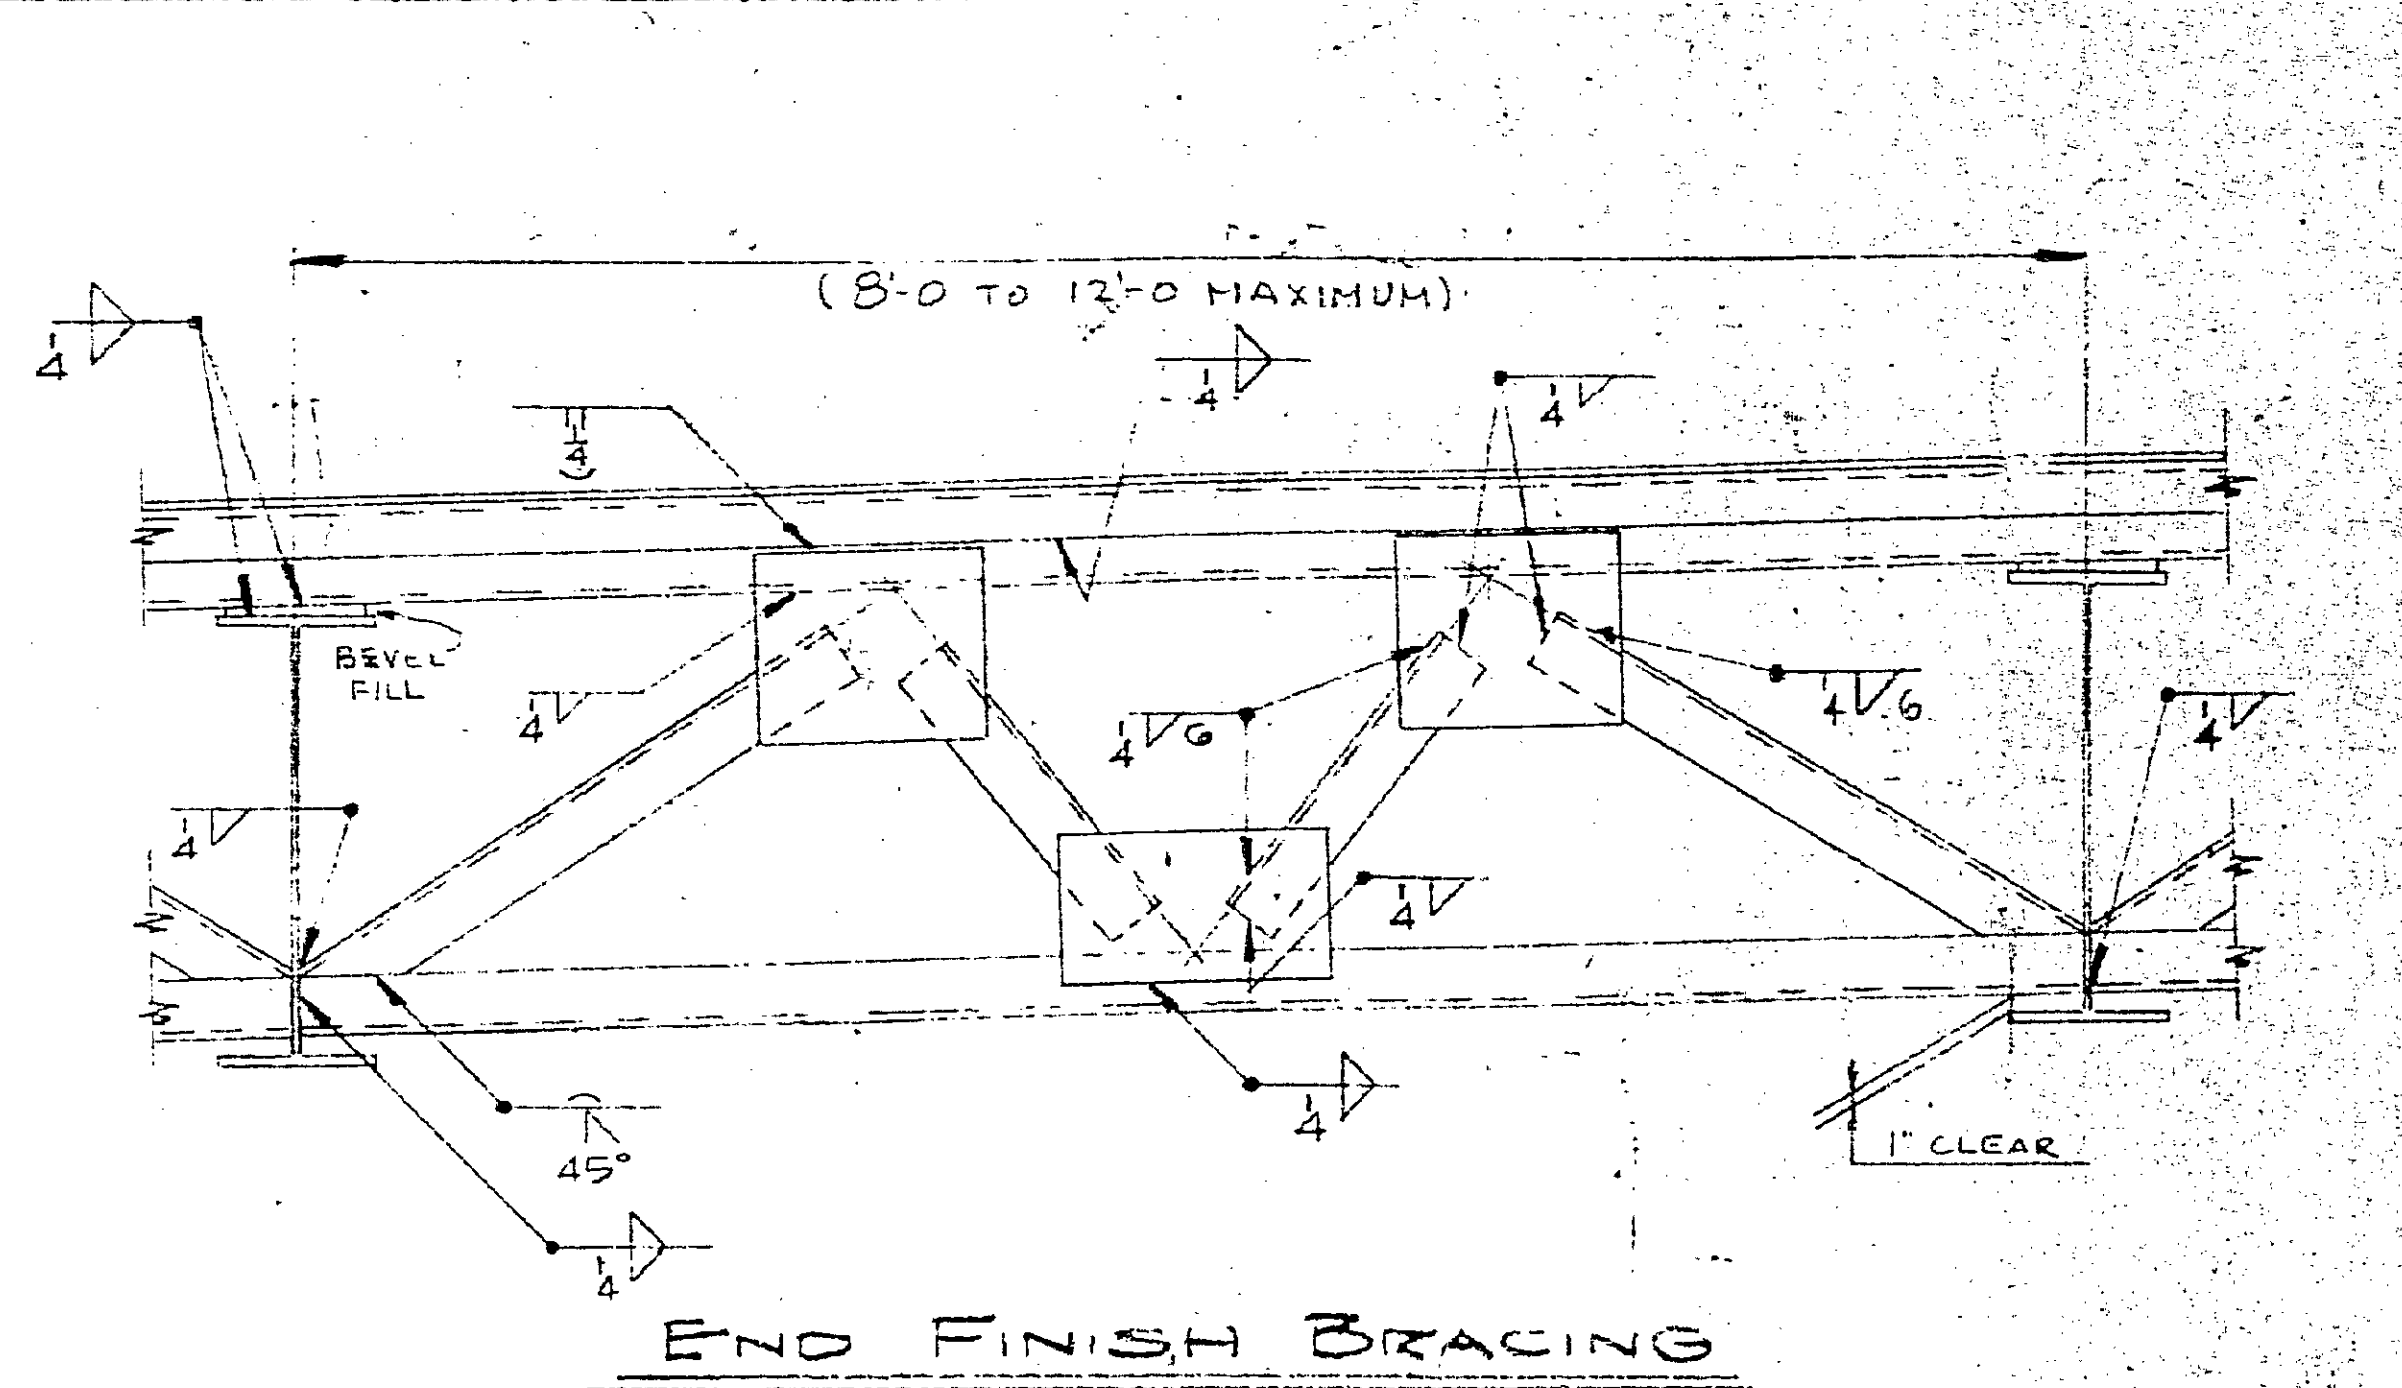

THIS CONTACT SURFACE SHALL NOT
BE PAINTED & SHALL BE LUBRICATED
WITH FLAKE GRAPHITE PRIOR TO
PLACING OF BACKWALL CONCRETE.

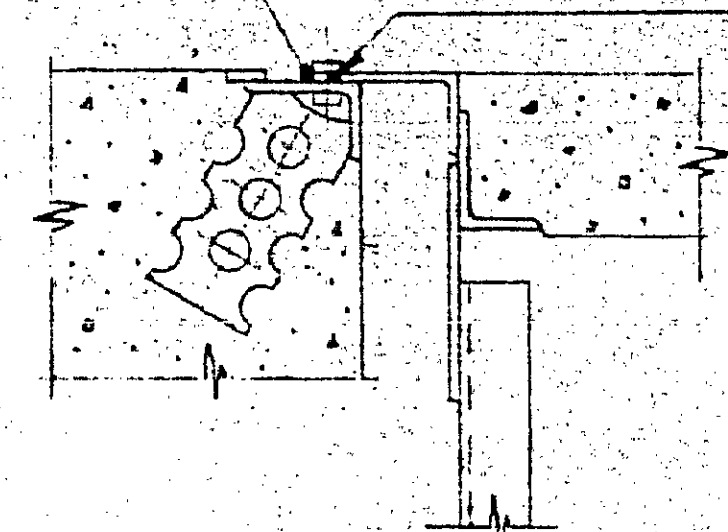

APPLY FLAKE GRAPHITE
BETWEEN WASHERS &
ANGLE. TURN BOLT TIGHT
& RELEASE ONE HALF
TURN. REMOVE BOLTS AS
SOON AS CONCRETE HAS
SET, PREFERABLY WITHIN
2 HOURS. FILL HOLES WITH
BITUMINOUS MATERIAL

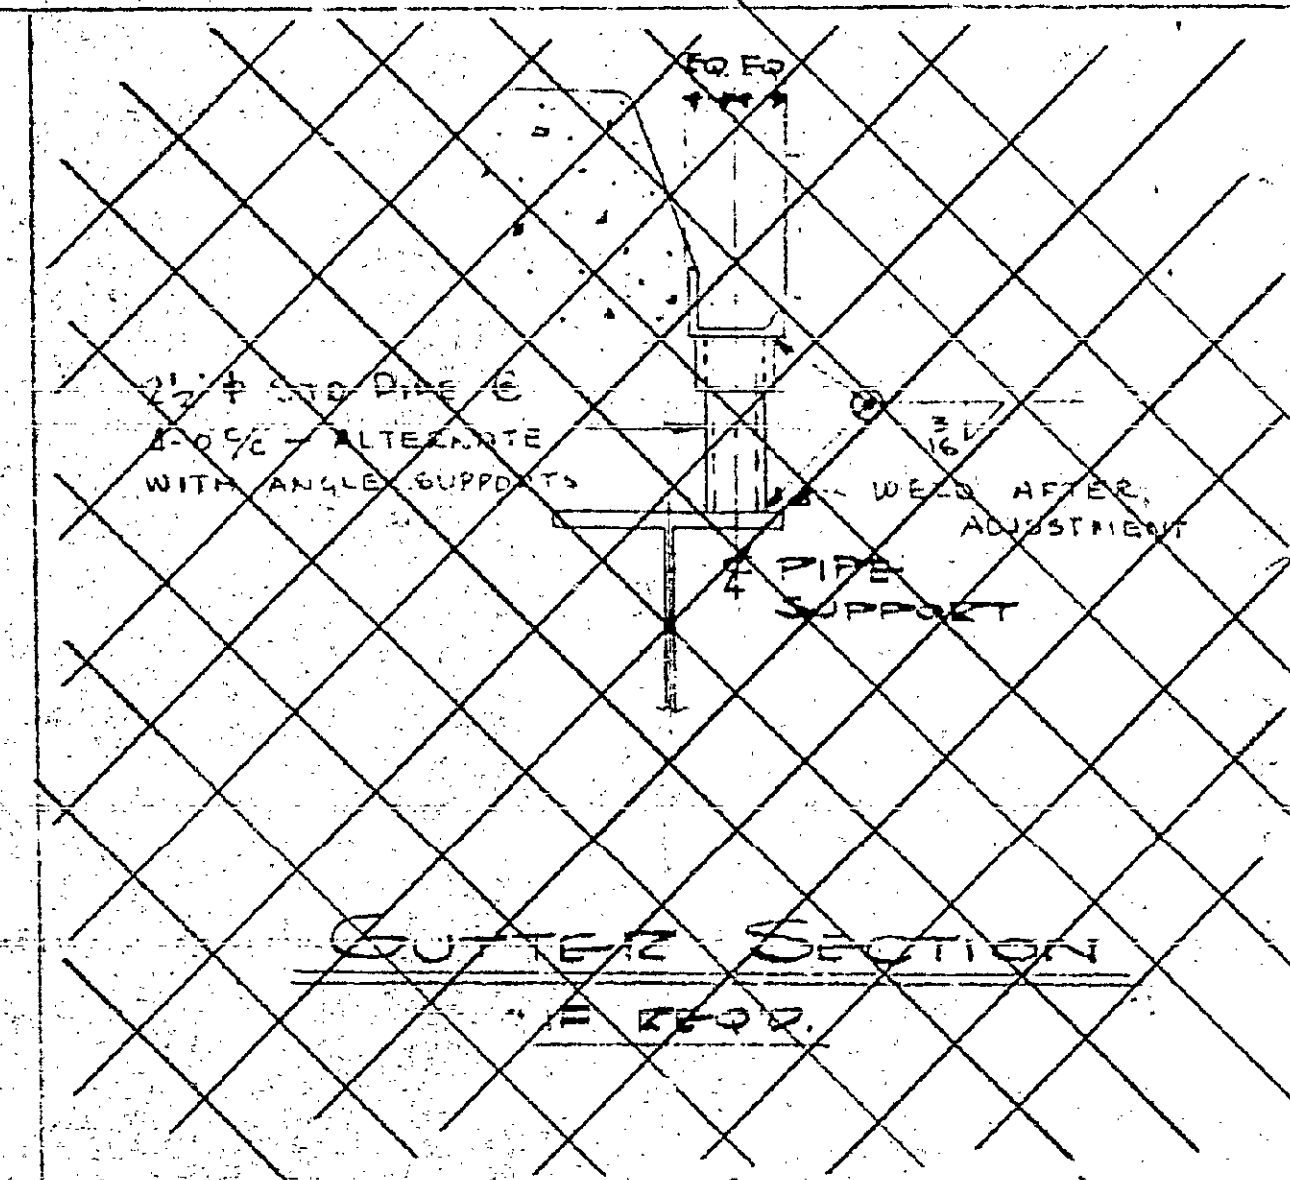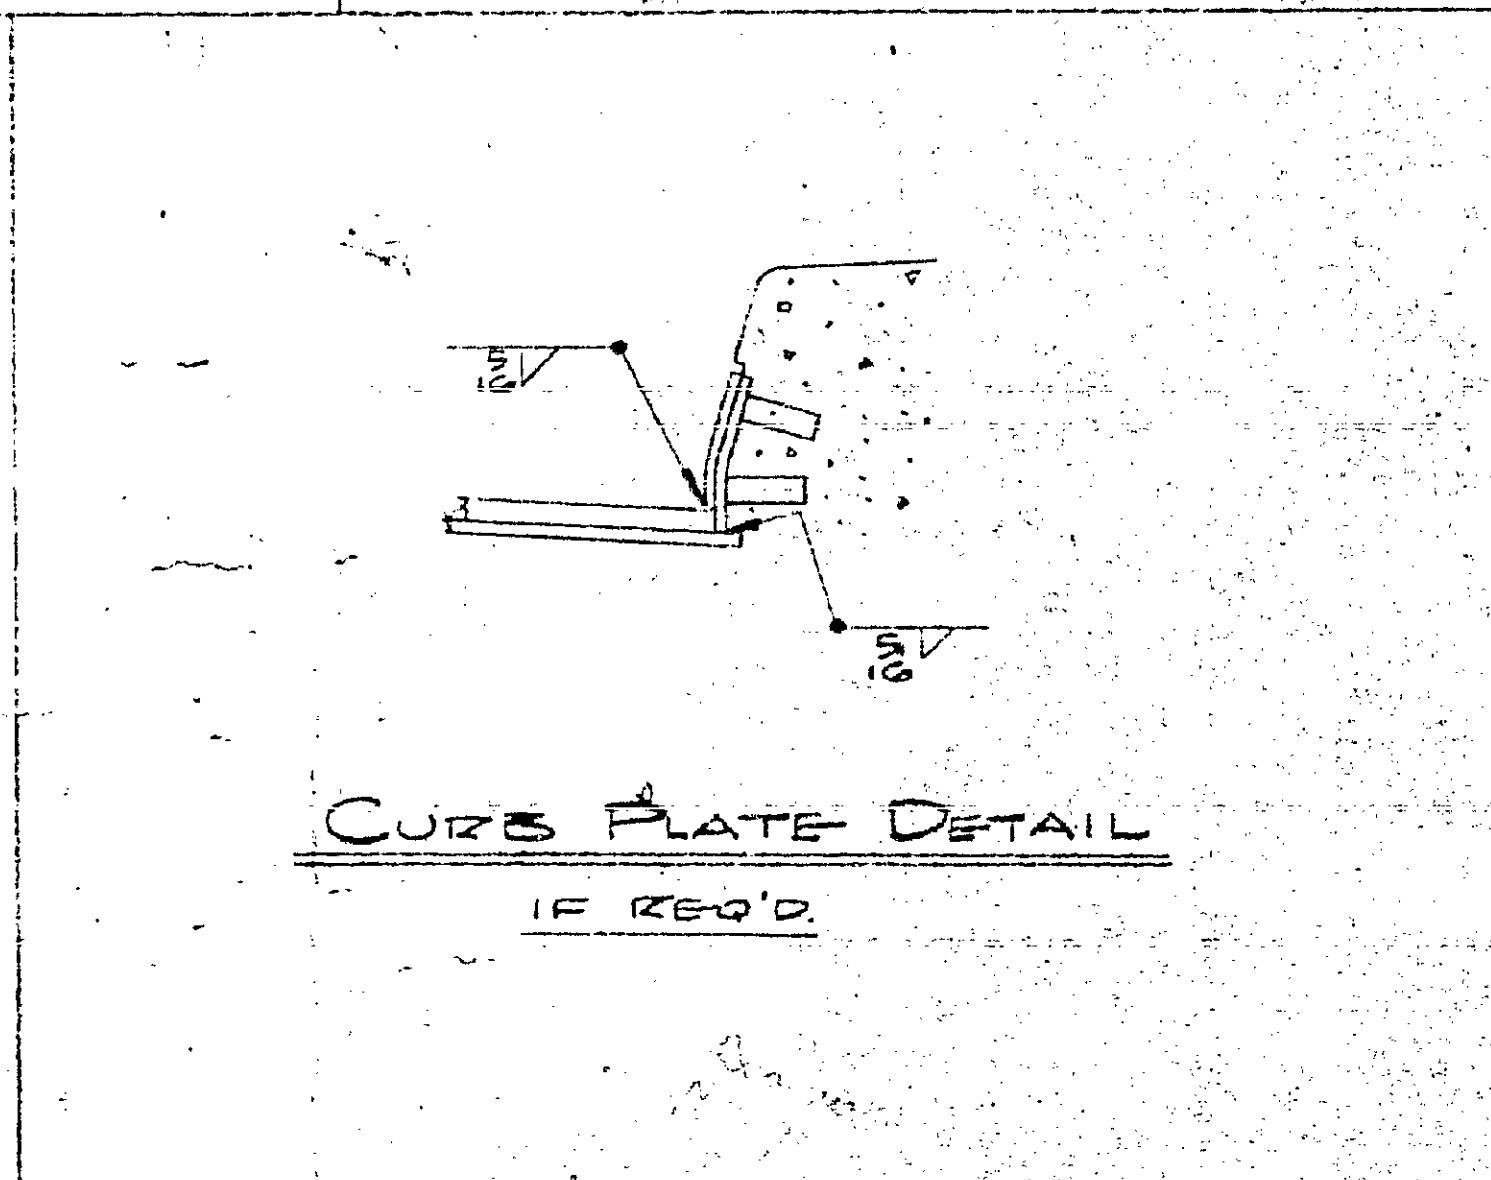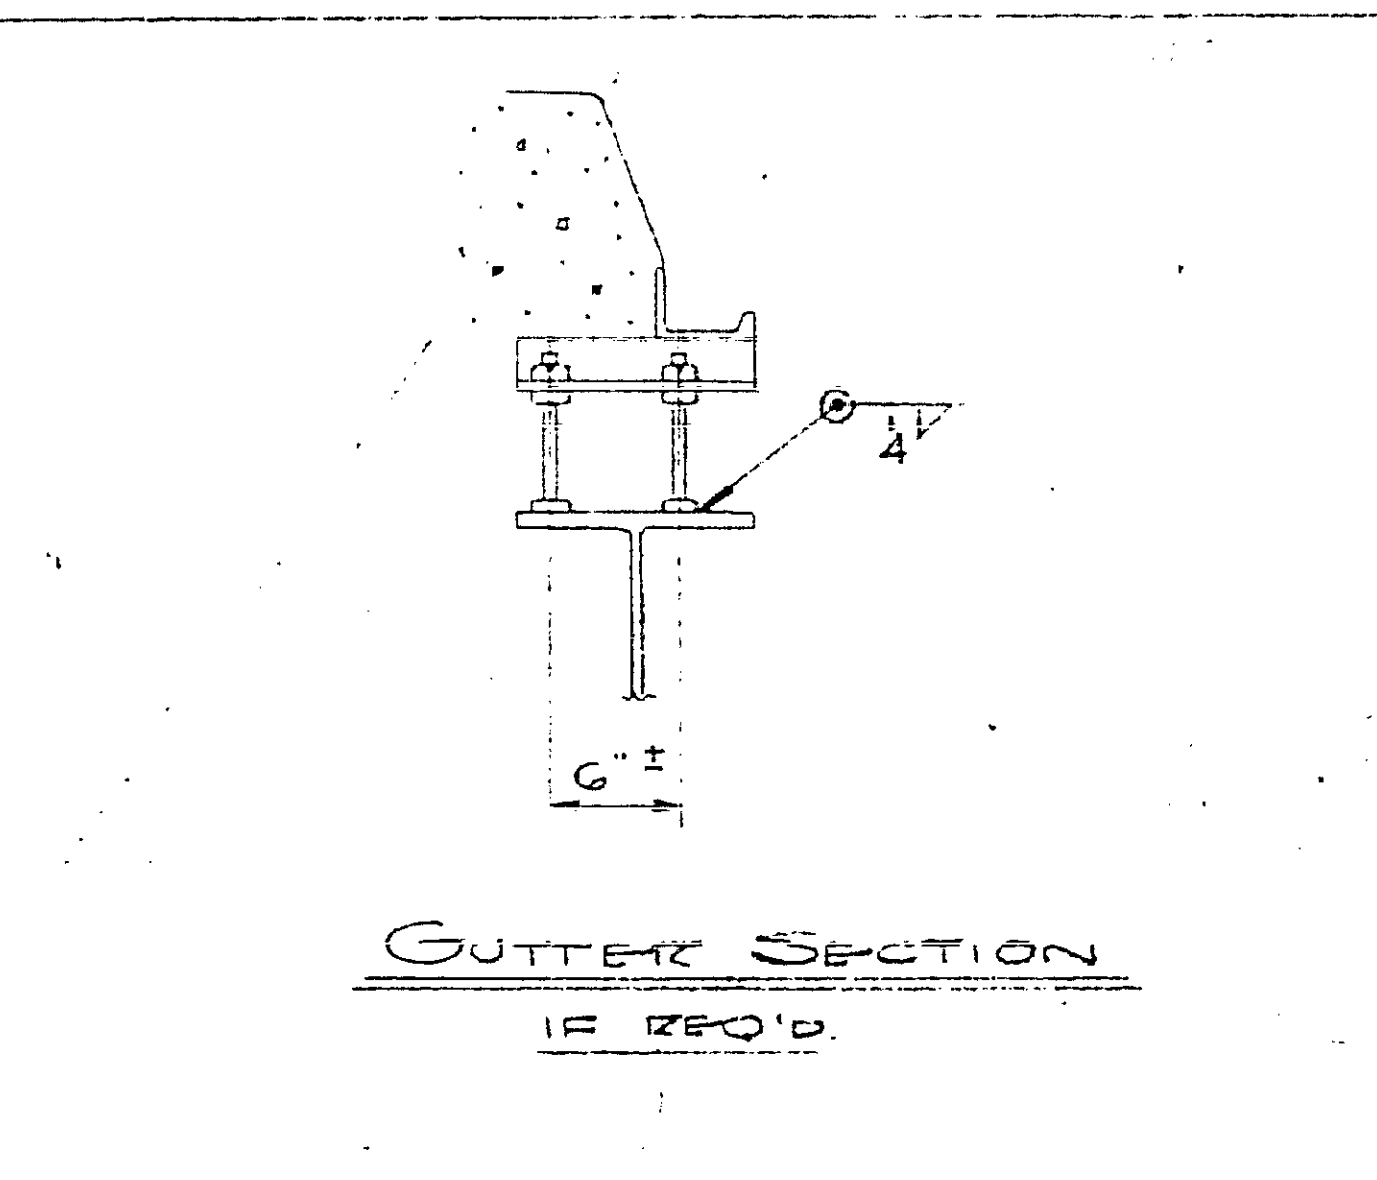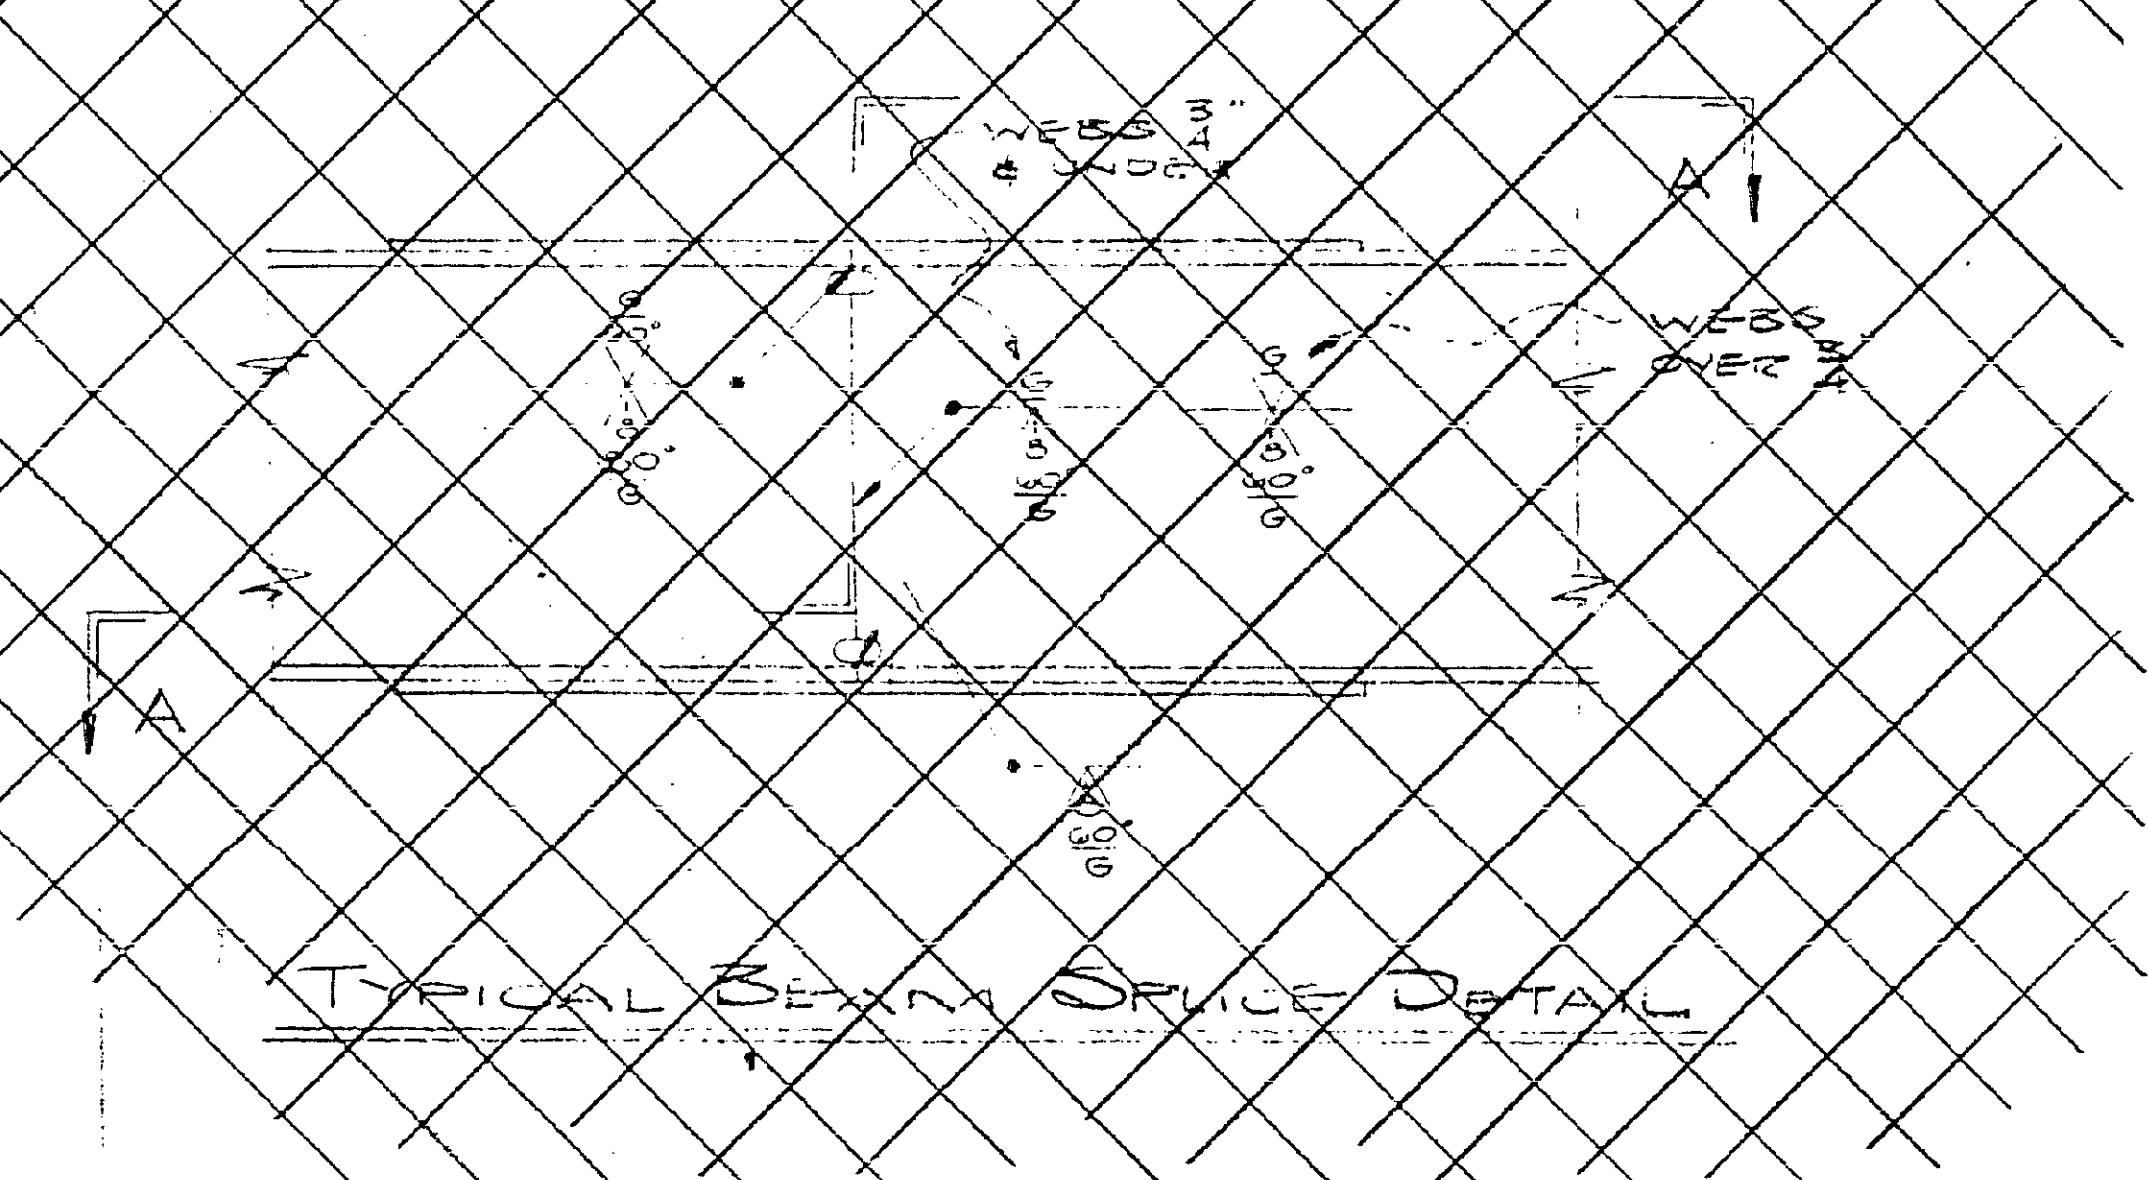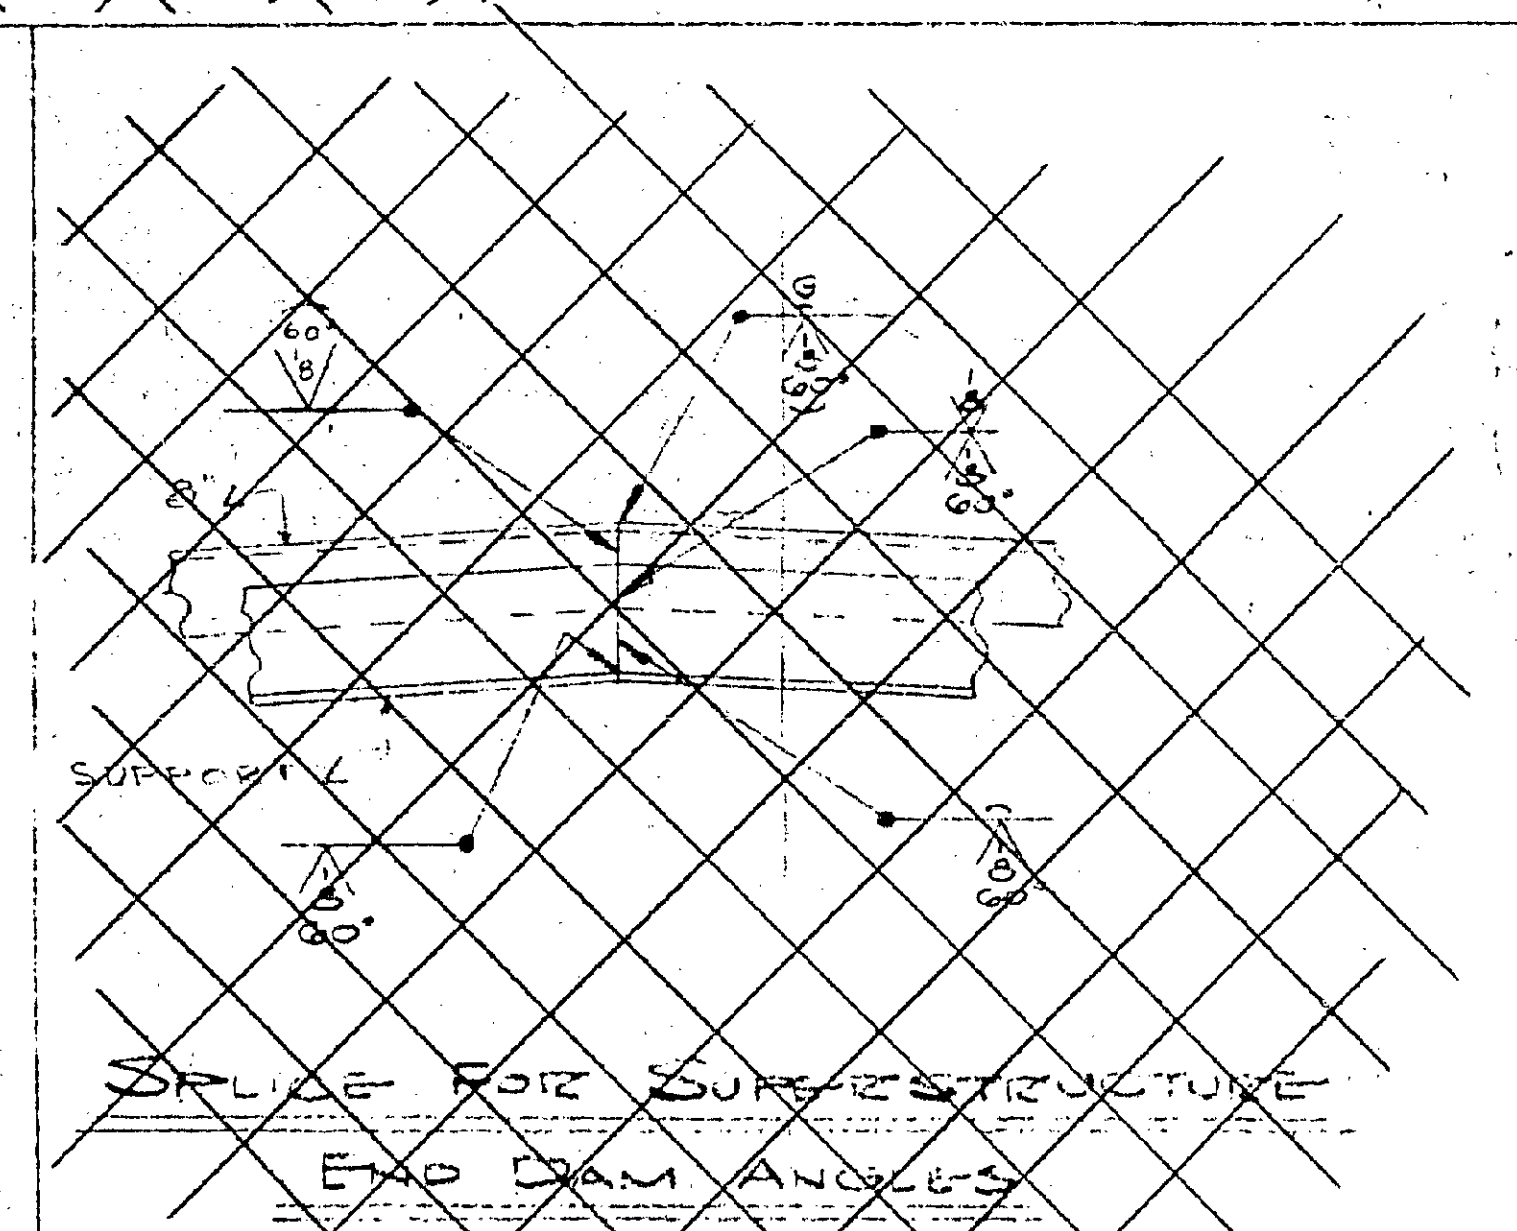

BUREAU OF BRIDGES	
<i>C. H. Robertson</i>	Engineer of Bridges
APPROVED	<i>WRS</i> 825
APPROVED AS NOTED	
NOT APPROVED	
for general conformance with design plans and specifications only. Does not relieve contractor from responsibility for errors or omissions.	

TOP SECRET

REF: O. S. H. D. STD. DWGS. FOR STEEL BENT FRAMES

BRIDGE ERECTION DETAILS

OHIO STATE HIGHWAY DEPARTMENT

12SEP65	1	ADD ENCL DAM SPLICE WITHOUT APLX	5	
12AUG65	1	REV. TO COMPLY W/ DND STD.	5	ENCL
DATE	NO.	REVISION	BY	CH. 5


HOLTS _____ UNLESS NOTED	FINISH UNLESS NOTED
SHOP CONNECTIONS _____	
FIELD CONNECTIONS _____	
SECTION BY _____	

[illegible]


OHIO STATE HIGHWAY DEPARTMENT				
ARCHITECT-ENGINEER				
CONTRACT NO.	DRAWN	CHECKED	APPROVED	DATE
20852	JB	LC	OSND	AZE OF
	JULY - 66		8-20-66	

~~BEAM SPICE WELDING PROCEDURE FOR 3 SPANS~~

- ① RAISE THE ABUTMENT END OF BEAMS TABULATED AMOUNT (R) =
- ② BUTT WELD THE BEAM FLG & WEB, USING THE FOLLOWING SEQUENCE: MAKE (TWO) (ONE) PASSES ON THE WEB, THEN (TWO) (ONE) ON EACH FLANGE; REPEAT, USING ONE PASS (OR TWO) AT EACH LOCATION, UNTIL WELDS ARE COMPLETED.
- ③ WELD THE BOTTOM & TOP MOMENT RES.
- ④ LOWER THE BEAM FLGS TO FINAL POSITION.

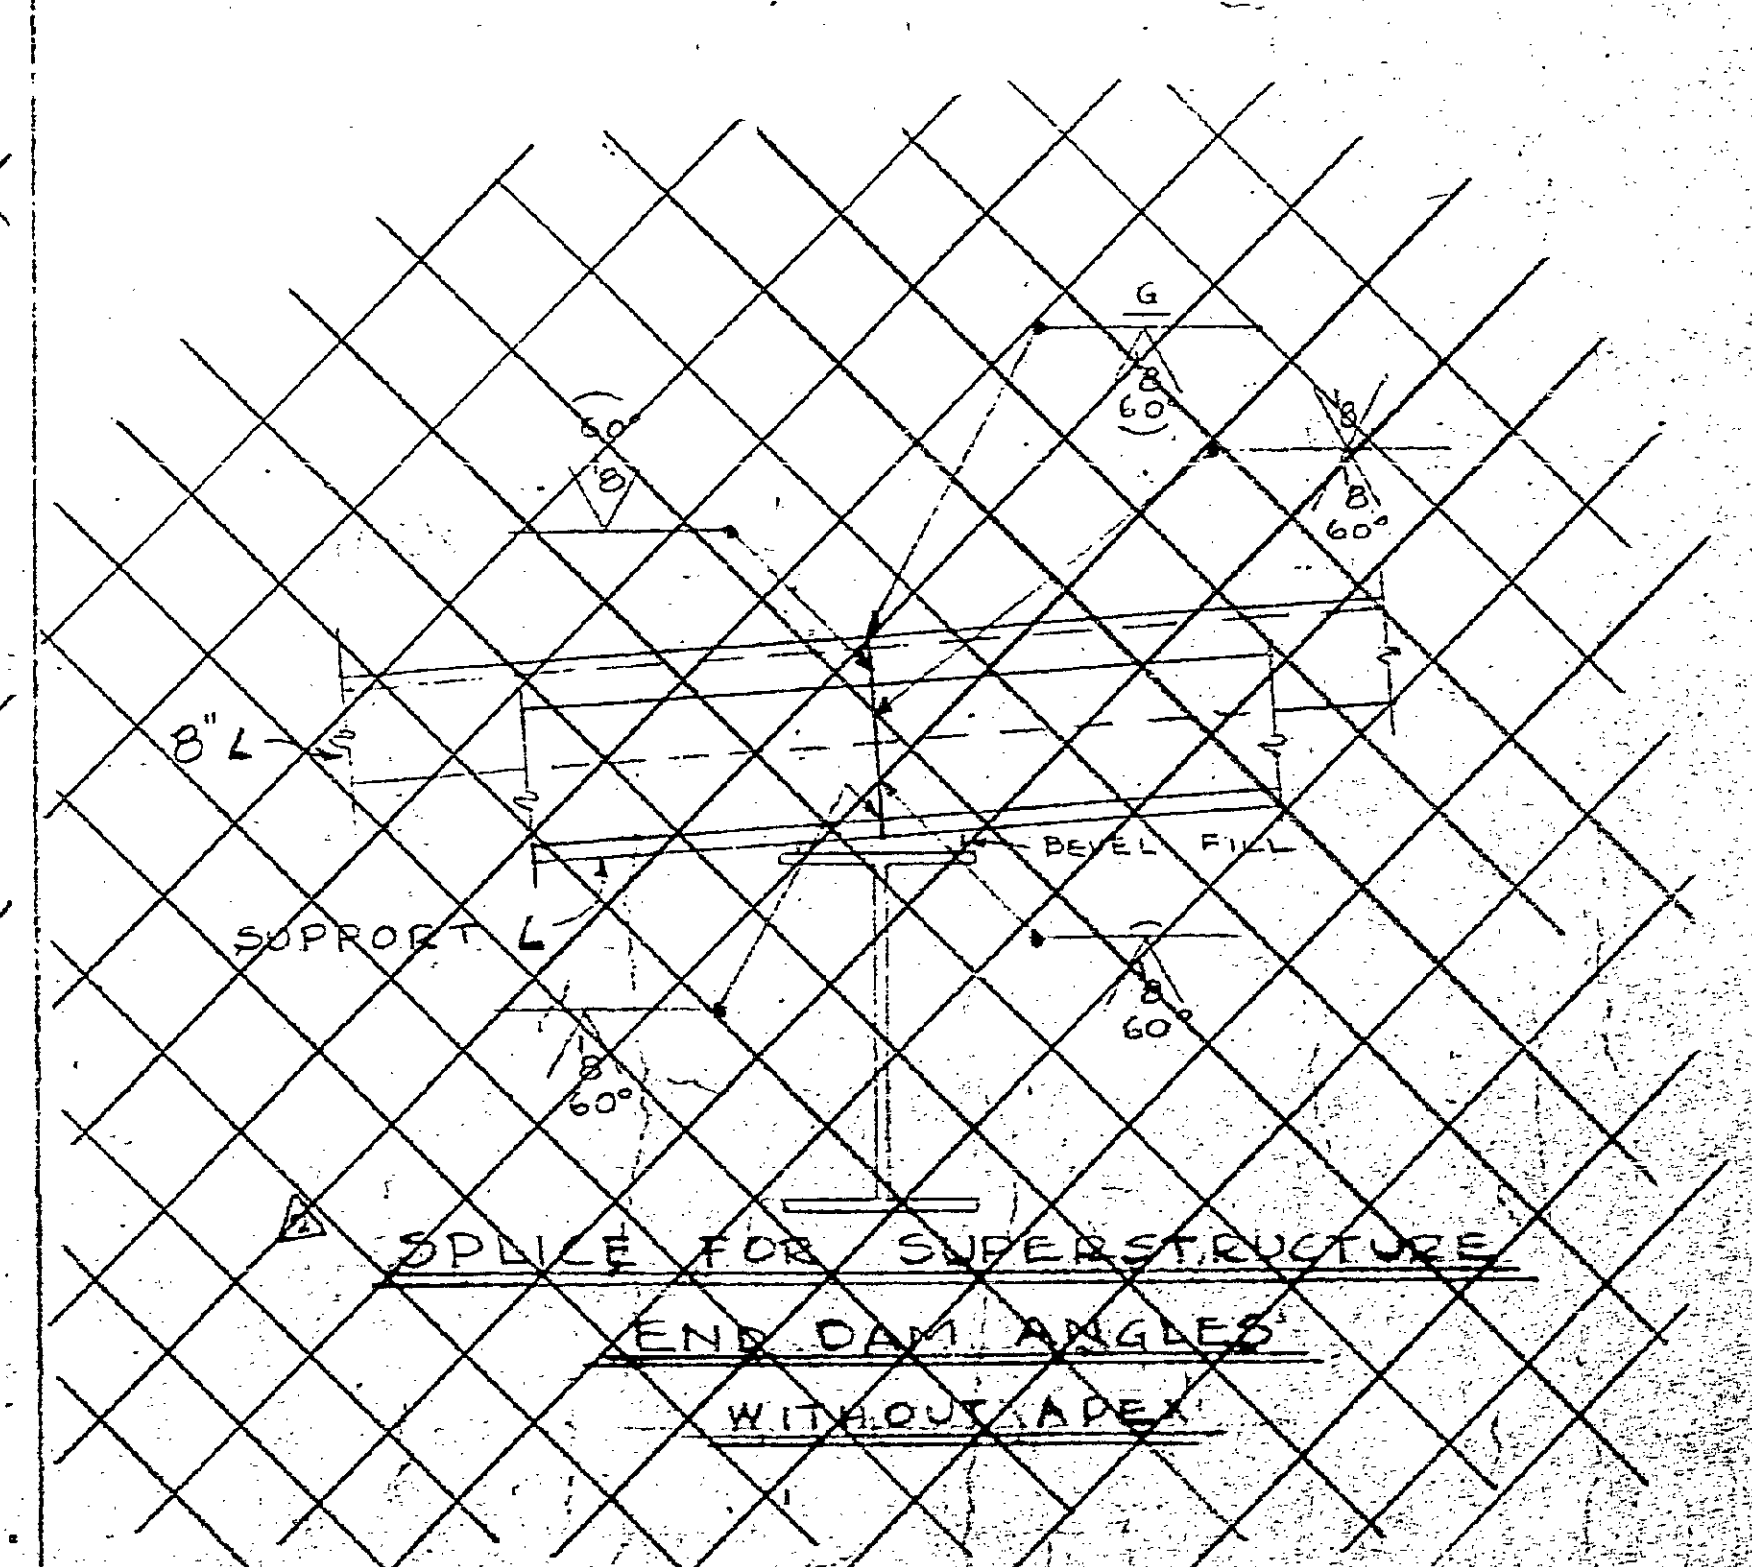

BOLTED BEAM SPLICE

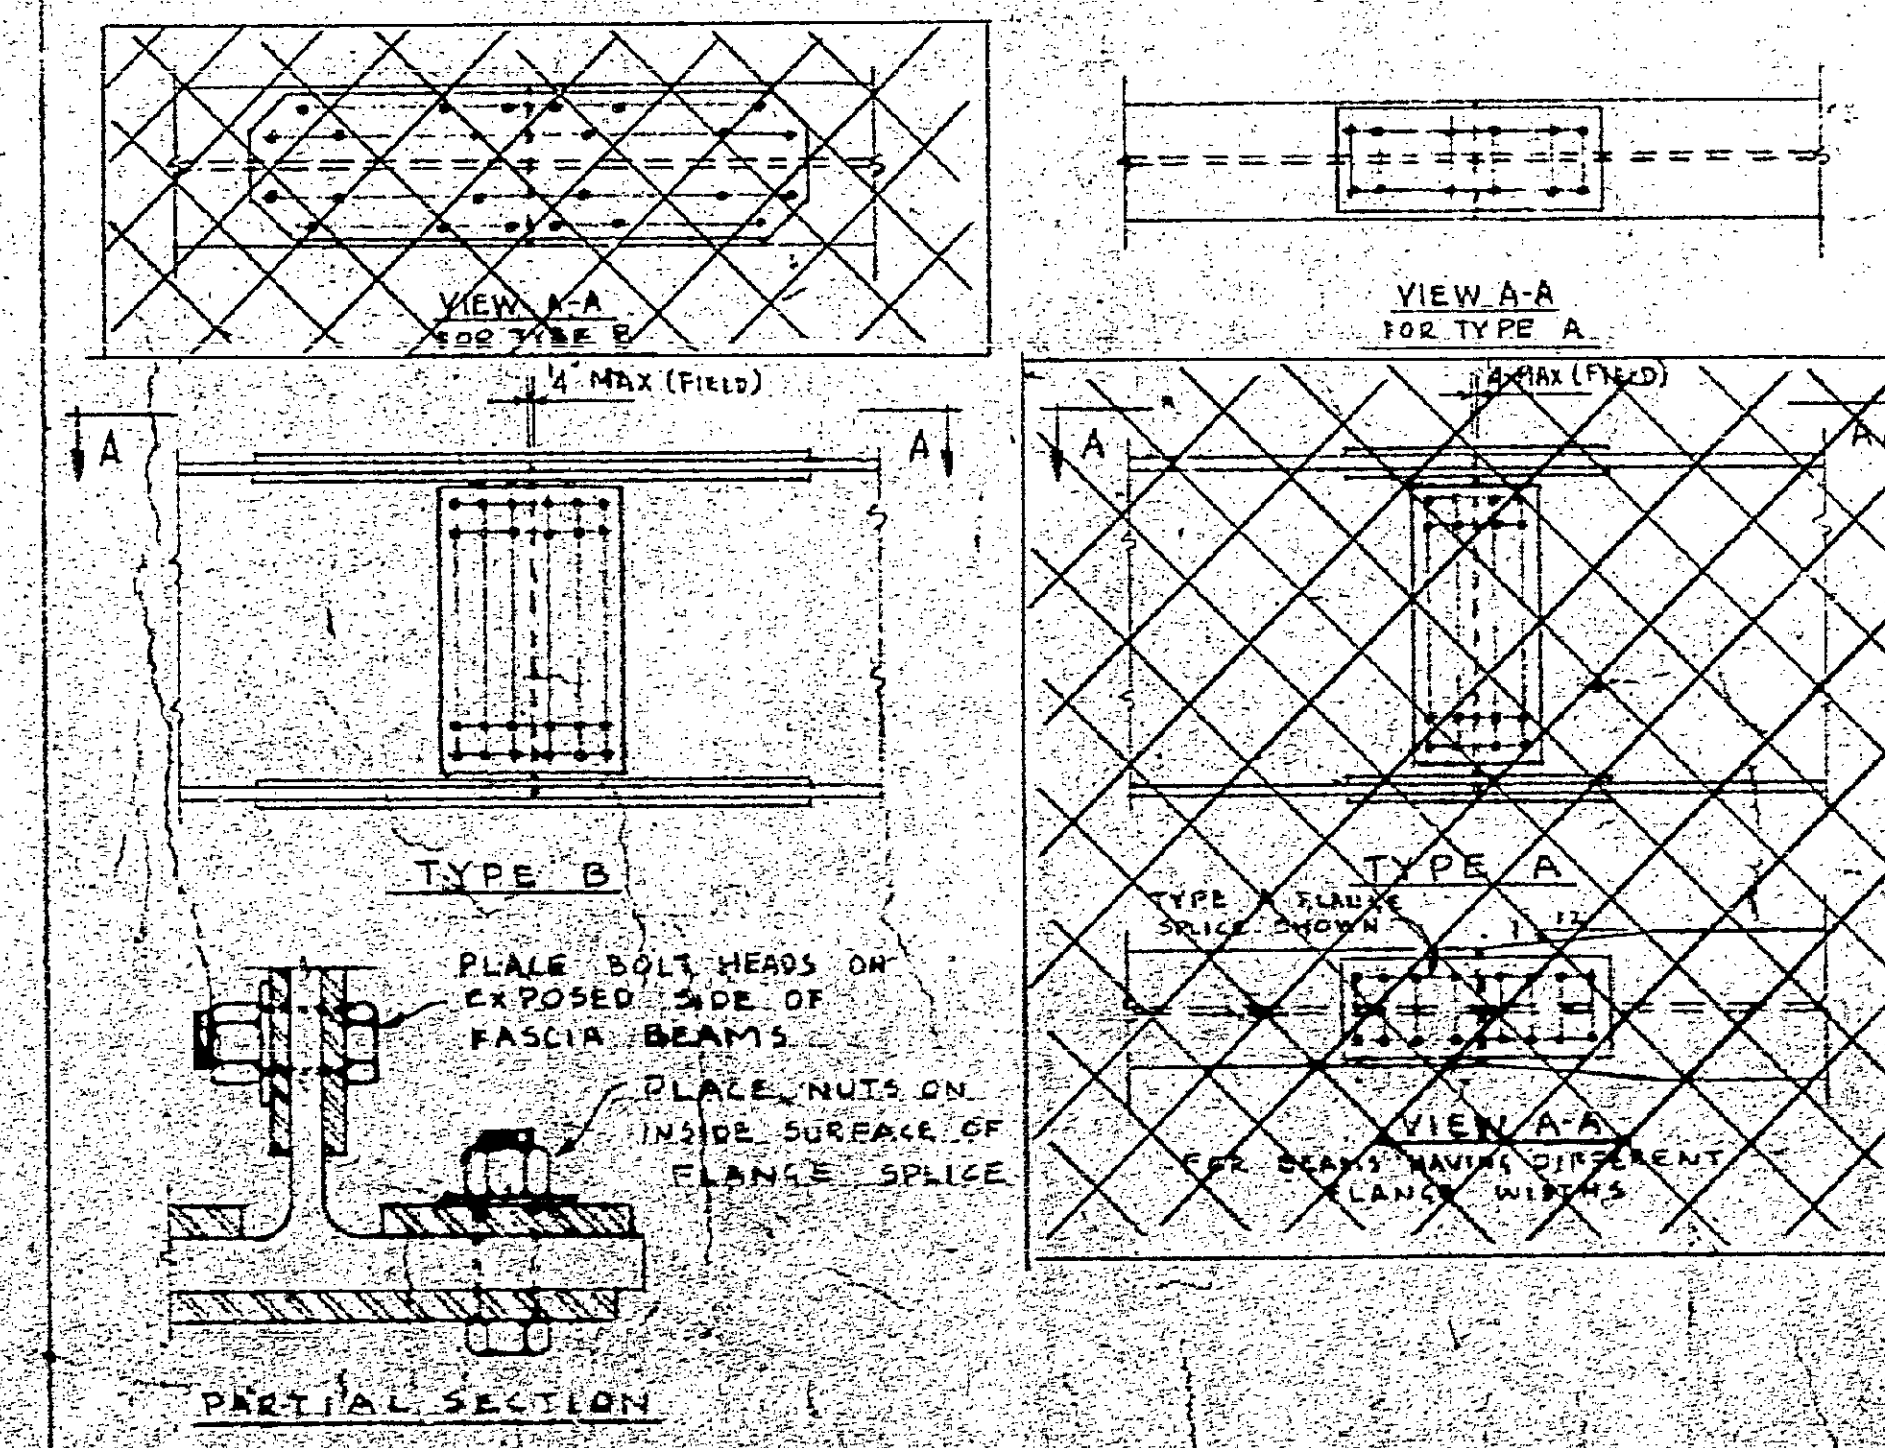


SUBSTANDARD DRAWING

This drawing does not meet minimum filming standards! **MICRO-DATA** does not accept responsibility for the inferior results due to the condition of this drawing.

5080	010	SHOT DWG. STR. STEEL							0063	1968	0170	060
------	-----	----------------------	--	--	--	--	--	--	------	------	------	-----

a aa ba
b ob bb
c
d
e
f
g
h
i
j
k
l
m
n
o
p
q
r
s
t
u
v
w
x
y

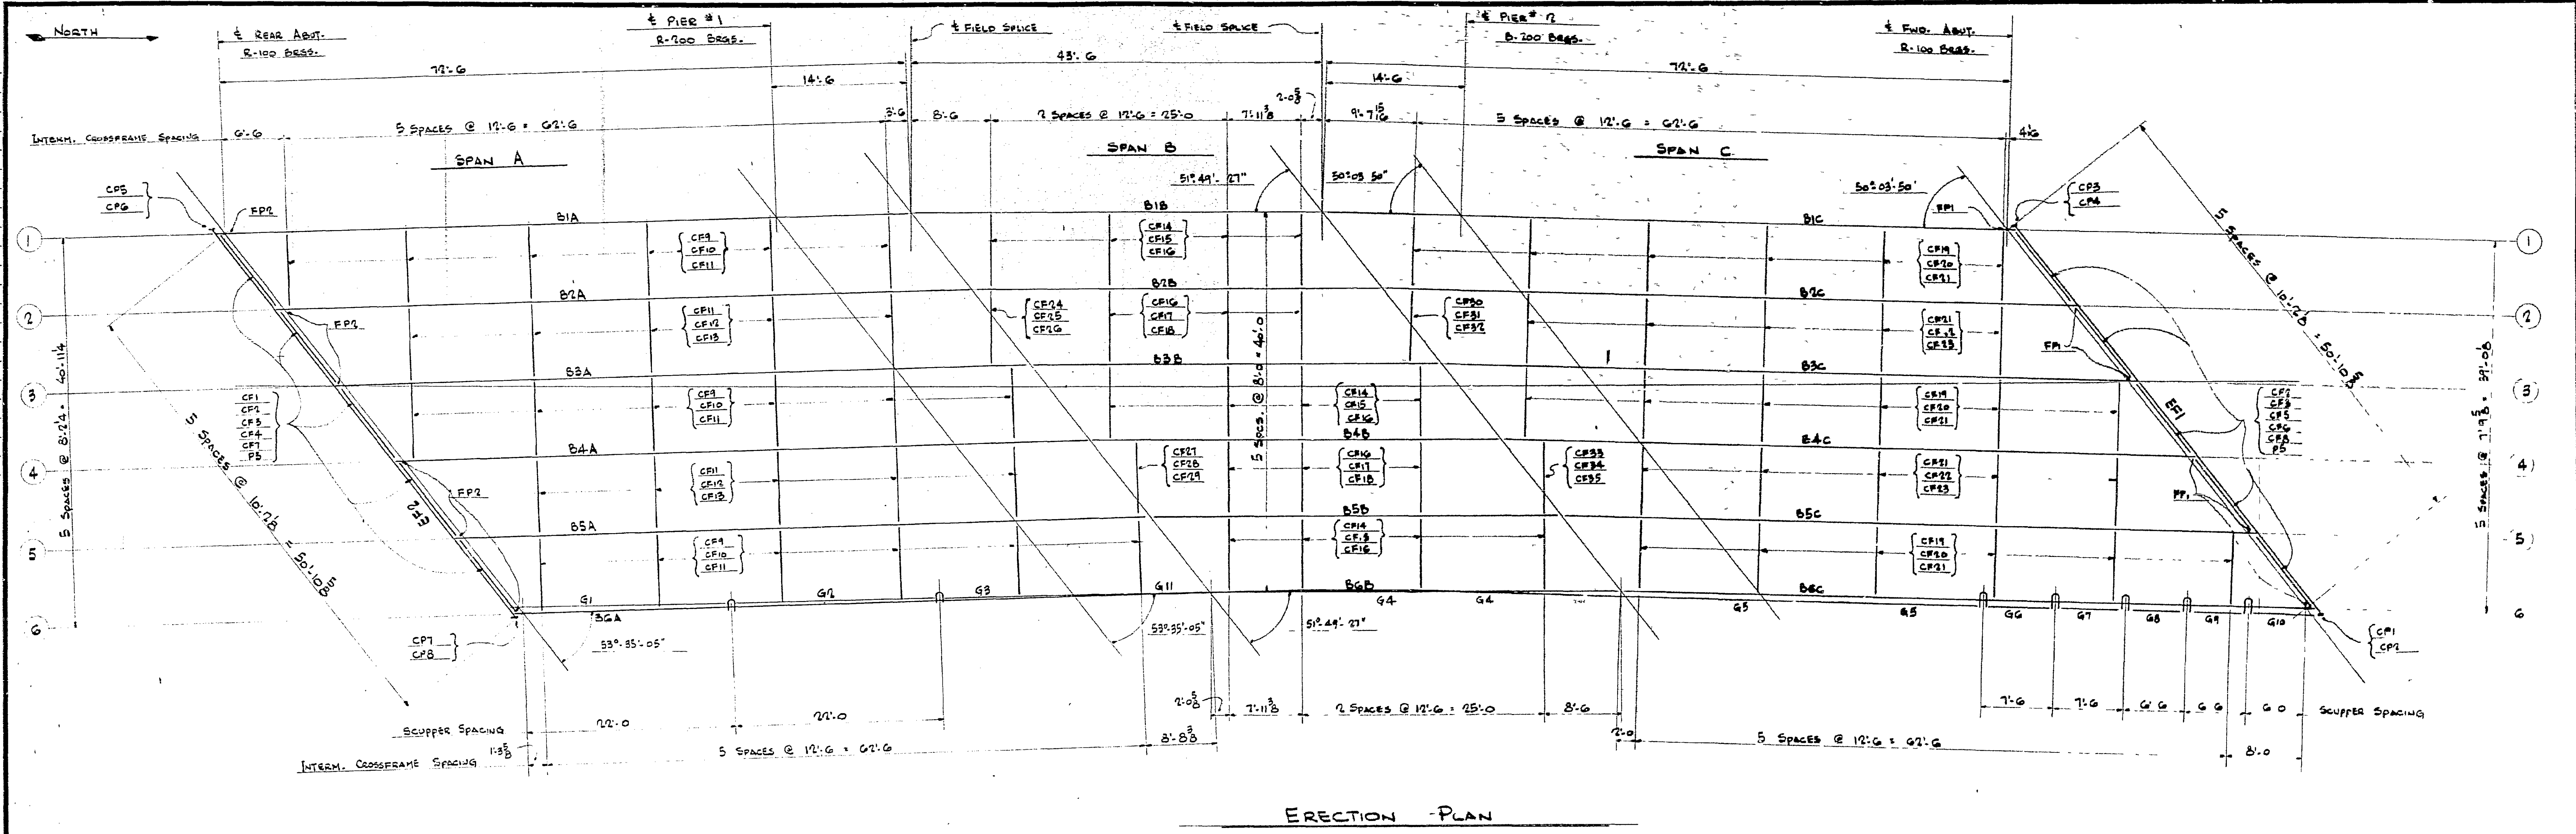

ERECTION PLAN

SUBSTANDARD DRAWING
This drawing does not meet minimum filing standards: MICRO-DATA does not accept responsibility for the inferior results due to the condition of this drawing.

NOTE:
FOR ERECTION DETAILS SEE J.T.E. Co. DWG E2
FOR SPACE PLATE LOCATION SEE J.T.E. Co. DWG A10

BUREAU OF BRIDGES
APPROVED: [Signature]
DATE: [Blank]
NO: [Blank]
REVISION: [Blank]
BY: [Blank]
CH: [Blank]

FOR REFERENCE


DATE	NO	REVISION	BY	CH	BY
HOLES UNLESS NOTED			FINISH UNLESS NOTED		
SHOP CONNECTIONS WELDED					
FIELD CONNECTIONS WELDED & BOLTED					
ERECTION BY OTHERS					
ISSUE FOR NO DATE 11/16 3 8-2 5/4/68 1 2-11-68 05/10/68 2 1-11-68 05/10/68 3 3-23					
The J.T.E. EDWARDS COMPANY 1241 MCKINLEY AVENUE COLUMBUS OHIO 43222					
BRIDGE # 171 - CR - 75 WILSON RD. OVER N.Y.C. RR. FRANKLIN COUNTY					
WHITAKER MERRELL Co. CONTRACTOR					
O.S.H.D. (BARRETT ASSOCIATED ENG.) ARCHITECT-ENGINEER					
CONTRACT NO	DRAWN	CHECKED	APPROVED	ASE	
20852	JB	LC	ASHD	OF	
	JULY-66		8-20-66		

5080 0110 SHOP DWG STR STEEL 0043 11968 01180 060

12 14 16 18 20 22 24 26 28 30 32 34 36 38 40 42 44 46 48 50 52 54 56 58 60 62 64 66 68 70 72 74 76 78 80 82 84 86 88 90 92 94 96 98 100

SUBSTANDARD DRAWING


This drawing does not meet minimum filing standards. MICRO-DATA does not accept responsibility for the inferior results due to the condition of this drawing.

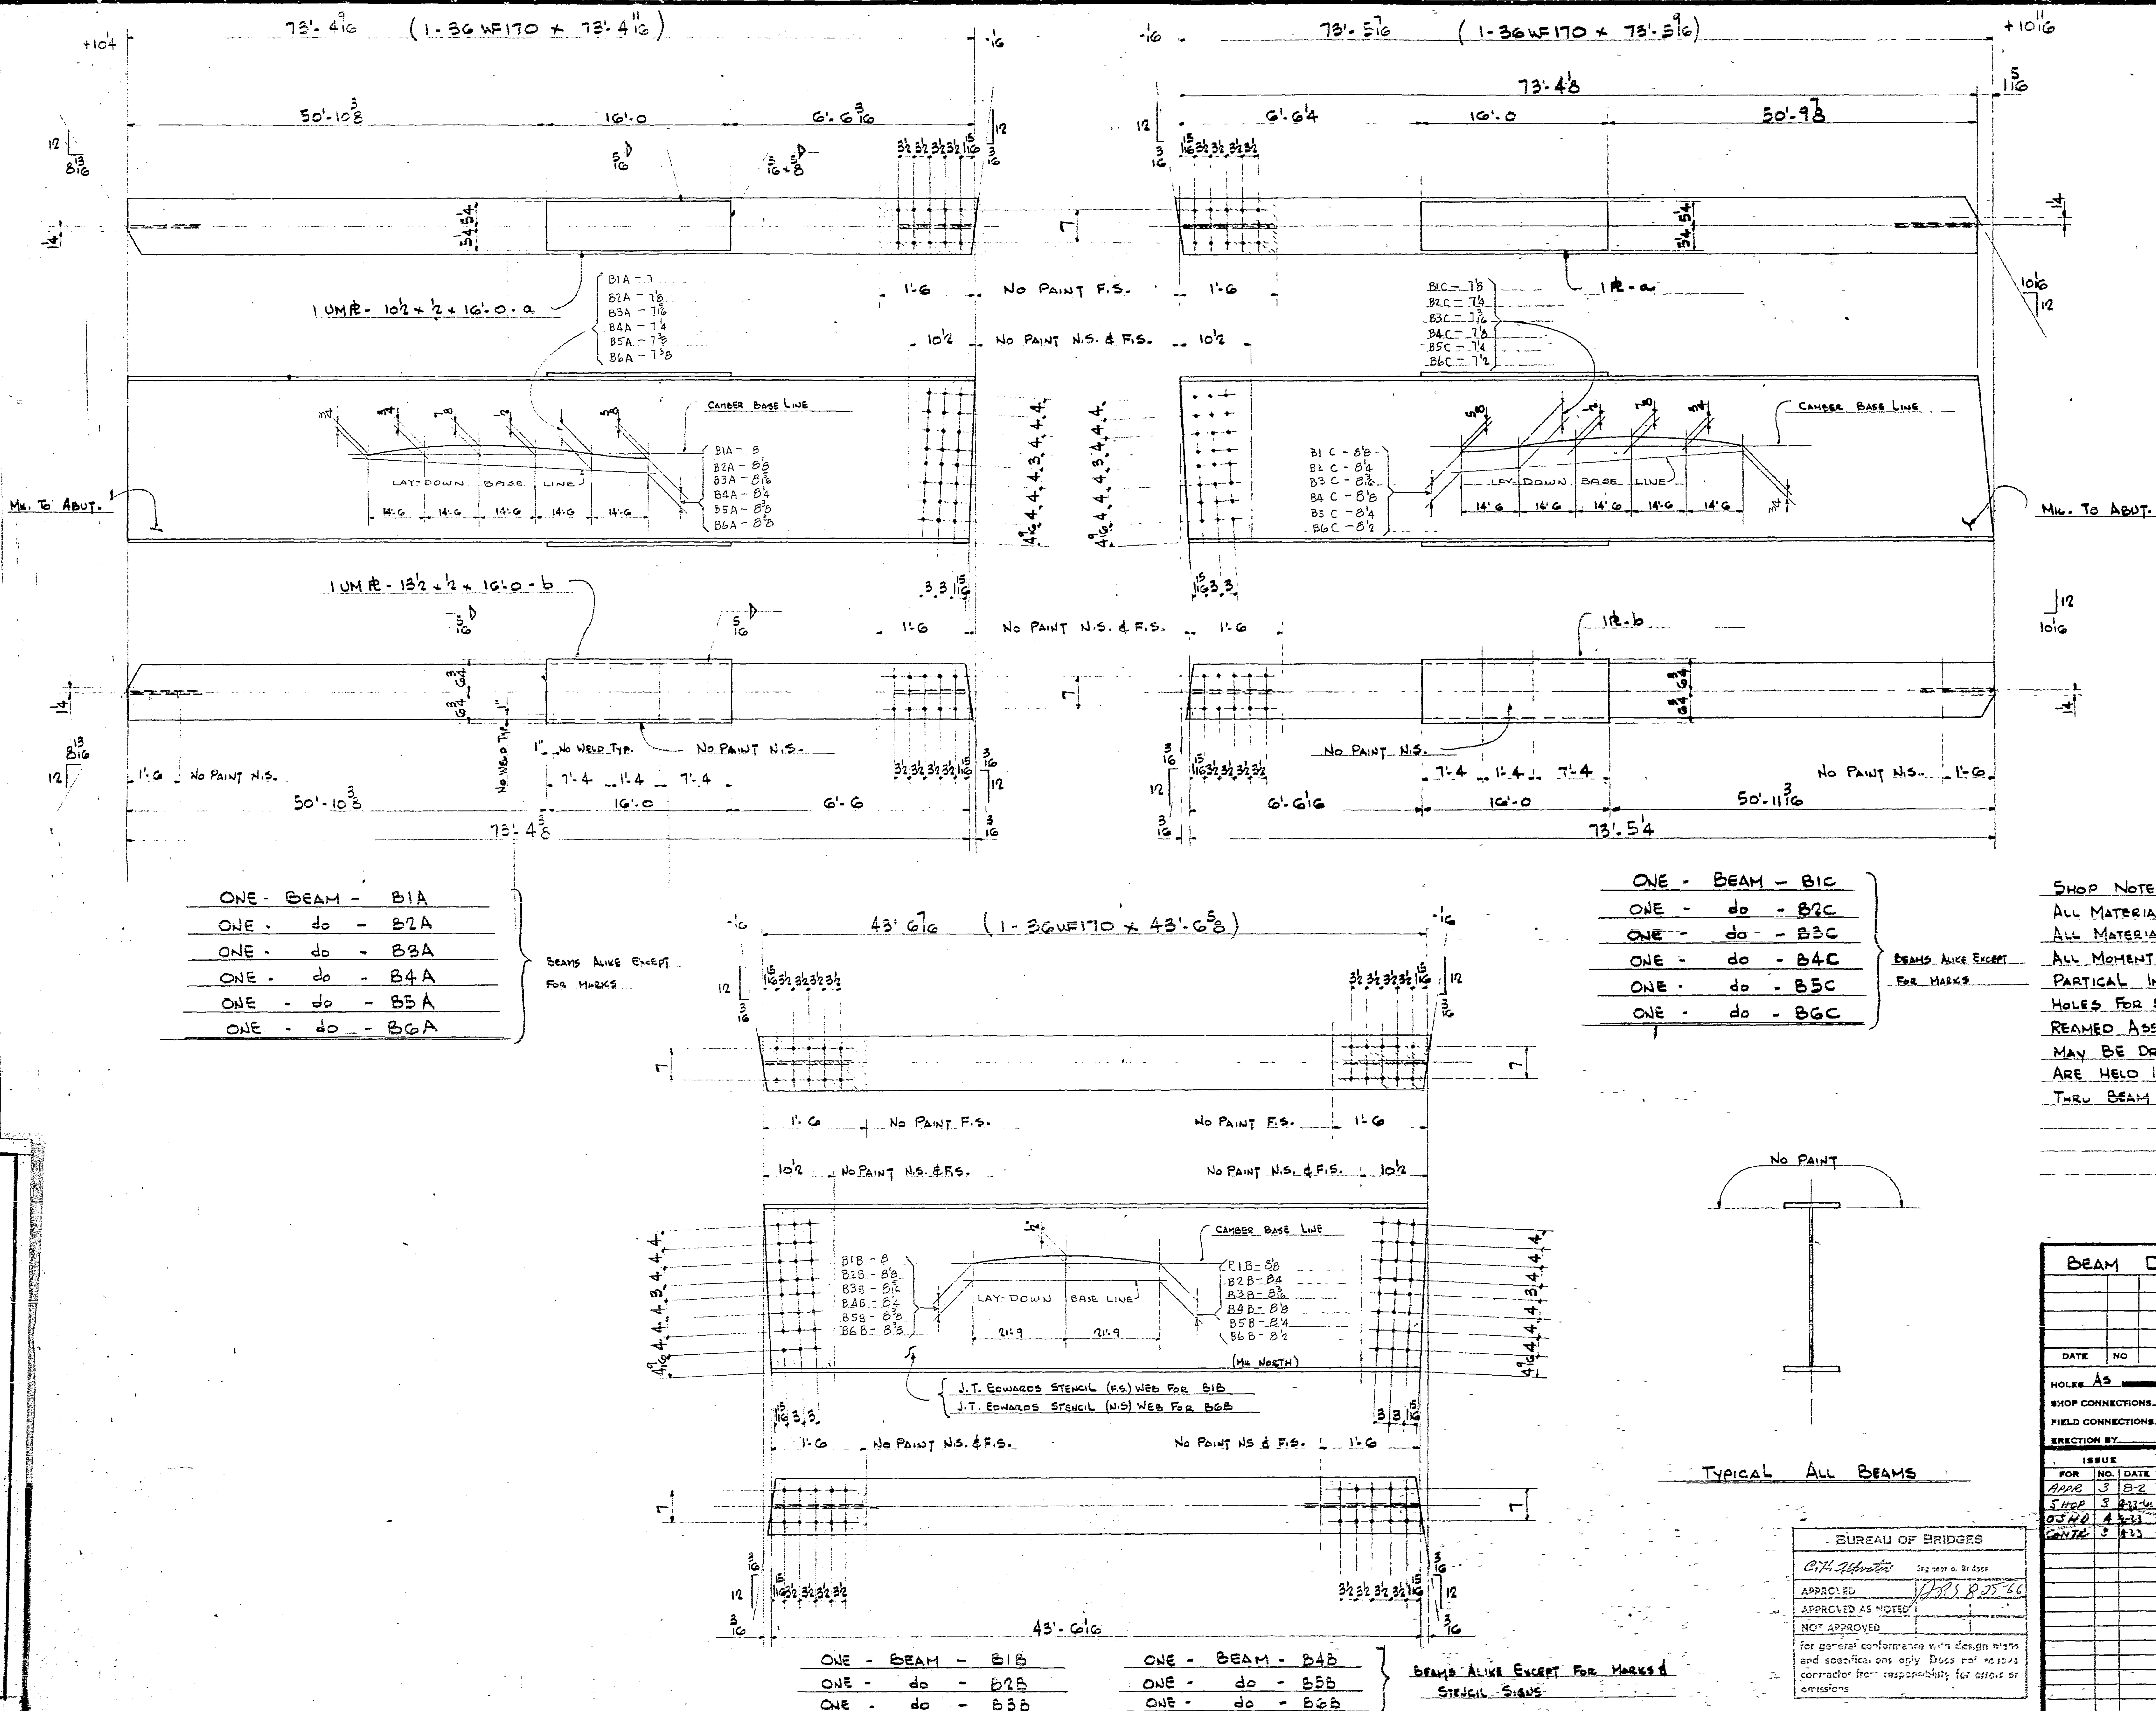

SHOP NOTES!

ALL MATERIAL A-36 STEEL
ALL MATERIAL ORDERED EXCEPT MOMENT PLATES
ALL MOMENT PLATE WELDS TO BE MAGNETIC
PARTIAL INSPECTED
HOLES FOR SPLICES TO BE SUBPUNCHED $\frac{1}{16}$ " AND
REAMED ASSEMBLED TO $\frac{1}{16}$ " ϕ IN SHOP. HOLES
MAY BE DRILLED FULL SIZE IF ALL SPLICE PLATES
ARE HELD IN PLACE DURING DRILLING. (DRILL
THRU BEAM & PLATES TOGETHER) REMOVE ALL BURRS


FOR REFERENCE

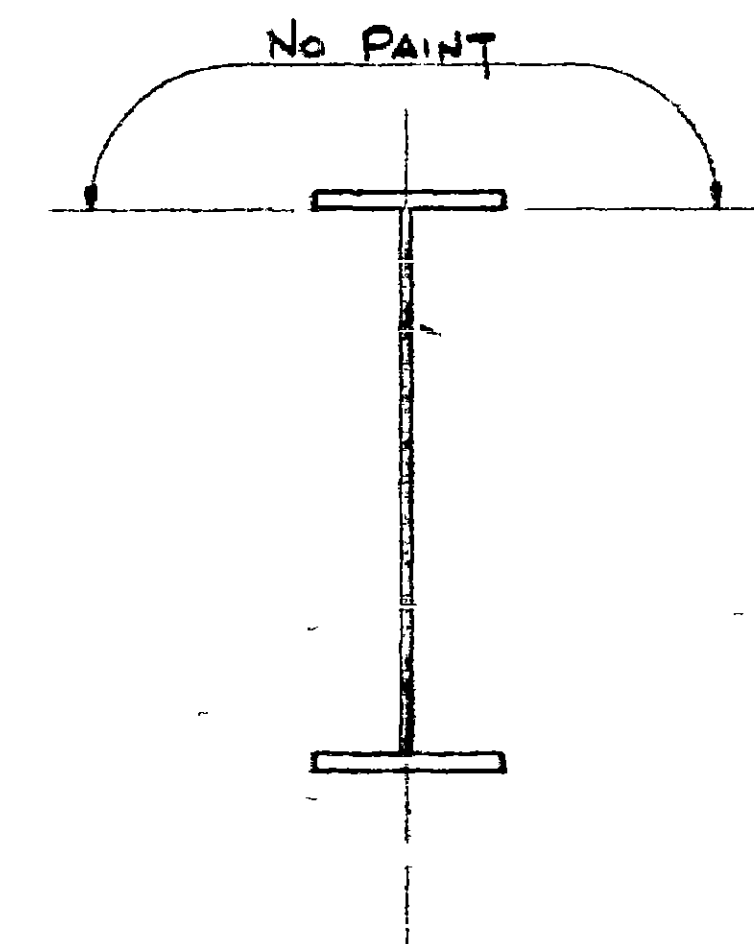

TYPICAL ALL BEAMS

0080 010 SHOP DWG STR. STEEL 0063 1168 0190 060

This drawing does not meet minimum filming standards: **MICRO-DATA** does not accept responsibility for the inferior results due to the condition of this drawing.

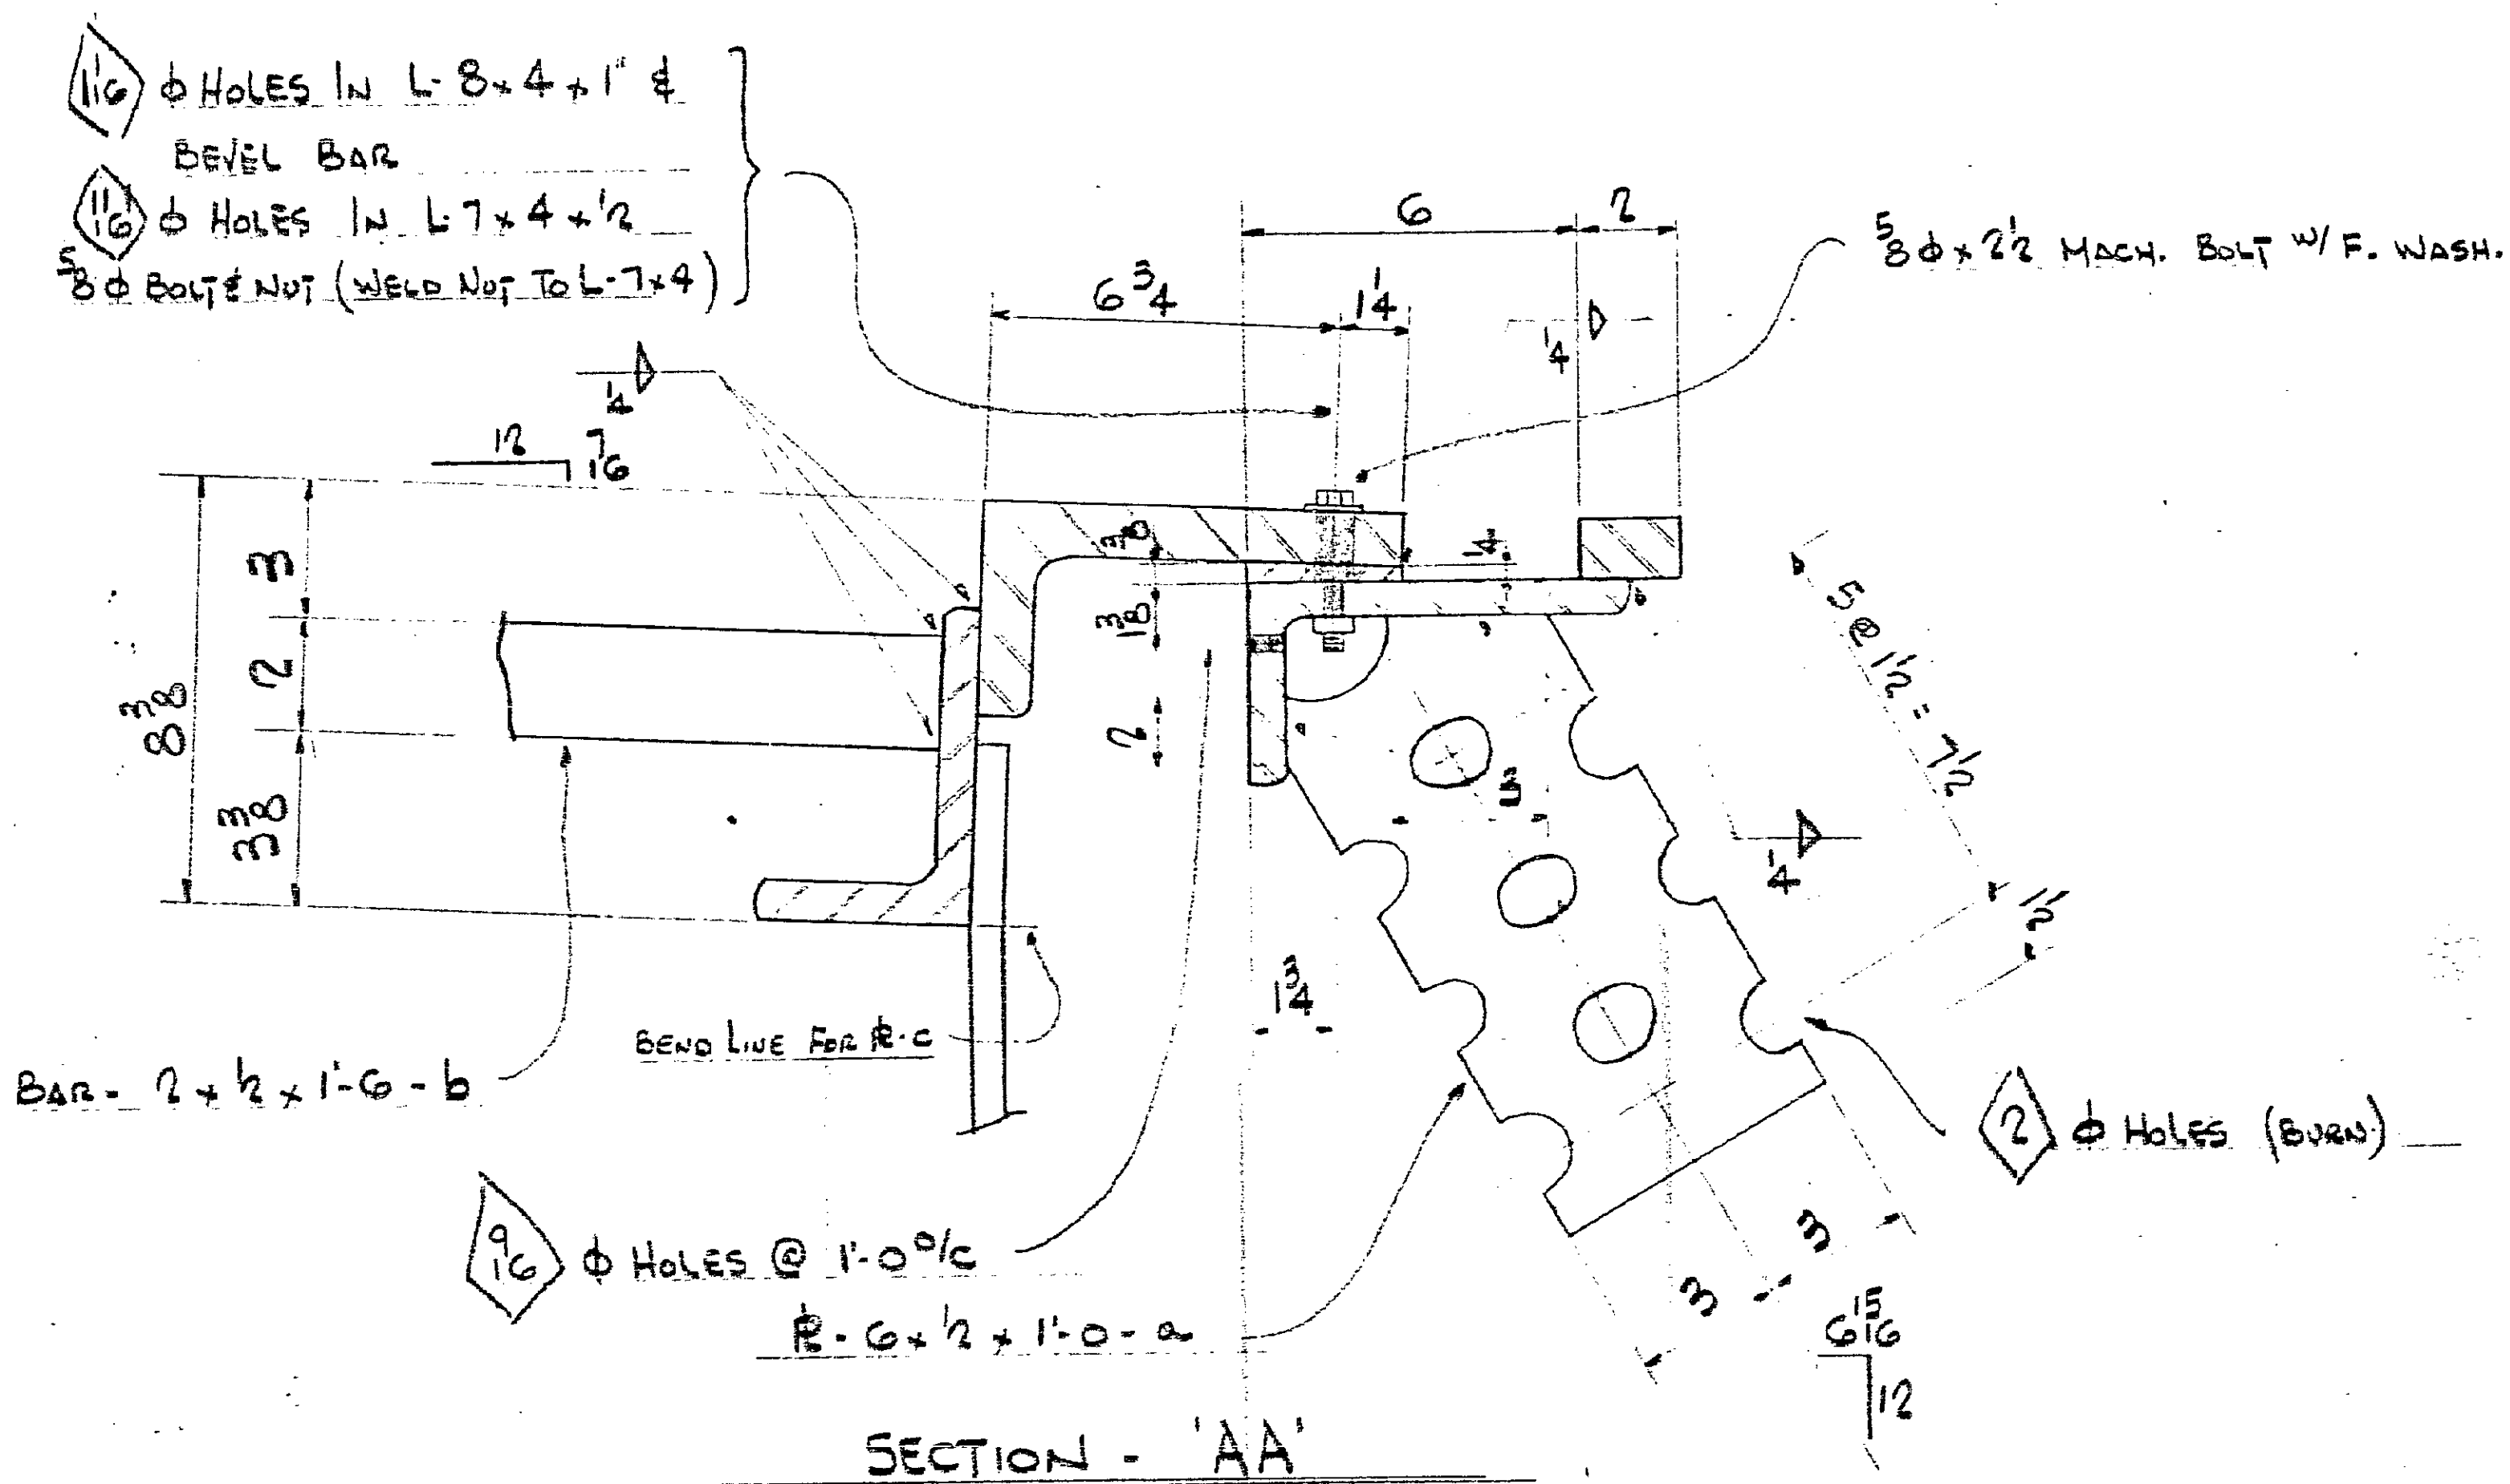

SHOP NOTE!

ALL MATERIAL A36. G2T STEEL

BUREAU OF

Engineer of Exports

APPROVED

APPROVED AS NOTED

NOT APPROVED

for general conformity with design plans
and specifications. Does not release
contractor from responsibility for errors or
omissions.

ENDS ON FINISH

FOR REFERENCE

DATE

NO.

REVISION

BY

CH. BY

HOLES AS NOTED

FINISH UNLESS NOTED

SHOP CONNECTIONS

WELDED & BOLTED

No PAINT

FIELD CONNECTIONS

WELDED

ERECTION BY

OTHERS

ISSUE

FOR NO. DATE

APR 3 1962

SHED 3 1964

OSHD 4 1964

CHUTE 5 1964

The J. T. EDWARDS COMPANY

1241 MCKINLEY AVENUE
COLUMBUS, OHIO 43222

BRIDGE # 171-CR-75

WILSON RD. OVER N.Y.C. R.R.

FRANKLIN COUNTY

WHITAKER MERRELL CO.
CONTRACTOR

O.S.H.D. (BARRETT ASSOCIATED ENG.)
ARCHITECT-ENGINEER

CONTRACT NO.

DRAWN

CHECKED

APPROVED

AS OF

JB

LC

O.S.H.D.

8-20-66



10852

JULY-66

a	aa	ba
b	ab	bb
c		
d		
e		
f		
g		
h		
i		
j		
k		
l		
m		
n		
o		
p		
q		
r		
s		
t		
u		
v		
w		
x		
y		
z		

SUBSTANDARD DRAWING

This drawing does not meet minimum filing standards: **MICRO-DATA** does not meet minimum filing standards. **MICRO-DATA** does not meet minimum filing standards. **MICRO-DATA** does not meet minimum filing standards.

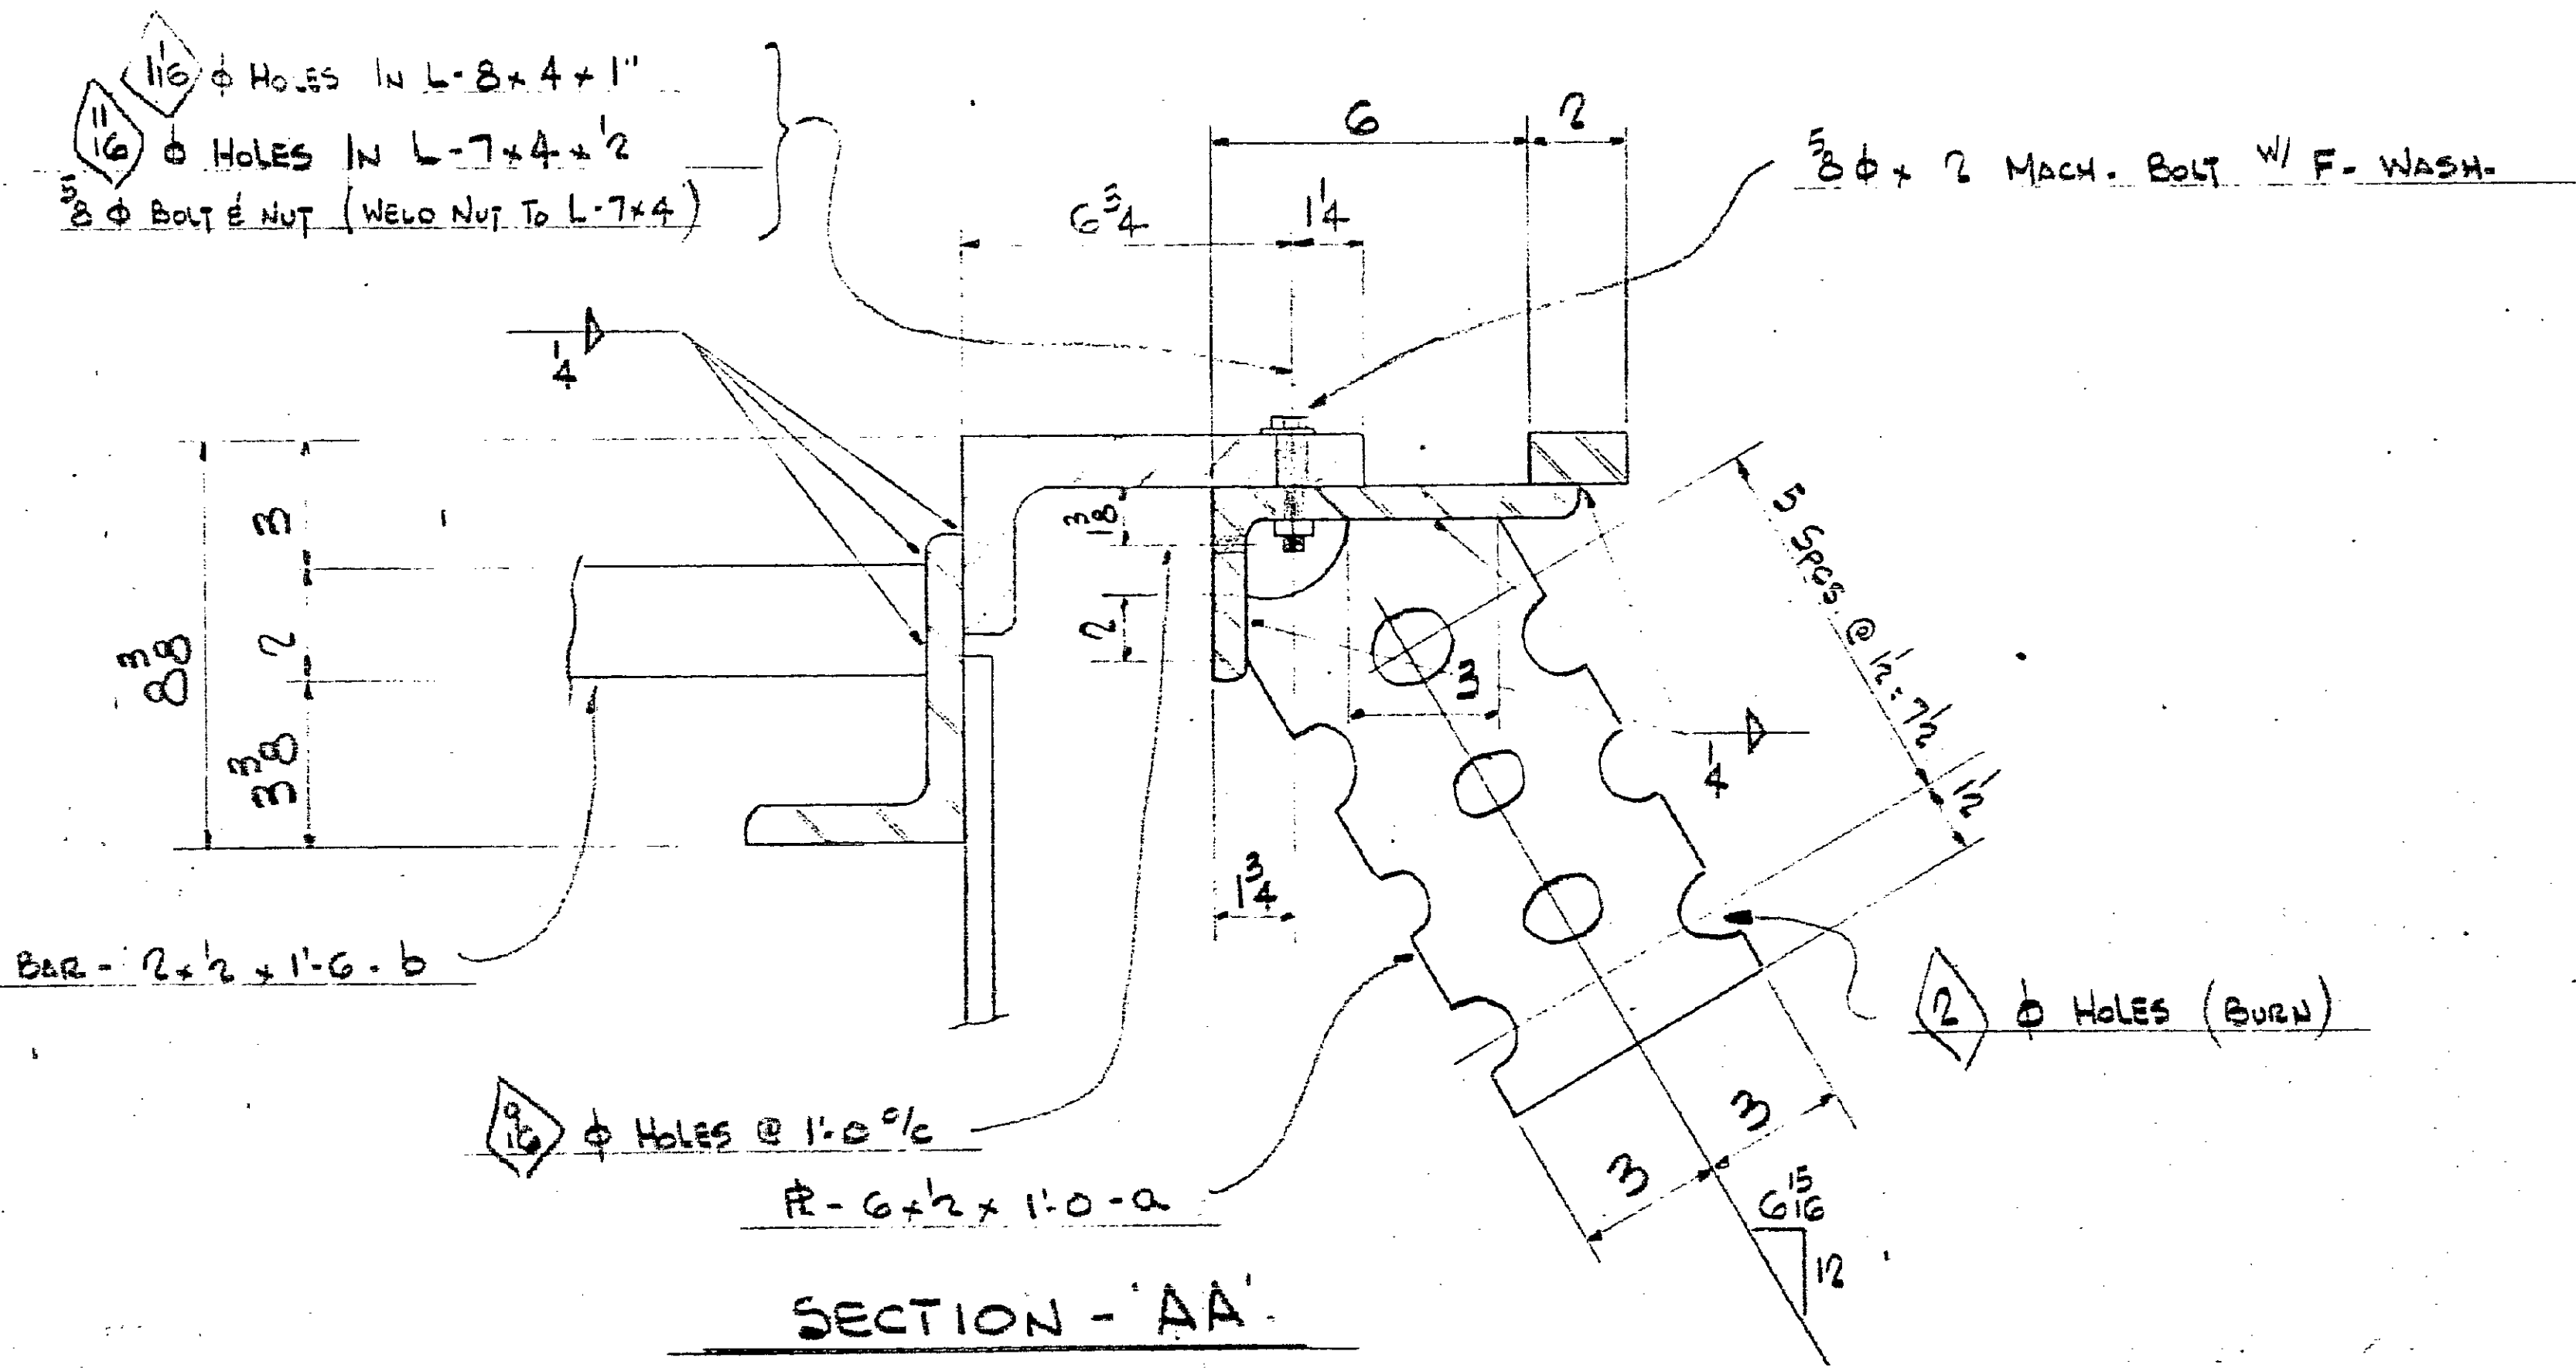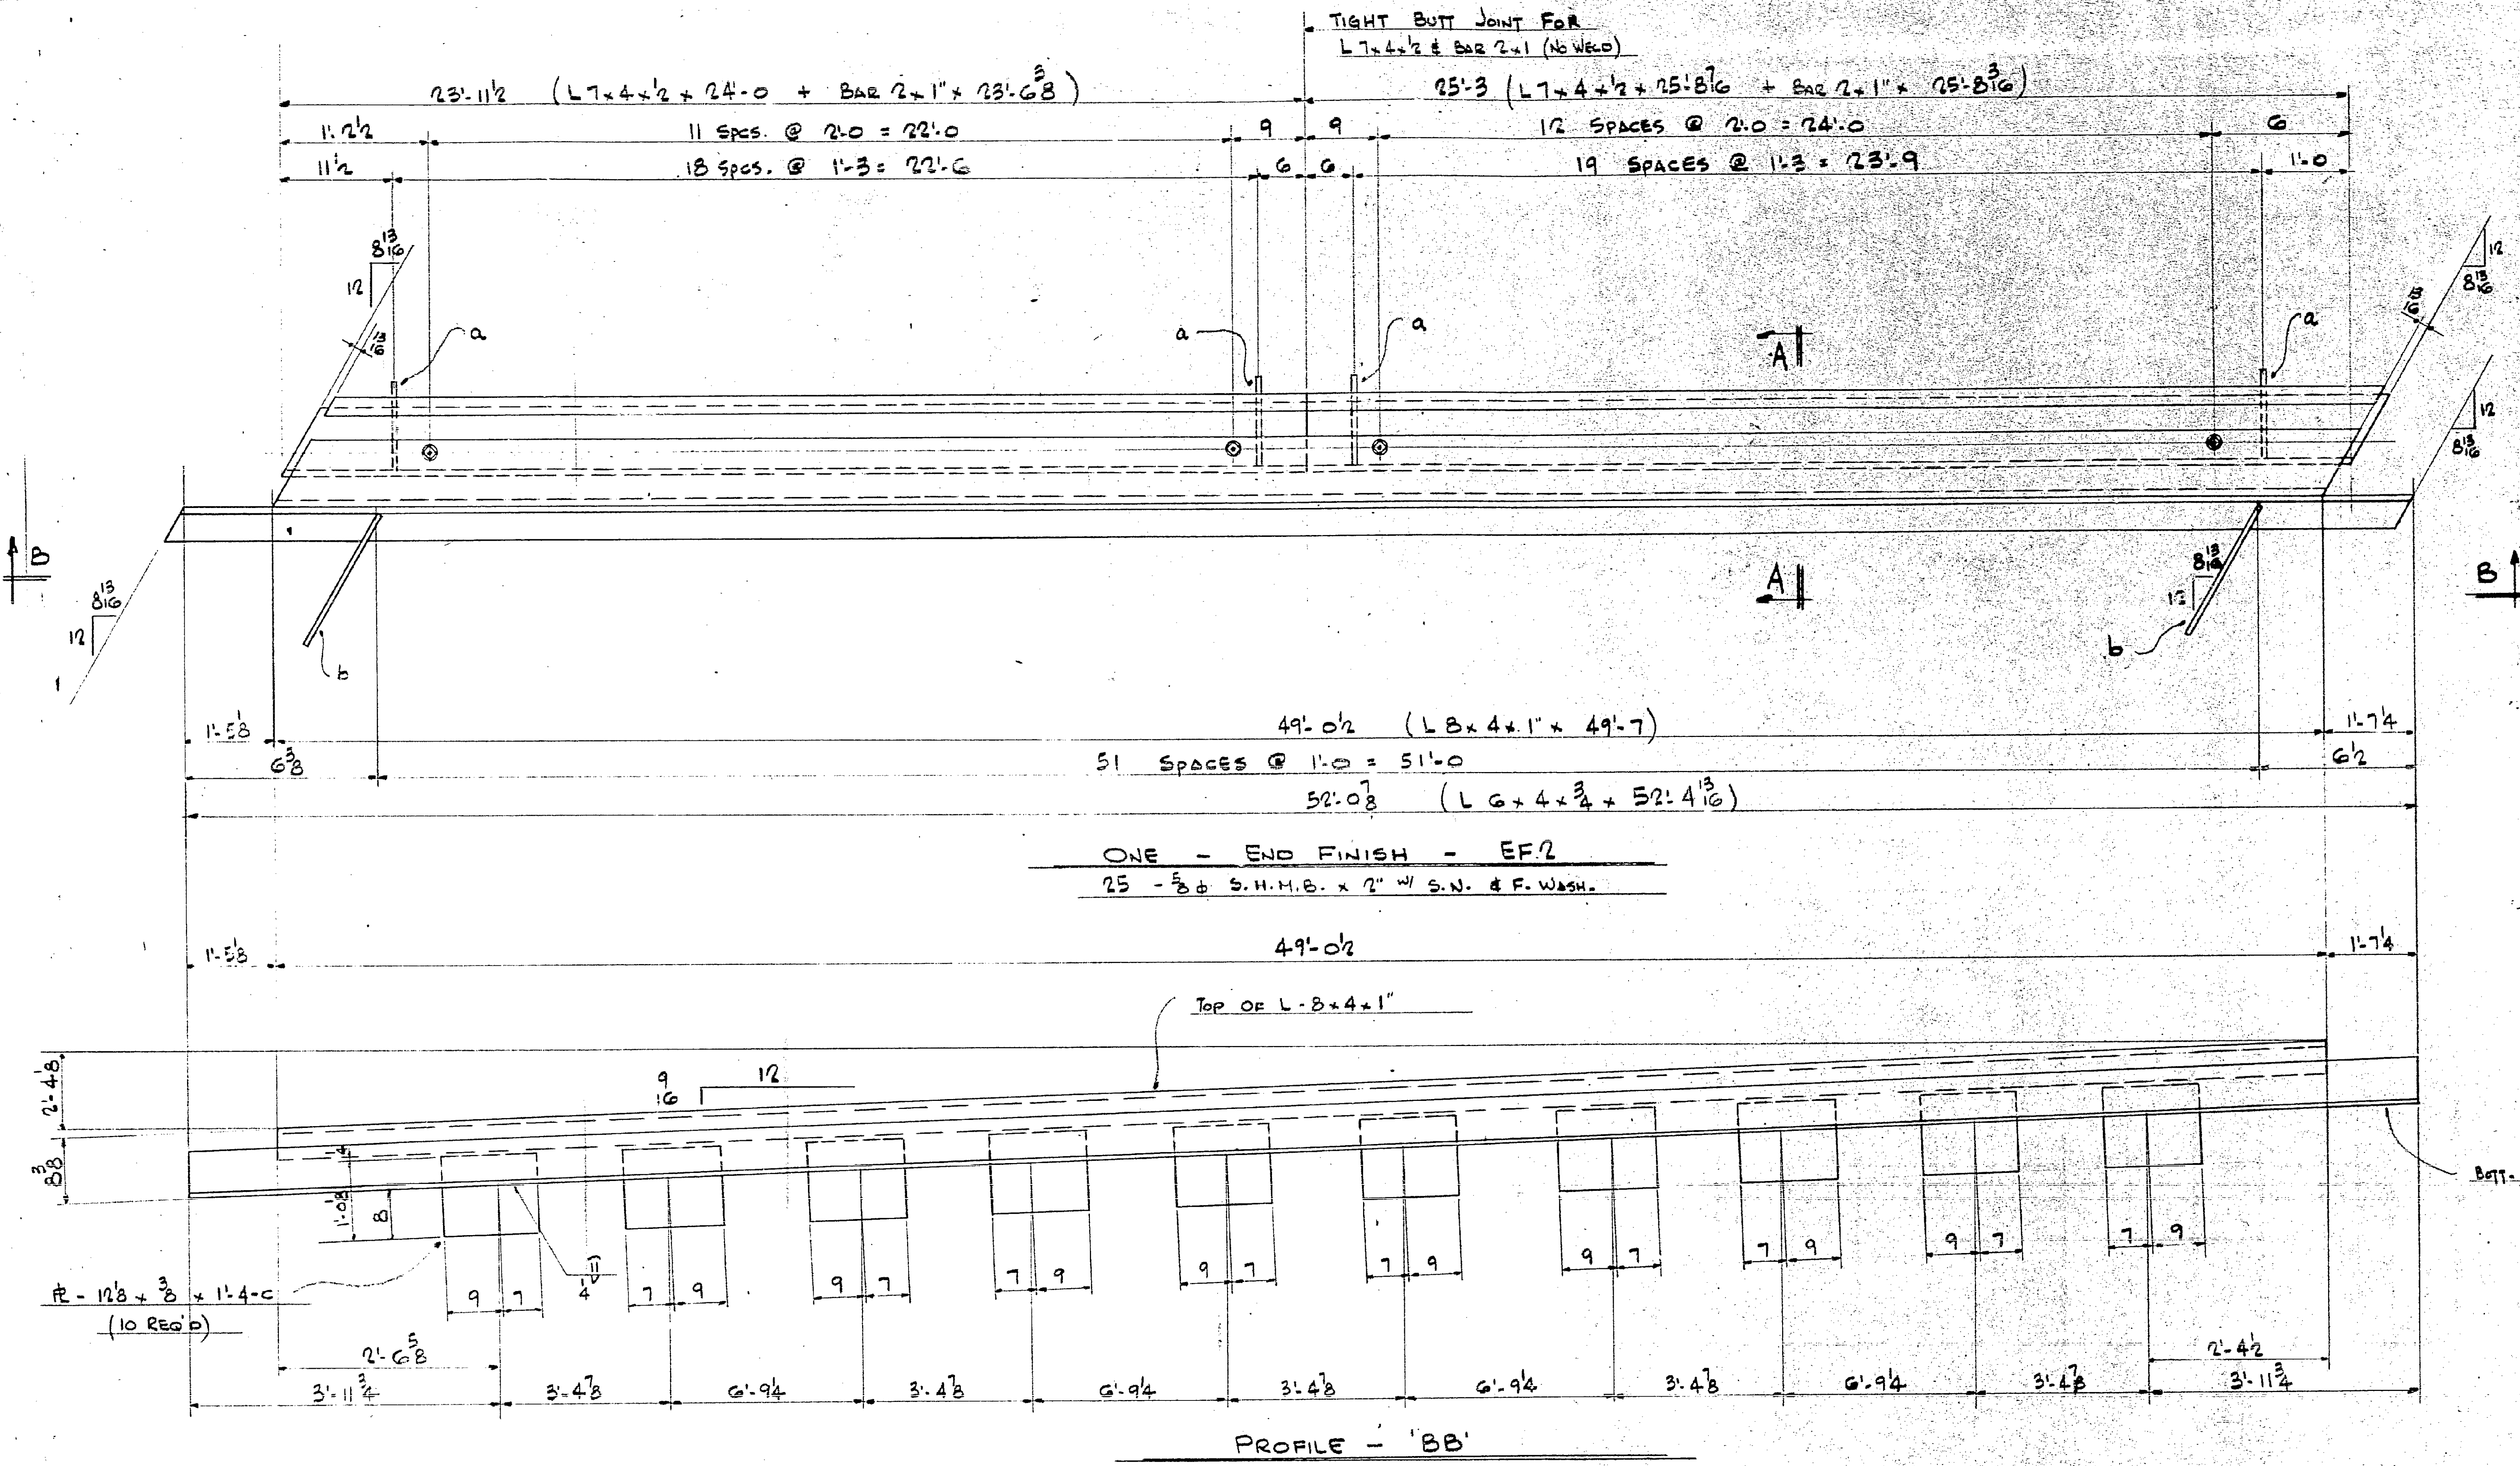

BUREAU OF BRIDGES	
Engineer of Bridges	
APPROVED	APPROVED AS NOTED
NOT APPROVED	
for general conformance with design plans and specifications only. Does not relieve contractor from responsibility for errors or omissions.	





SHOP NOTES!
ALL MATERIAL A36-G2T STEEL.

FOR REFERENCE

END FINISH																							
DATE	NO.	REVISION	BY																				
Holes As Noted																							
SHOP CONNECTIONS		WELDED & BOLTED	FINISH UNLESS NOTED																				
FIELD CONNECTIONS		WELDED	NO PAINT																				
ERECTION BY		OTHERS																					
<table border="1"> <tr><th>ISSUE</th><th>FOR</th><th>NO.</th><th>DATE</th></tr> <tr><td>APPROVED</td><td>3</td><td>B-2</td><td></td></tr> <tr><td>SHOP</td><td>5</td><td>1-1-66</td><td></td></tr> <tr><td>DESIGN</td><td>4</td><td>1-1-66</td><td></td></tr> <tr><td>CONTRACT</td><td>3</td><td>1-1-66</td><td></td></tr> </table>				ISSUE	FOR	NO.	DATE	APPROVED	3	B-2		SHOP	5	1-1-66		DESIGN	4	1-1-66		CONTRACT	3	1-1-66	
ISSUE	FOR	NO.	DATE																				
APPROVED	3	B-2																					
SHOP	5	1-1-66																					
DESIGN	4	1-1-66																					
CONTRACT	3	1-1-66																					
The J.T. Edwards Company 1241 McKinley Avenue COLUMBUS, OHIO 43222																							
BRIDGE #171 - CR-25 WILSON Rd. OVER N.Y.C. R.R. FRANKLIN COUNTY																							
WHITAKER MERRELL Co. CONTRACTOR																							
O.S.H.D. (CORRETT ASSOCIATED ENGR.) ARCHITECT-ENGINEER																							
<table border="1"> <tr><th>CONTRACT NO.</th><th>DRAWN</th><th>CHECKED</th><th>APPROVED</th><th>A G OF</th></tr> <tr><td>20852</td><td>JB</td><td>LC</td><td>O.S.H.D.</td><td></td></tr> <tr><td></td><td></td><td></td><td>8-20-66</td><td></td></tr> </table>				CONTRACT NO.	DRAWN	CHECKED	APPROVED	A G OF	20852	JB	LC	O.S.H.D.					8-20-66						
CONTRACT NO.	DRAWN	CHECKED	APPROVED	A G OF																			
20852	JB	LC	O.S.H.D.																				
			8-20-66																				

50810 0110 SHOP DWG. STR. STEEL 0063 11968 0210 060

a	aa	ba
b	ab	bb
c		
d		
e		
f		
g		
h		
i		
j		
k		
m		
n		
o		
p		
q		
r		
s		
t		
u		
v		
w		
x		
y		
z		

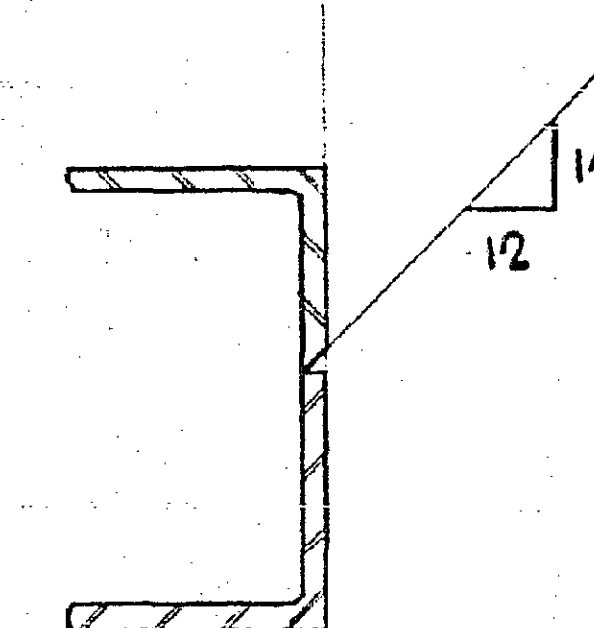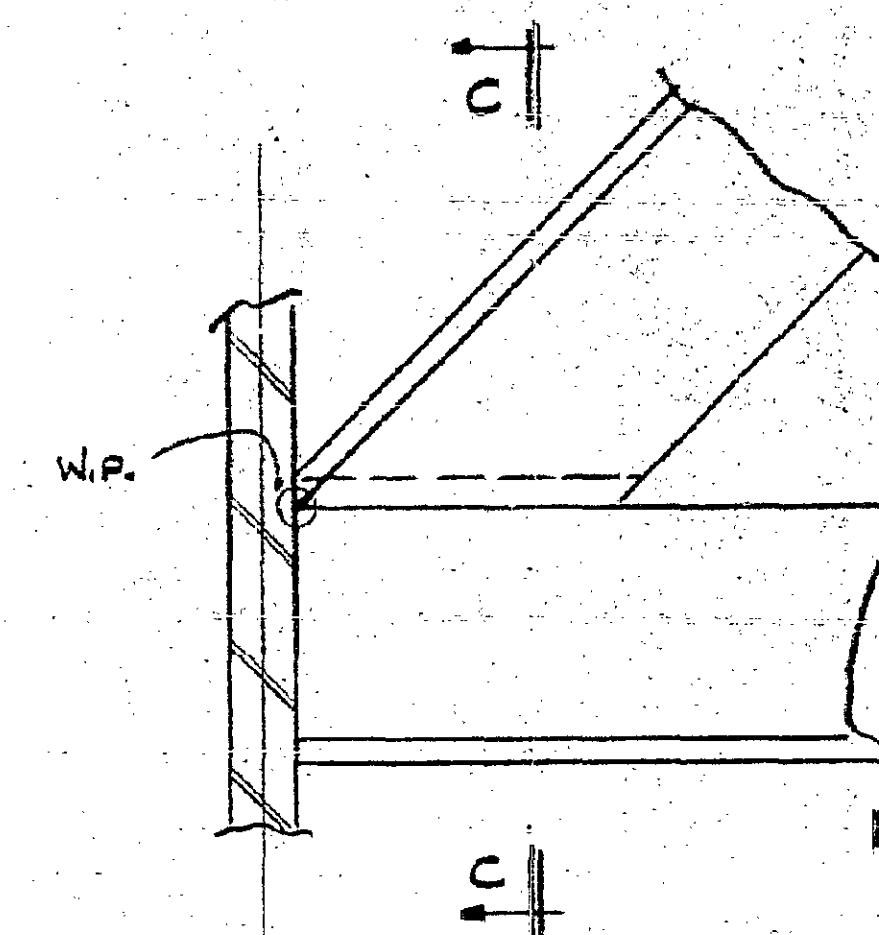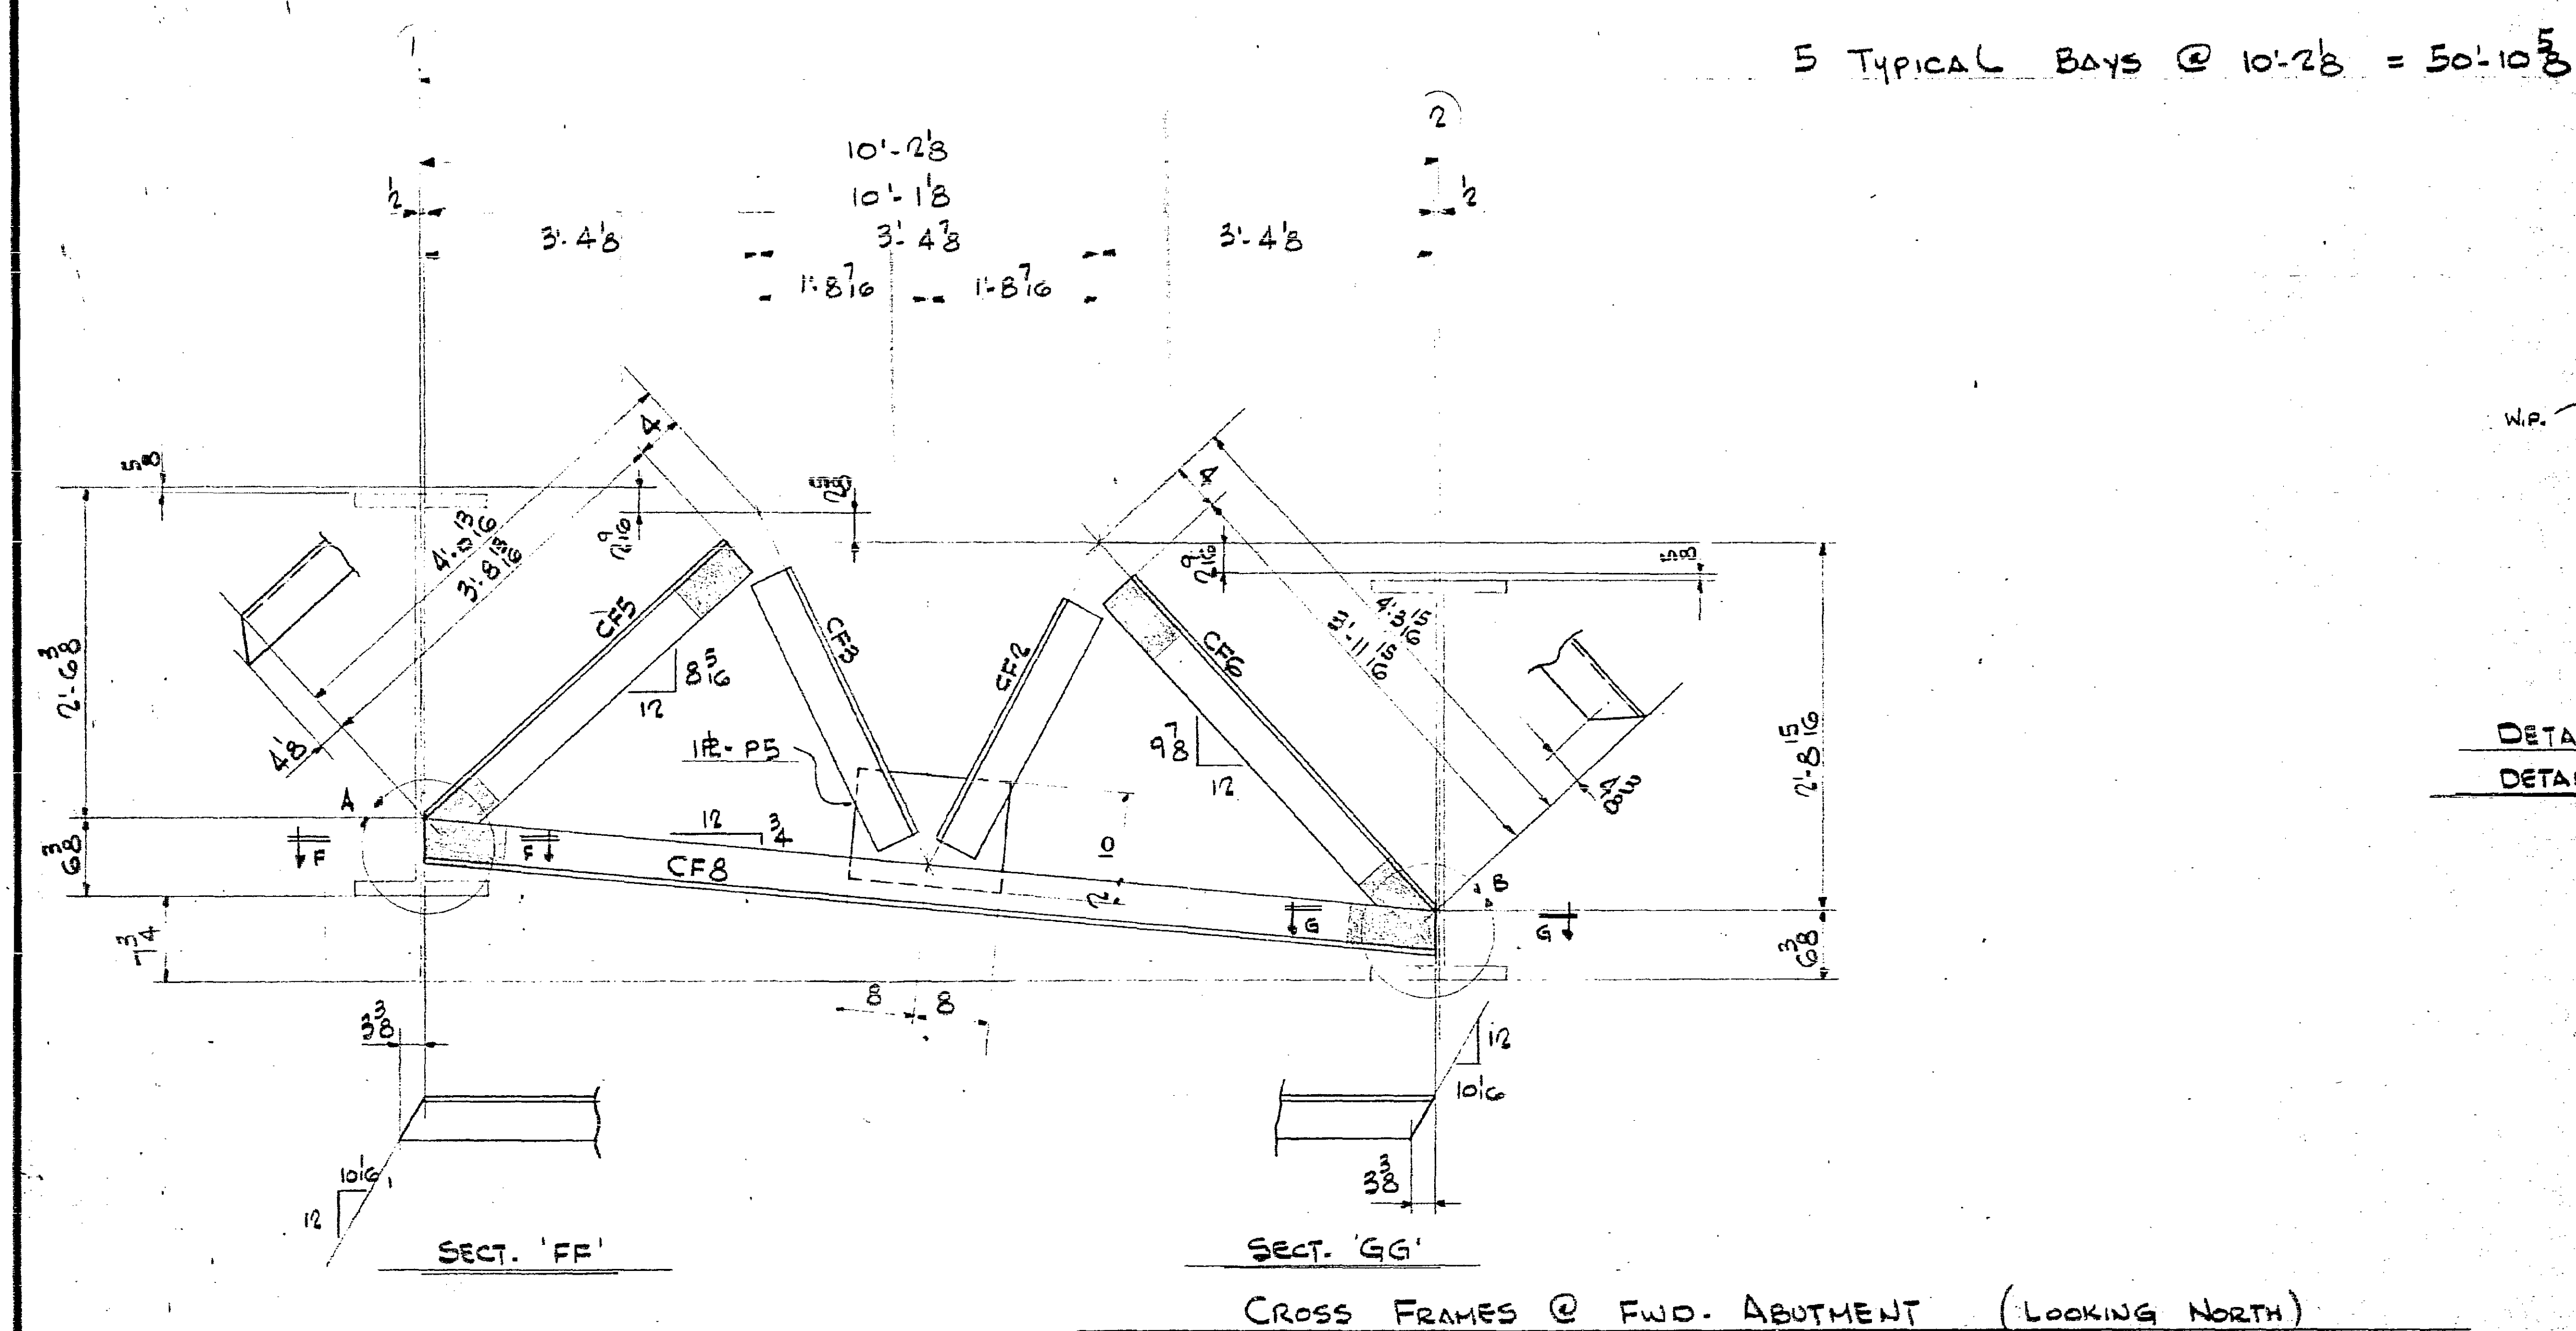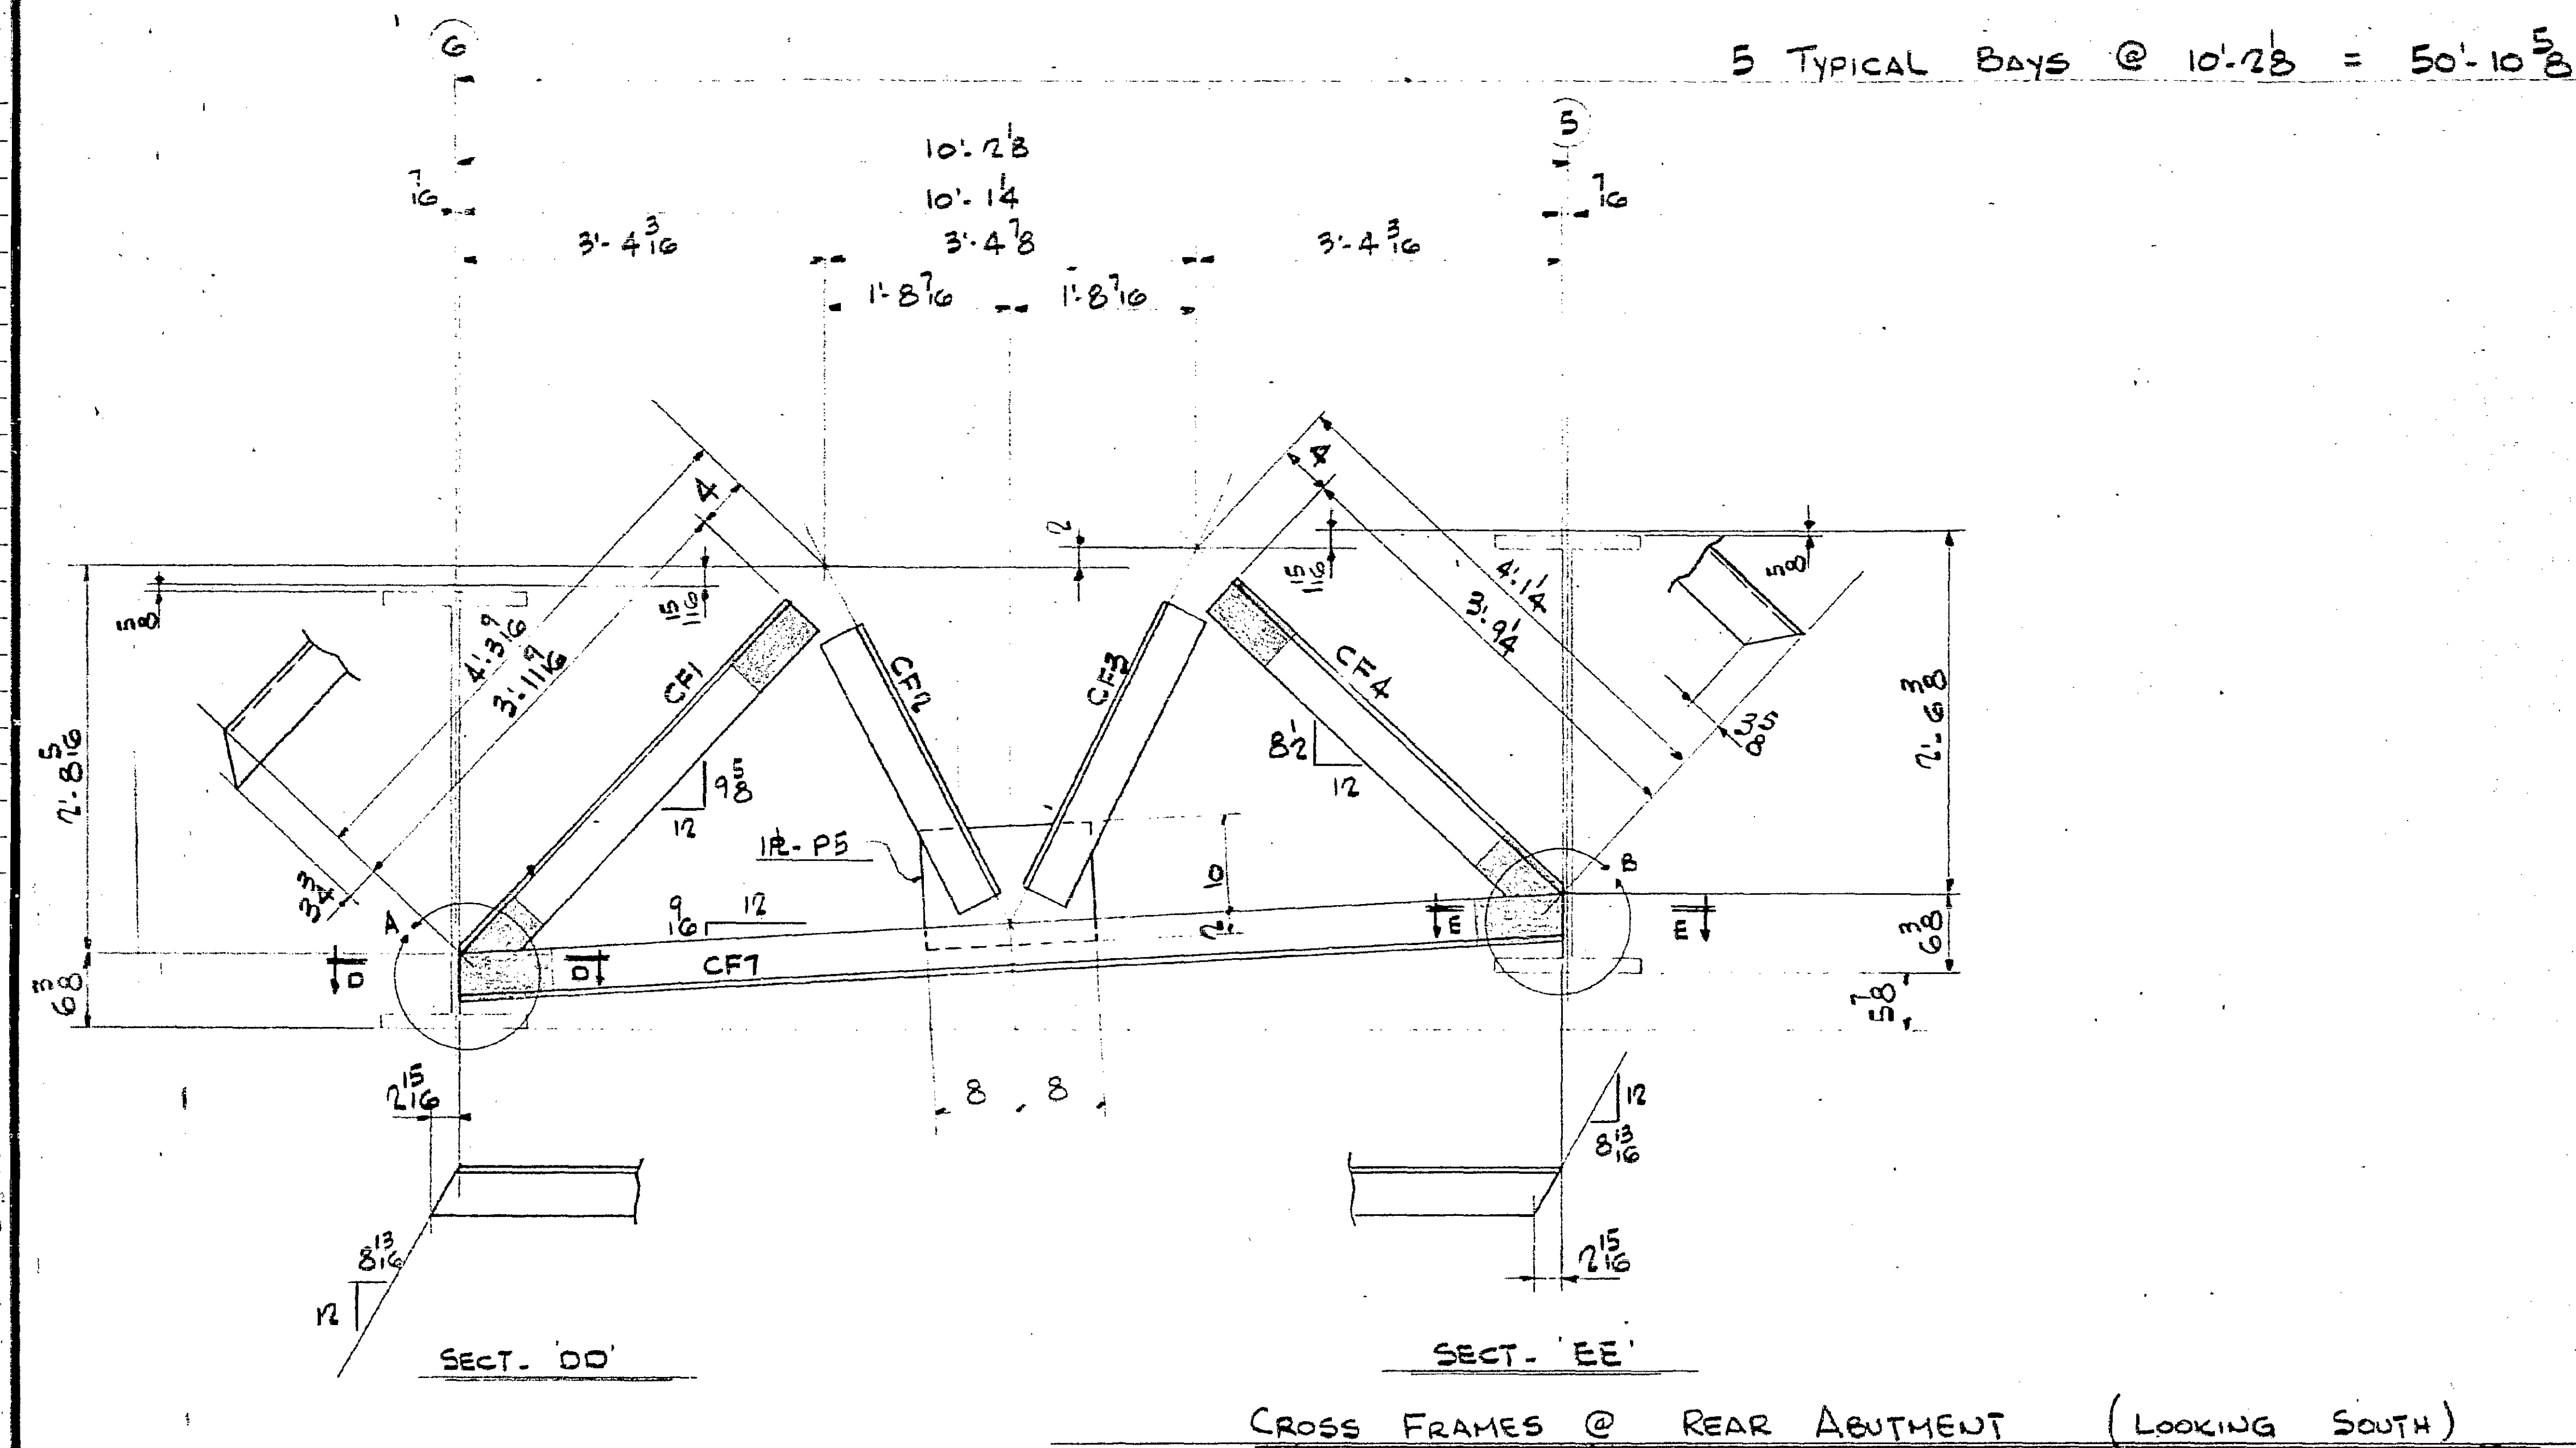

SCHEDULE OF CROSS FRAMES				
NO.	MATERIAL	LENGTH		MARK
REQD		FT.	IN.	
5	L-4 x 4 x $\frac{5}{16}$ * 10	4	3 10	CF1
10	do	2	6 2	CF2
10	do	2	8	CF3
5	do	3	9 4	CF4
5	do	4	0 10	CF5
5	do	3	11 5	CF6
5	do	10	4 2	CF7
5	L-4 x 4 x $\frac{5}{16}$ * 10	10	4 2	CF8

CROSS FRAMES			
DATE	NO.	REVISION	BY CH. B.
HOLE <u>—</u> UNLESS NOTED		FINISH UNLESS NOTED	
SHOP CONNECTIONS <u>CH</u>		ONE SHOP COAT 708.07	
FIELD CONNECTIONS <u>WELDED</u>			
ERECTION BY <u>OTHERS</u>		BRUSHED ON	

ISSUE	
FOR	NO. DATE
APPR	3 8-2
SHOP	3 9-23-41
COND	4 9-23
CONTR	3 9-23



The J. T. EDWARDS COMPANY

1241 MCKINLEY AVENUE
COLUMBUS, OHIO 43222



BRIDGE # 171 - CR - 25
 WILSON RD OVER N.Y.C. R.R.
 FRANKLIN COUNTY
 WHITAKER MERRELL CO.
 CONTRACTOR

O.S.H.D. (BARRETT ASSOCIATED ENG.)
 ARCHITECT-ENGINEER

CONTRACT NO.	DRAWN	CHECKED	APPROVED	A 7 OF
20852	JB	L. C.	O.S.H.D. 8-20-64	
	JULY - 66			

SUBSTANDARD DRAWING

This drawing does not meet minimum filming standards! **MICRO-DATA** does not accept responsibility for the inferior results due to the condition of this drawing.

SHOP NOTE!
NO PAINT WITHIN 8' OF END OF
ANGLES (SHADED PART)
NO PAINT ON CF2-CF3 & R-P5


ALL MATERIAL A-36

10	$12 + \frac{3}{2} +$	1	4	P
----	----------------------	---	---	---

5080	010	SHOP DWG. STR. STEEL						0063	1968	0220	060
------	-----	----------------------	--	--	--	--	--	------	------	------	-----

Technical drawing of a roof truss structure, showing a series of interconnected triangles. The drawing includes dimensions and labels for various components:

- Horizontal Dimensions (Top):**
 - Span 1: 8'-2 1/4" (Total), 8'-1 1/2" (Left half)
 - Span 2: 8'-2 1/4" (Total), 8'-1 1/2" (Left half)
 - Span 3: 8'-2 1/4" (Total), 8'-1 1/2" (Left half)
 - Span 4: 8'-2 1/4" (Total), 8'-1 1/2" (Left half)
 - Span 5: 8'-2 1/4" (Total), 8'-1 1/2" (Left half)
- Vertical Dimensions (Left):**
 - Overall height: 3'-0 1/2"
 - Height from base to first peak: 1'-11 3/4"
 - Height from base to second peak: 2'-9"
- Labels:**
 - CF9, CF10, CF11, CF777, CF77

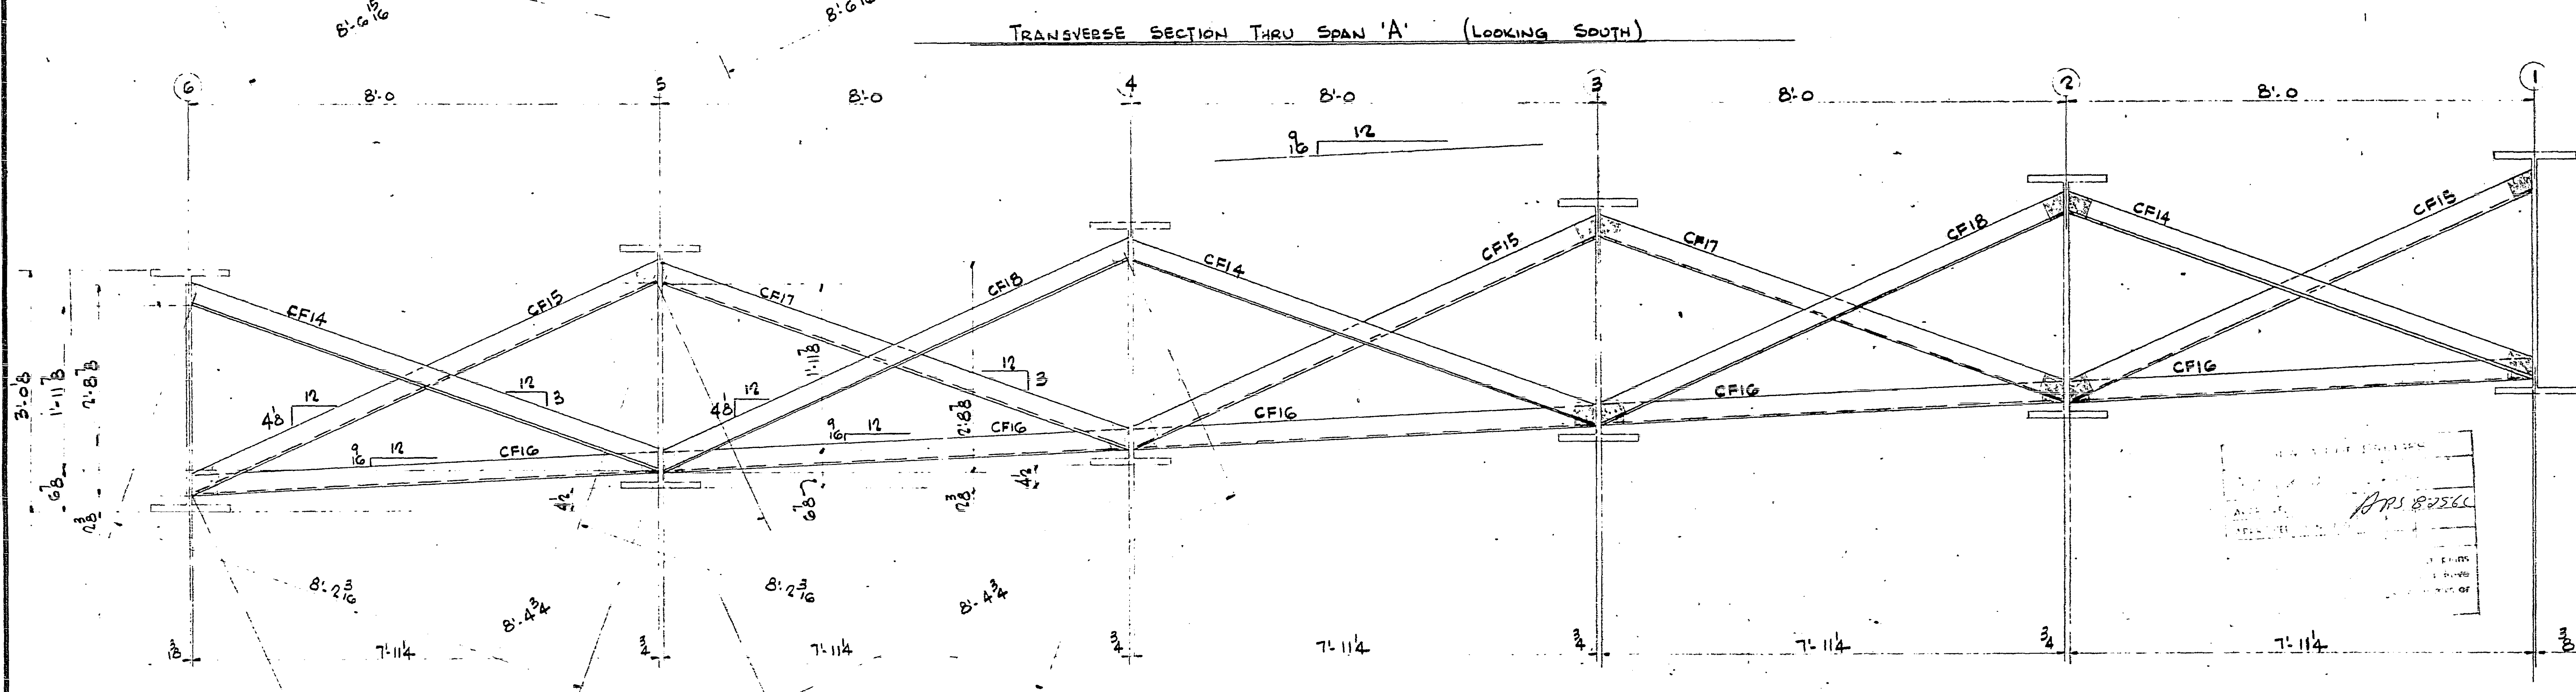

TRANSVERSE SECTION THRU SPAN 'B' (LOOKING SOUTH)

SCHEDULE OF CROSS FRAMES				
No.	DESCRIPTION	FT	IN	MARK
18	L 3 x 3 x 1/2 x	8	5 1/2	CF9
18	do	8	7 1/2	CF10
28	do	8	1 3/4	CF11
10	do	8	5 1/2	CF12
10	do	8	7 1/2	CF13
12	do	8	2 1/2	CF14
12	do	8	5 1/2	CF15
18	do	7	1 1/2	CF16
6	do	8	2 1/2	CF17

CROSS FRAMES		
DATE	NO.	REVISION
FOR REF.		

HOLE - UNLESS NOTED		FINISH
SHOP CONNECTIONS		ONE
FIELD CONNECTIONS		WELDED
ERECTION BY		OTHERS

ISSUE		
FOR	NO.	DATE
11/10/28	3	8-2
11/10/28	3	21-4
11/10/28	3	21-5
11/10/28	3	21-6

The J.T. EDWARDS
 1241 MCINLEY AVE.
 COLUMBUS, OHIO 4



BRIDGE # 171 - CR - 25
 WILSON Rd. N.Y.C. R.R.

CROSS FRAMES				FOR REFERENCE																					
DATE		NO.		REVISION		BY CH. SY																			
HOLES _____ UNLESS NOTED				FINISH UNLESS NOTED																					
SHOP CONNECTIONS <i>ch</i>				ONE SHOP COPY 108.07																					
FIELD CONNECTIONS <i>WELDED</i>																									
ERECTION BY _____ OTHERS _____				BRUSHED ON _____																					
<table><tr><th colspan="3">ISSUE</th></tr><tr><th>FOR</th><th>NO.</th><th>DATE</th></tr><tr><td><i>AWD</i></td><td><i>3</i></td><td><i>8-2</i></td></tr><tr><td><i>SHD</i></td><td><i>3</i></td><td><i>2-11-44</i></td></tr><tr><td><i>OSH</i></td><td><i>4</i></td><td><i>2-11-44</i></td></tr><tr><td><i>CONTR</i></td><td><i>3</i></td><td><i>6-15</i></td></tr></table>				ISSUE			FOR	NO.	DATE	<i>AWD</i>	<i>3</i>	<i>8-2</i>	<i>SHD</i>	<i>3</i>	<i>2-11-44</i>	<i>OSH</i>	<i>4</i>	<i>2-11-44</i>	<i>CONTR</i>	<i>3</i>	<i>6-15</i>	 <i>The J.T. EDWARDS COMPANY</i> 1241 MCKINLEY AVENUE COLUMBUS, OHIO 43222 			
ISSUE																									
FOR	NO.	DATE																							
<i>AWD</i>	<i>3</i>	<i>8-2</i>																							
<i>SHD</i>	<i>3</i>	<i>2-11-44</i>																							
<i>OSH</i>	<i>4</i>	<i>2-11-44</i>																							
<i>CONTR</i>	<i>3</i>	<i>6-15</i>																							
<i>BRIDGE # 171 - CR - 25</i>																									
<i>WILSON Rd. N.Y.C. R.R.</i>																									
<i>FRANKLIN COUNTY</i>																									
<i>WHITAKER - MERRELL CO.</i>																									
<i>CONTRACTOR</i>																									
<i>O.S.H.D. (BARRETT ASSOCIATED ENG.)</i>																									
<i>ARCHITECT-ENGINEER</i>																									
CONTRACT NO.		DRAWN		CHECKED		APPROVED																			
<i>20852</i>		<i>JB</i>		<i>LC</i>		<i>O.S.H.D.</i>																			
		<i>JULY - 65</i>				<i>8-20-66</i>																			
						<i>A 8</i> OF																			


SUBSTANDARD DRAWING

This drawing does not meet minimum filming standards! **MICRO-DATA** does not accept responsibility for the inferior results due to the condition of this drawing.


a	aa	ba
b	ab	bb
c		
d		
e		
f		
g		
h		
i		
k		
m		
n		
p		
s		
t		
v		
w		
y		

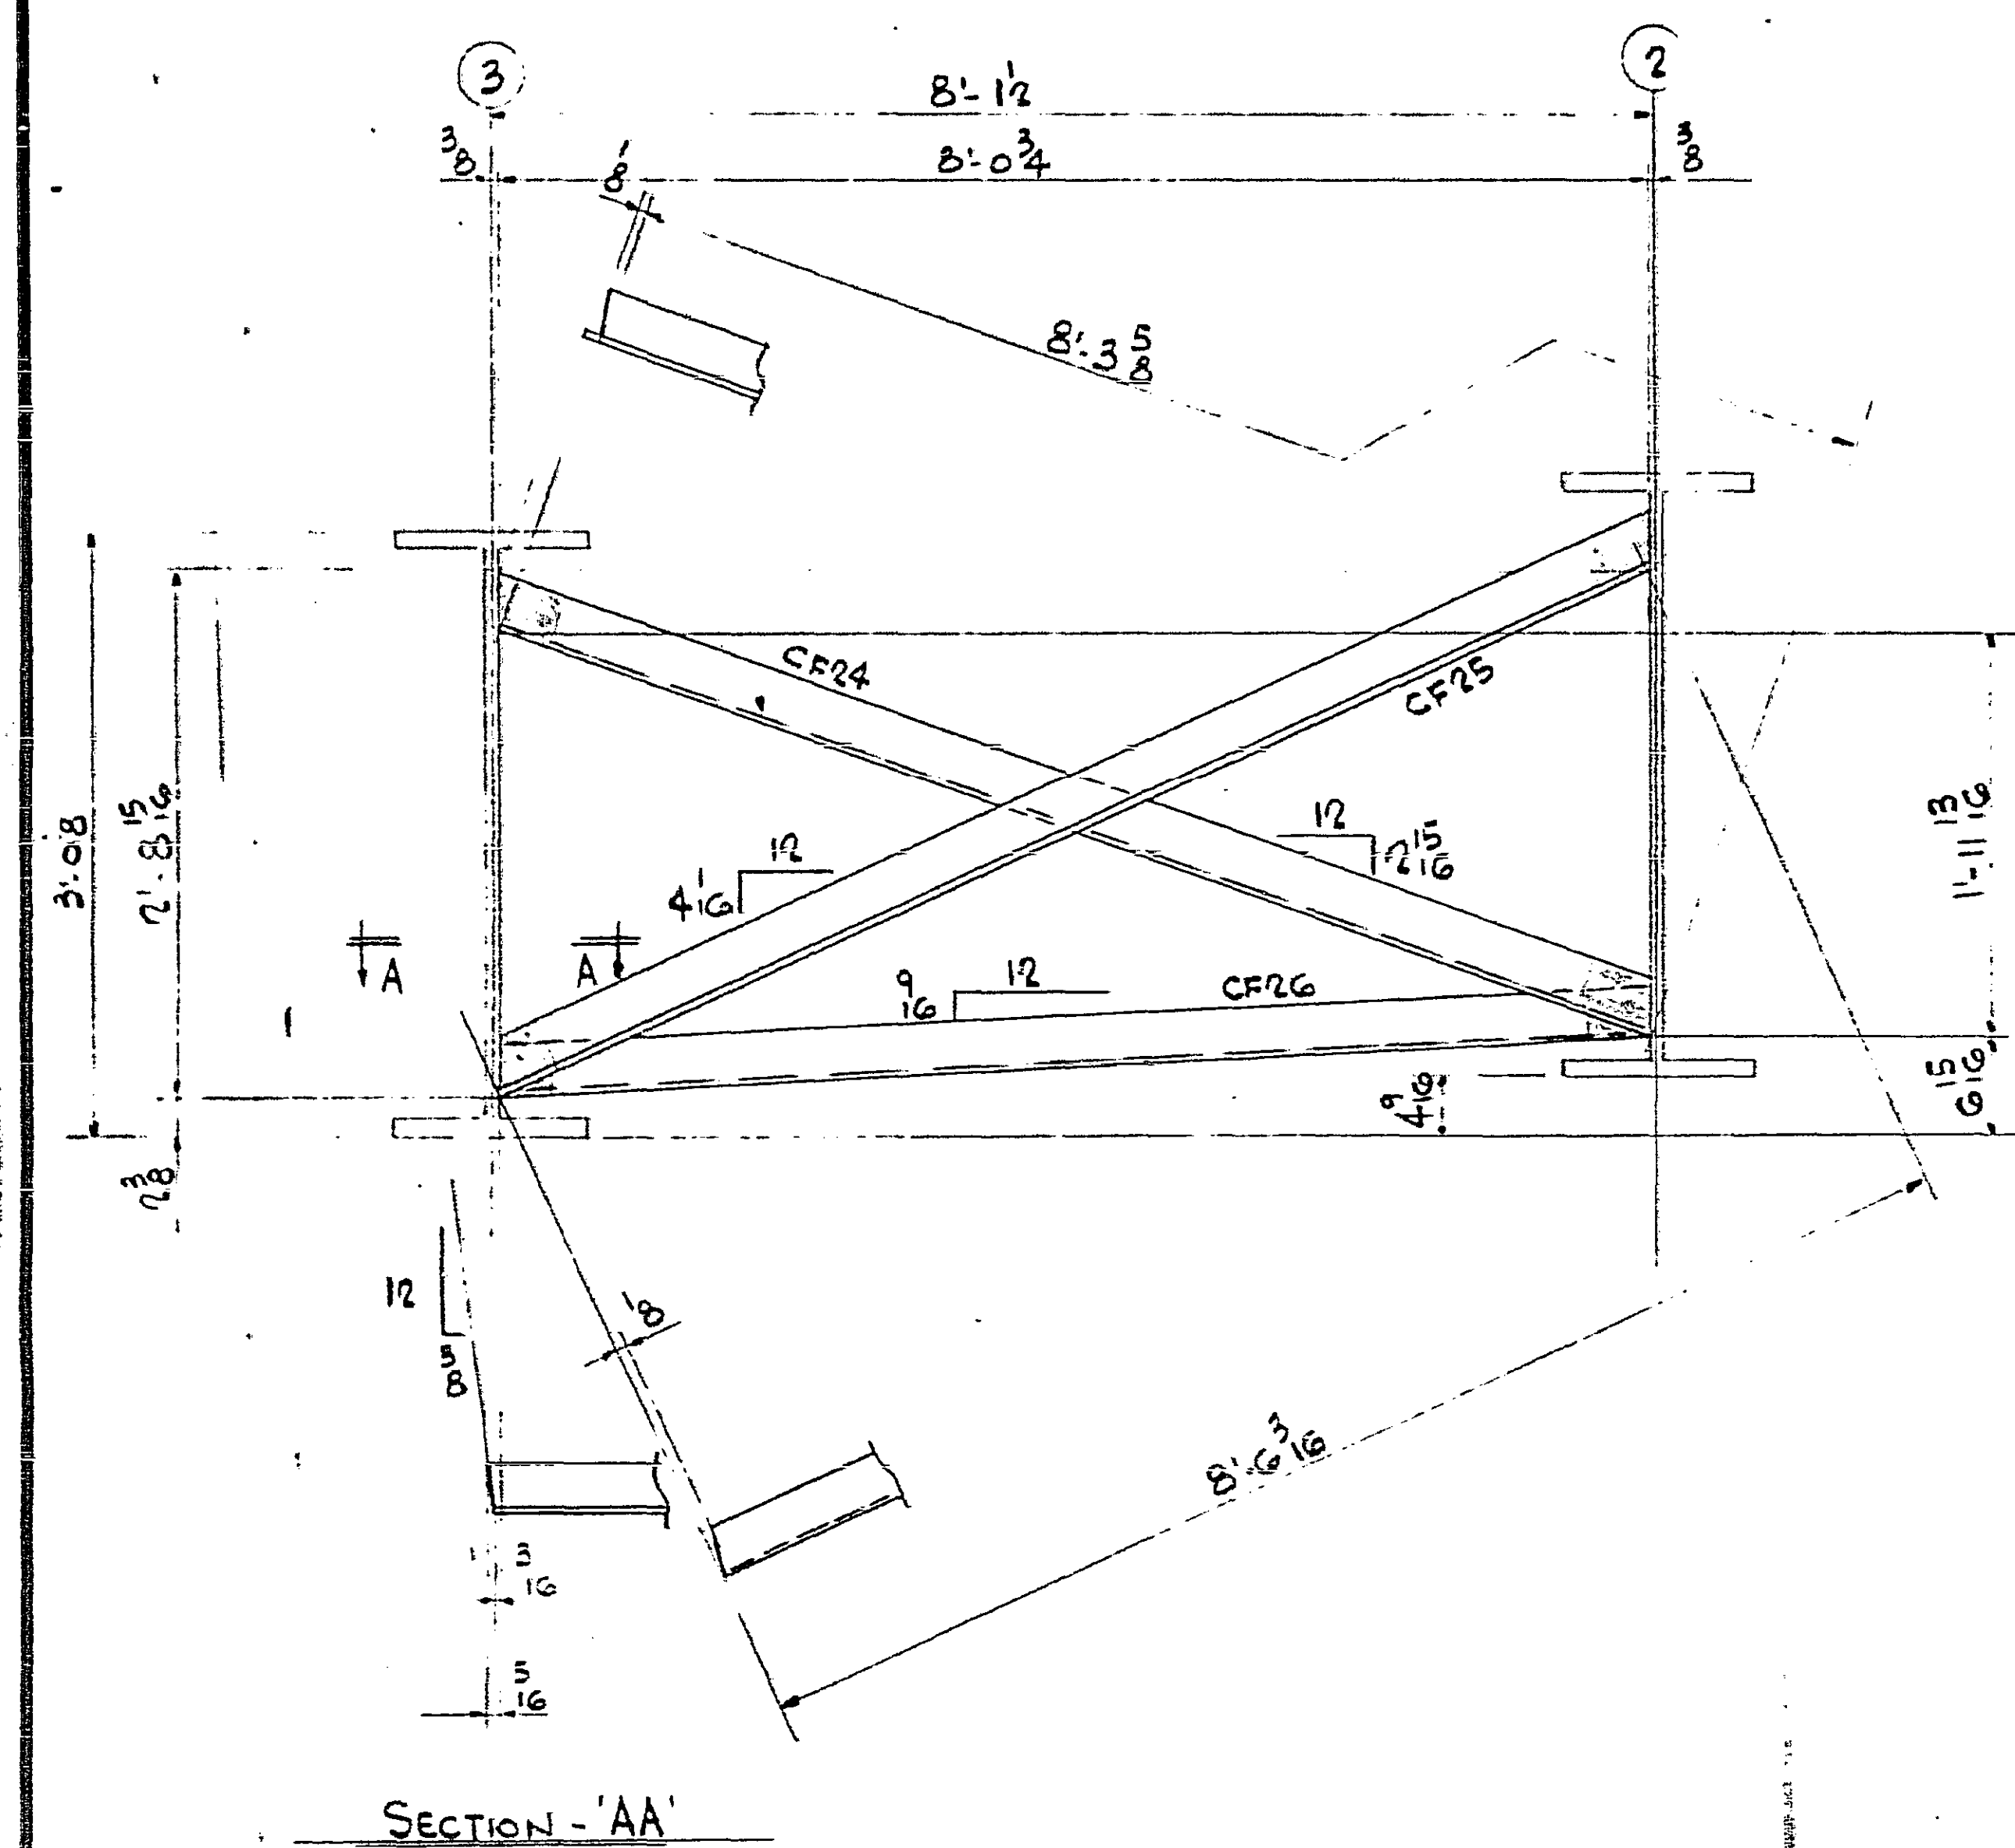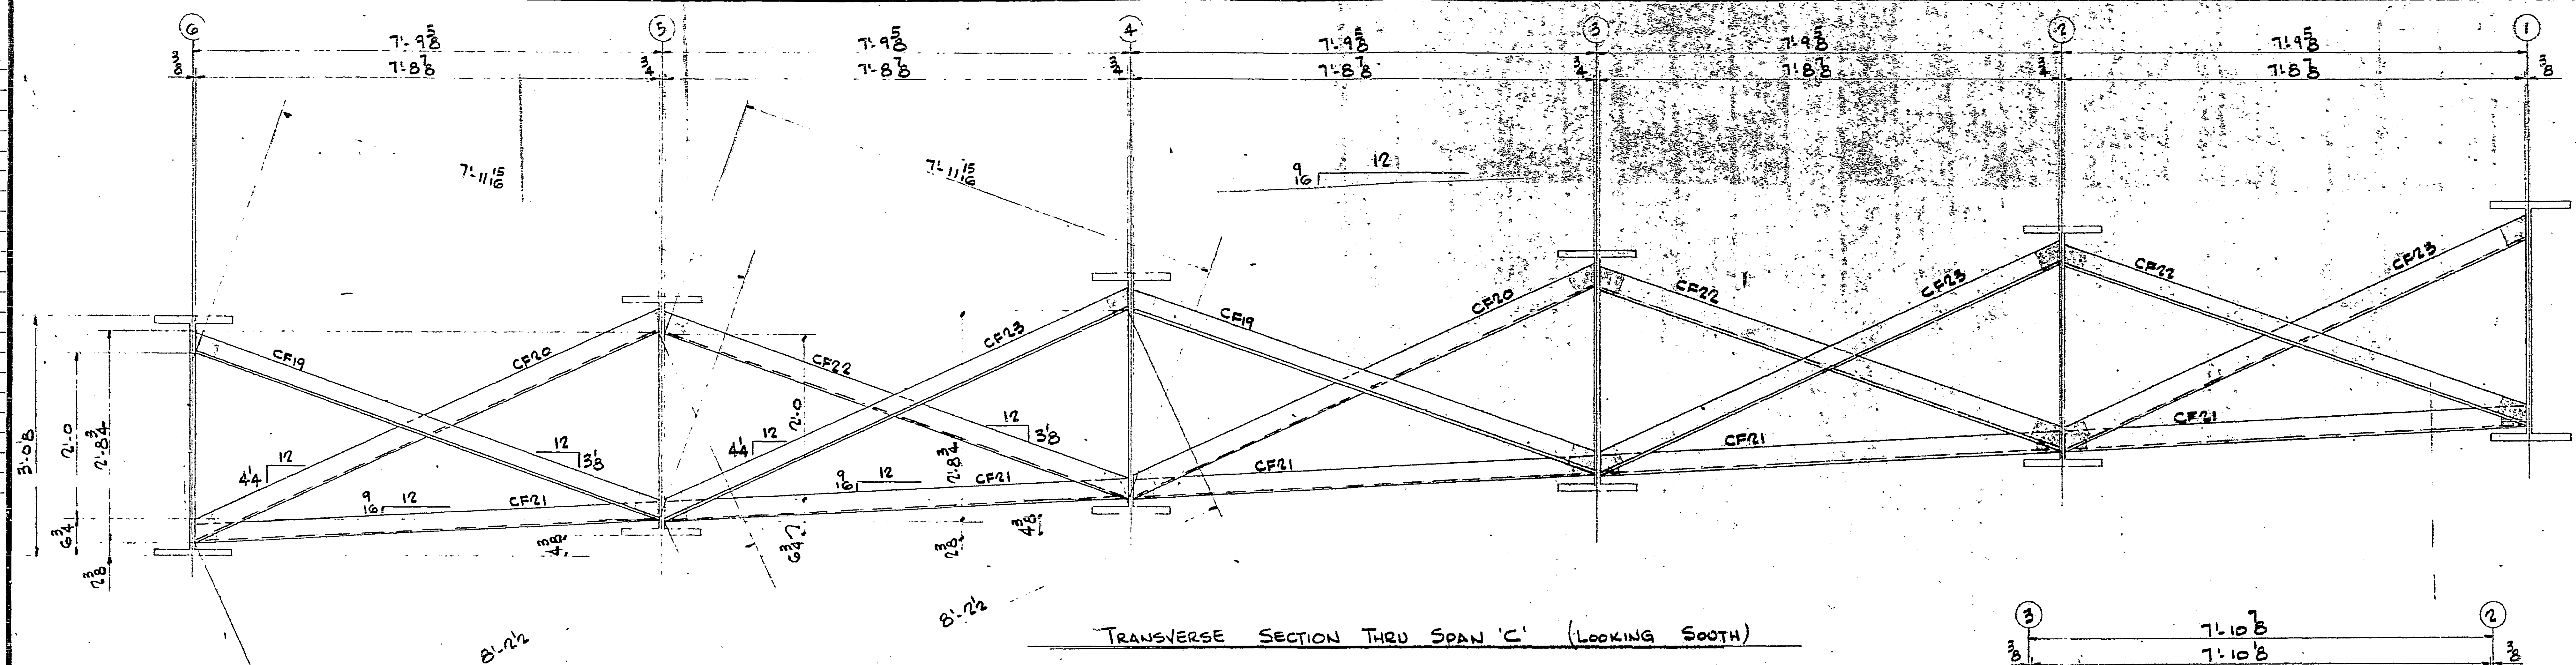


SECTION BETWEEN LINES 2 & 3 @ SPAN 'B'

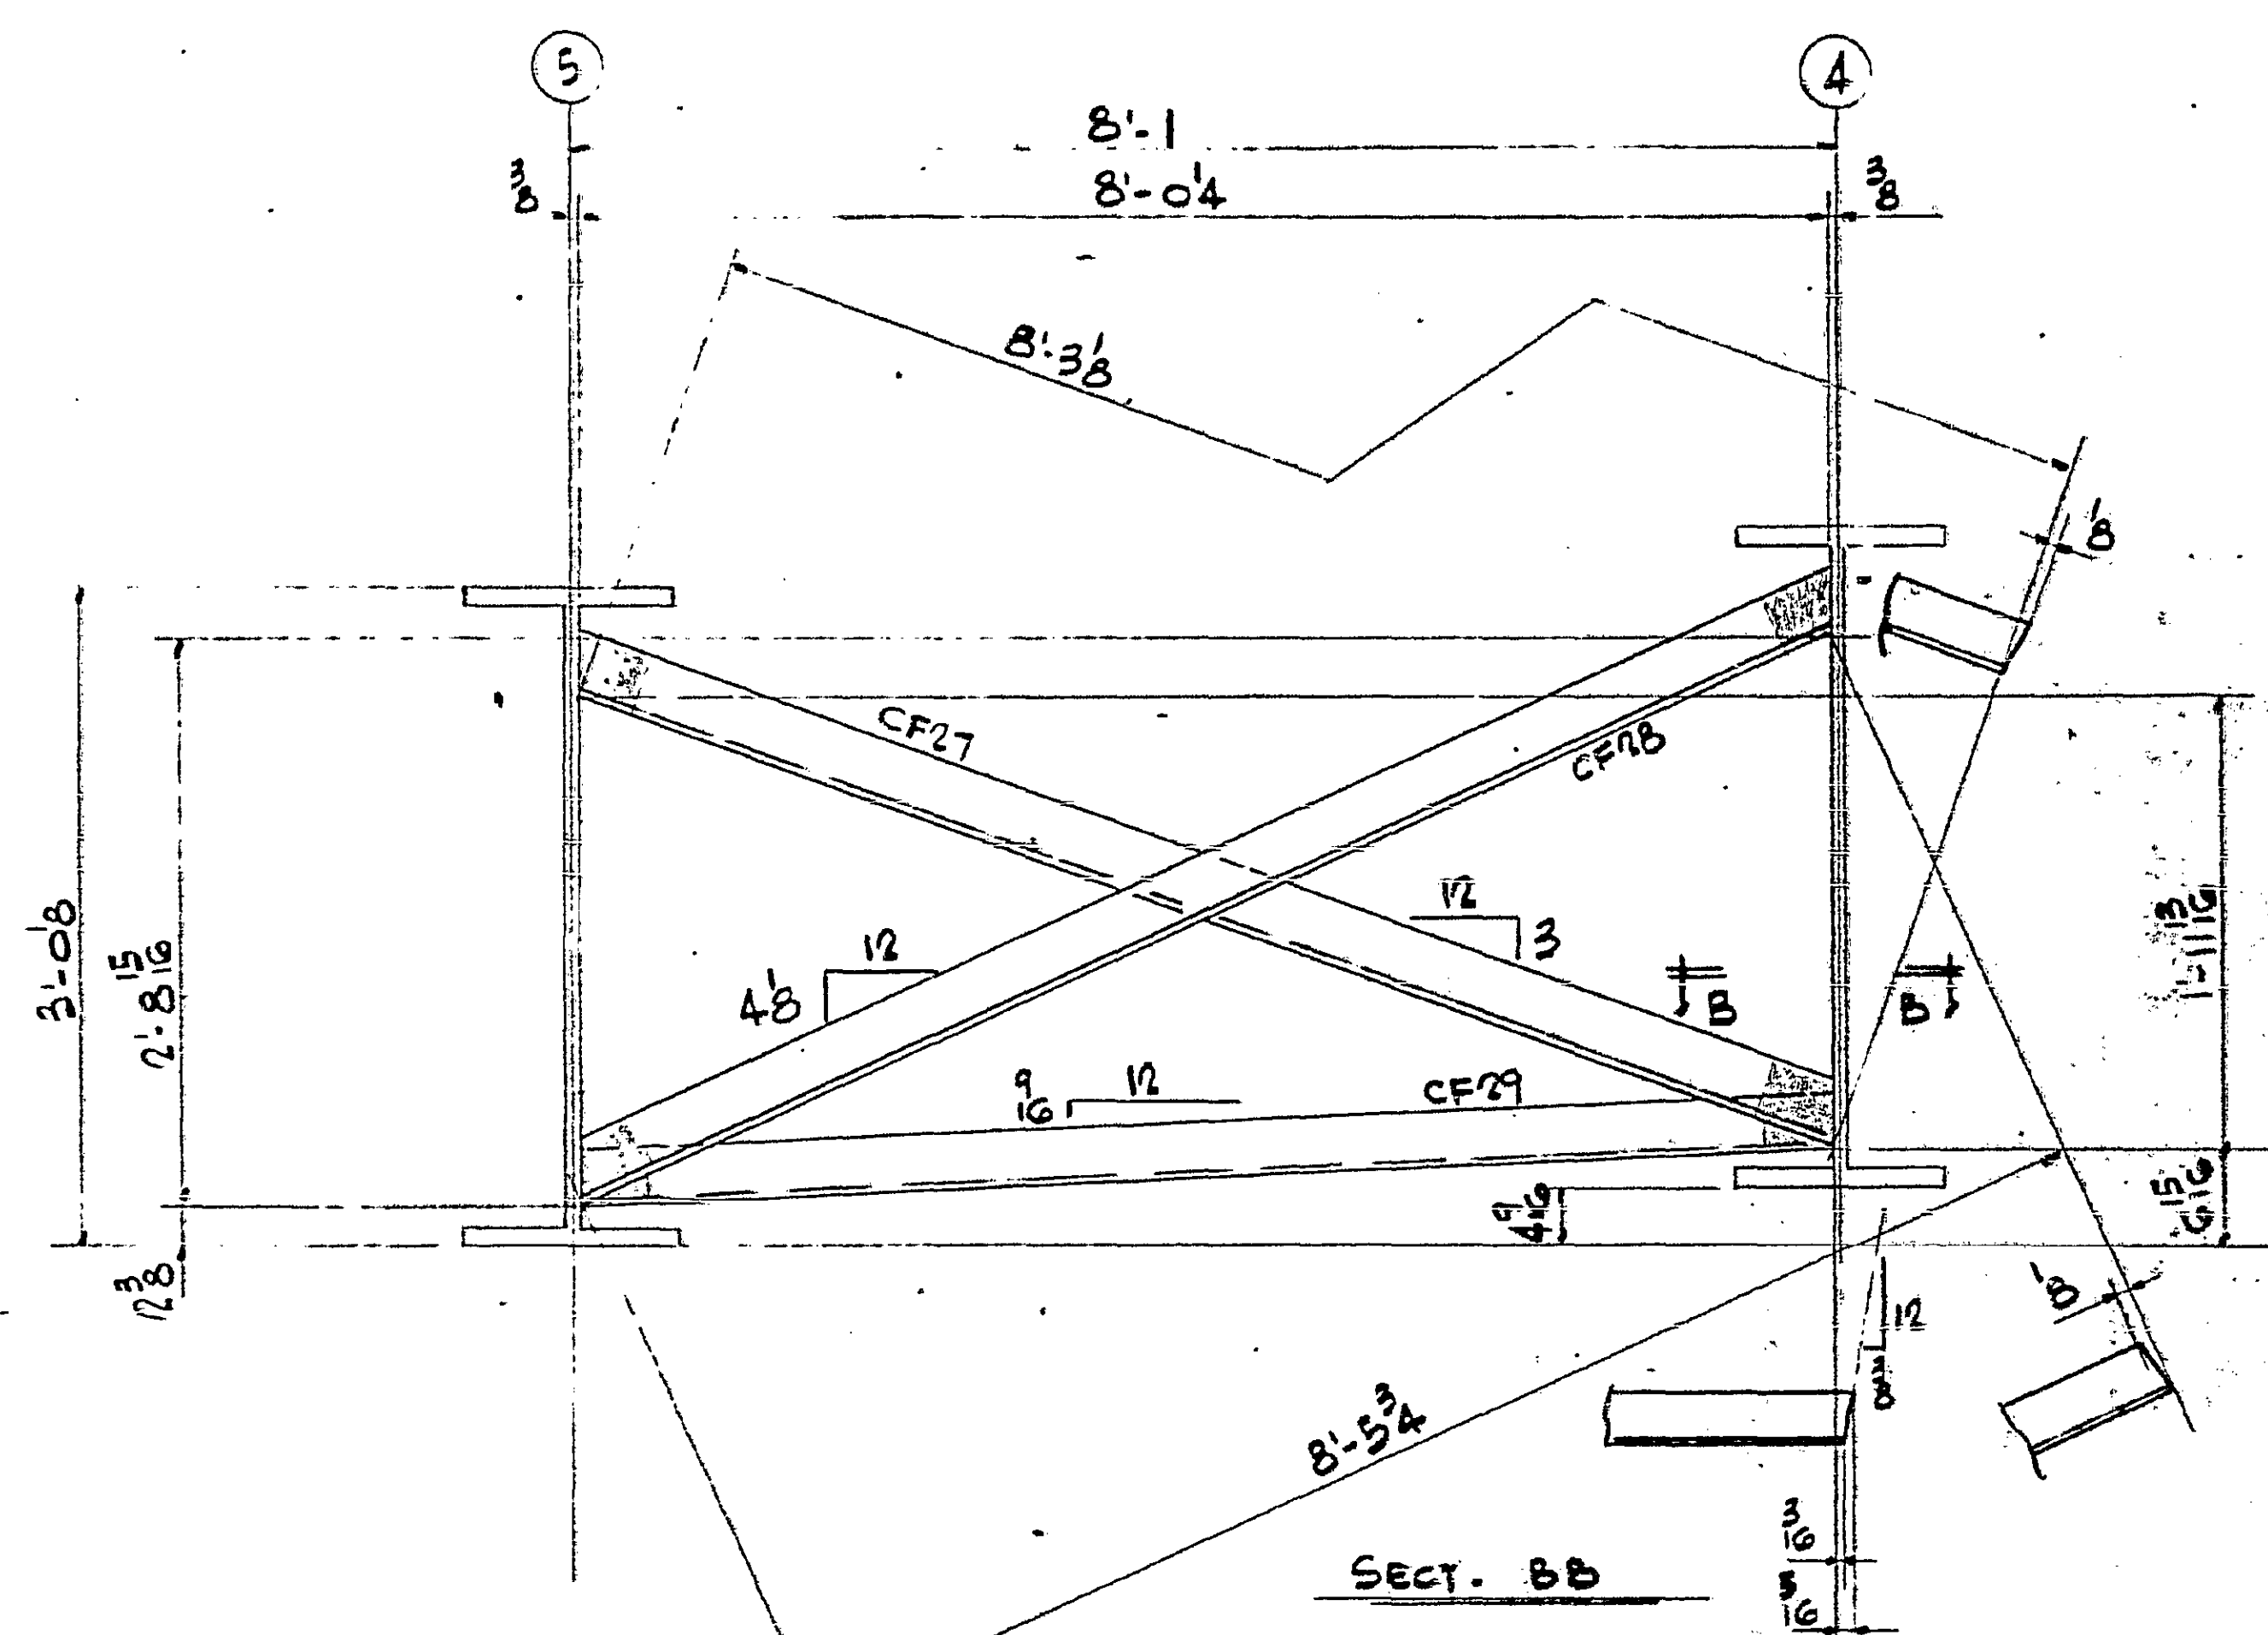

SECTION BETWEEN LINES 4 & 5 @ SPAN 'B'

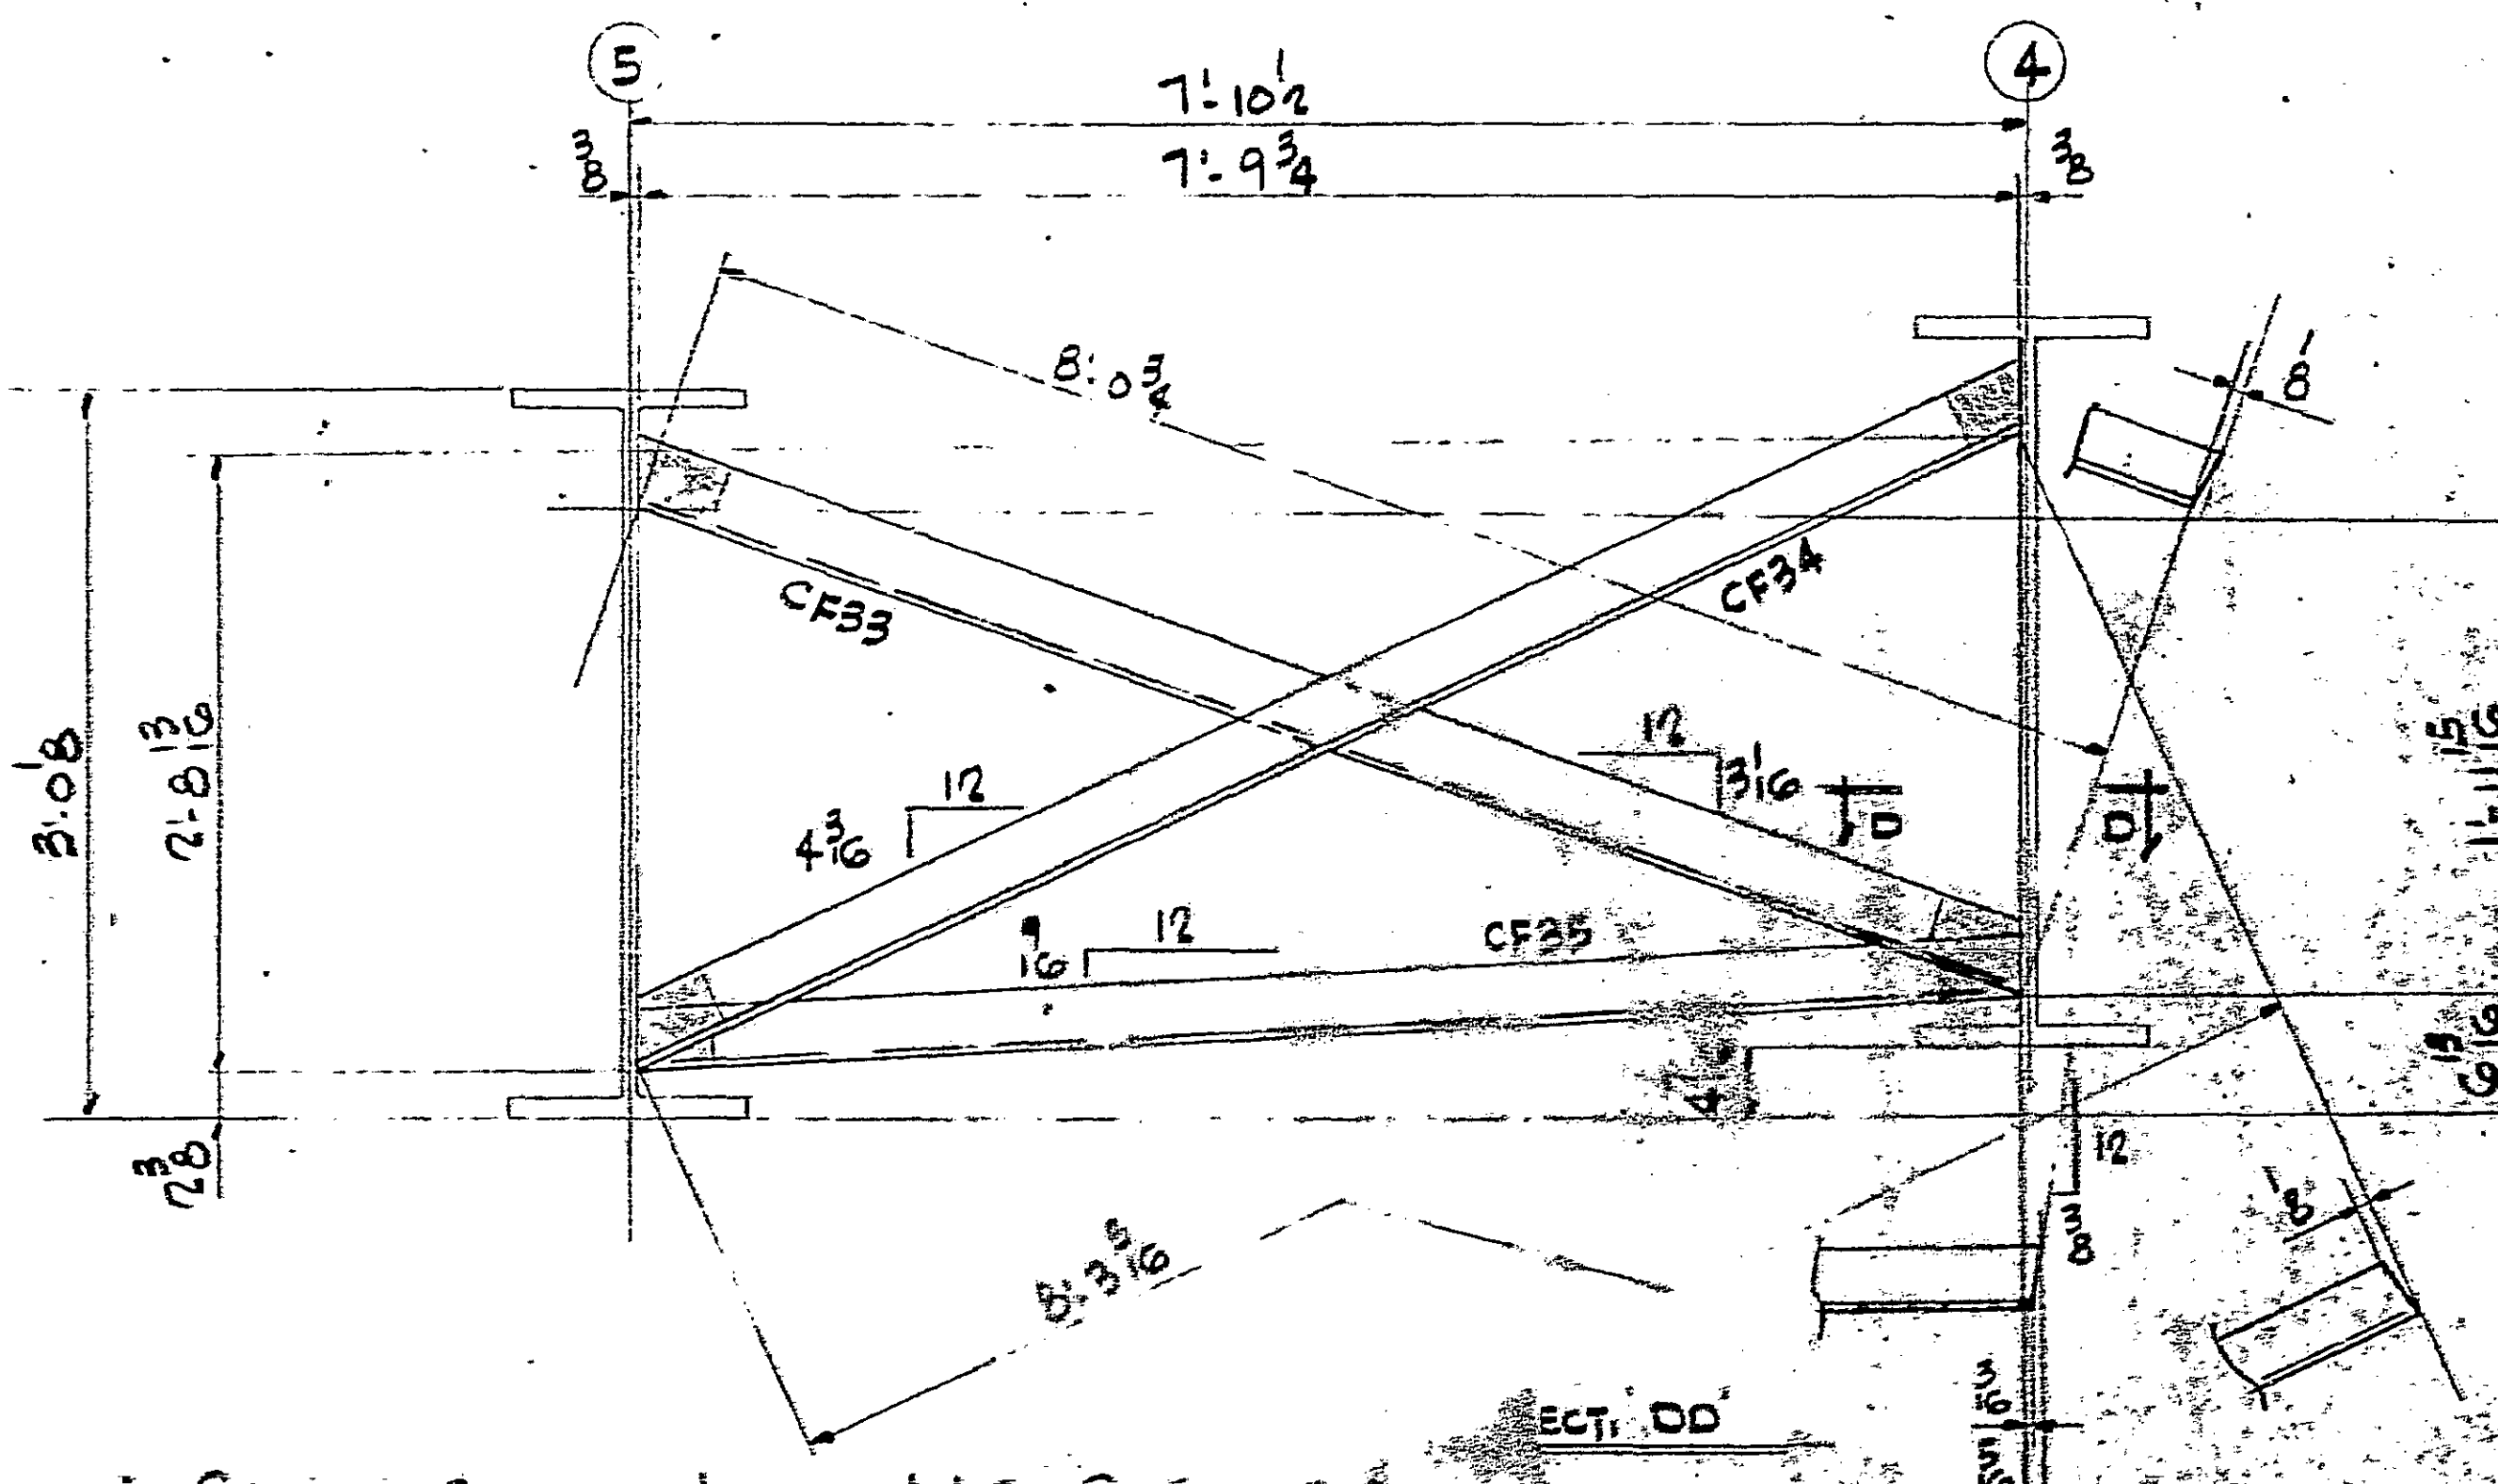

SECTION BETWEEN LINES 4 & 5, @ SPAN C

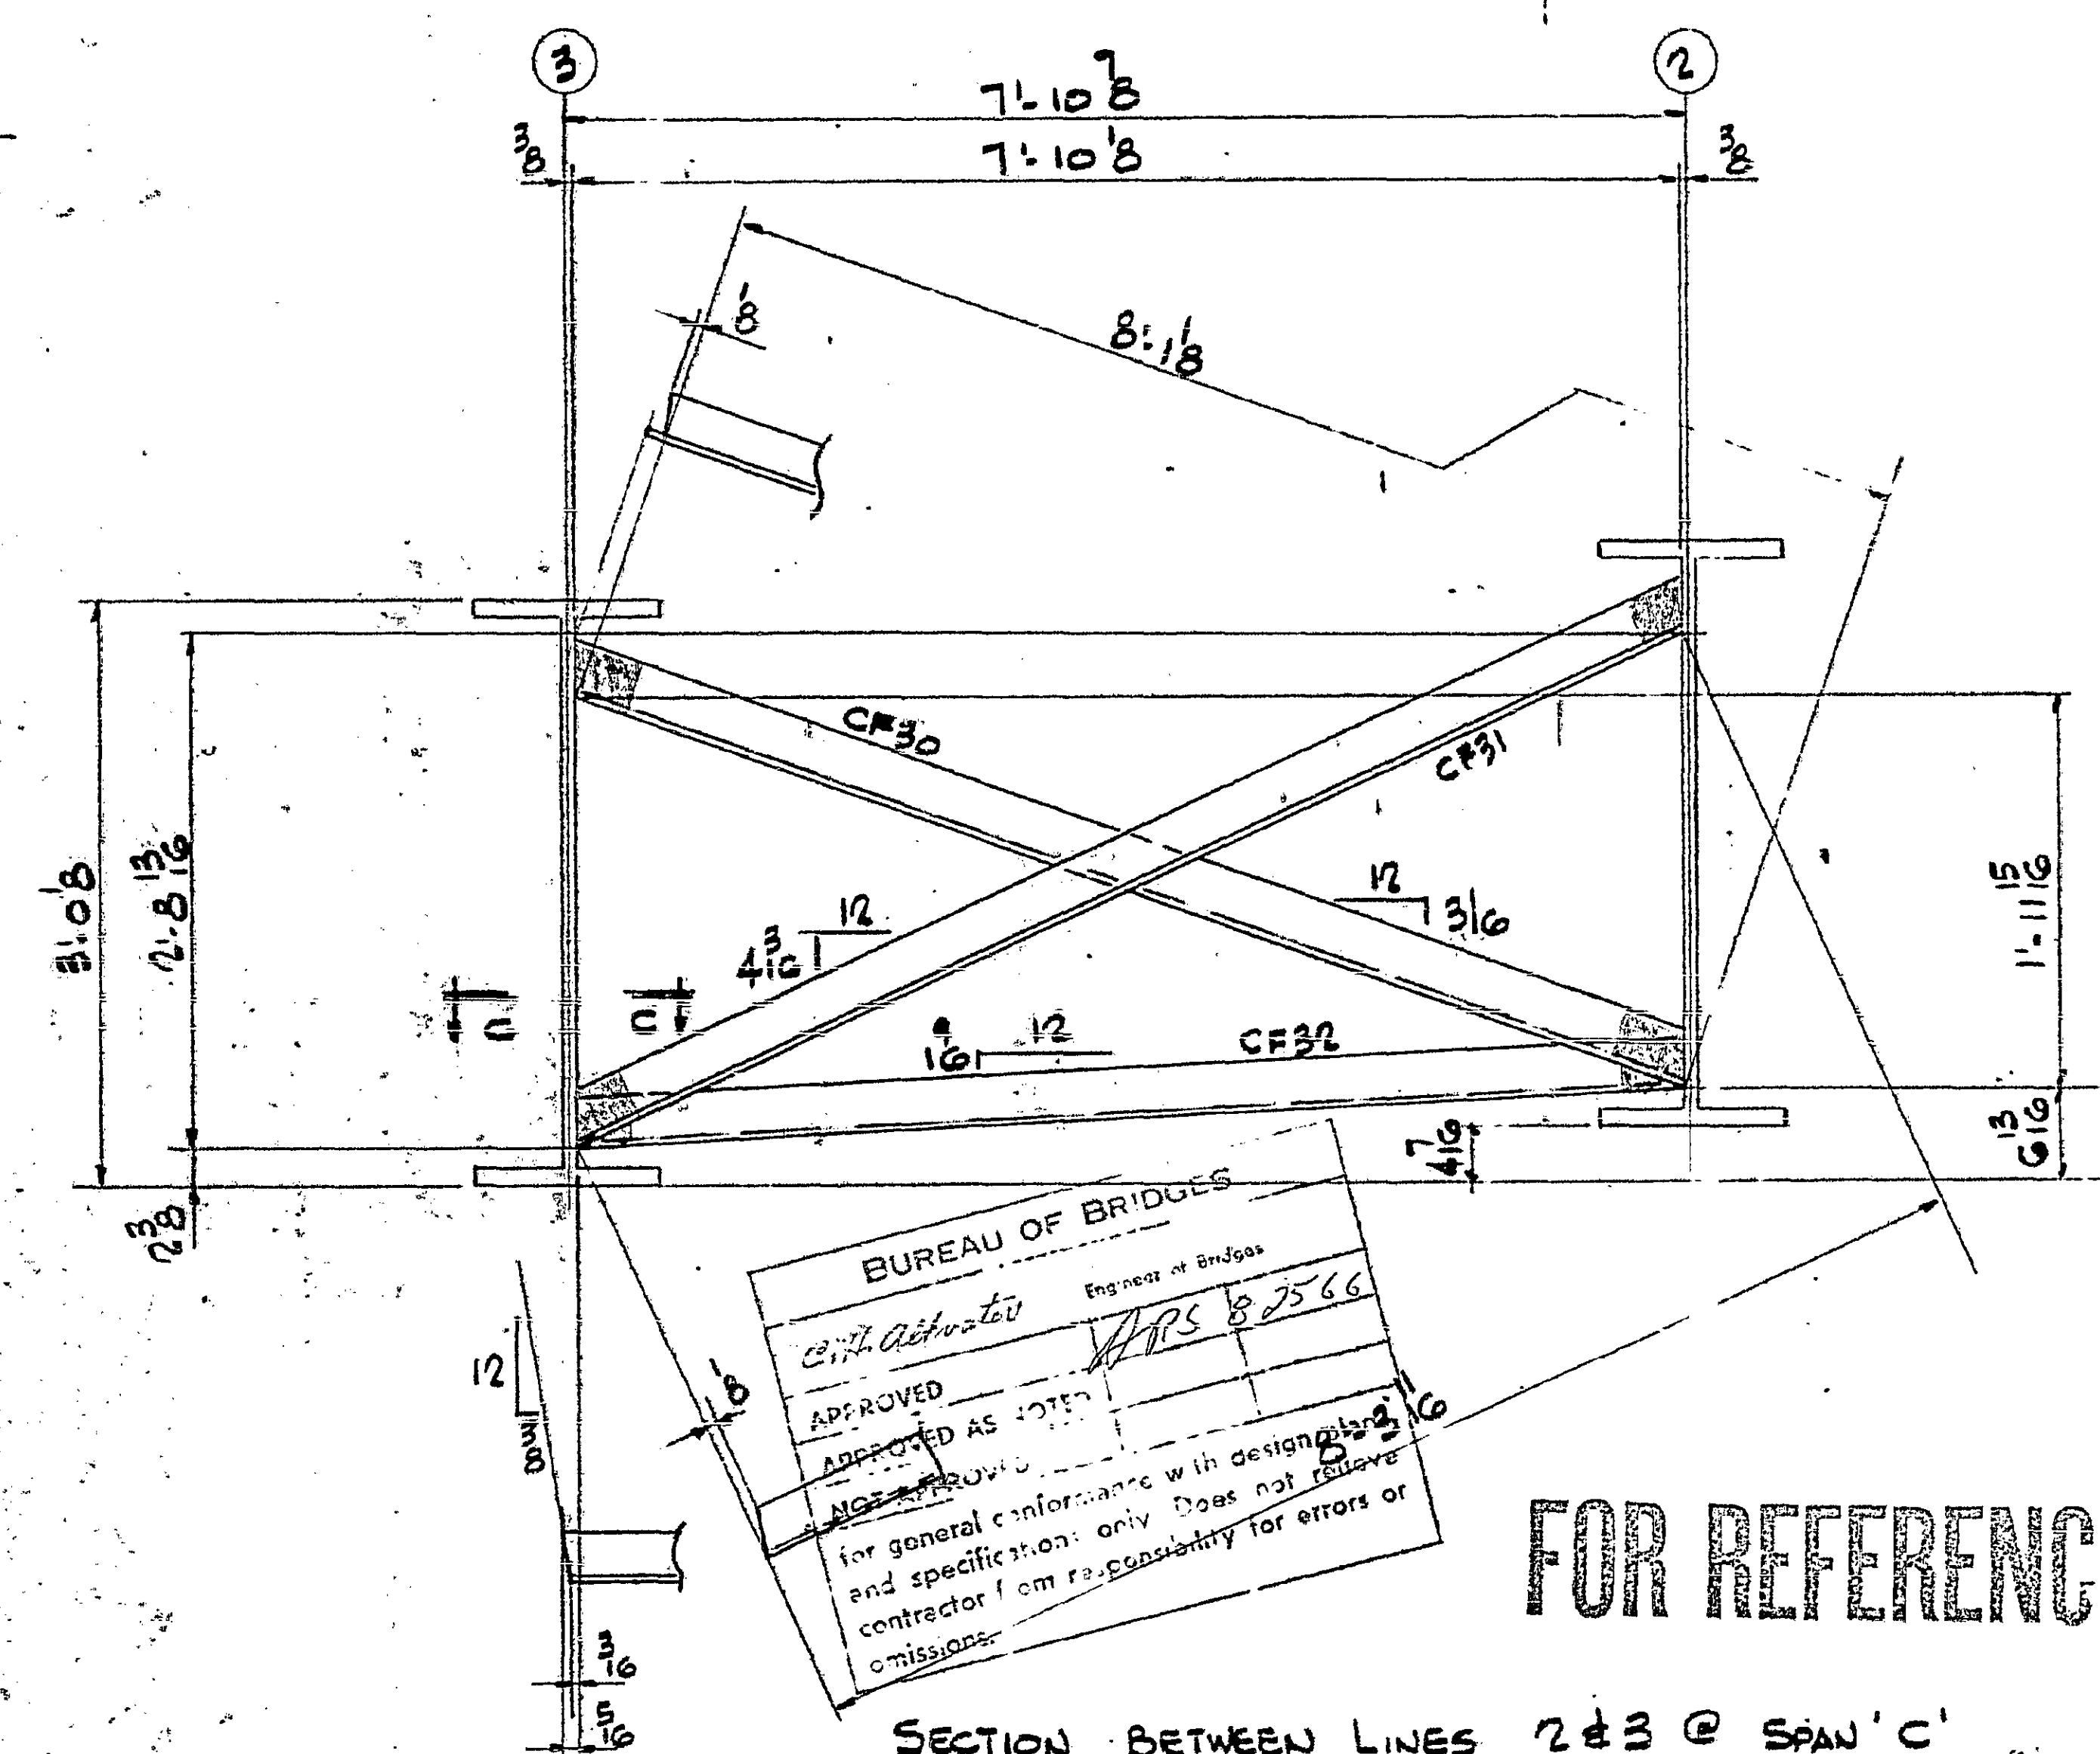

FOR PREFERENCE

SECTION - CC

CROSS FRAMES

SCHEDULE OF CROSSFRAMES

No. Seq'd.	DESCRIPTION	FR.	IN.	MARK
18	L-3-3 x 1/2 x	8	0 1/2	CF 19
18	do	8	3 1/2	CF 20
28	do	7	9 1/2	CF 21
10	do	8	0 1/2	CF 22
10	do	8	3 1/2	CF 23
ONE	do	8	4 1/2	CF 24
ONE	do	8	7 1/2	CF 25
ONE	do	8	1 1/2	CF 26
ONE	do	8	4	CF 27
ONE	do	8	6 1/2	CF 28
ONE	do	8	0 1/2	CF 29
ONE	do	8	1 1/2	CF 30
ONE	do	8	4 1/2	CF 31
ONE	do	7	10 1/2	CF 32
ONE	do	8	1 1/2	CF 33
ONE	do	8	4 1/2	CF 34
ONE	L-3-3 x 1/2 x	7	10 1/2	CF 35

DATE

NO.

REVISION

BY

CH. BY

HOLES UNLESS NOTED

SHOP CONNECTIONS

FIELD CONNECTIONS

ERECTION BY

FINISH UNLESS NOTED

ONE SHOP COAT 708.07

WELDED

OTHERS

BUSHED ON

ISSUE

FOR / NO. DATE

AMR 3 12-2

SHOP 3 12-14

OSHD 4 1-13

CONTR 3 12-13

The J.T. EDWARDS COMPANY

1241 MCKINLEY AVENUE
COLUMBUS, OHIO 43222

BRIDGE # 171 - CR - 75

WILSON RD. - N.Y.C. R.R.

FRANKLIN COUNTY

WHITAKER MERRELL CO.

CONTRACTOR

O.S.H.D. (BARRETT ASSOCIATED ENG.)

ARCHITECT-ENGINEER

CONTRACT NO.

DRAWN

CHECKED

APPROVED

A9

20852

JB

LC

OSHD

OF

JUN-66

8-26-66

SUBSTANDARD DRAWING

SHOP NOTE!
NO PAINT WITHIN 2" OF END
OF ANGLES (SHADED AREA)
ALL MATERIAL A-36

5080 010 SHOP DWG. STR. STEEL 0063 11968 0240 060