

## ORDINANCE NO. 1471

TO VACATE CERTAIN ALLEYS IN VALENTINE'S ADDITION, BEING THE ALLEY ALONG THE NORTH SIDE OF SAID ADDITION, FROM THE EAST LINE OF LOT 10 EXTENDED NORTHERLY ACROSS SAID ALLEY, EASTERLY TO THE EAST LINE OF LOT 24 EXTENDED NORTHERLY ACROSS SAID ALLEY; THE ALLEY EAST OF AND ADJACENT TO LOT 28, FROM THE SOUTH LINE OF LOT 28 EXTENDED EASTERLY ACROSS SAID ALLEY, NORTHERLY TO THE NORTHERN TERMINUS OF SAID ALLEY; AND THE ALLEY EAST OF AND ADJACENT TO LOT 29, FROM THE NORTH LINE OF LOT 29 EXTENDED, EASTERLY ACROSS SAID ALLEY, SOUTHERLY TO THE SOUTH LINE OF LOT 29 EXTENDED EASTERLY ACROSS SAID ALLEY.

WHEREAS, petitions by persons owning lots in the immediate vicinity of the alleys hereinafter described were presented to Council praying that said alleys, between the points named, be vacated; and

WHEREAS, notice of the pendency and prayers of said petitions have been given as required by law for six consecutive weeks; and

WHEREAS, Council, upon hearing, is satisfied that there is good cause for such vacation as prayed for, that it will not be detrimental to the general interest, and ought to be made.

BE IT ORDAINED BY THE COUNCIL OF THE CITY OF WESTERVILLE, STATE OF OHIO:

Section 1. That the following described alleys in Valentine's Addition be and the same are hereby vacated:

- a. The alley along the north side of said addition, from the east line of Lot 10 extended northerly across said alley, easterly to the east line of Lot 24 extended northerly across said alley.
- b. The alley east of and adjacent to Lot 28, from the south line of Lot 28 extended easterly across said alley, northerly to the northern terminus of said alley.
- c. The alley east of and adjacent to Lot 29, from the north line of Lot 29 extended easterly across said alley, southerly to the south line of Lot 29 extended easterly across said alley.

Section 2. That there is reserved to the City of Westerville its successors and assigns, a permanent right-of-way and easement, over, across, upon, through and under the alley vacated in Section 1b hereof, for the purpose of the installation, maintenance, repair and relocation of water, electric, storm and sanitary sewer, gas, and telephone lines.

Section 3. That this ordinance shall be and remain in force from and after the earliest period allowed by law.

Passed:


May 3 1966 Walter J. Brubaker  
Chairman of Council

Approved:

Kay Cornely  
Director of Law

VACATION'S FOR 1945-452  
 VACATION'S A/L 23.7 PG. 450-452  
 V A L L E N T I N

323.62

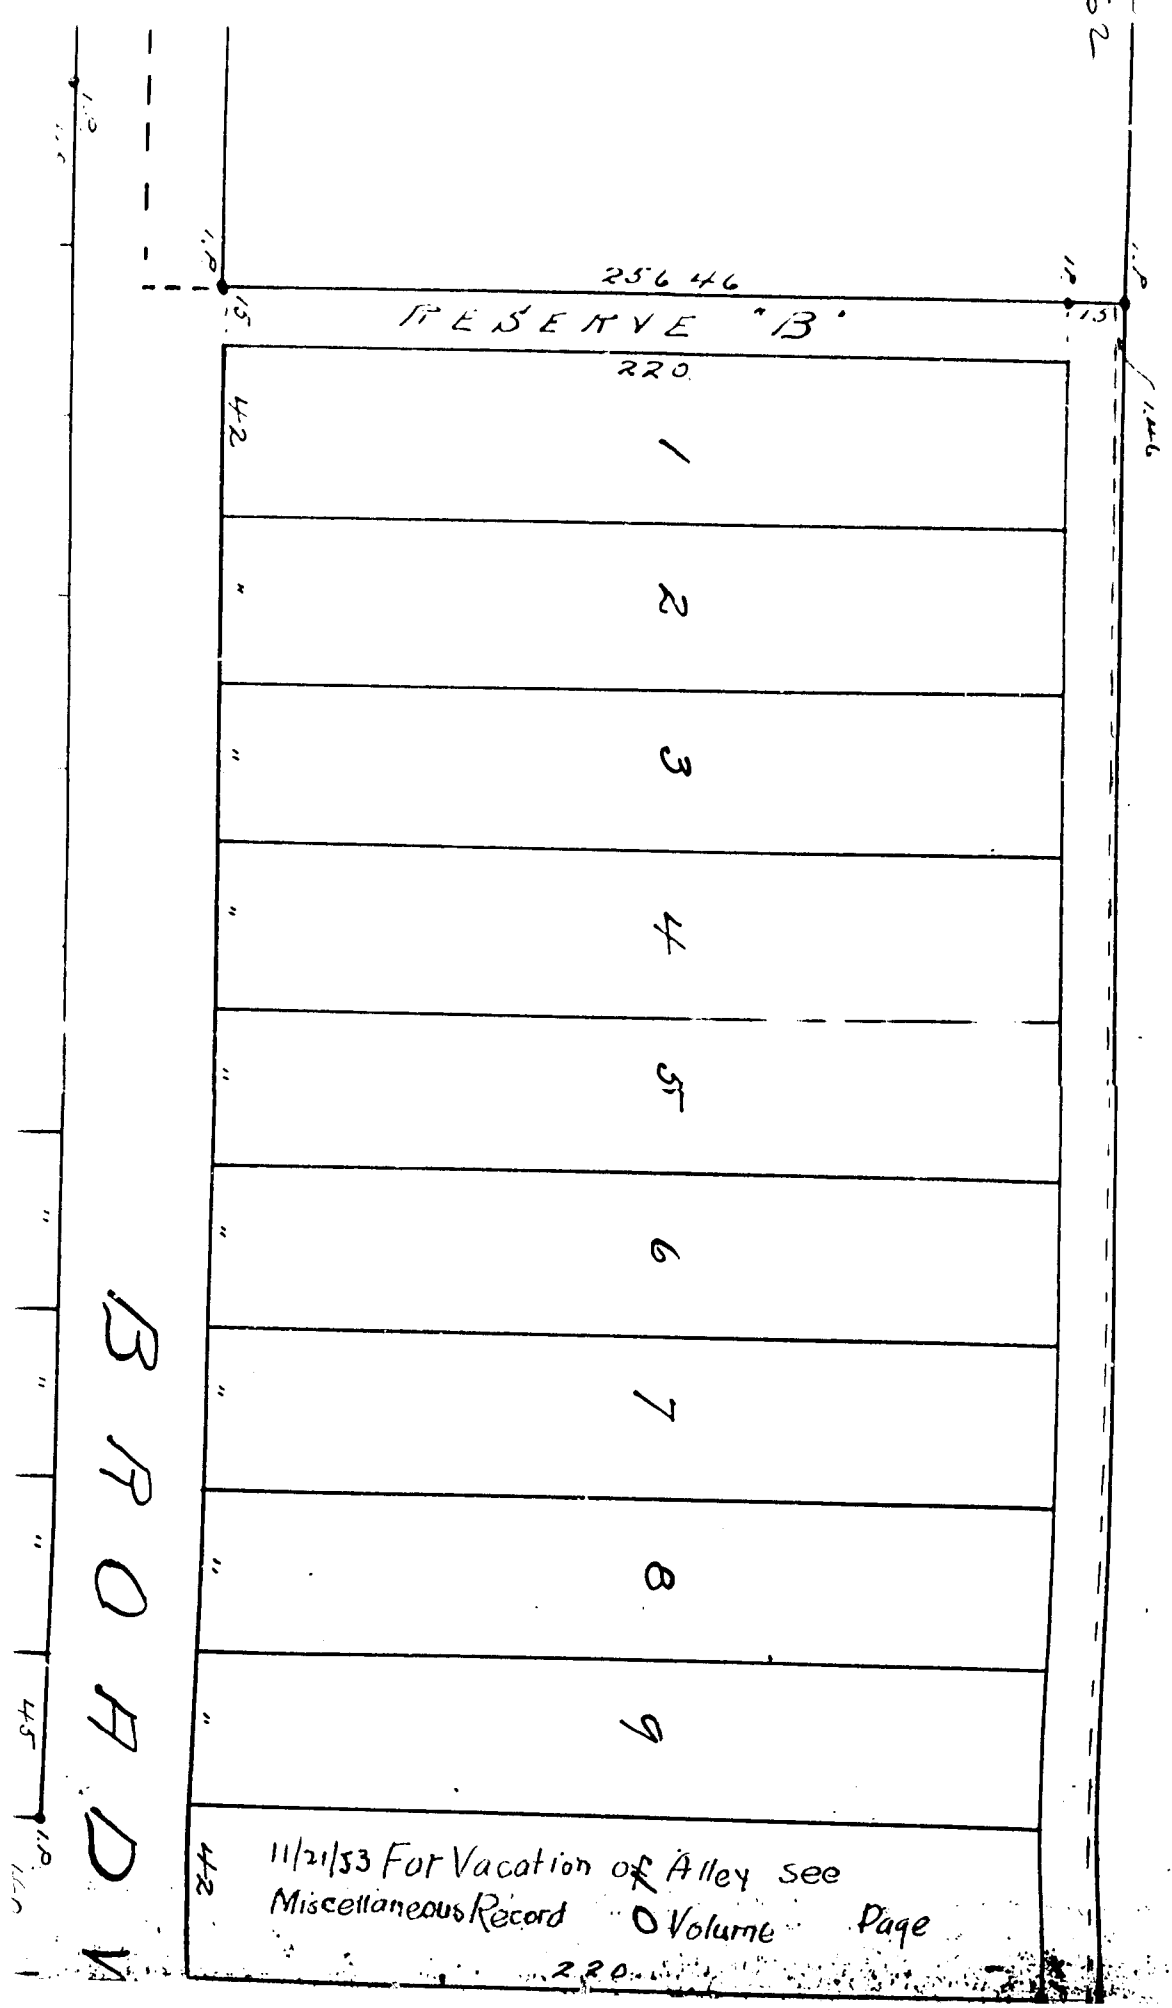

RESERVE "B"

220

42	1
"	2
"	3
"	4
"	5
"	6
"	7
"	8
"	9

B R O A D W A Y

11/21/53 For Vacation of Alley see  
 Miscellaneous Record Volume Page

220

