


PART  
TOWNSHIP

= 500 FEET

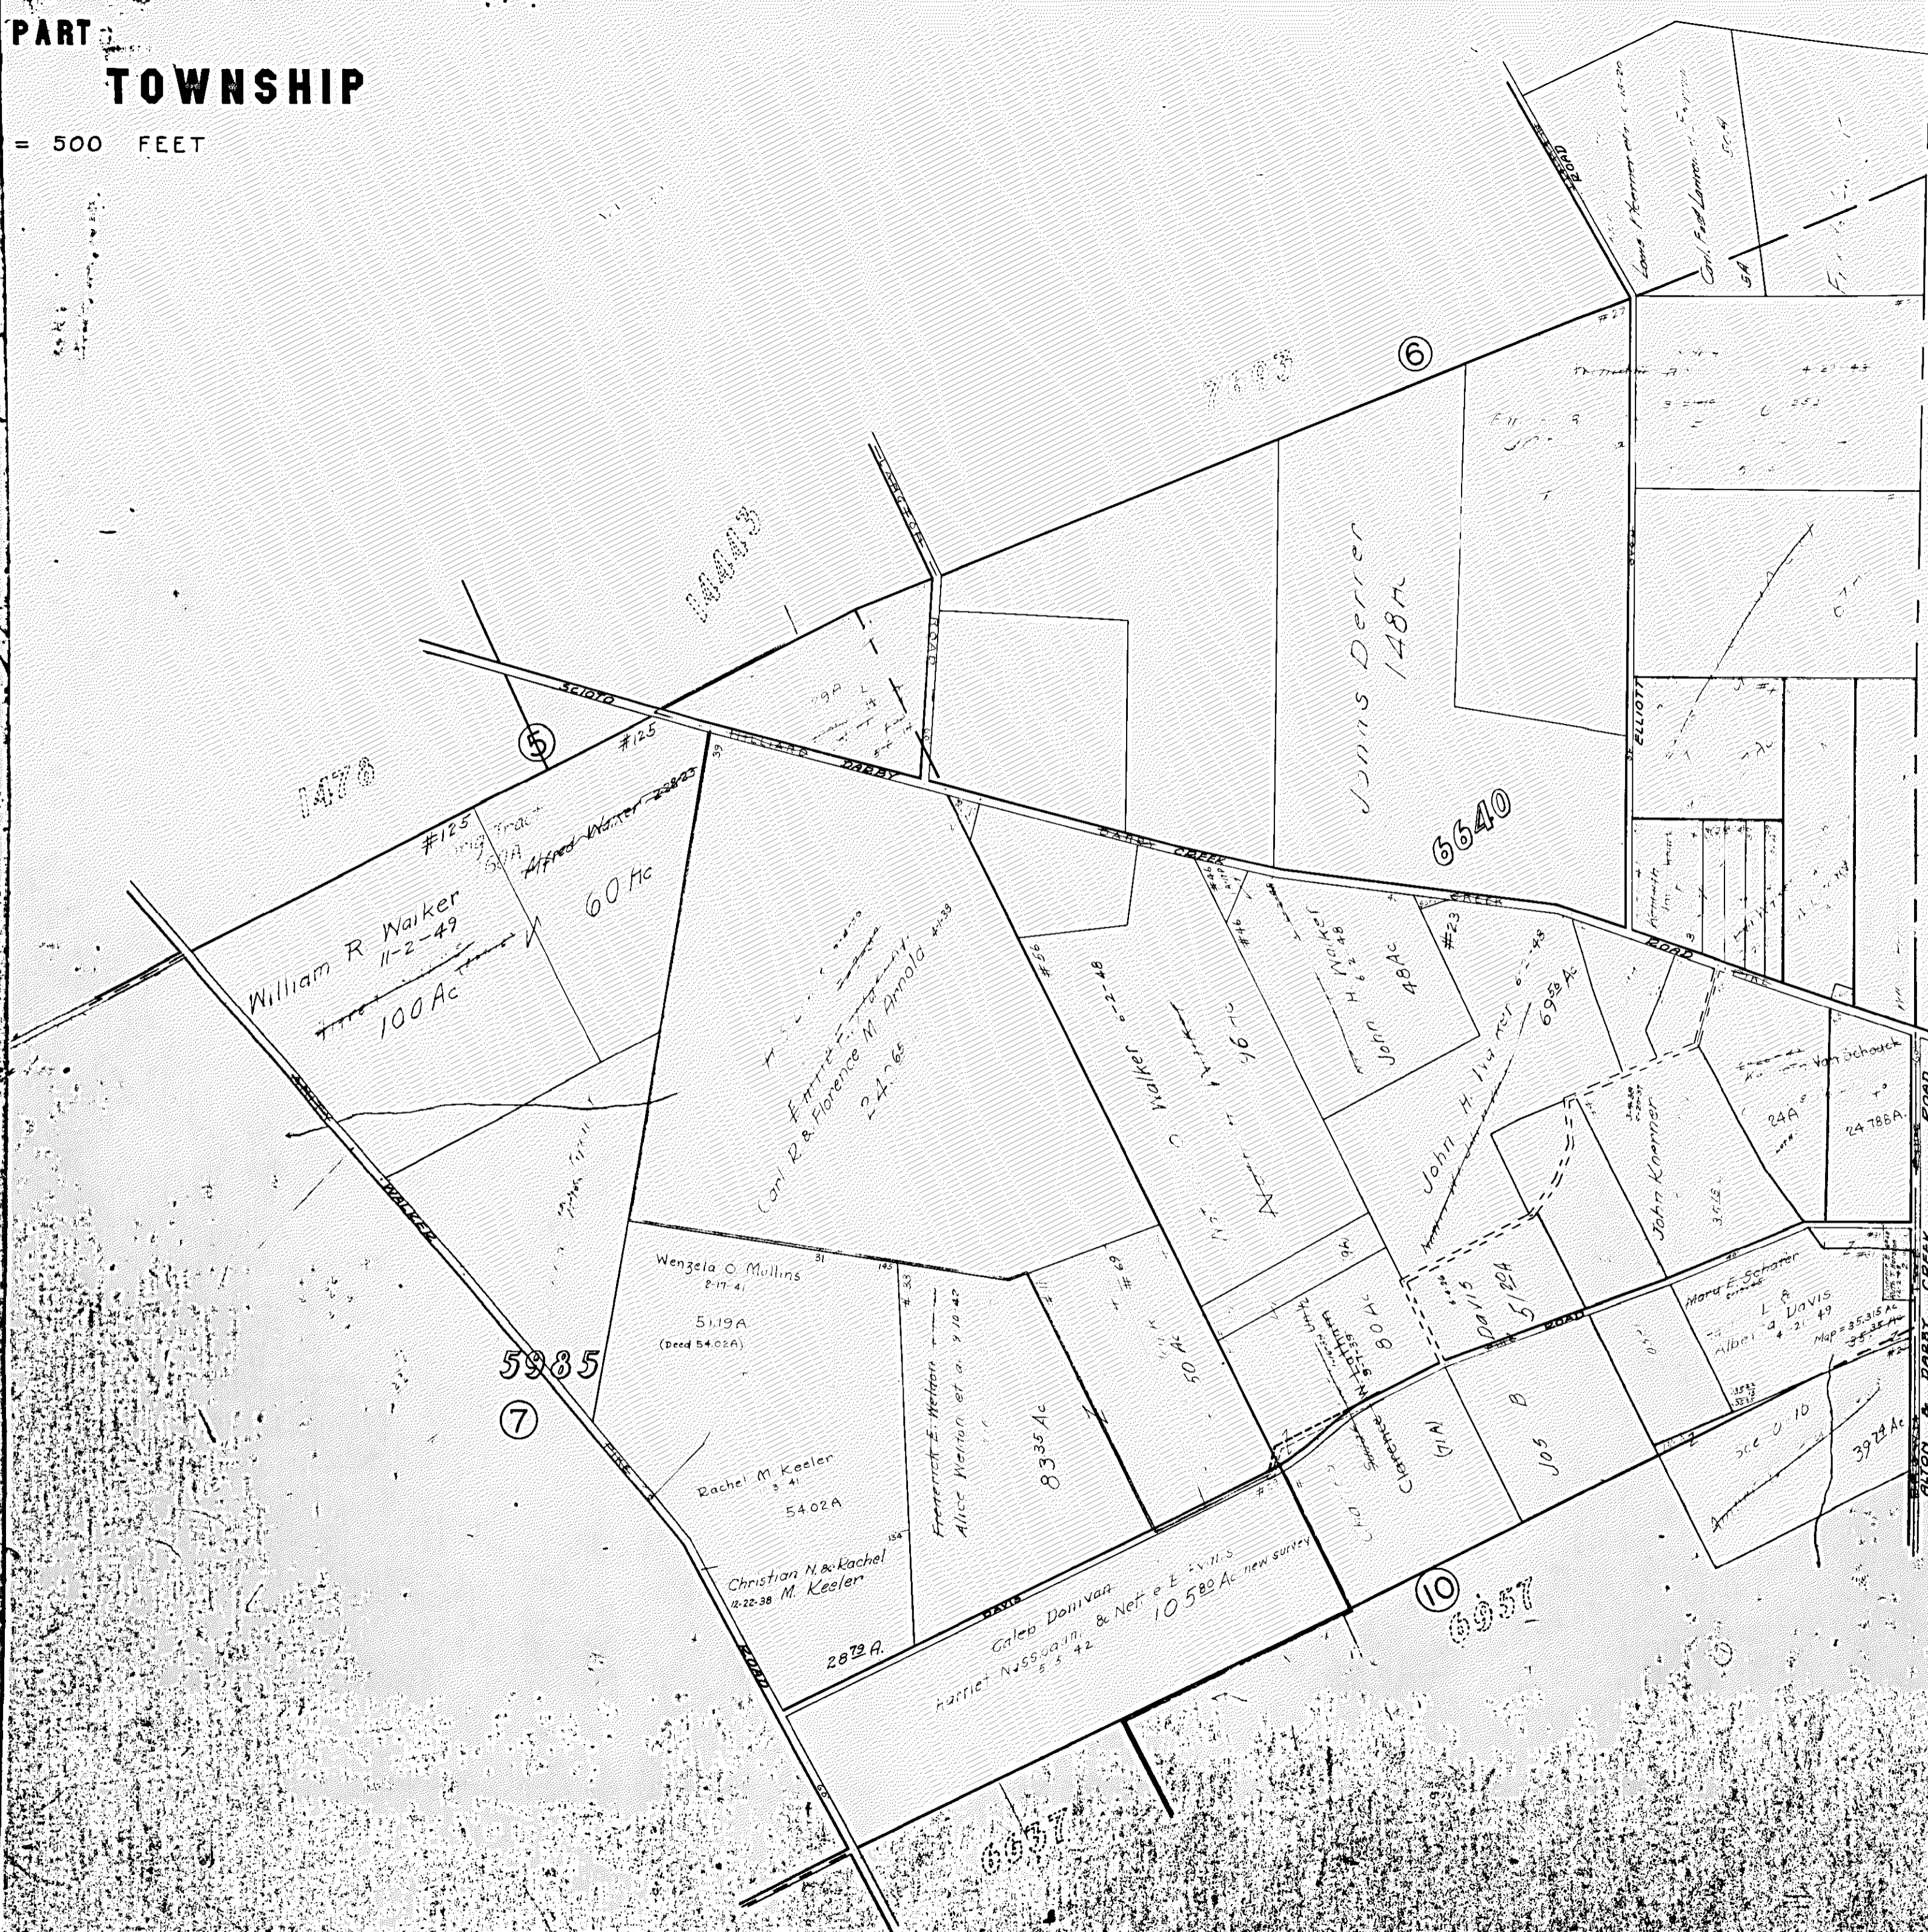

T O W N S H I P  
60  
R A N G E  
16  
S E C T I O N  
10