


HAMILTON

TWP
30
JACKSON

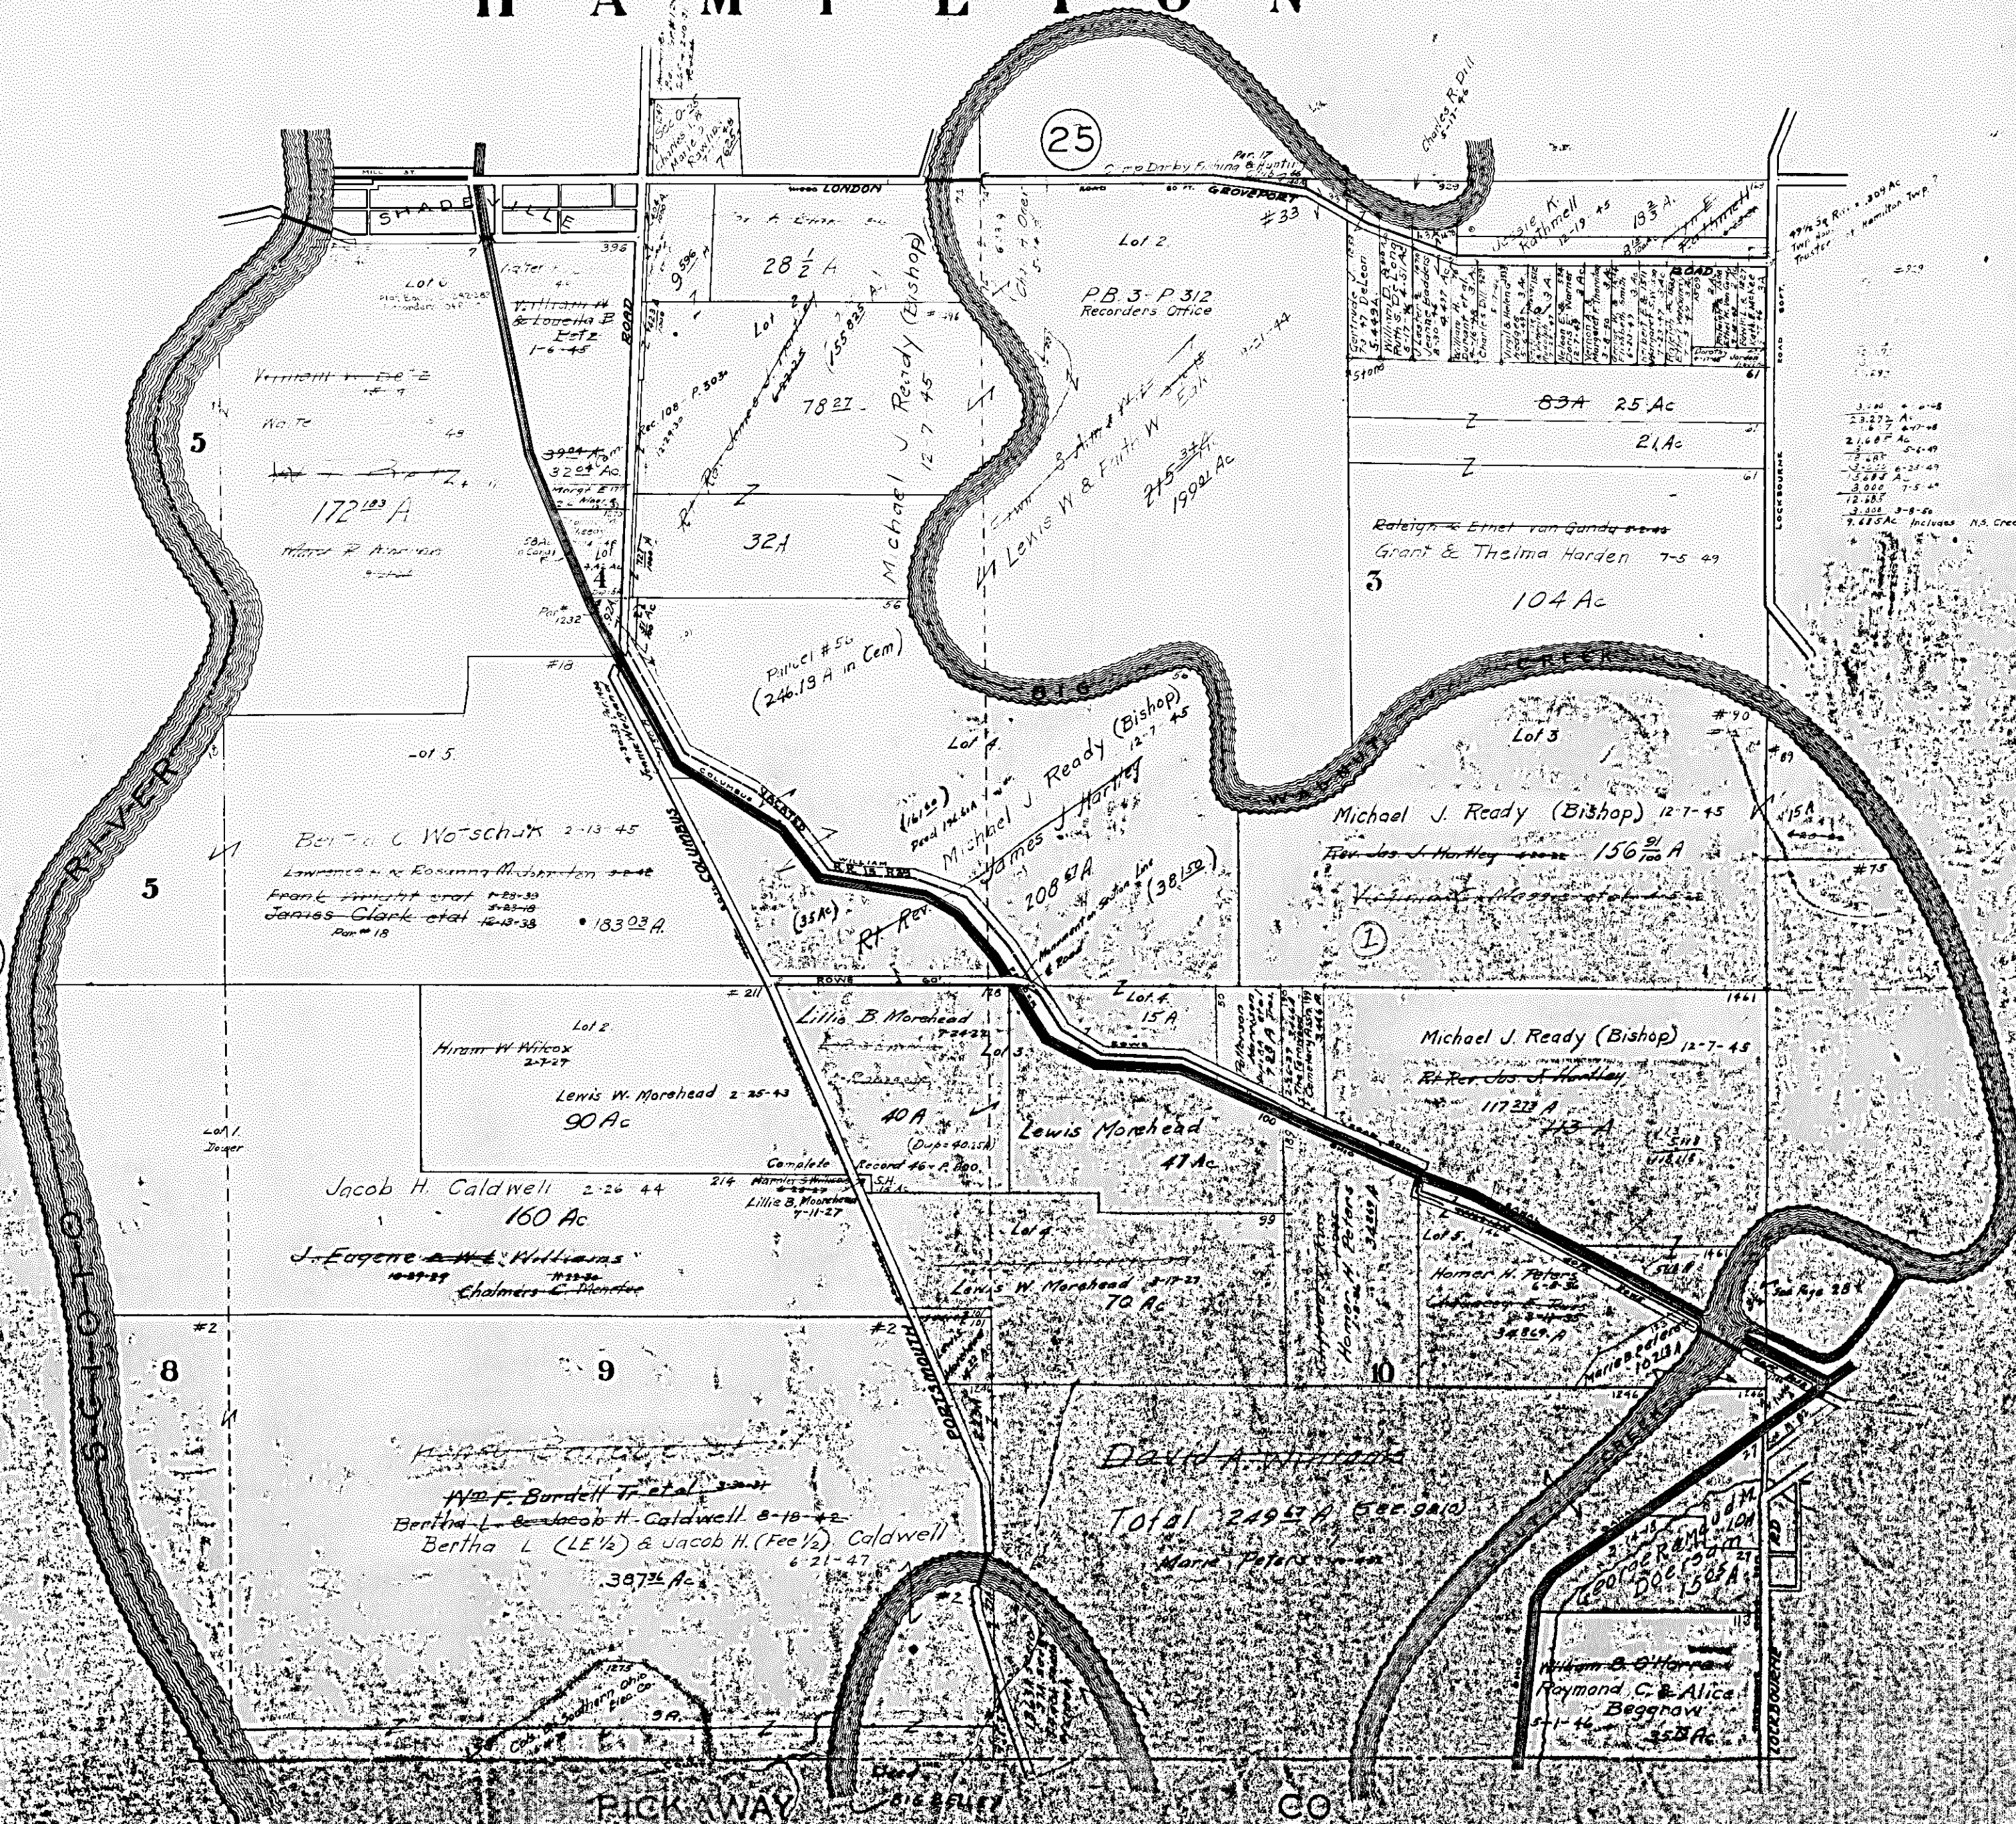

PICKAWAY

CO