


TOWNSHIP, R. 22, TP. 3.

SCALE ONE INCH = 500 FT.

26

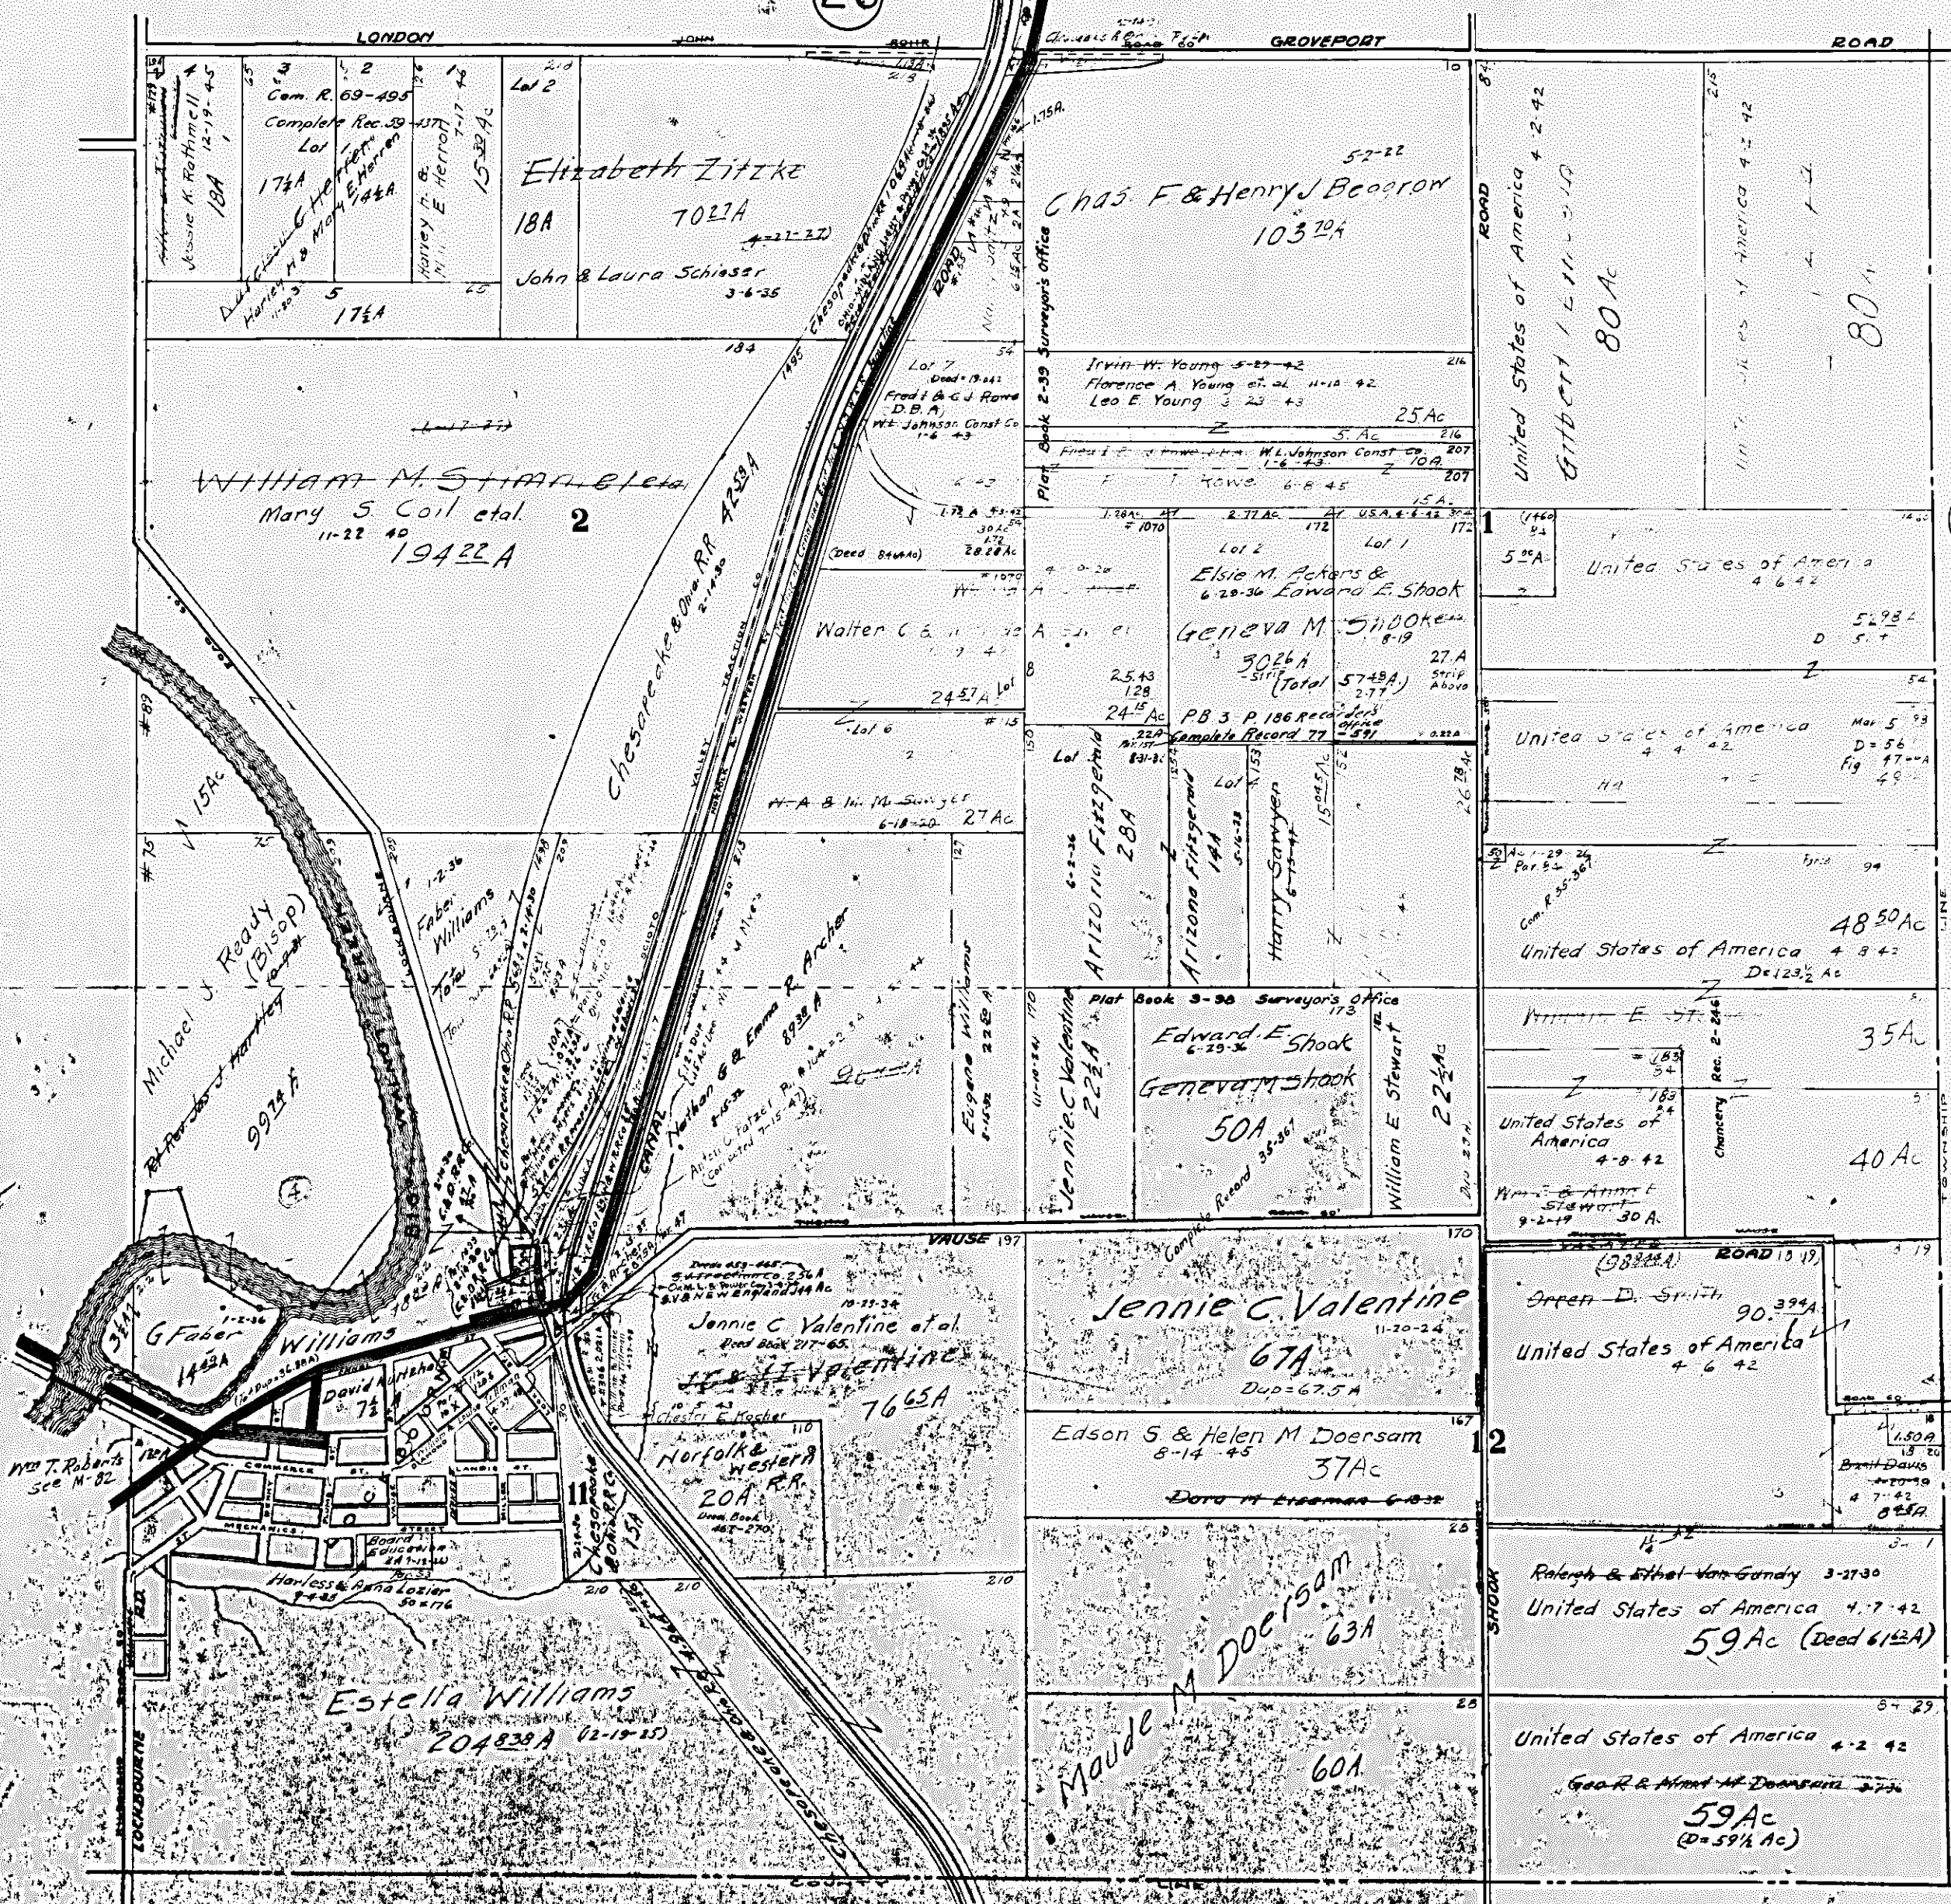

TWP 47

MADISON

49

Madison Tp. School District

PICKAWAY CO.