
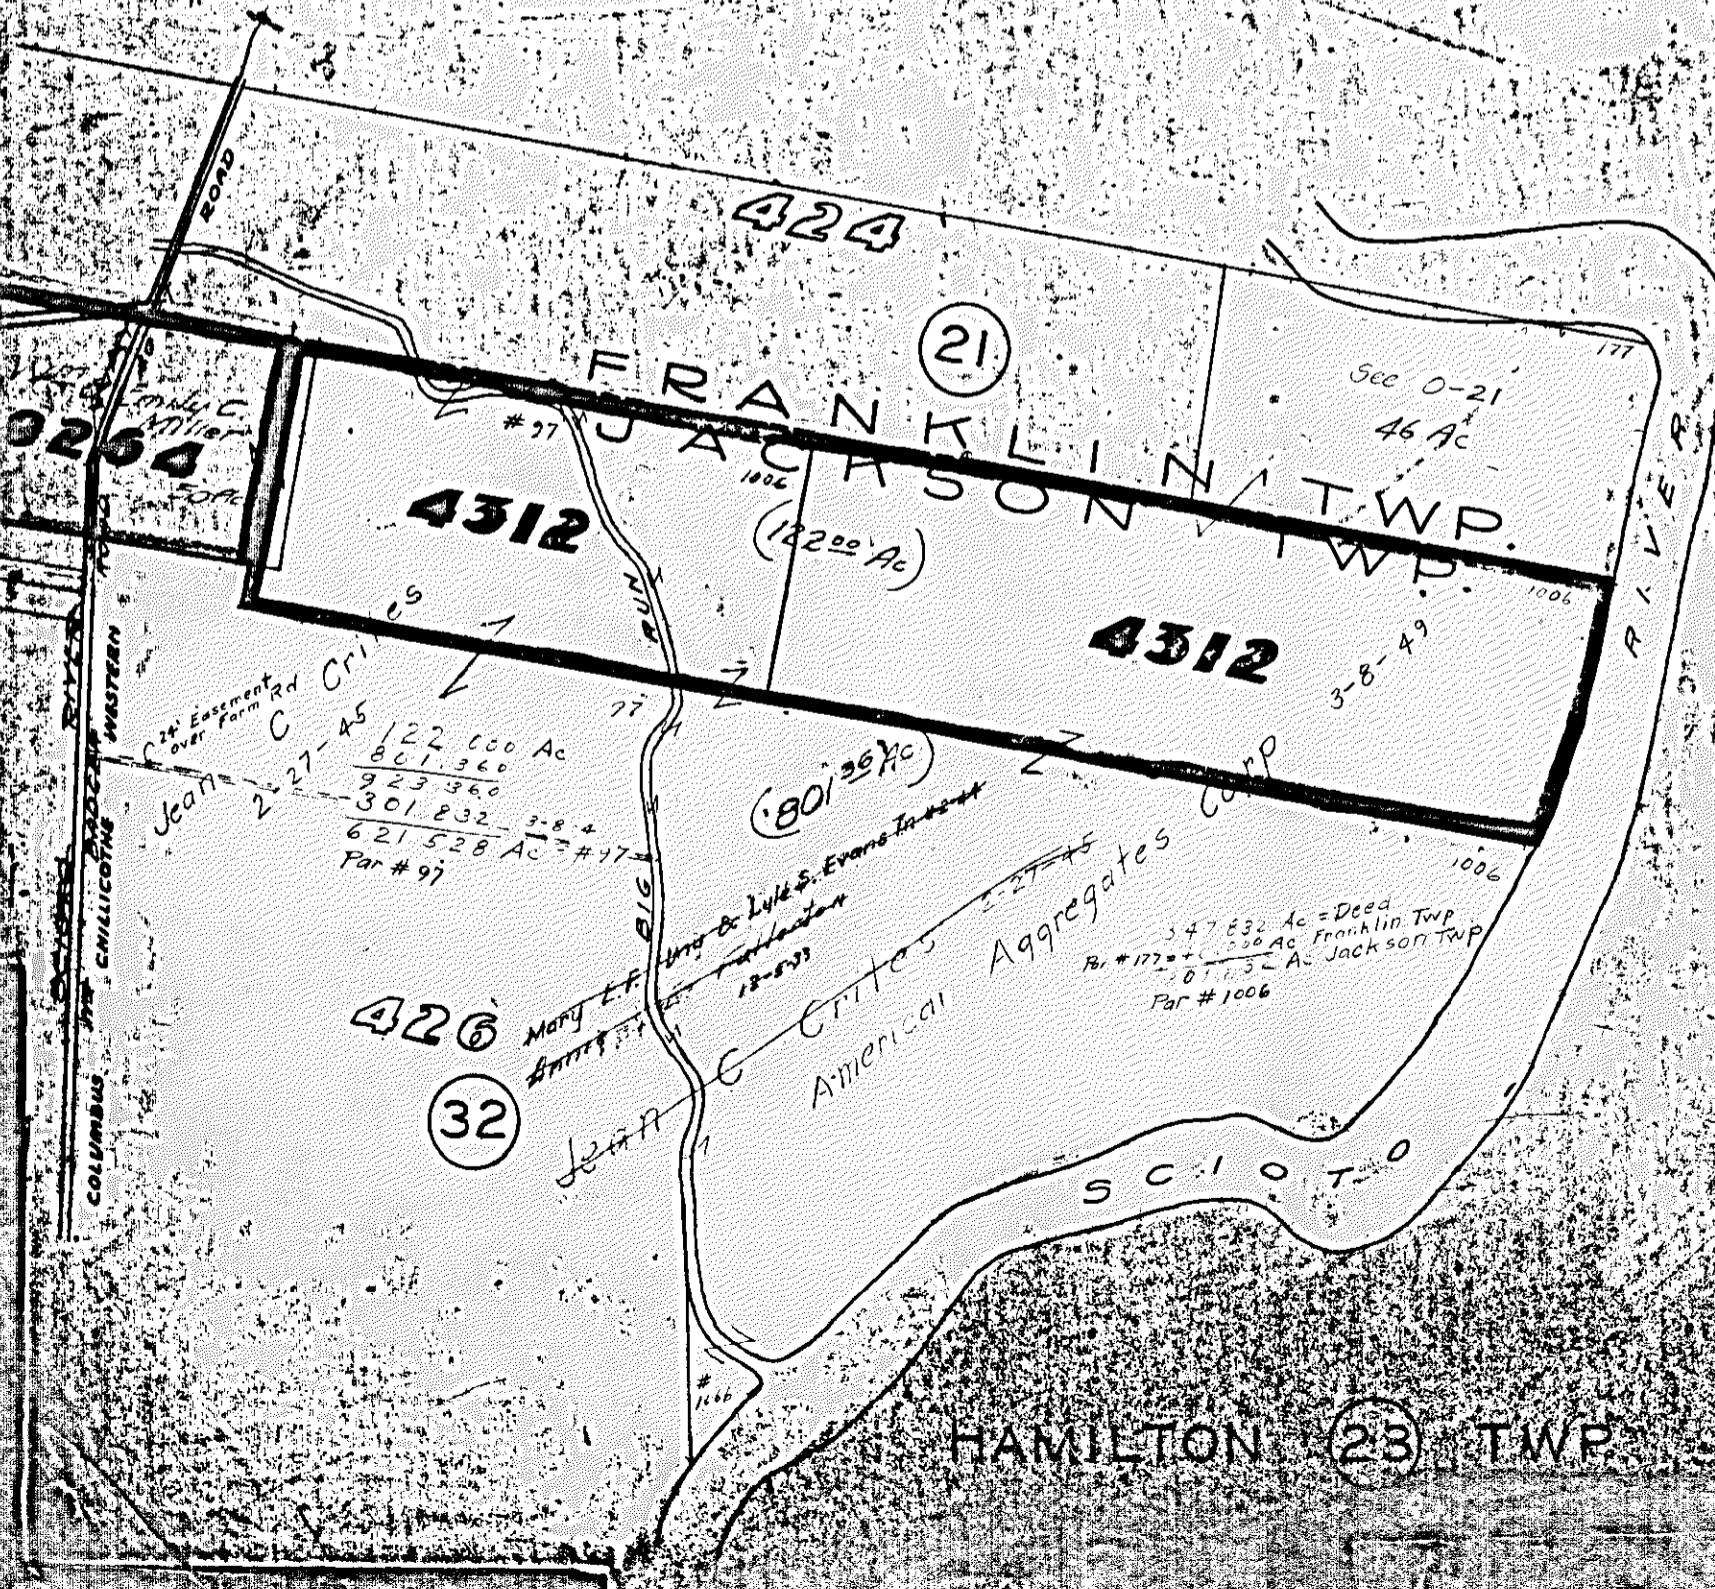


JACKSON TWP

30 Scale 1in = 500Ft.

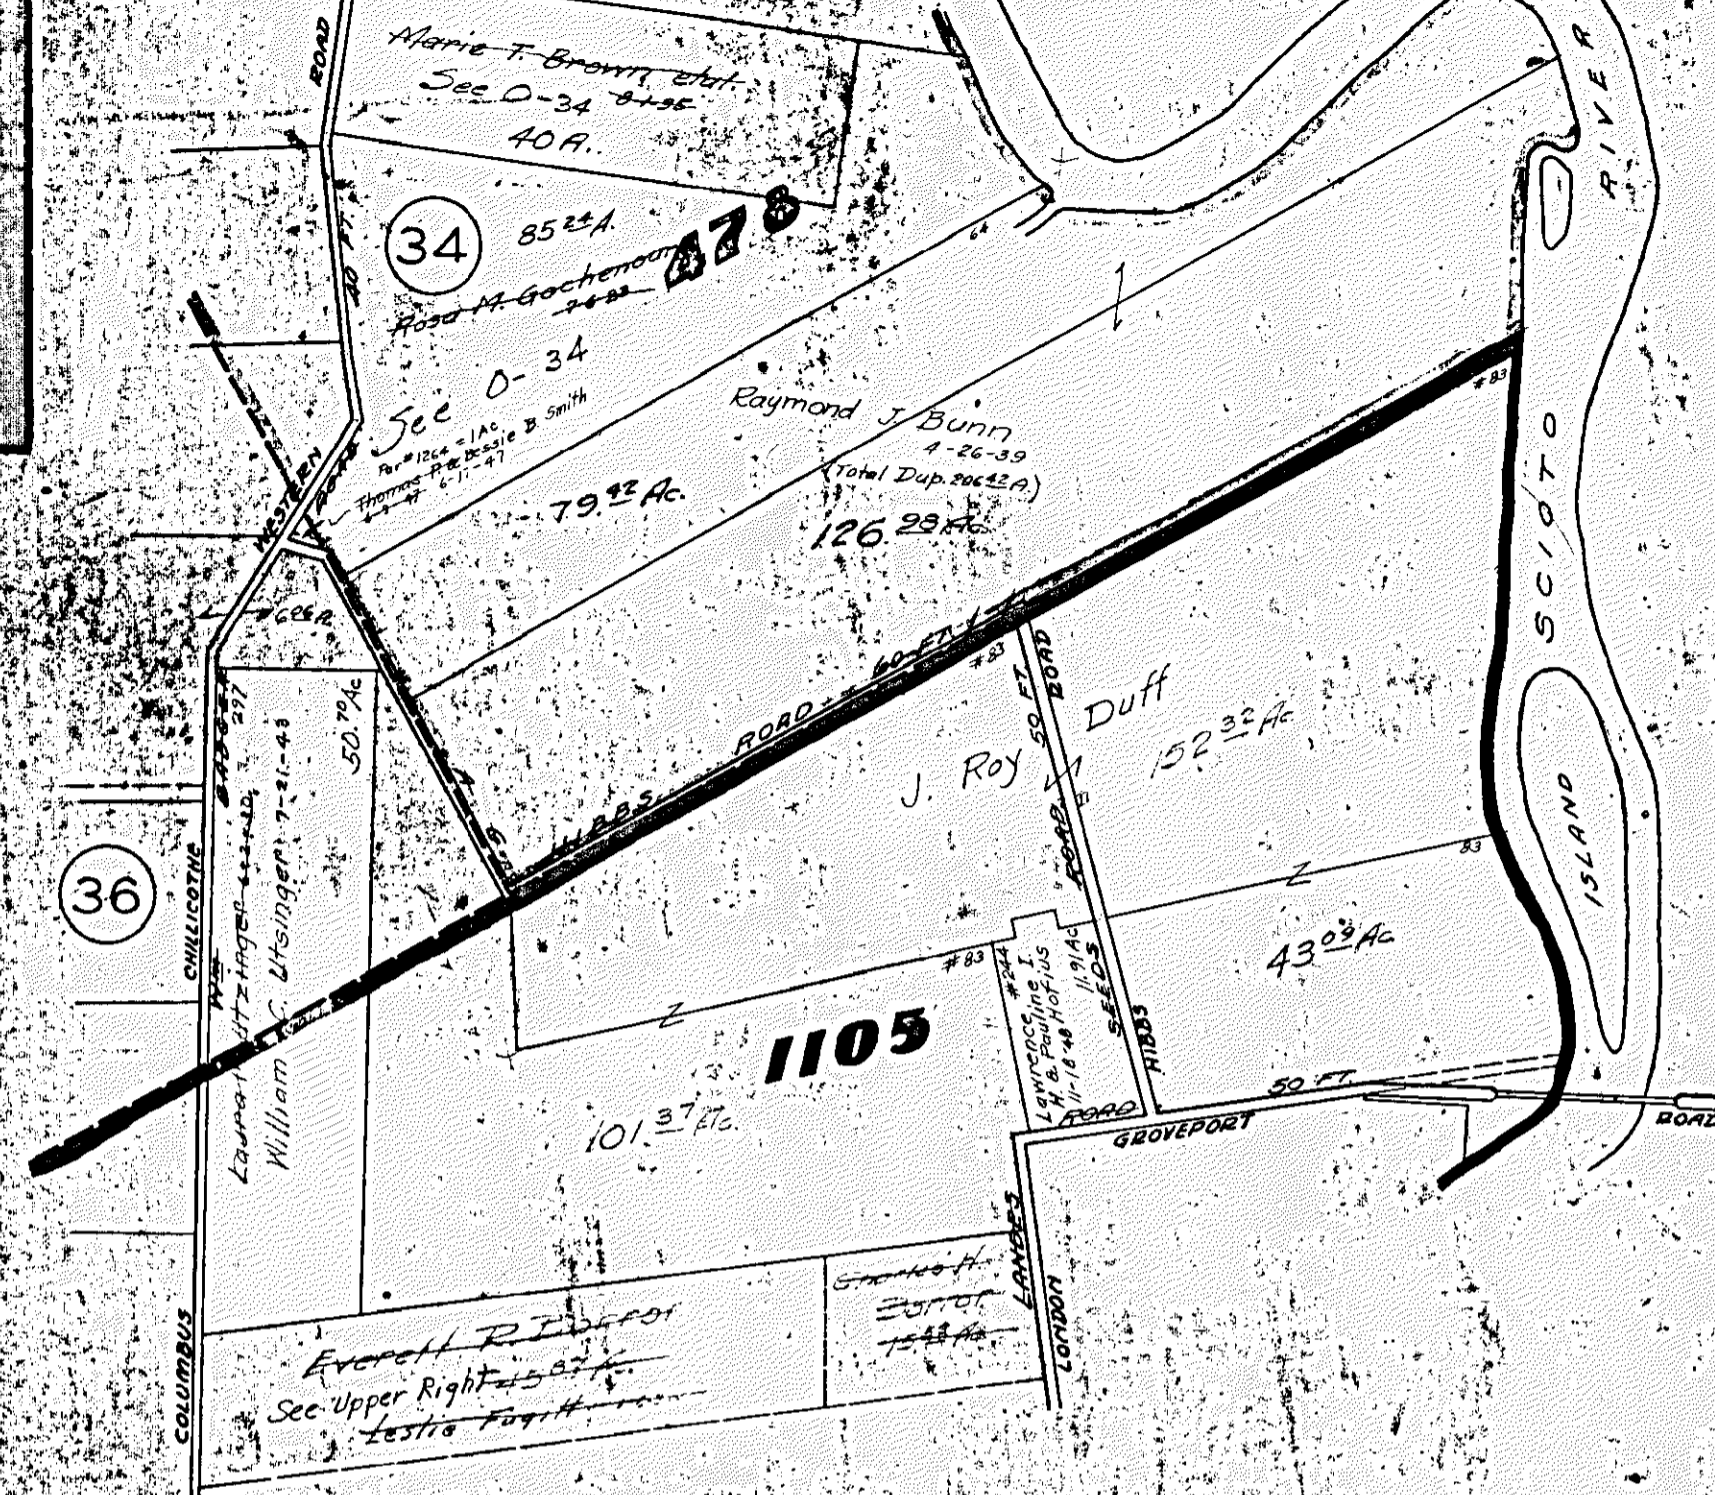









PICKAWAY COUNTY