



31

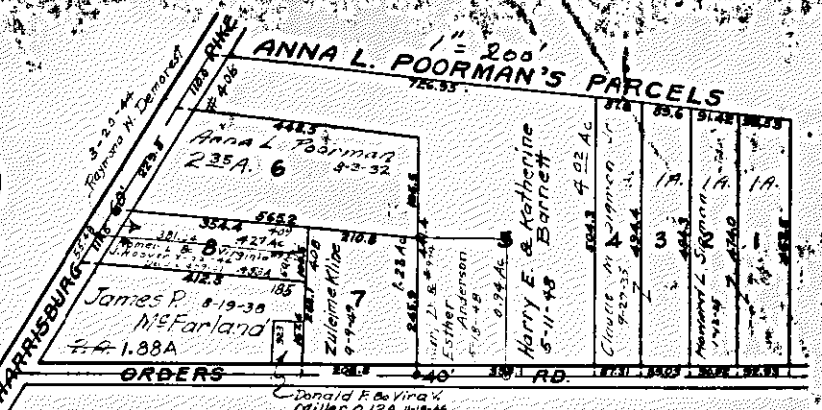

TWP. 83

84

34

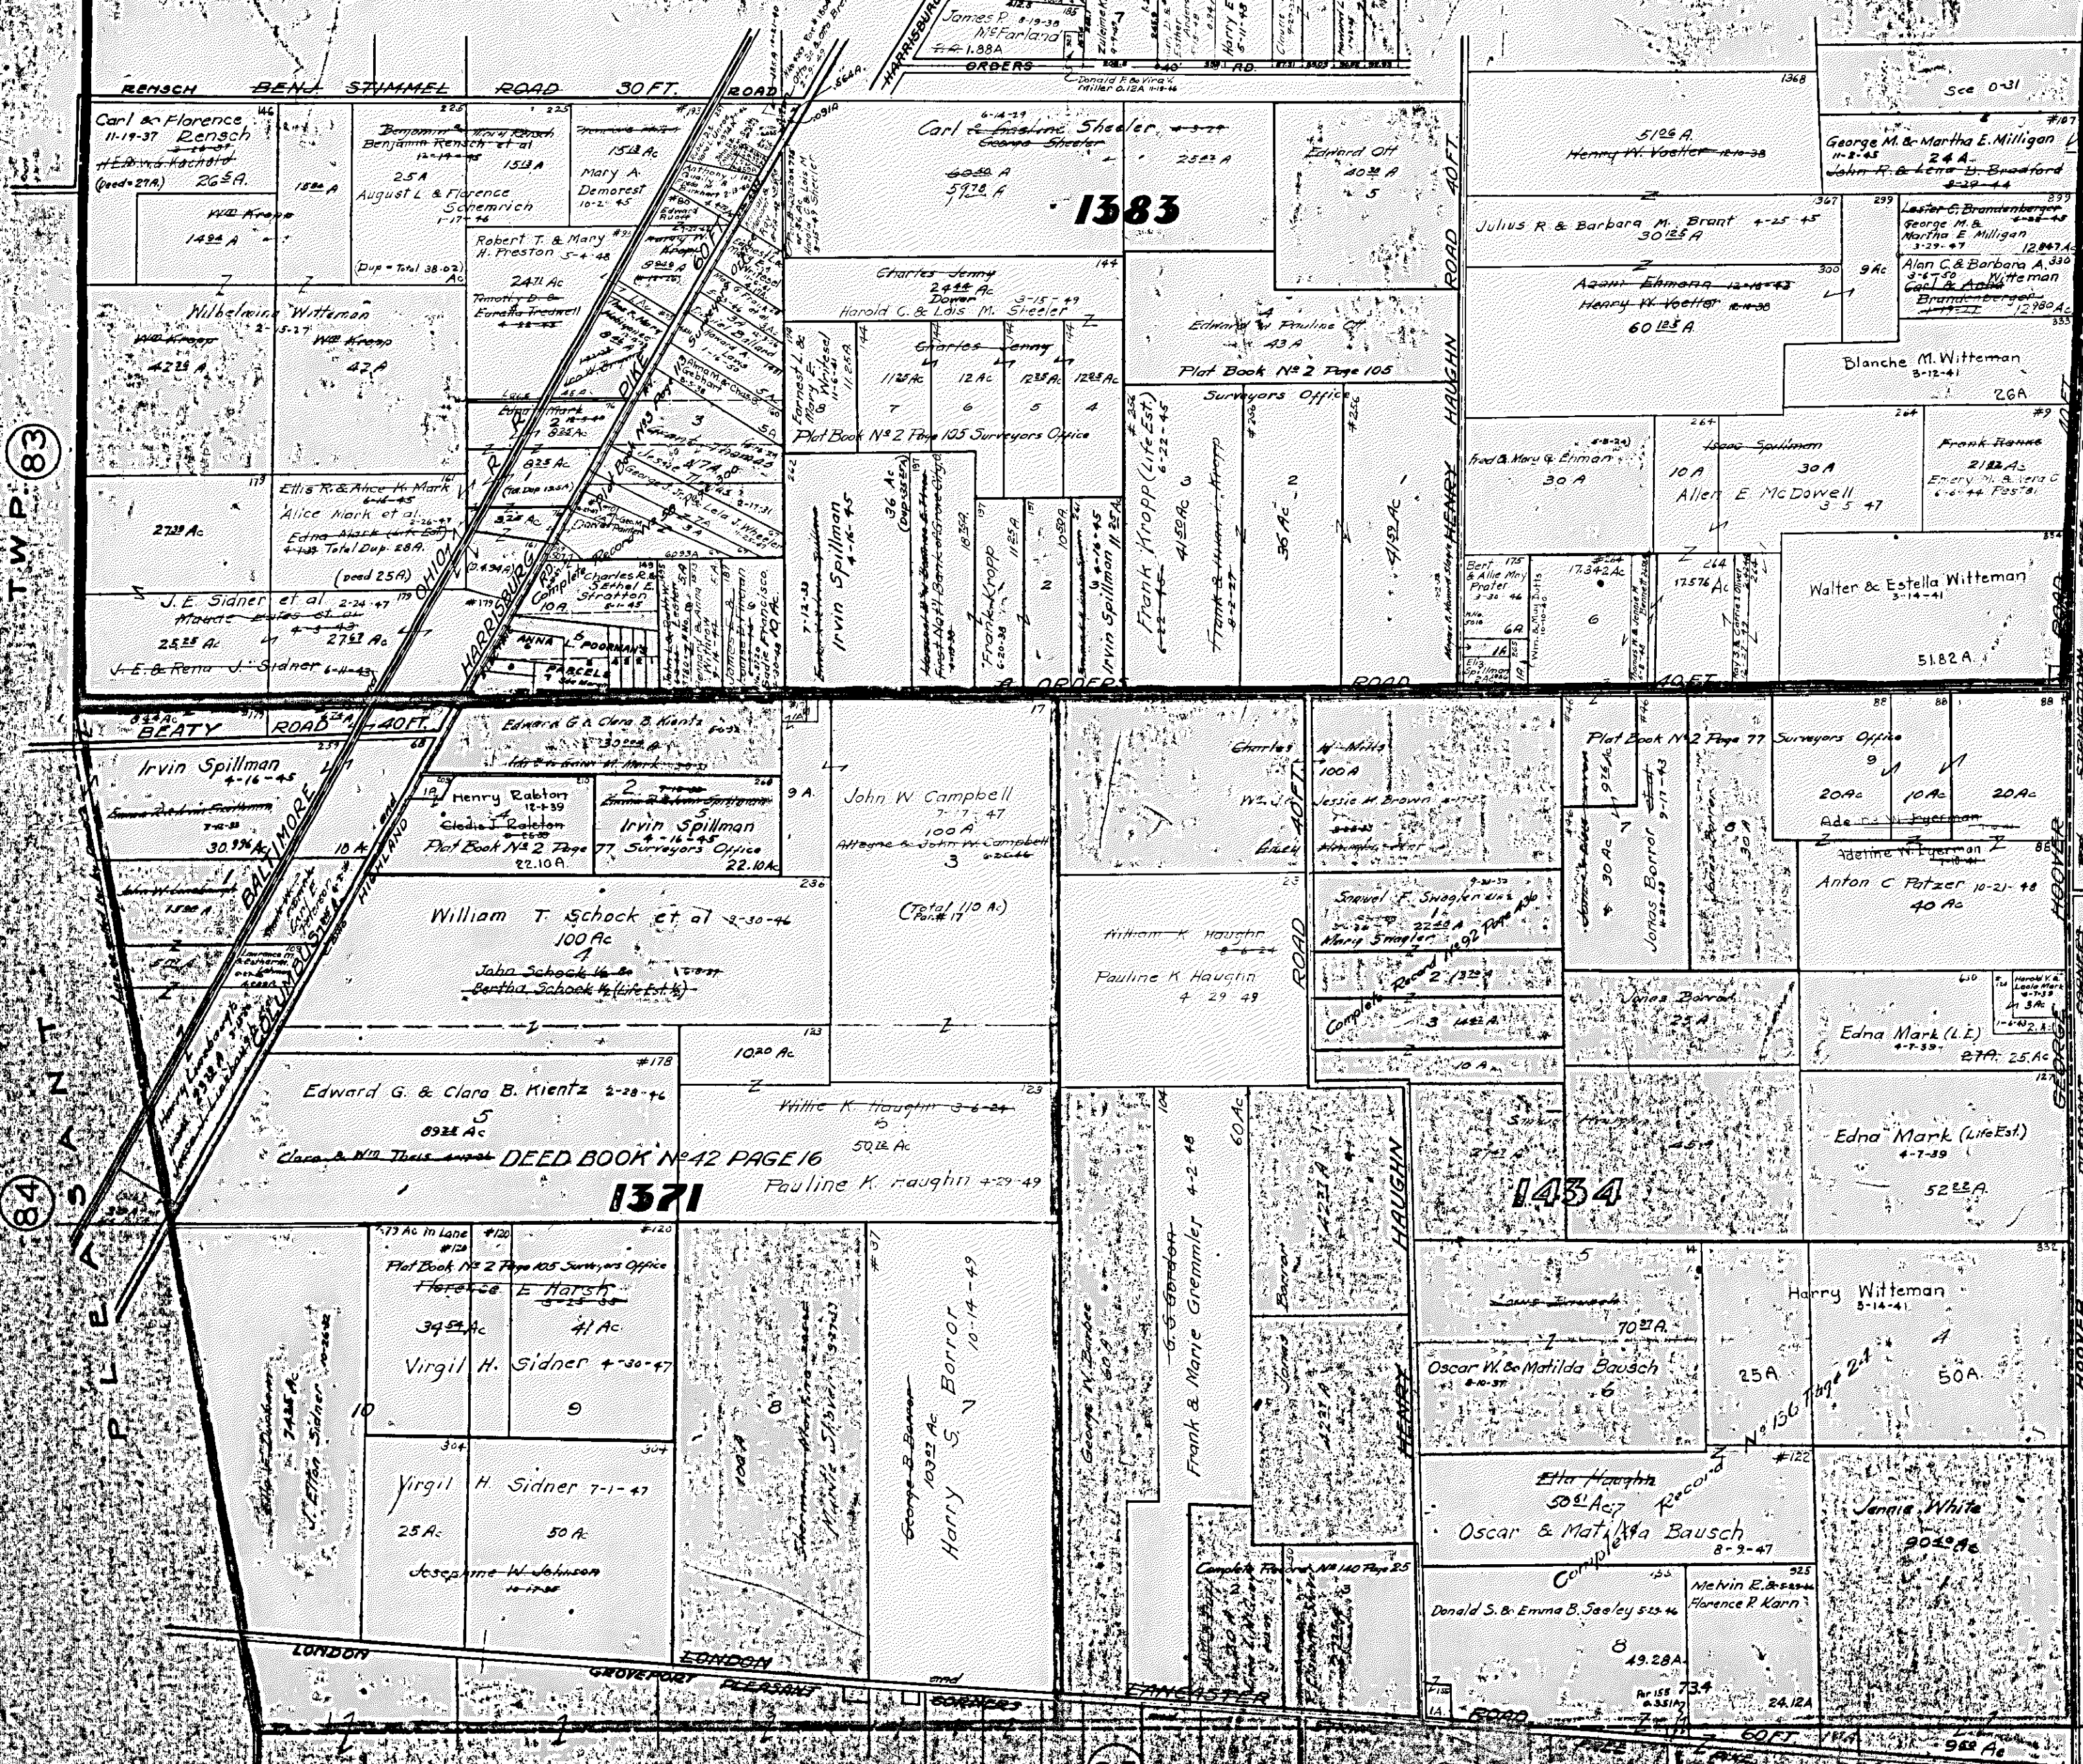

1383

1371

1434

1365