


Catherine Taylor
Pat # 5905 = 1A

P E R R Y T R

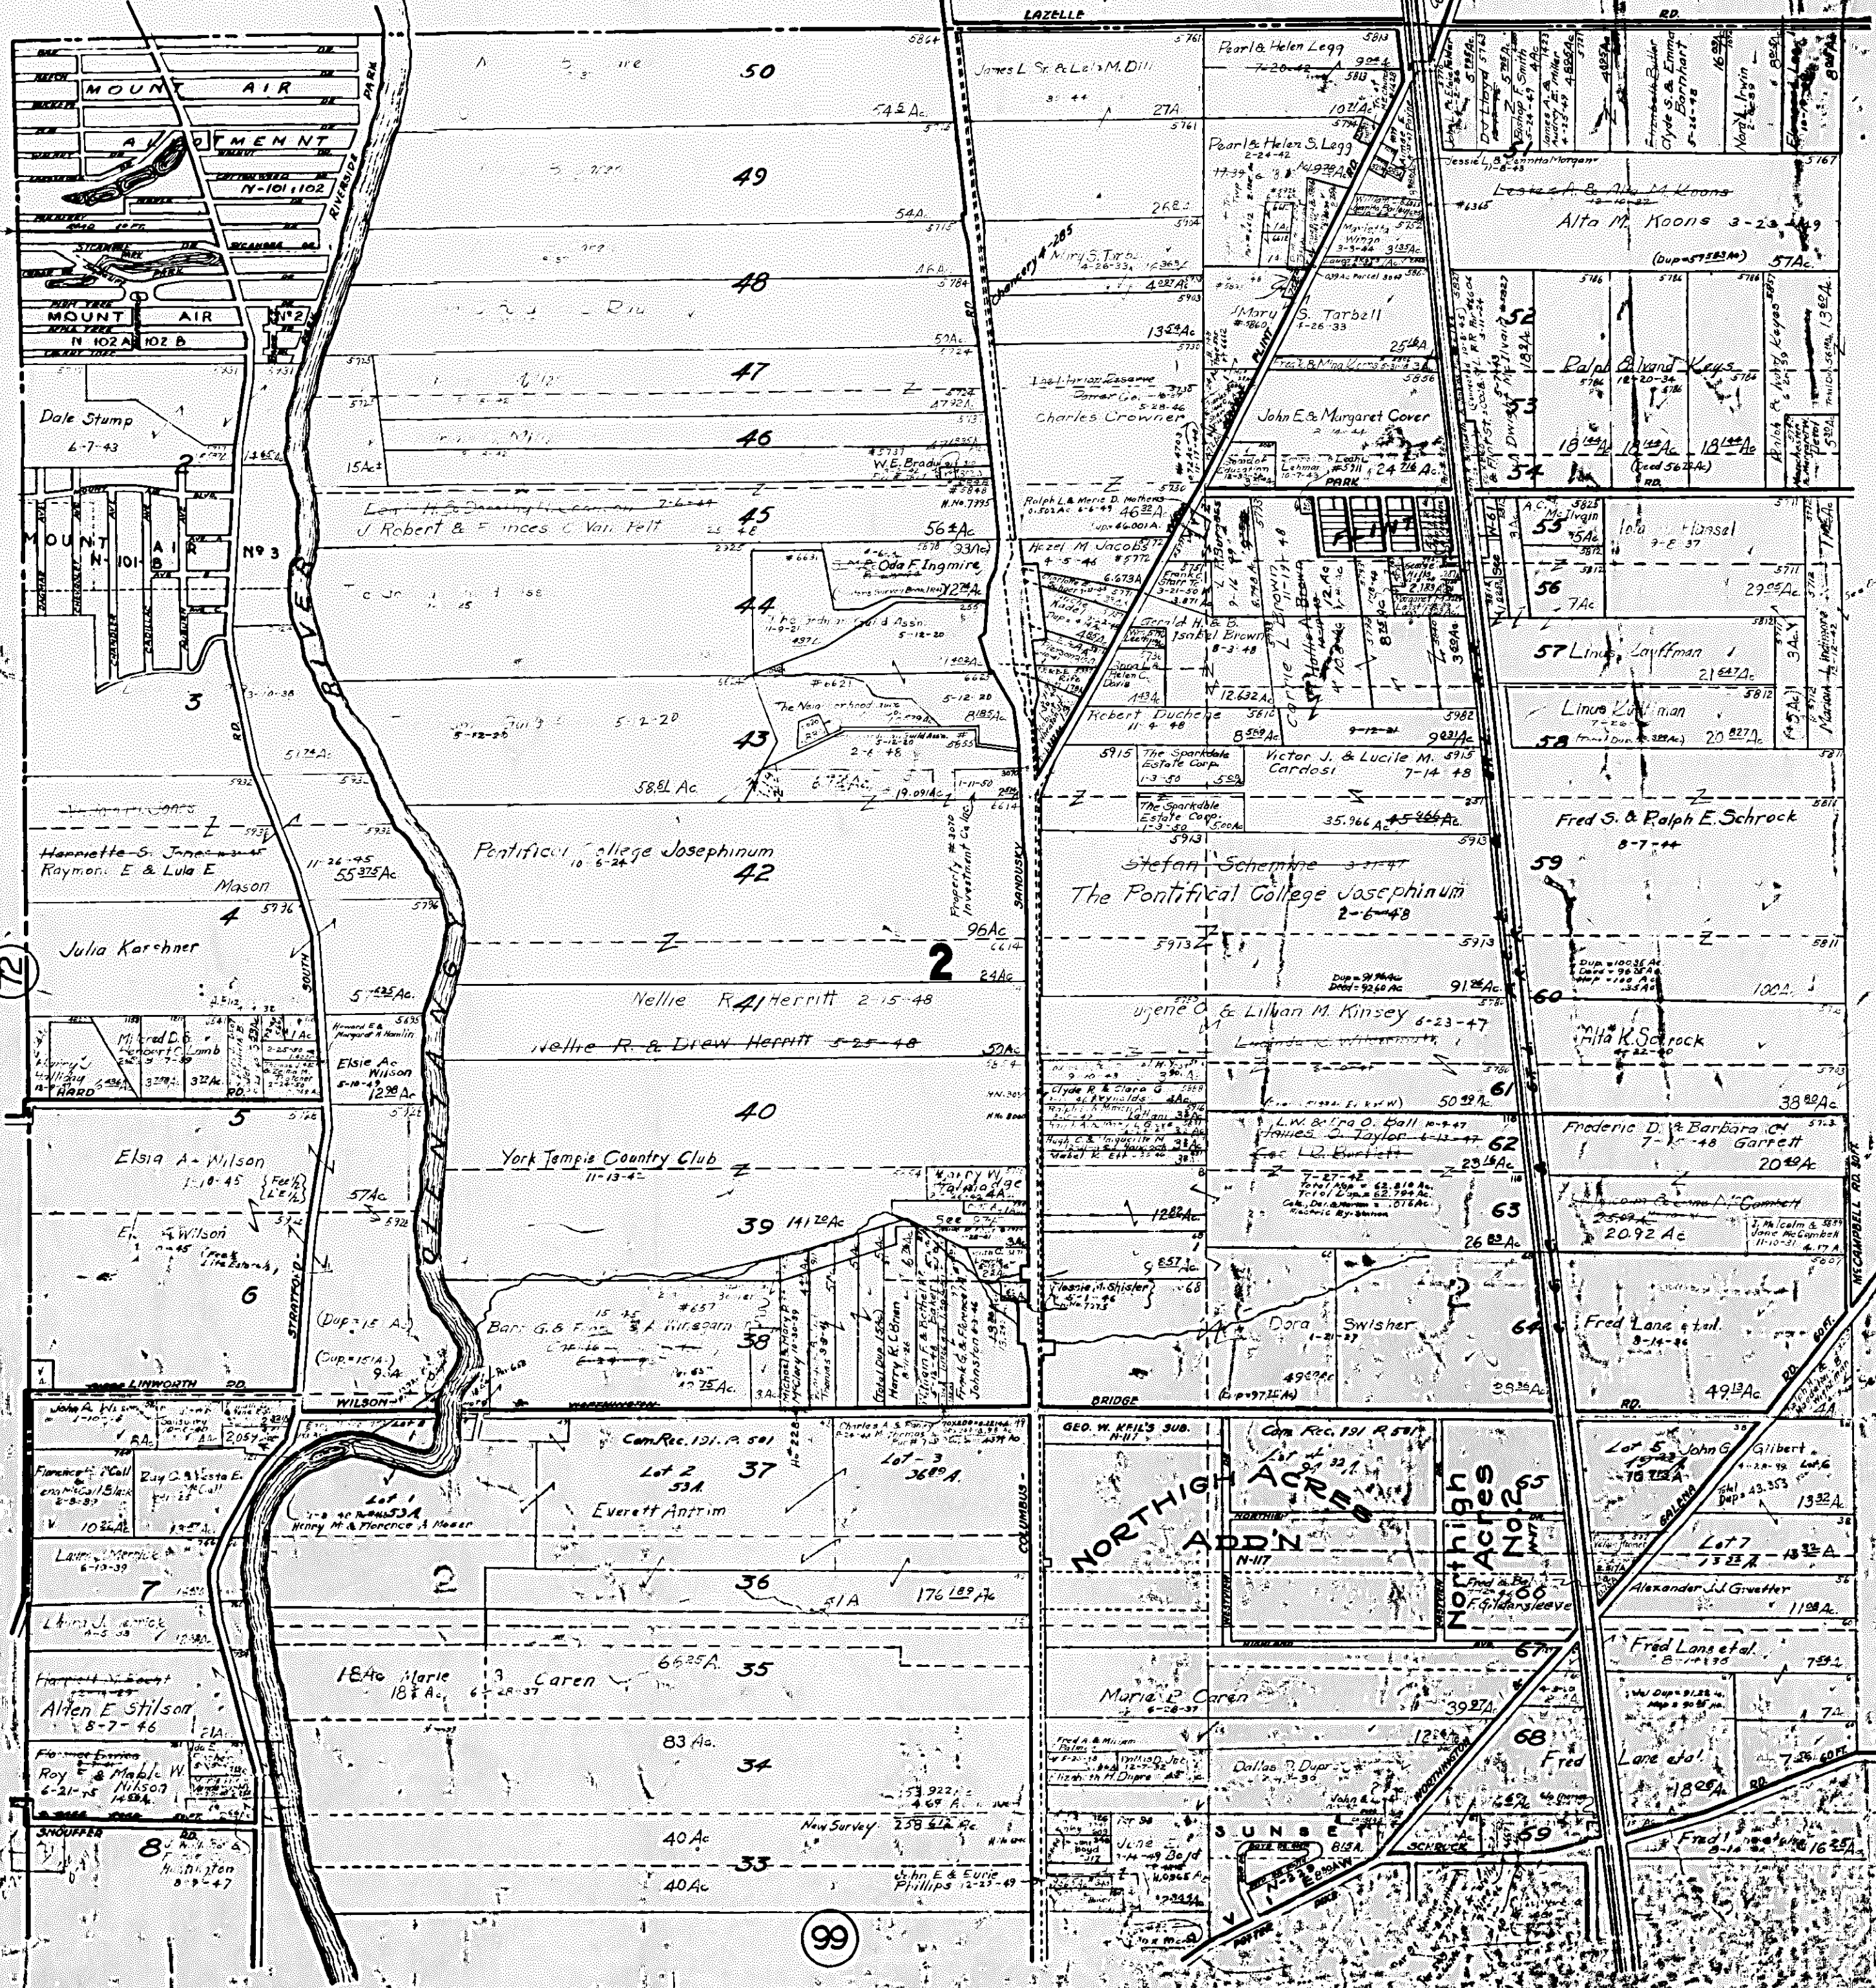

(72)

(99)

NORTH HIGH ACRES
ADD'N
N-17

NORTH HIGH ACRES
N-17

DELAWARE CO. SD.
 WORTHINGTON SD.
 N.W. QR.
SHARON TP.
 R. 10 TP. 2
 SCALE 1 INCH = 500 FT.