


T O W N S H I P, R. 22, TP. 4.

SCALE ONE INCH = 500 FT.

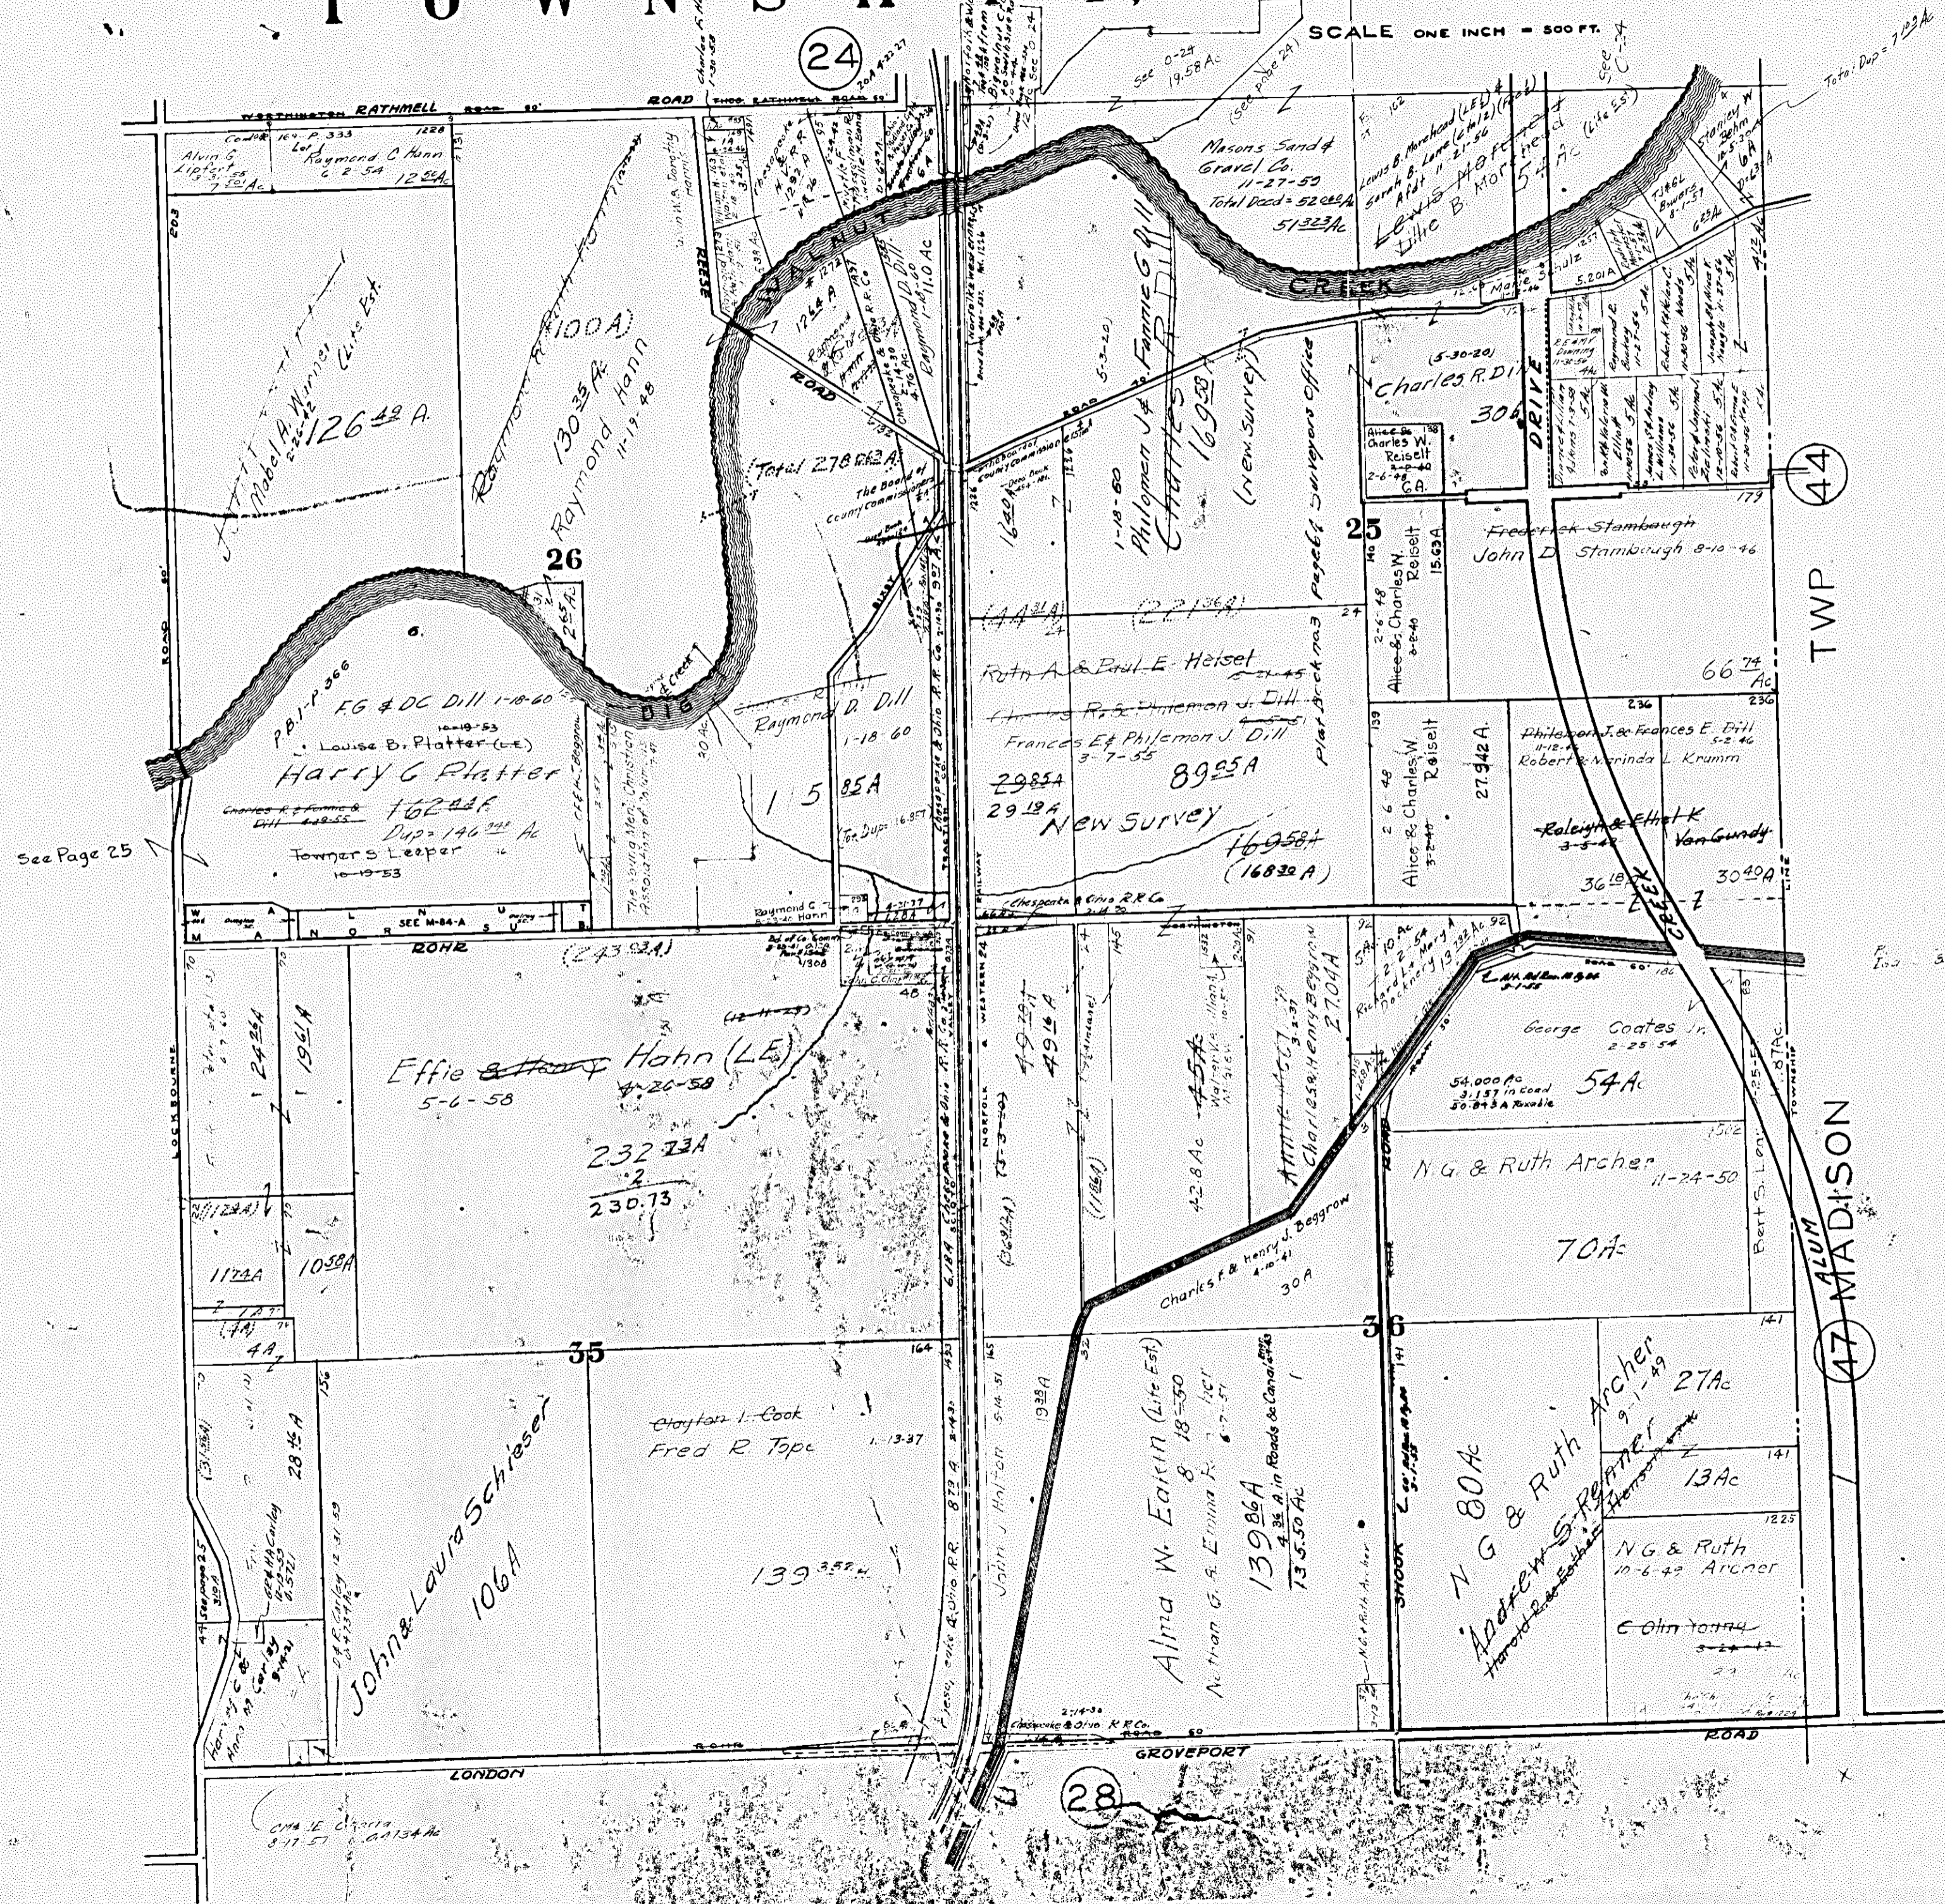

See Page 25

TWP 44

47 MADISON

28