


JACKSON TWP

Scale 1 in = 500 Ft.

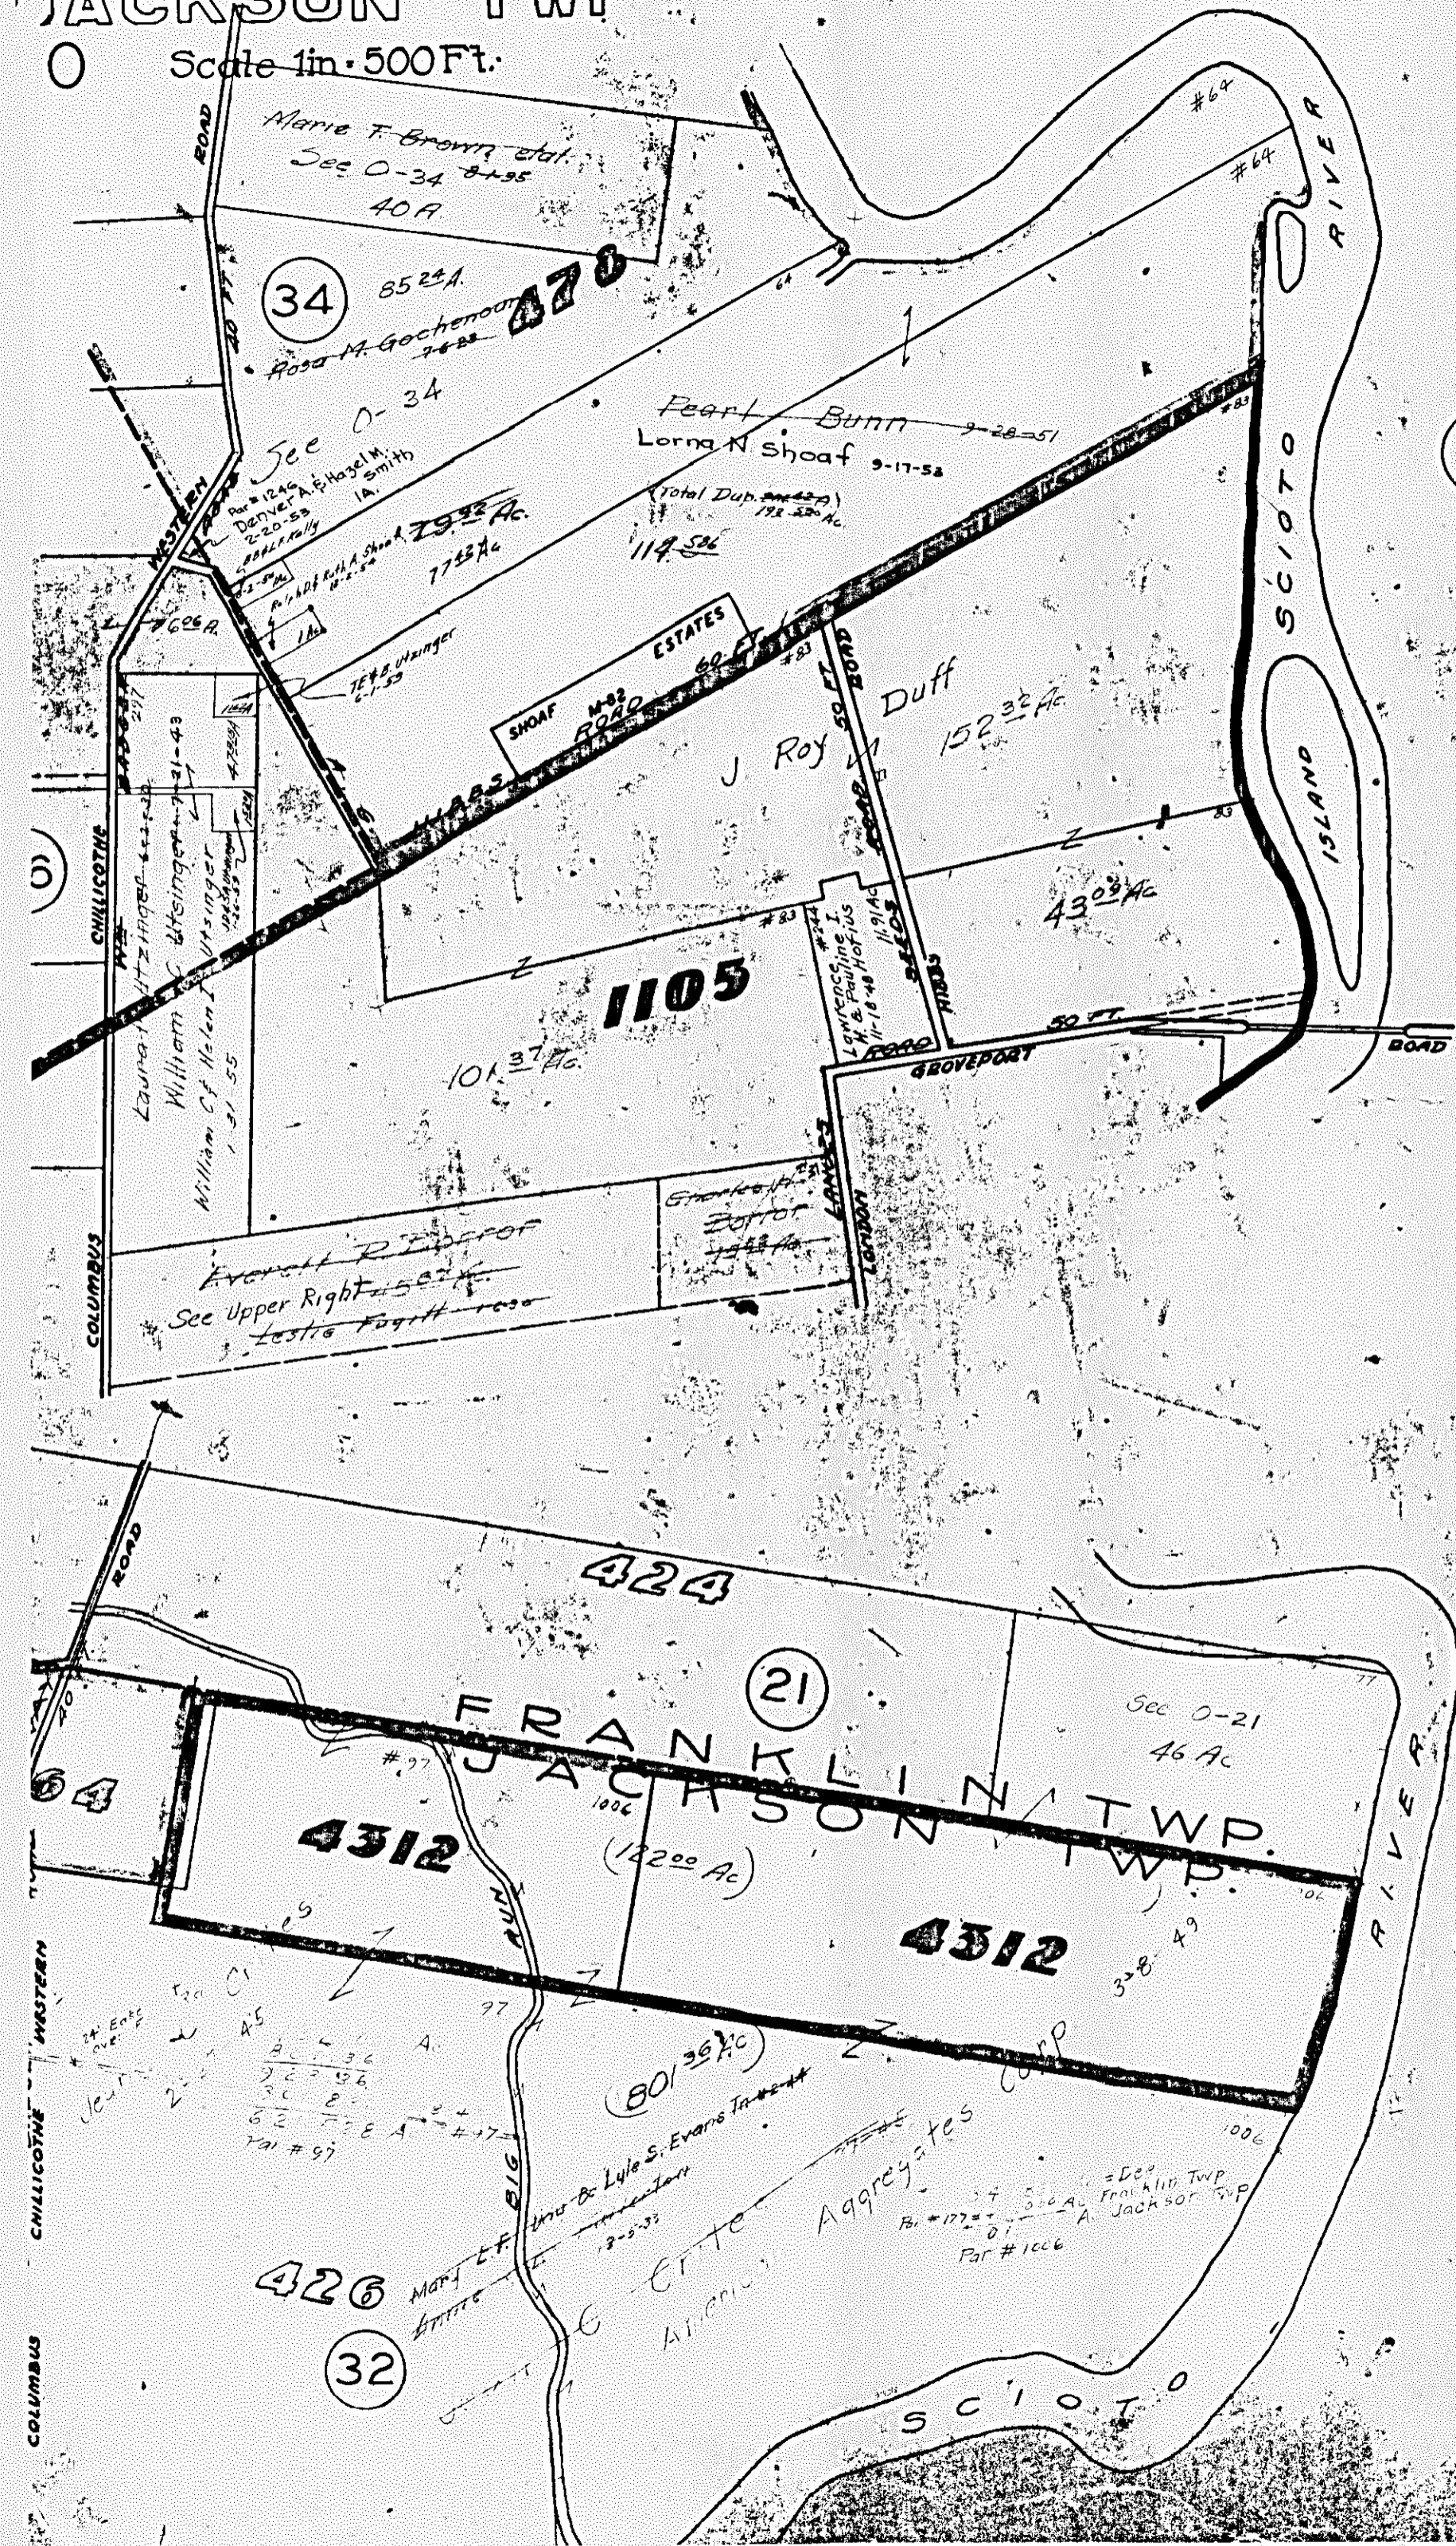

HAMILTON 25 TWP. HAMILTON 27 TWP. MARION 55 TWP.

