


103

MADISON TP.
R. 21 TP. II

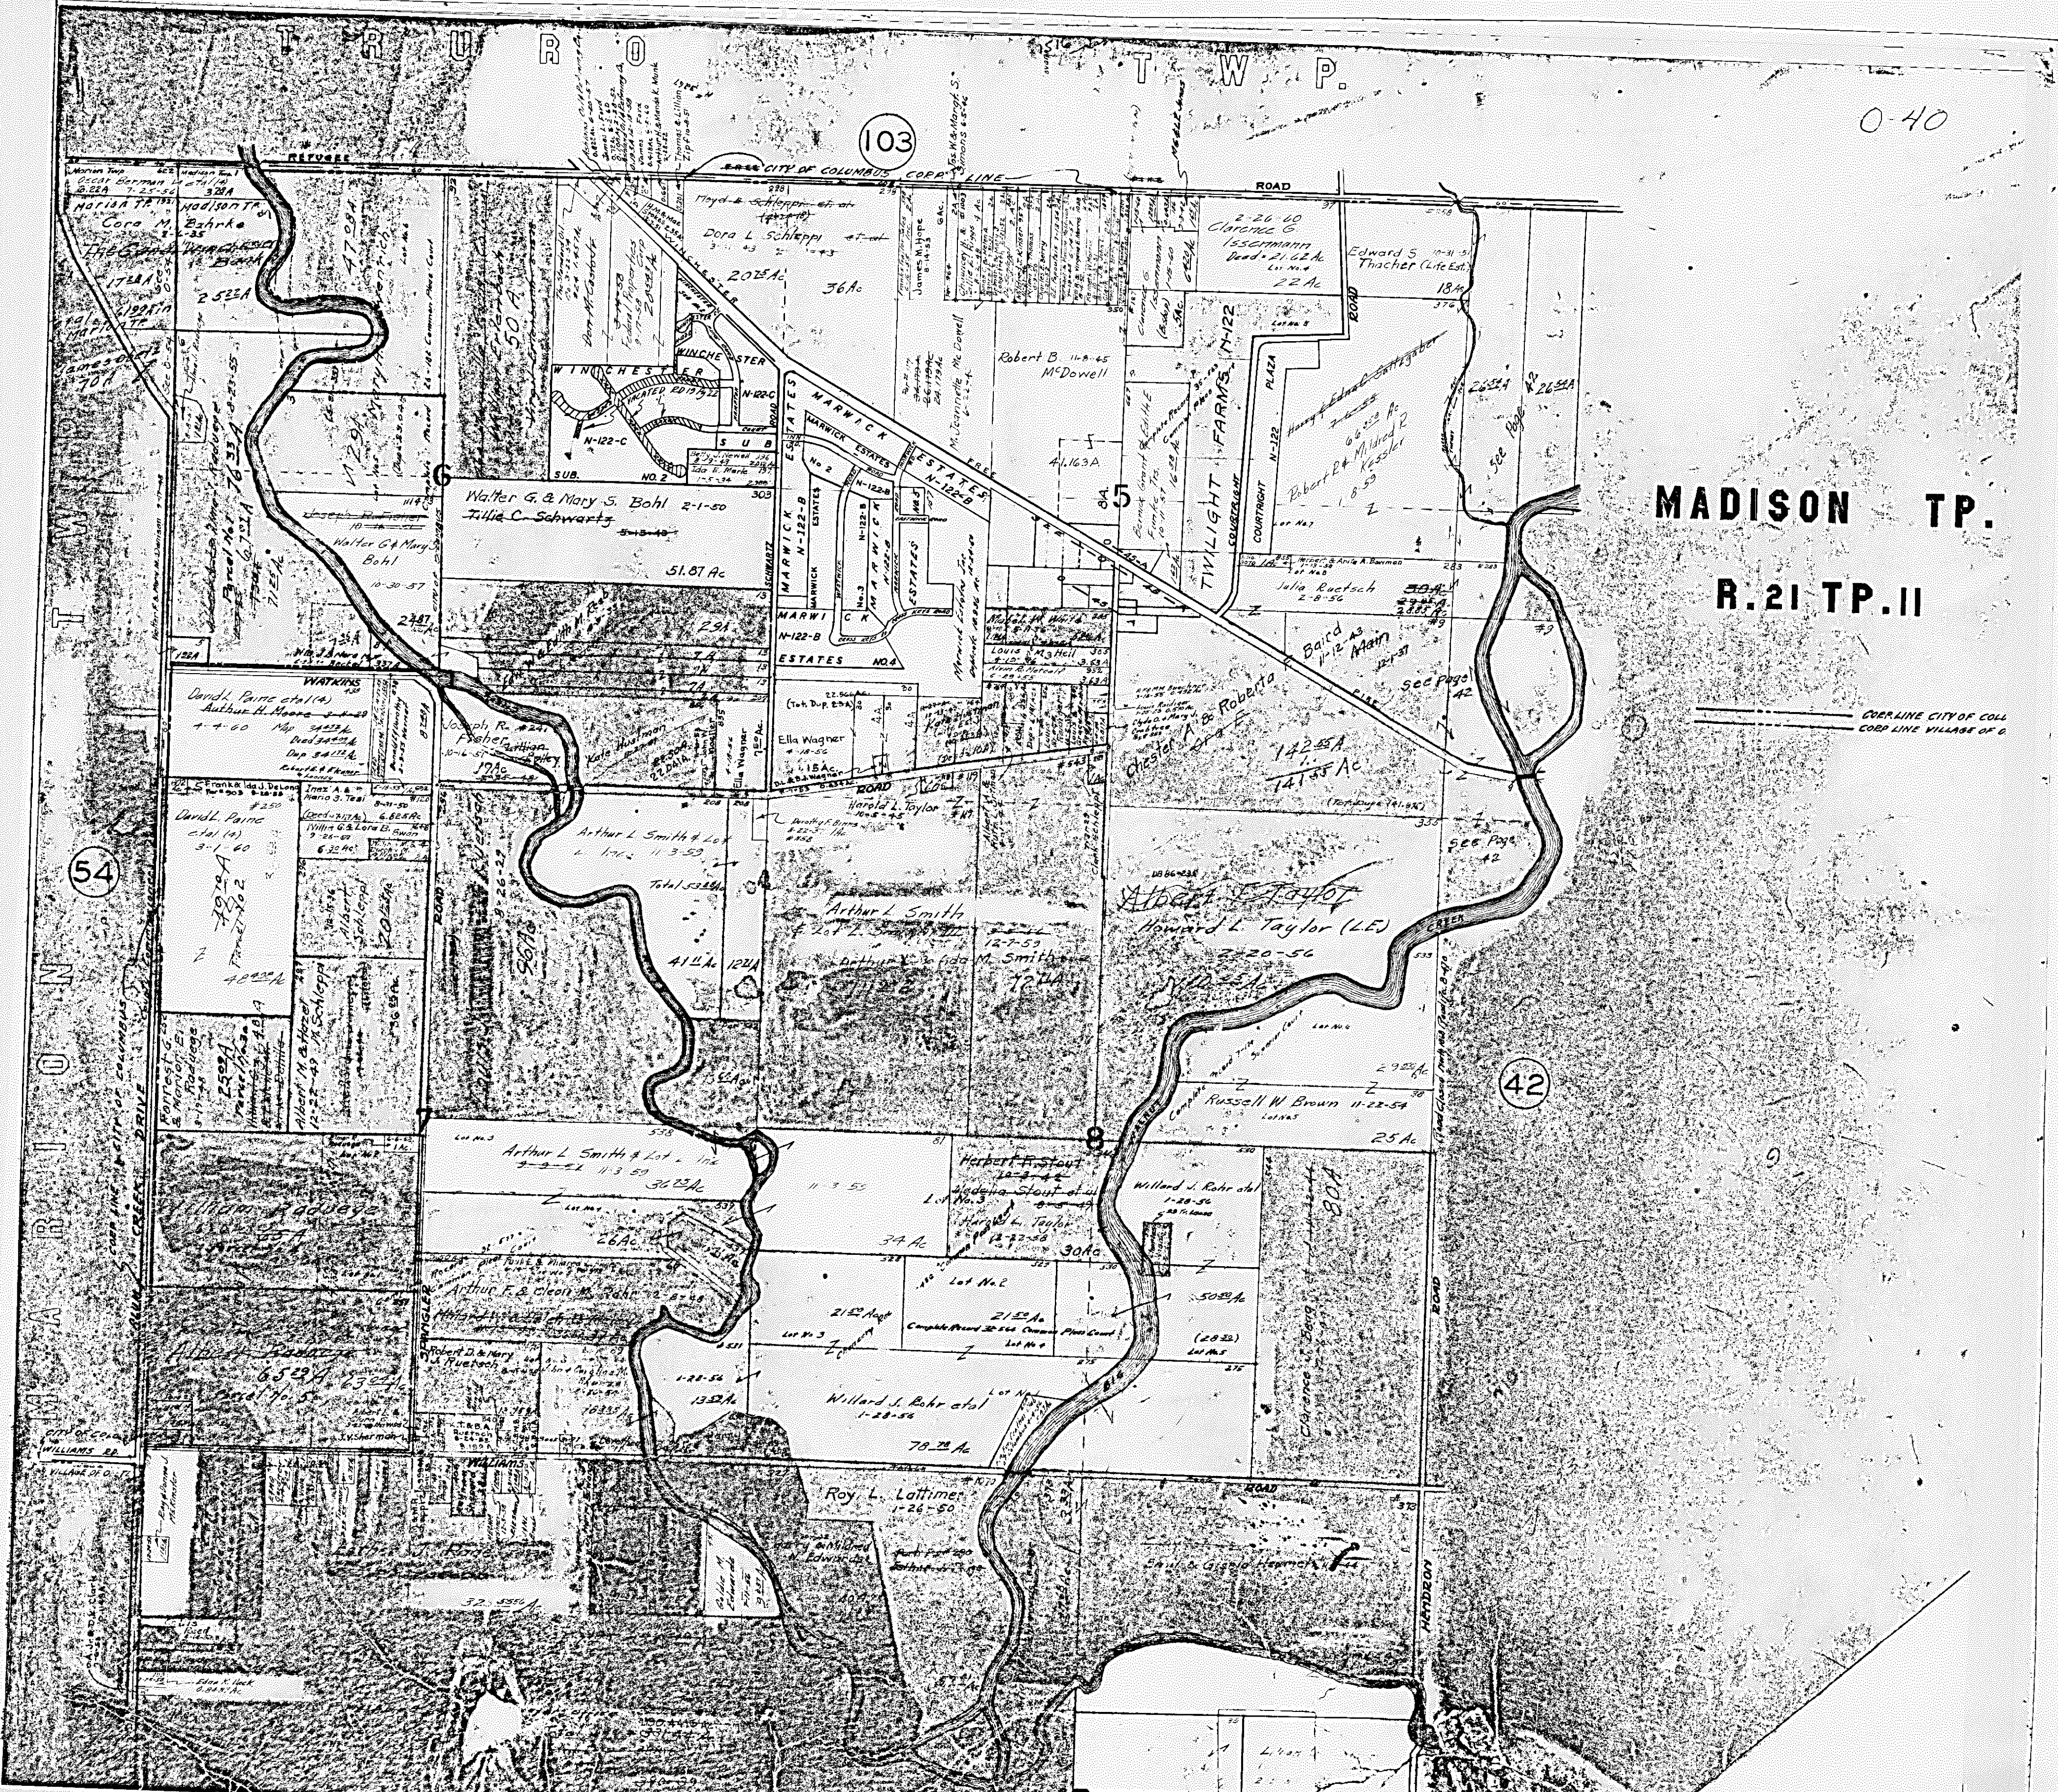

54

42

CORNER LINE CITY OF COLUMBUS
CORNER LINE VILLAGE OF C.