


MADISON TP. (see page 47)
R. 21 TP. 11-10

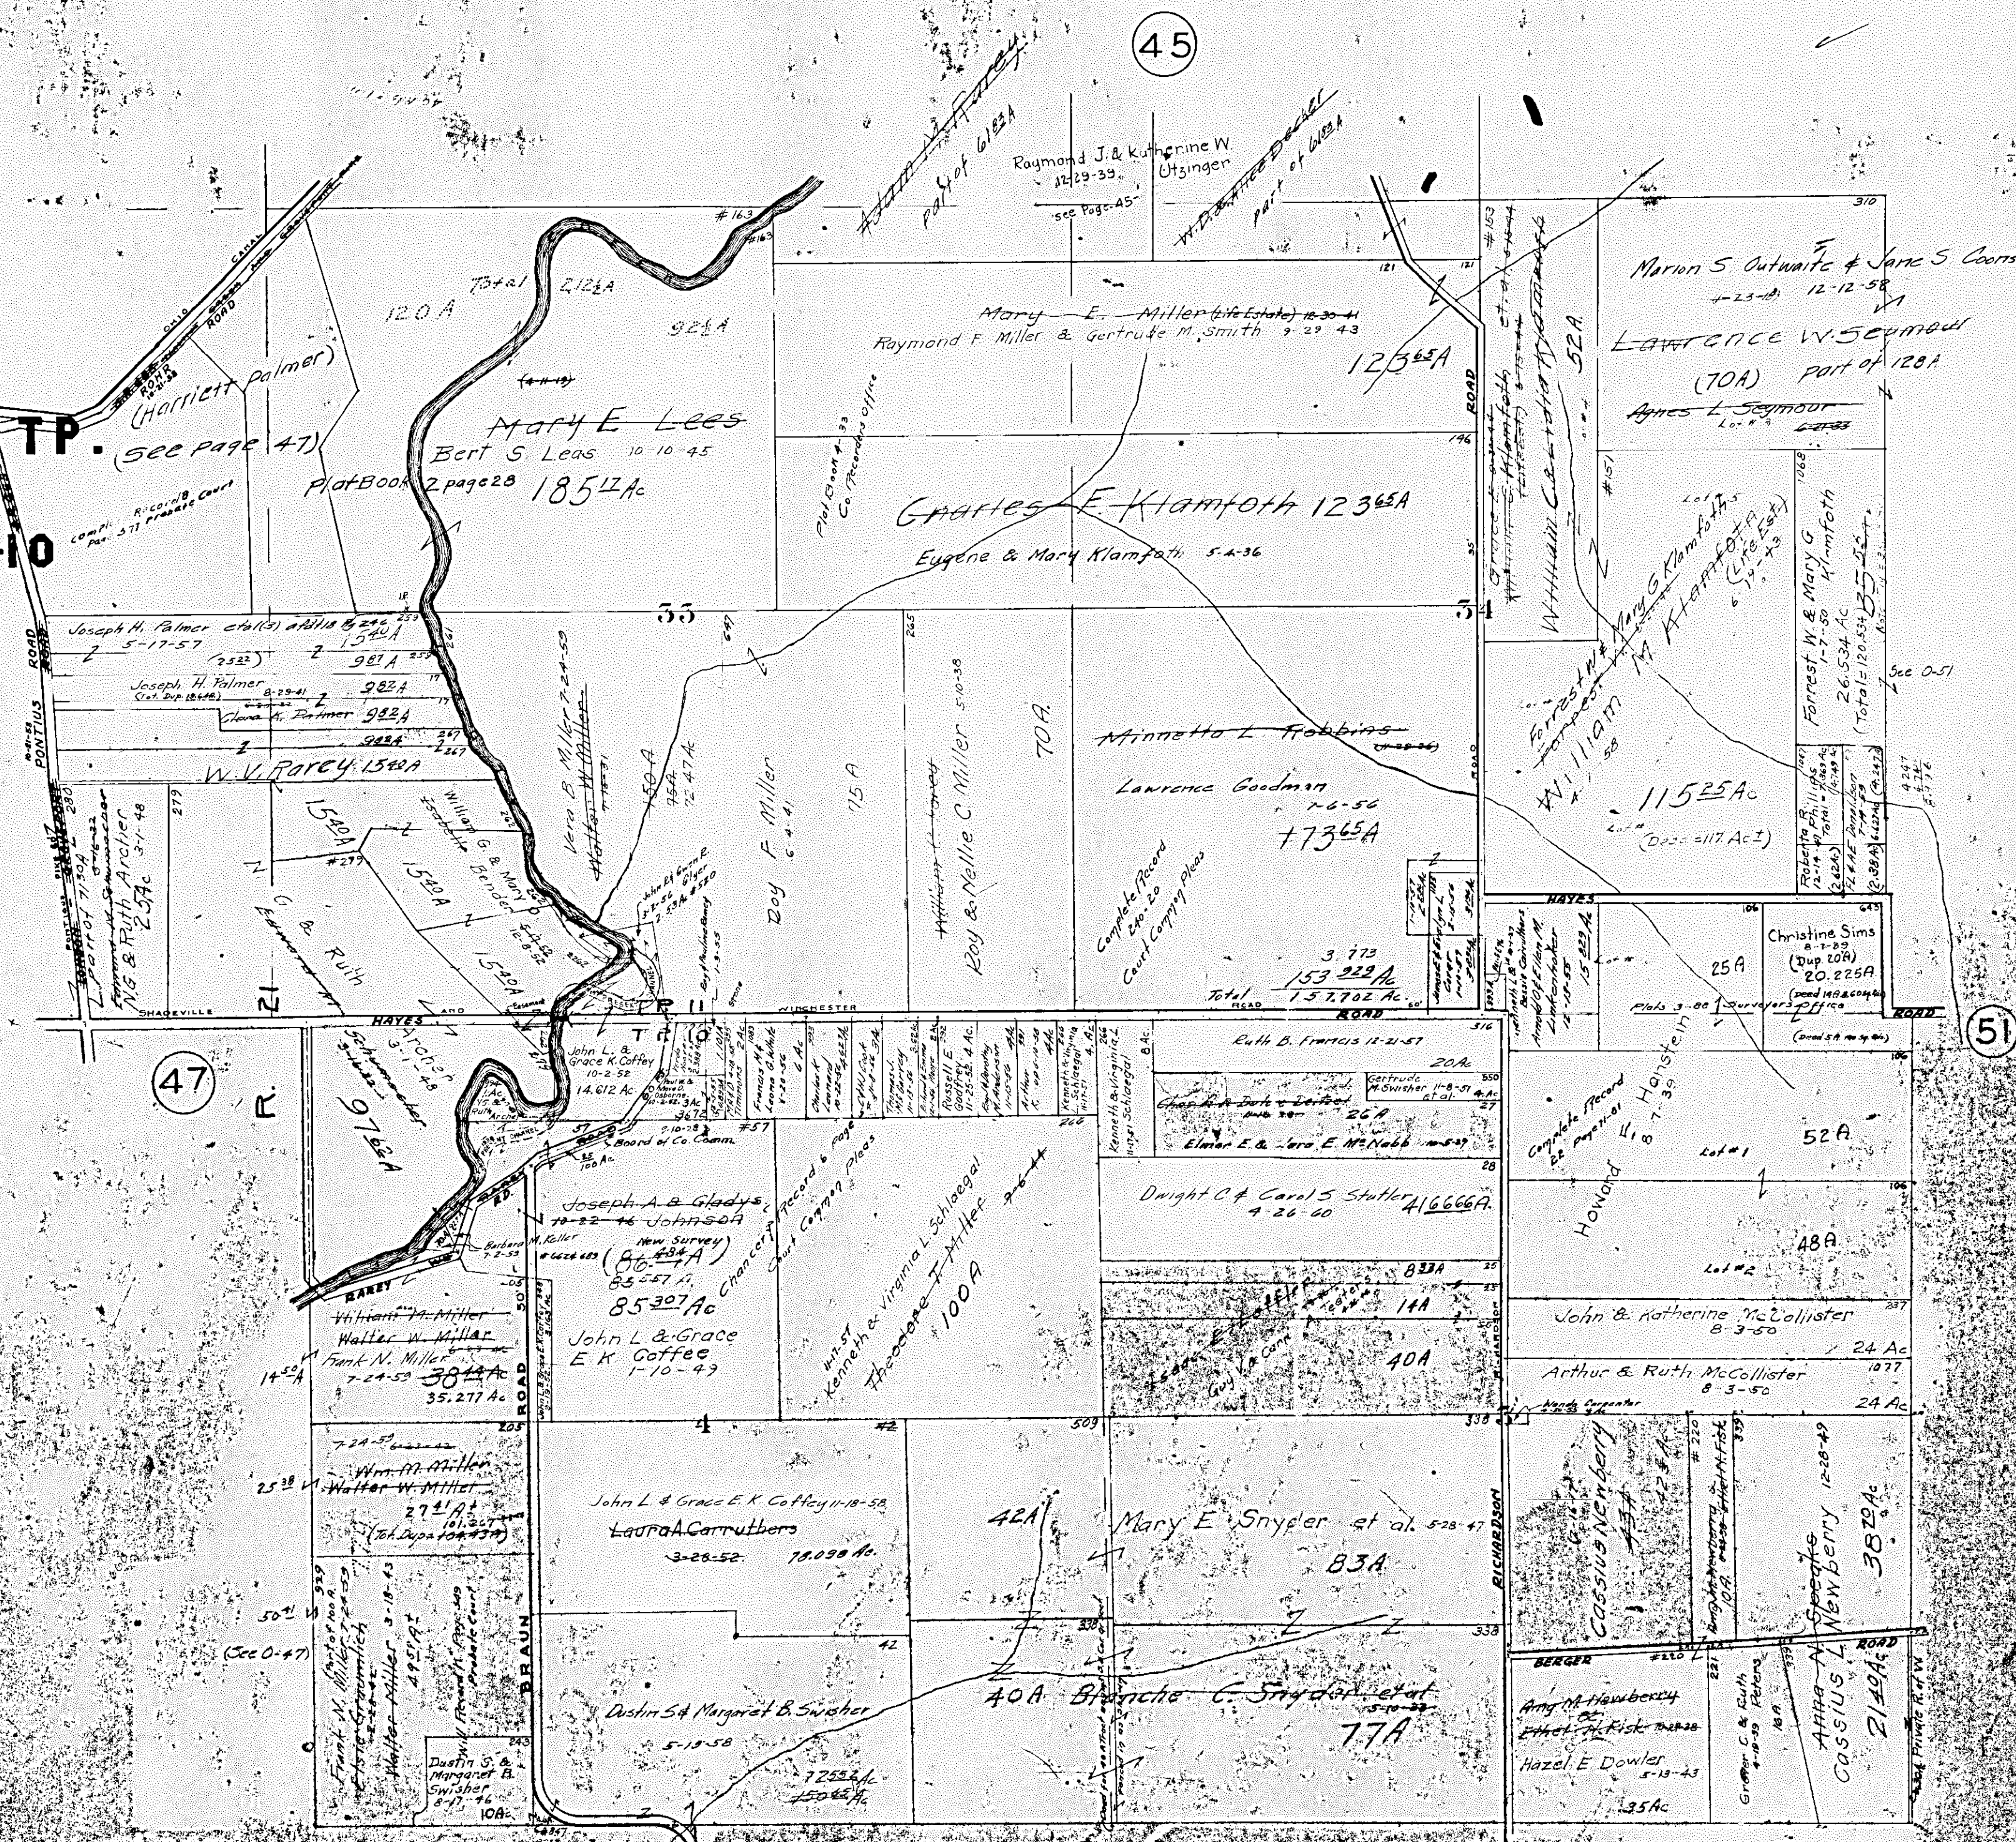

45

47

51

50