MADISON TP.
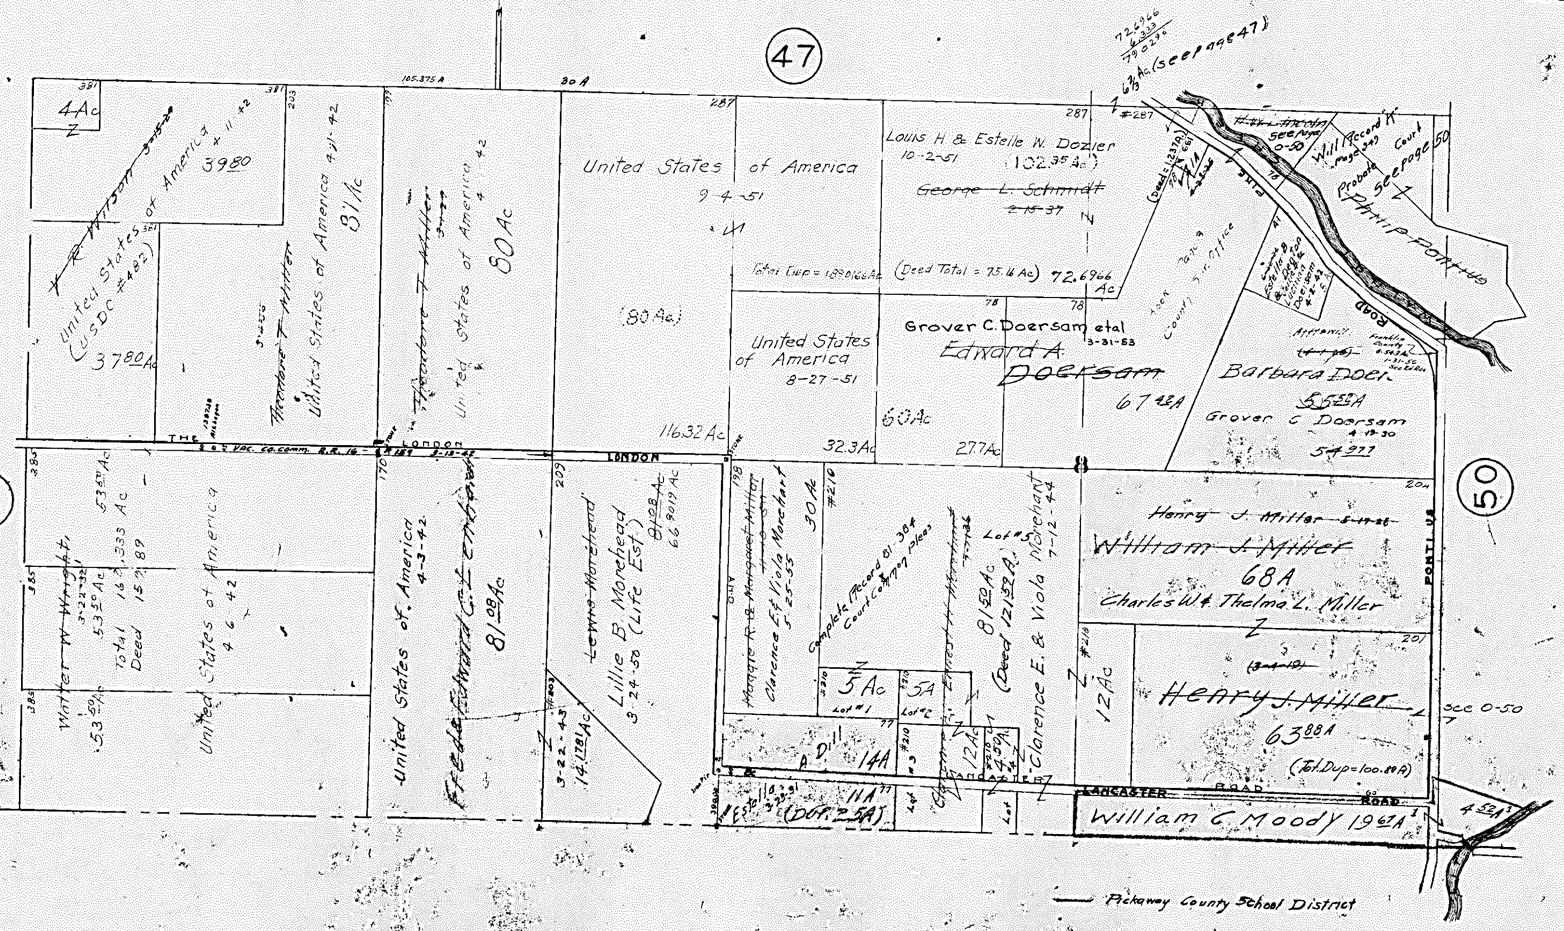
R. 21 TP. 10