MADISON TP.
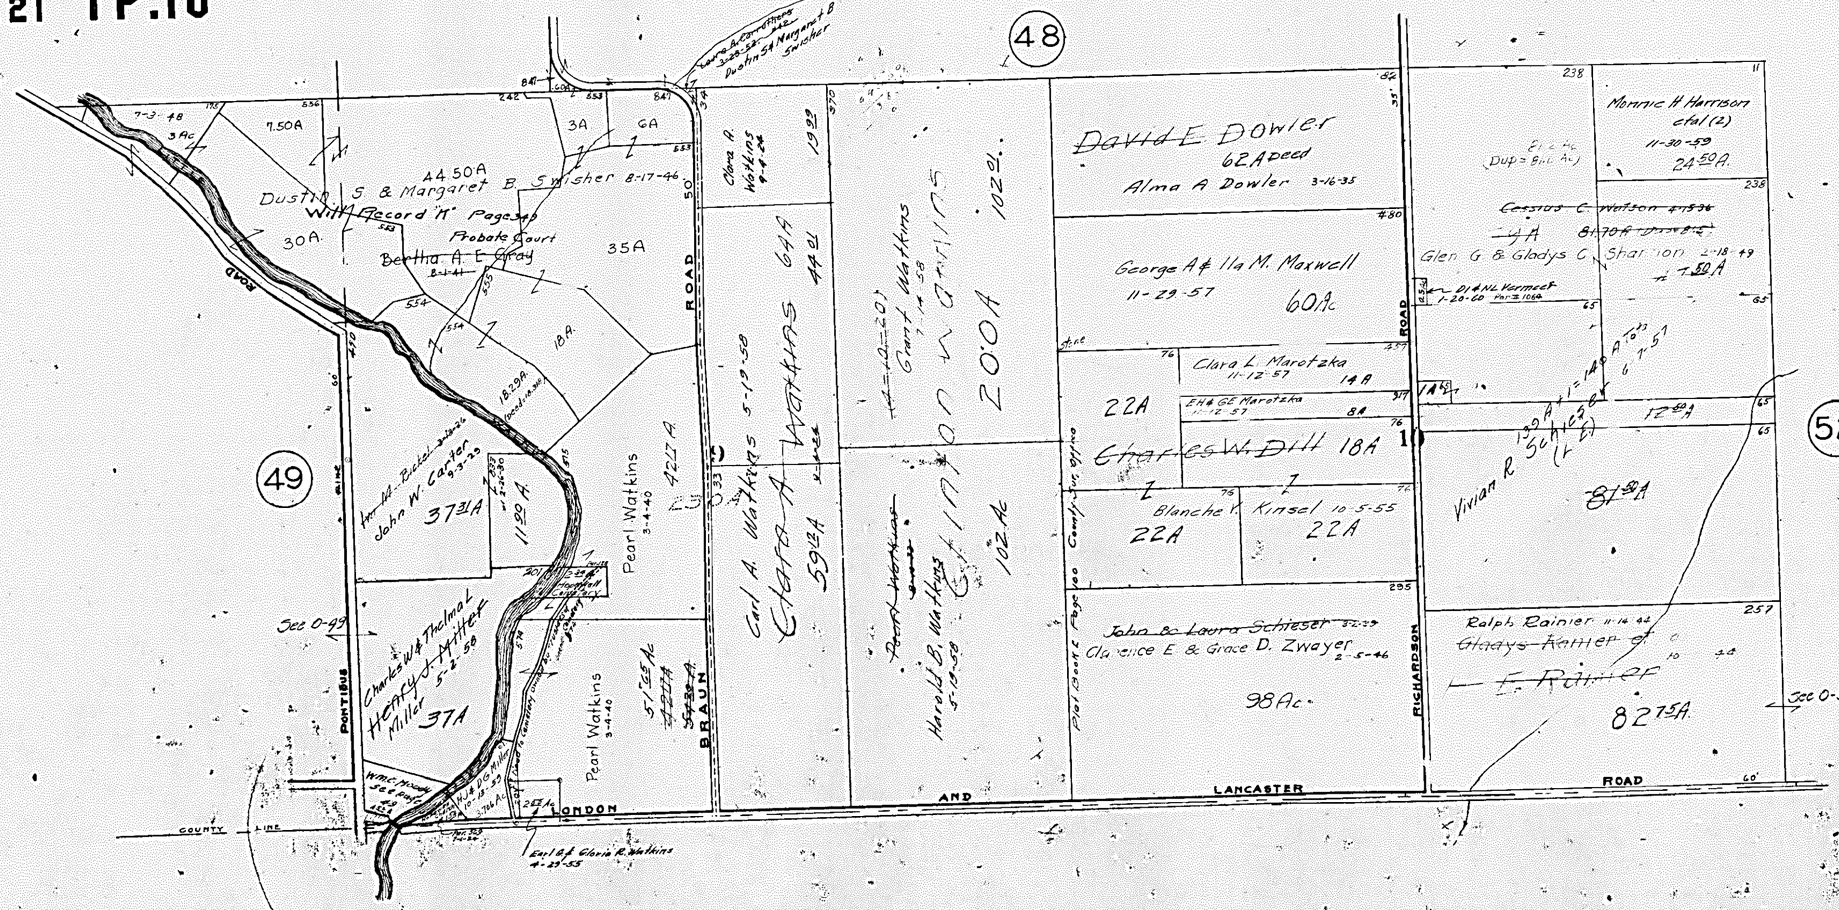
R.21 TP.10