


MADISON TP.

R.21 TP.10

Boonville
Littopalis School District

Winchester School District

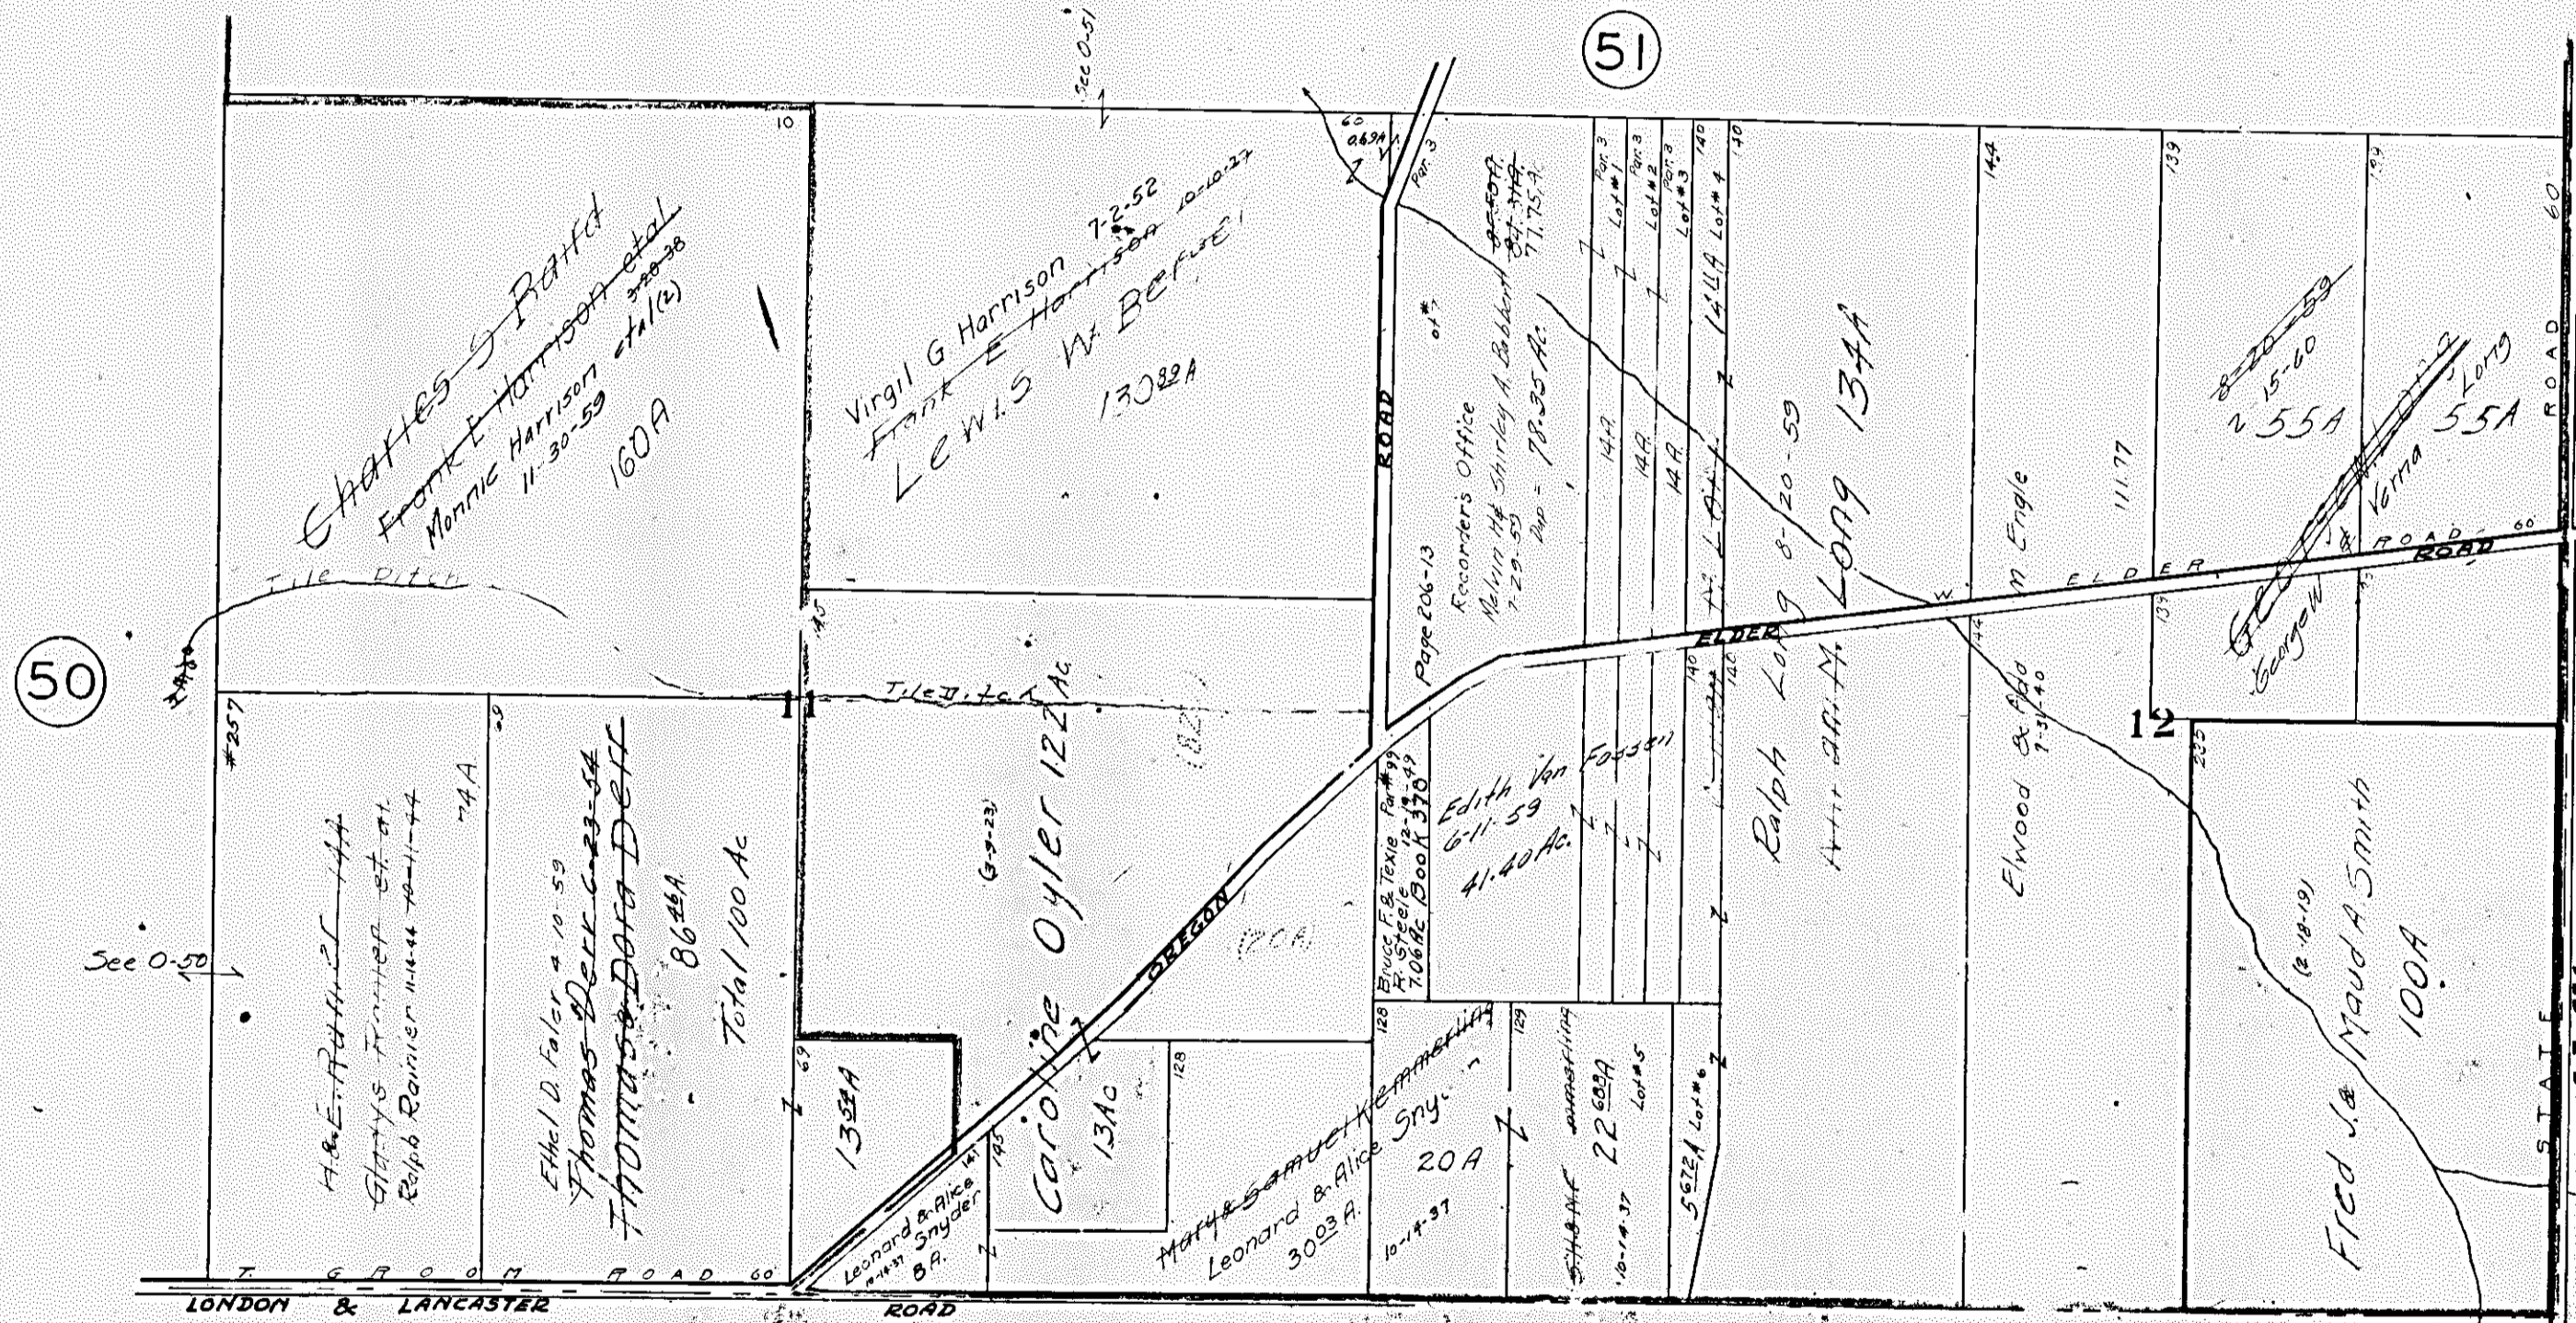

5
D
C
L
E
F
R
A
B
C
D