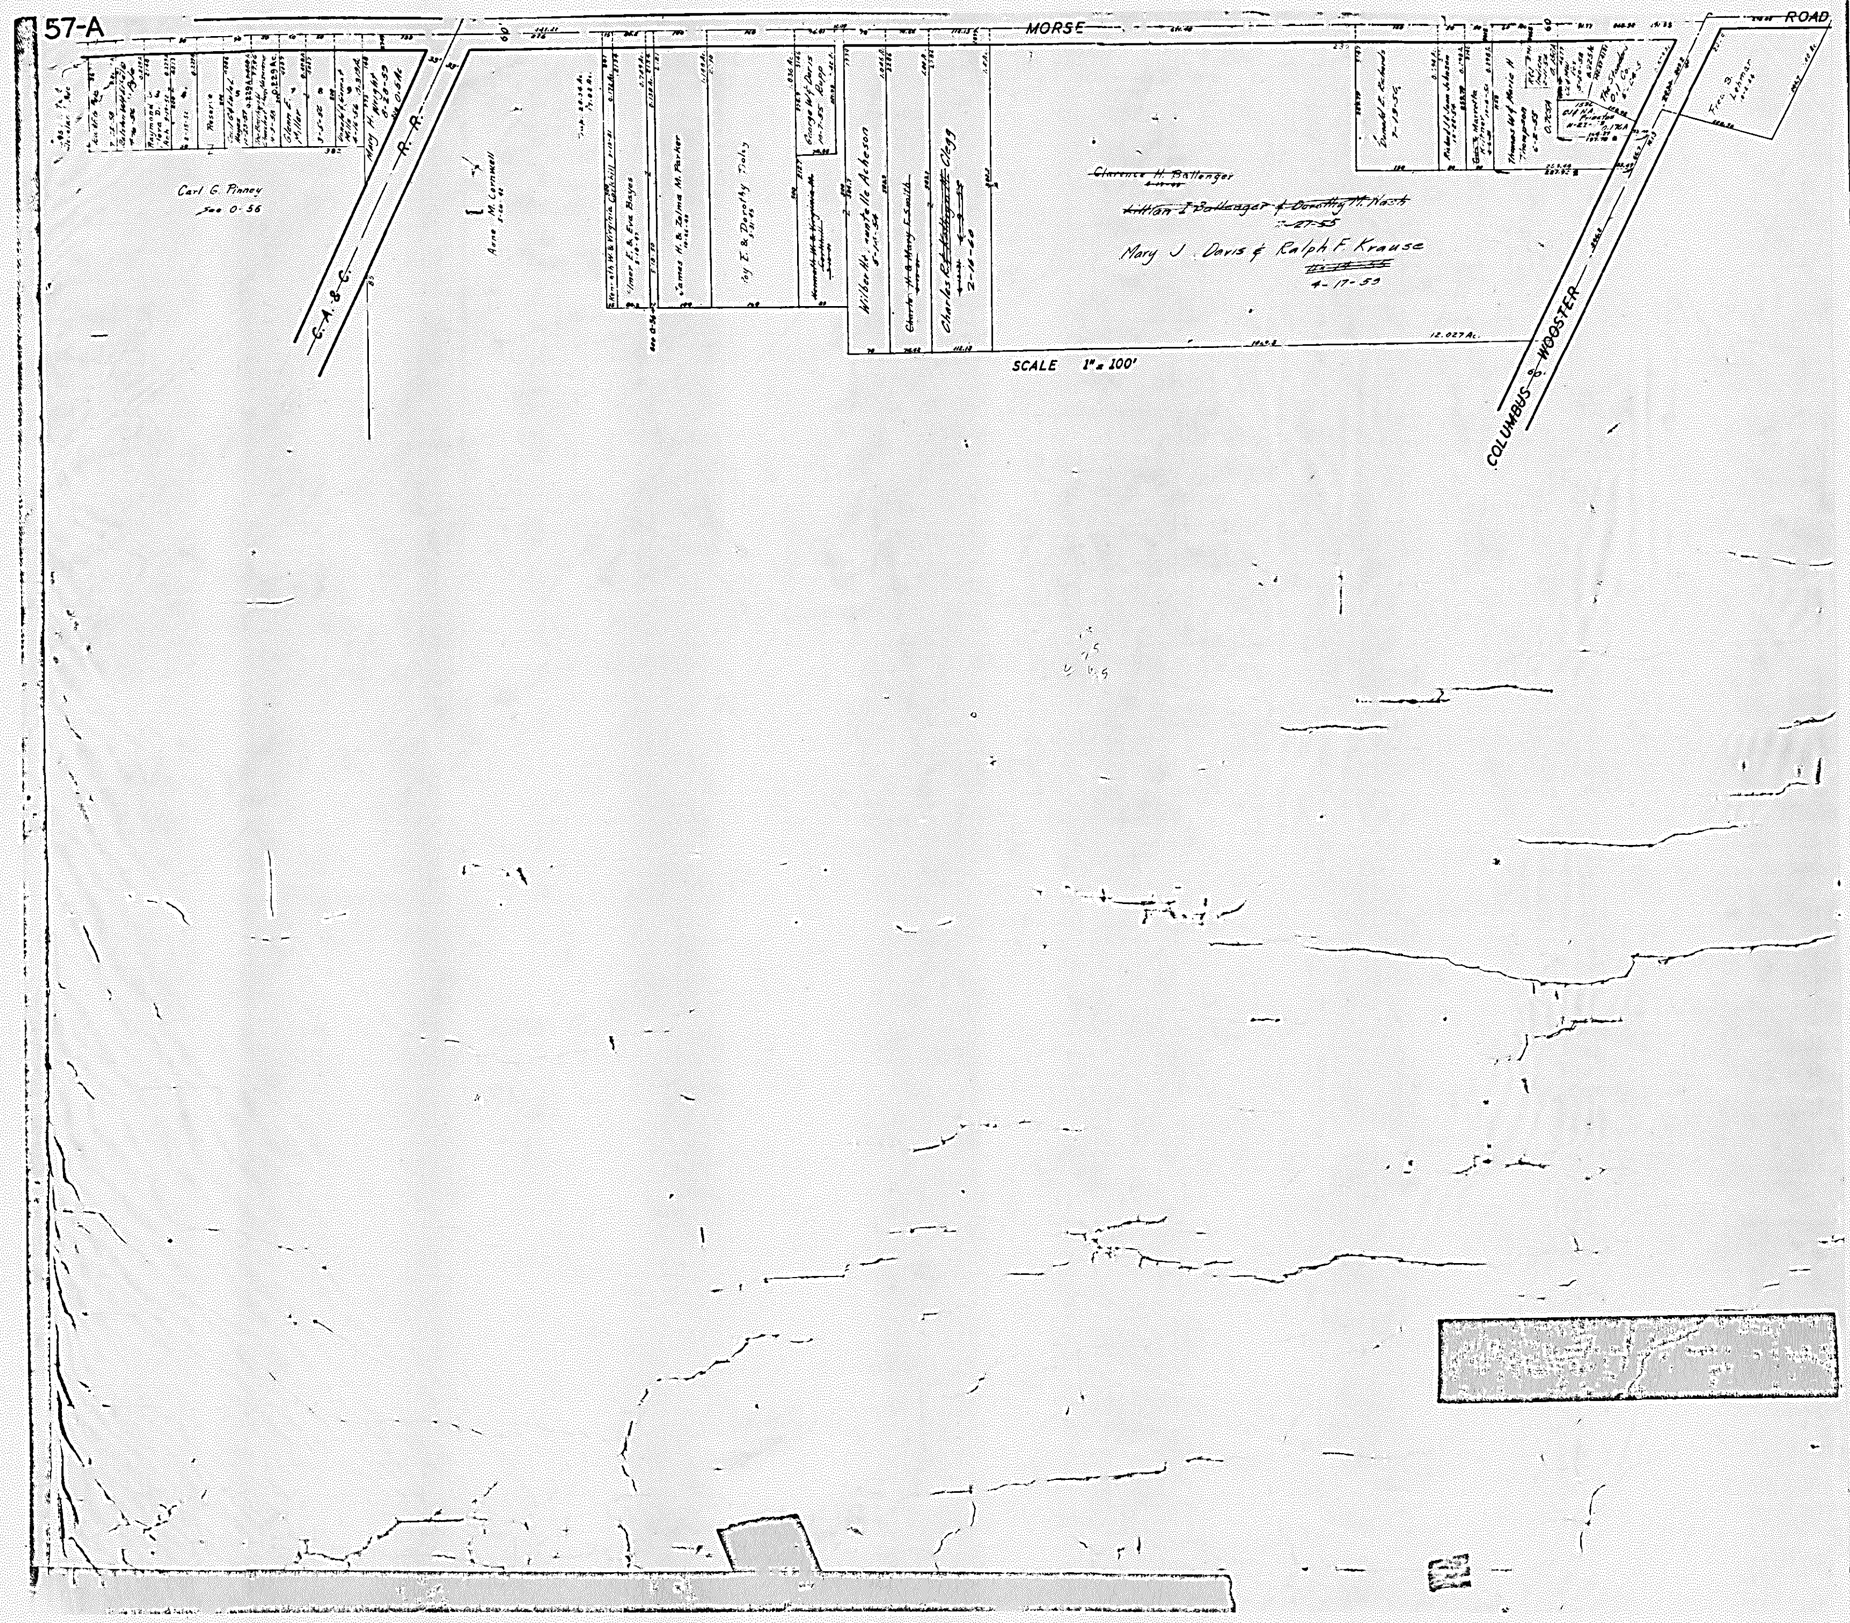
57-A
MORSE
ROAD
Carl G. Pinney
See 0-56
C. A. & C. R. R.
Anna M. Cornwell
See 0-56
Mary H. Wright
2-22-53
Probate
Wilbur H. and Ila Acheson
Clarence H. Ballenger
Mary J. Davis & Ralph F. Krause
4-17-53
12.027 Ac.
SCALE 1" = 100'
COLUMBUS & WOOSTER