


TOWNSHIP

300 FEET.

3000

(61)

62

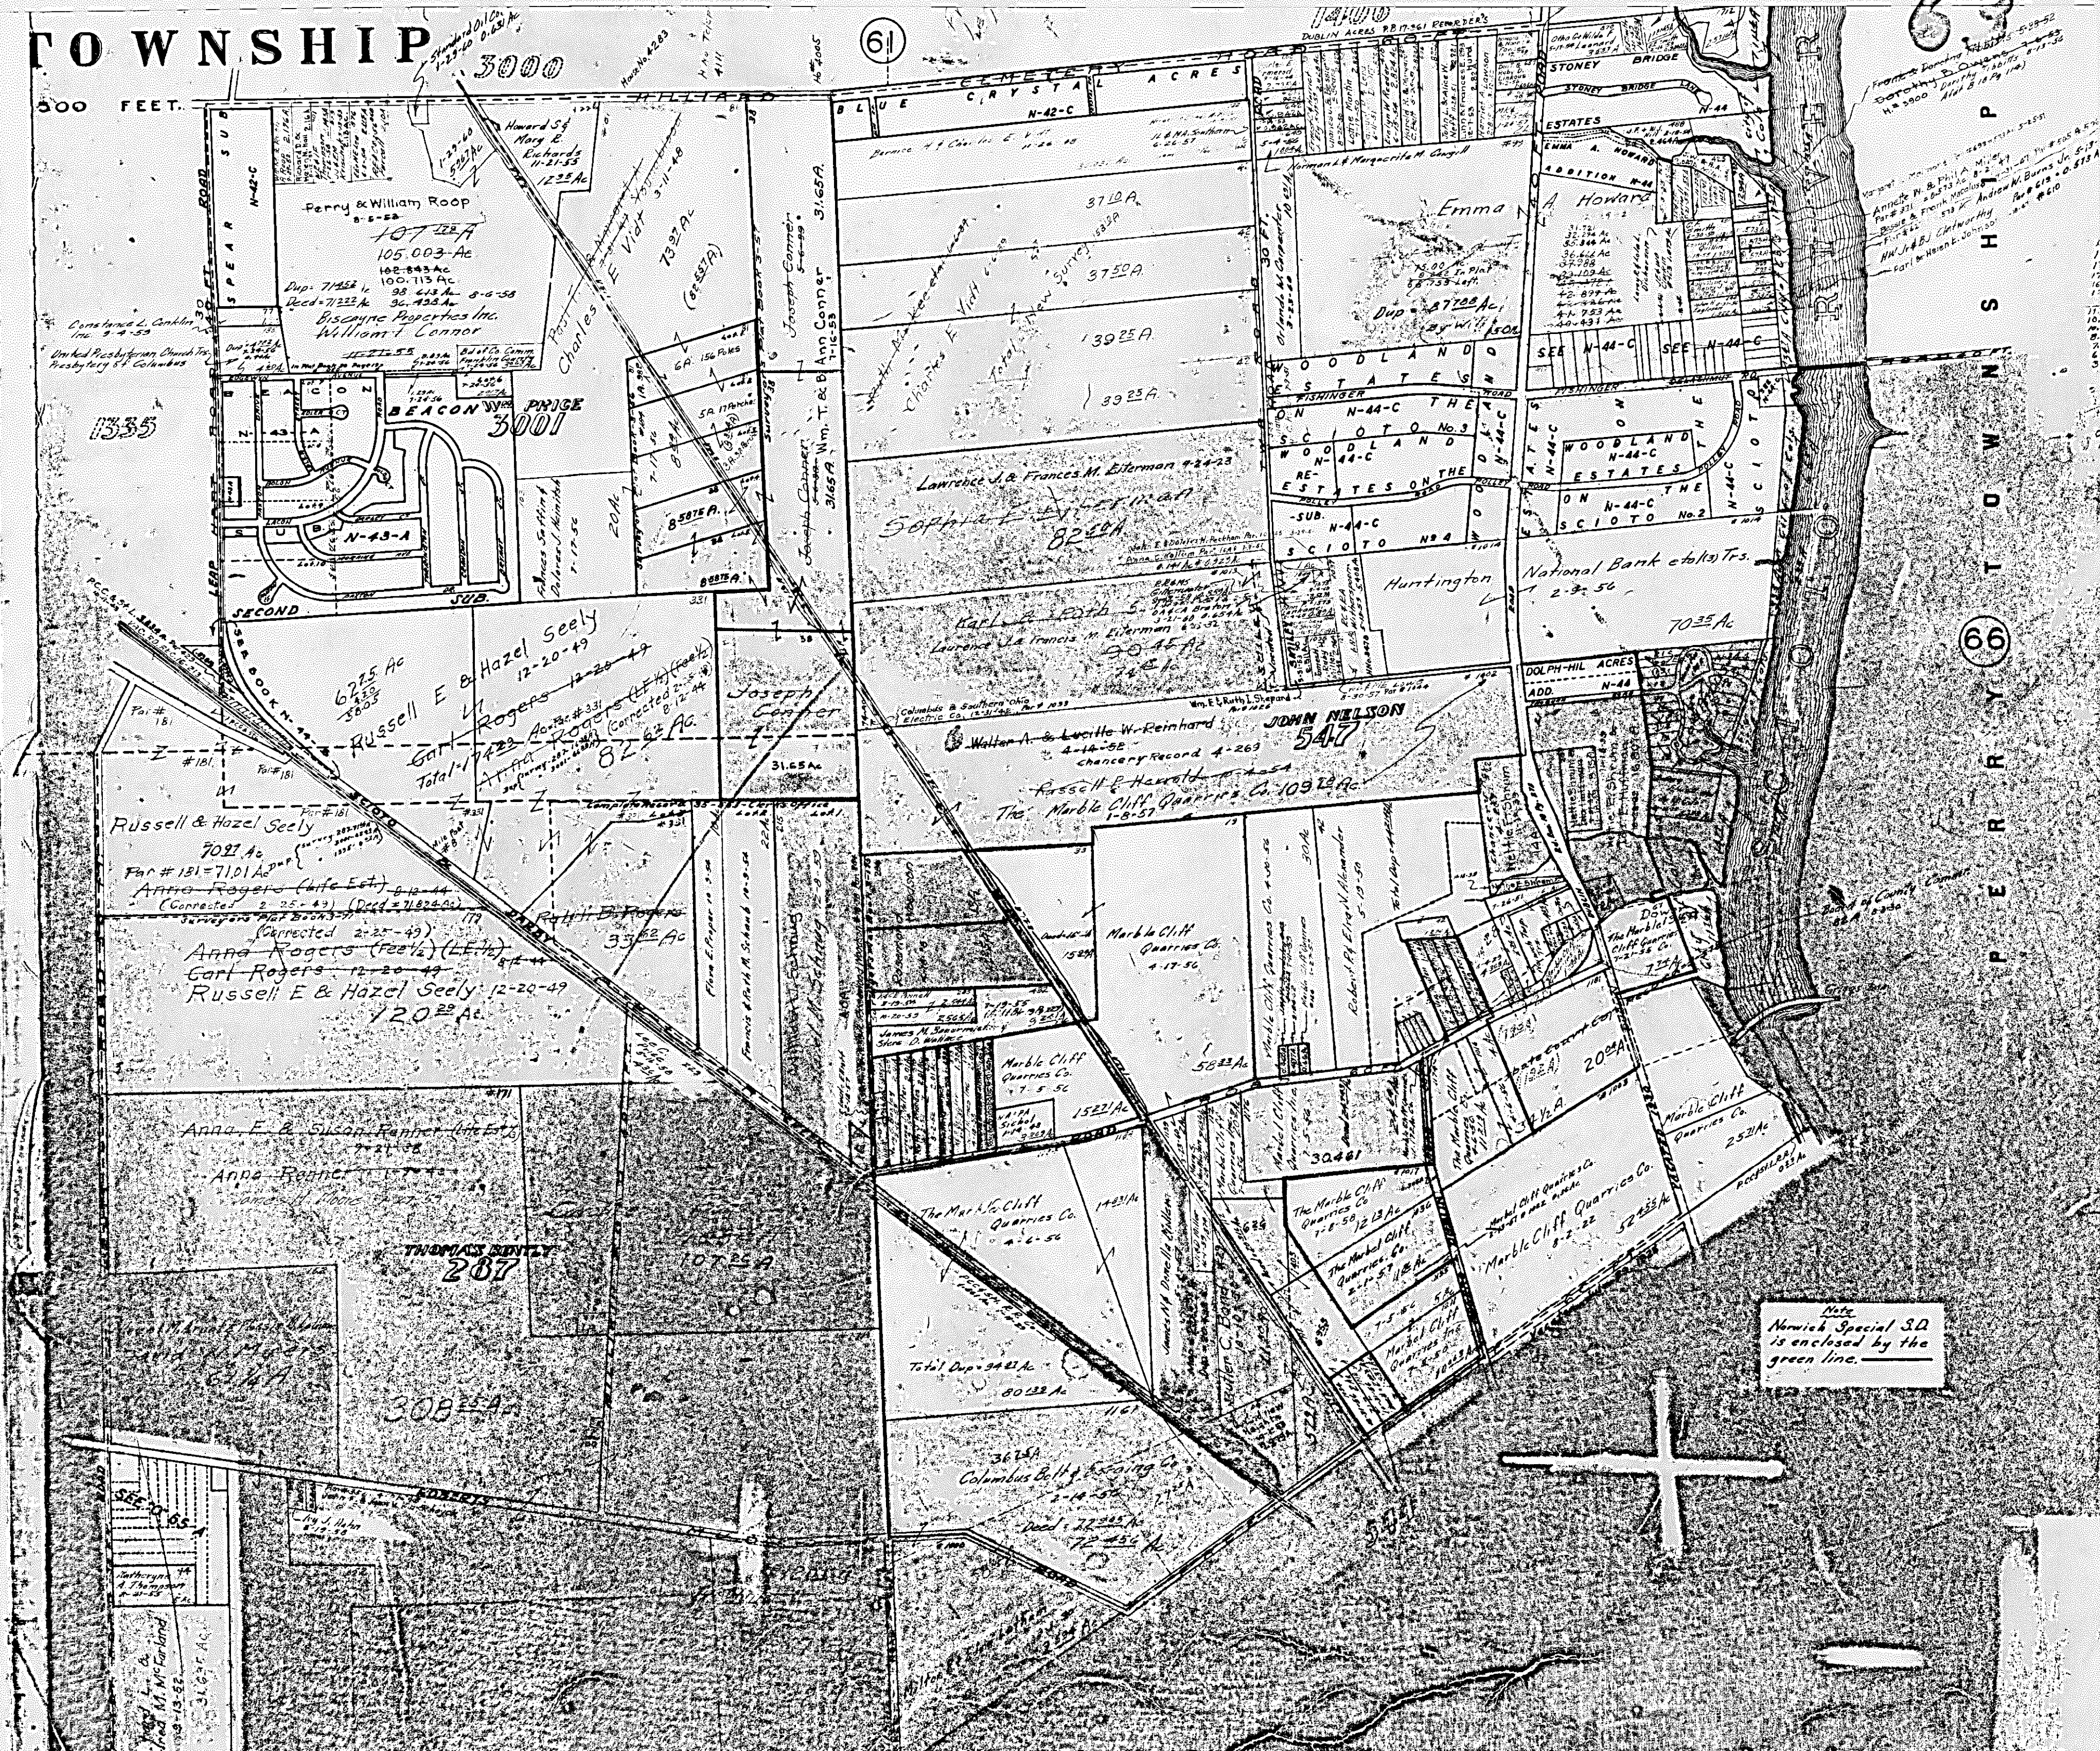

Note:
Norwich Special S.D.
is enclosed by the
green line.