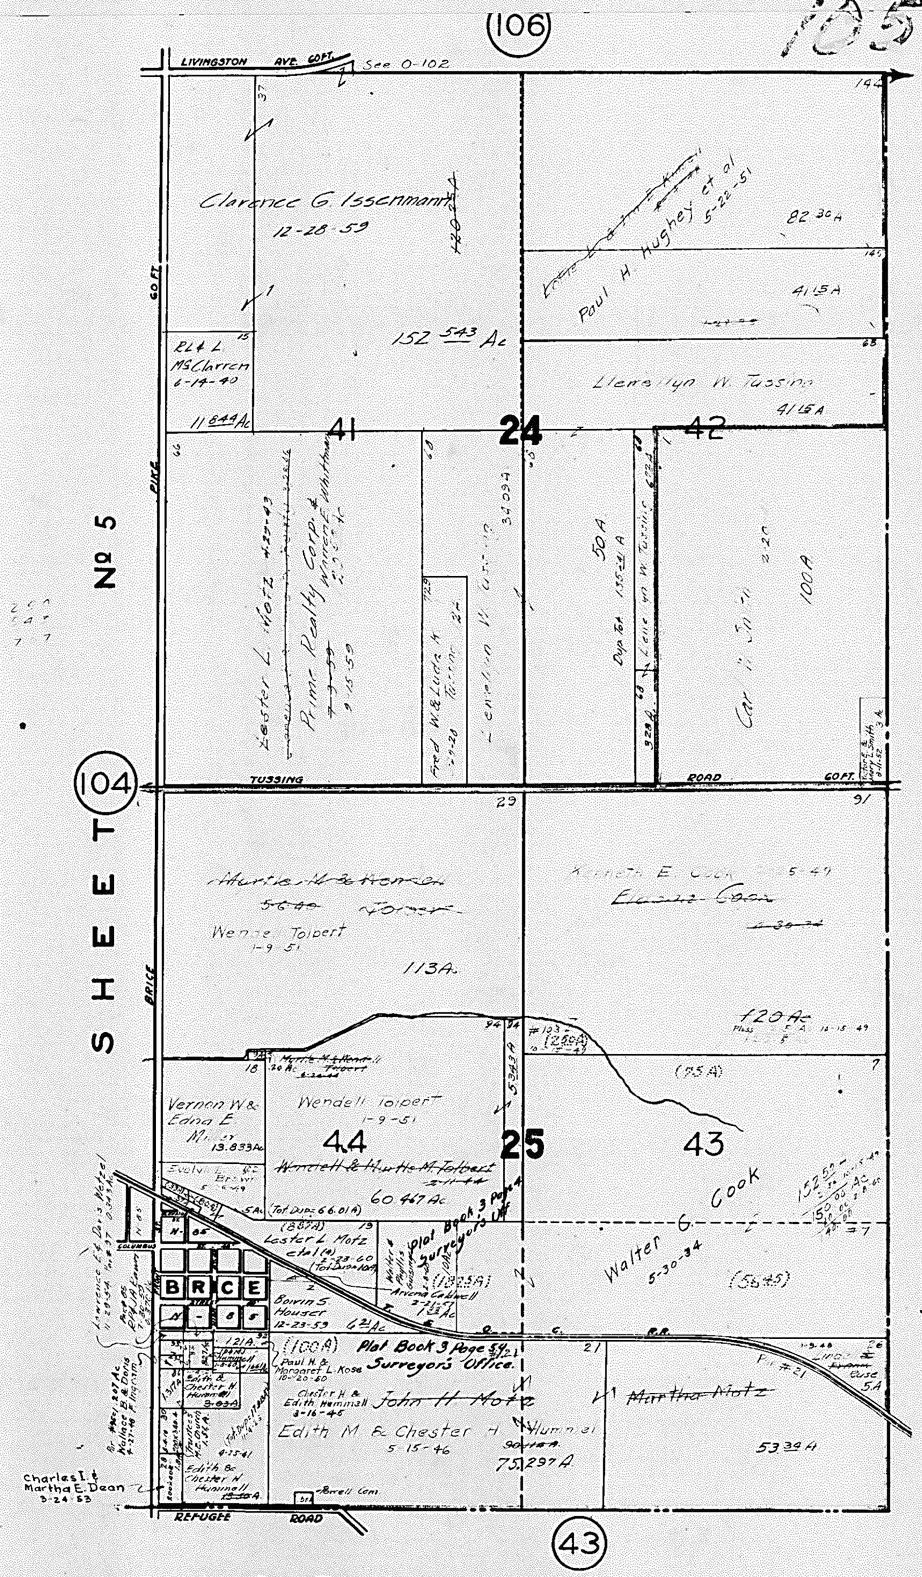
106
LIVINGSTON AVE. 60 FT.
See 0-102
Clarence G. Issemann
12-28-59
152 543 Ac
B.L. & L. McClarren 6-14-40
11 844 Ac
Paul H. Hughey et al 5-28-51
82 30 A
41.15 A
Llewellyn W. Tussing
41.15 A
41
24
42
Lester L. Motz
Prime Realty Corp.
50 A
100 A
TUSSING
ROAD
60 FT.
104
Wenne Tolbert
1-9-51
113 A.
120 Ac
Vernon W. & Edna E.
13.833 Ac
Wendell Tolbert
1-9-51
4.4
25
43
60.467 Ac
Lester L. Motz et al
Walter G. Cook
5-30-94
Boyd S. Housel
12-23-59
62 Ac
Plat Book 3 Page 54
Surveyor's Office.
Edith M. & Chester H. Hummel
5-15-46
Martha Motz
53 39 A
Charles I. & Martha E. Dean
3-24-53
REFUGE ROAD
43
MADISON TP.
SCALE 1" = 800'+-
Violet Twp. S
Reynoldsbu
Madison Twp
SHEET
TRURO
SHEET Nº 5

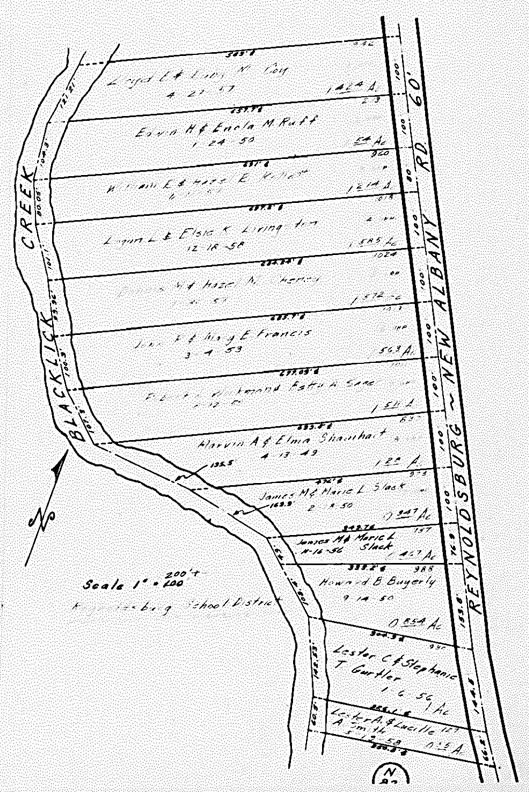
BLACKLICK CREEK
NEW ALBANY ~ REYNOLDSBURG RD. 60'
Scale 1" = 200'
Reynoldsburg School District