


103

SHEET No 1

2543

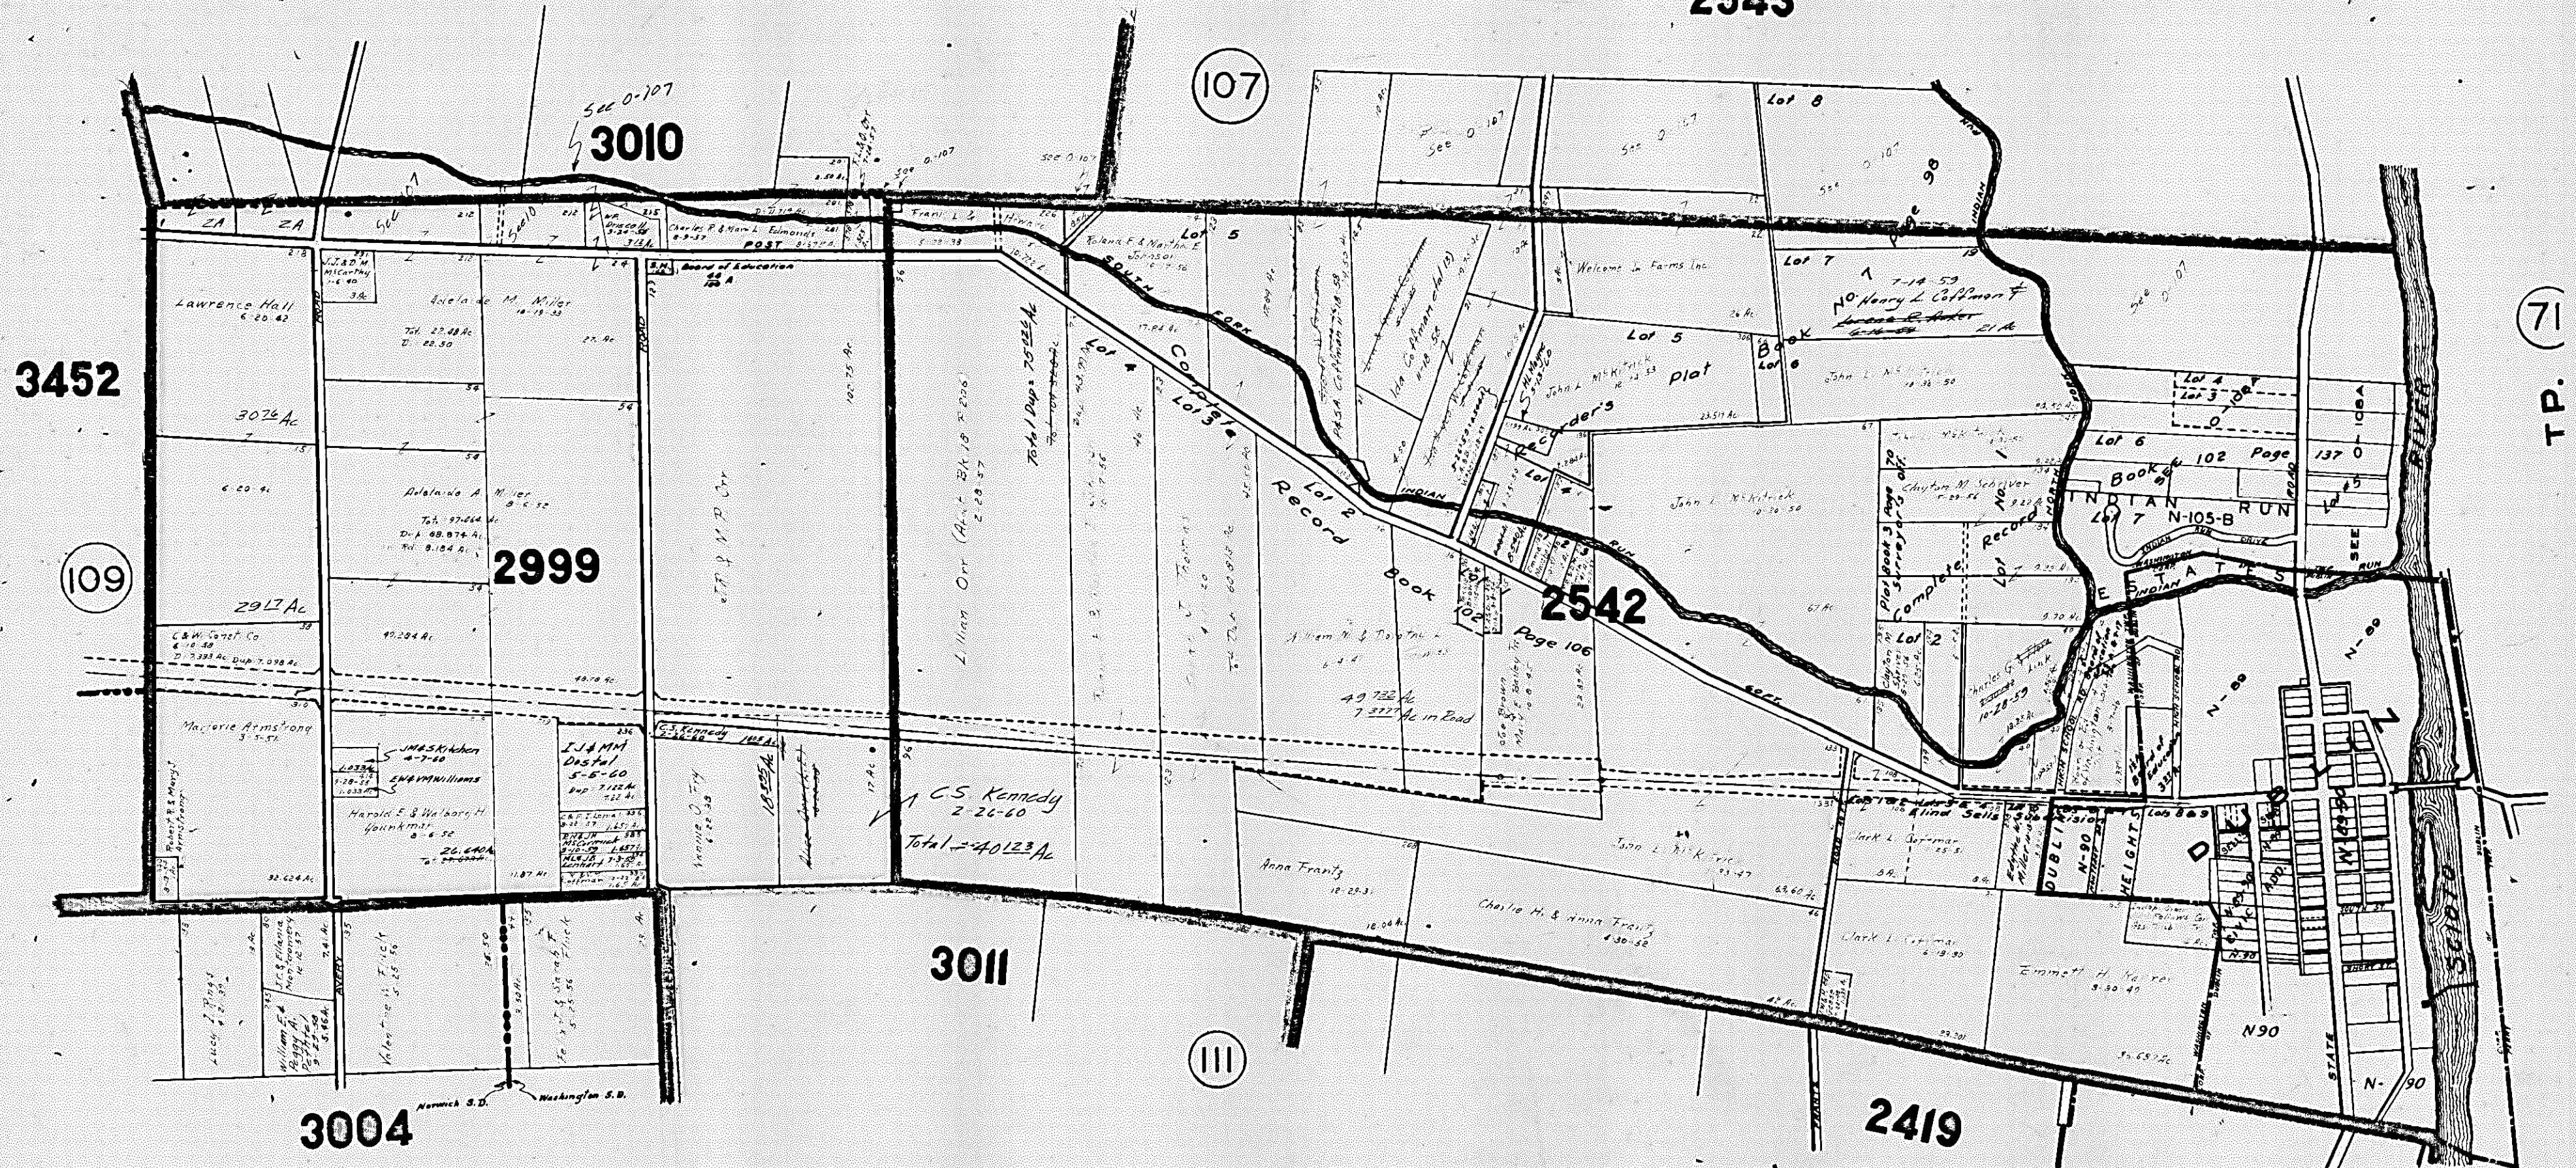

SHEET No 5

42  
2.46  
37.54

SHEET NO. 3  
WASHINGTON 1  
SCALE 1 IN. = 500 FT.