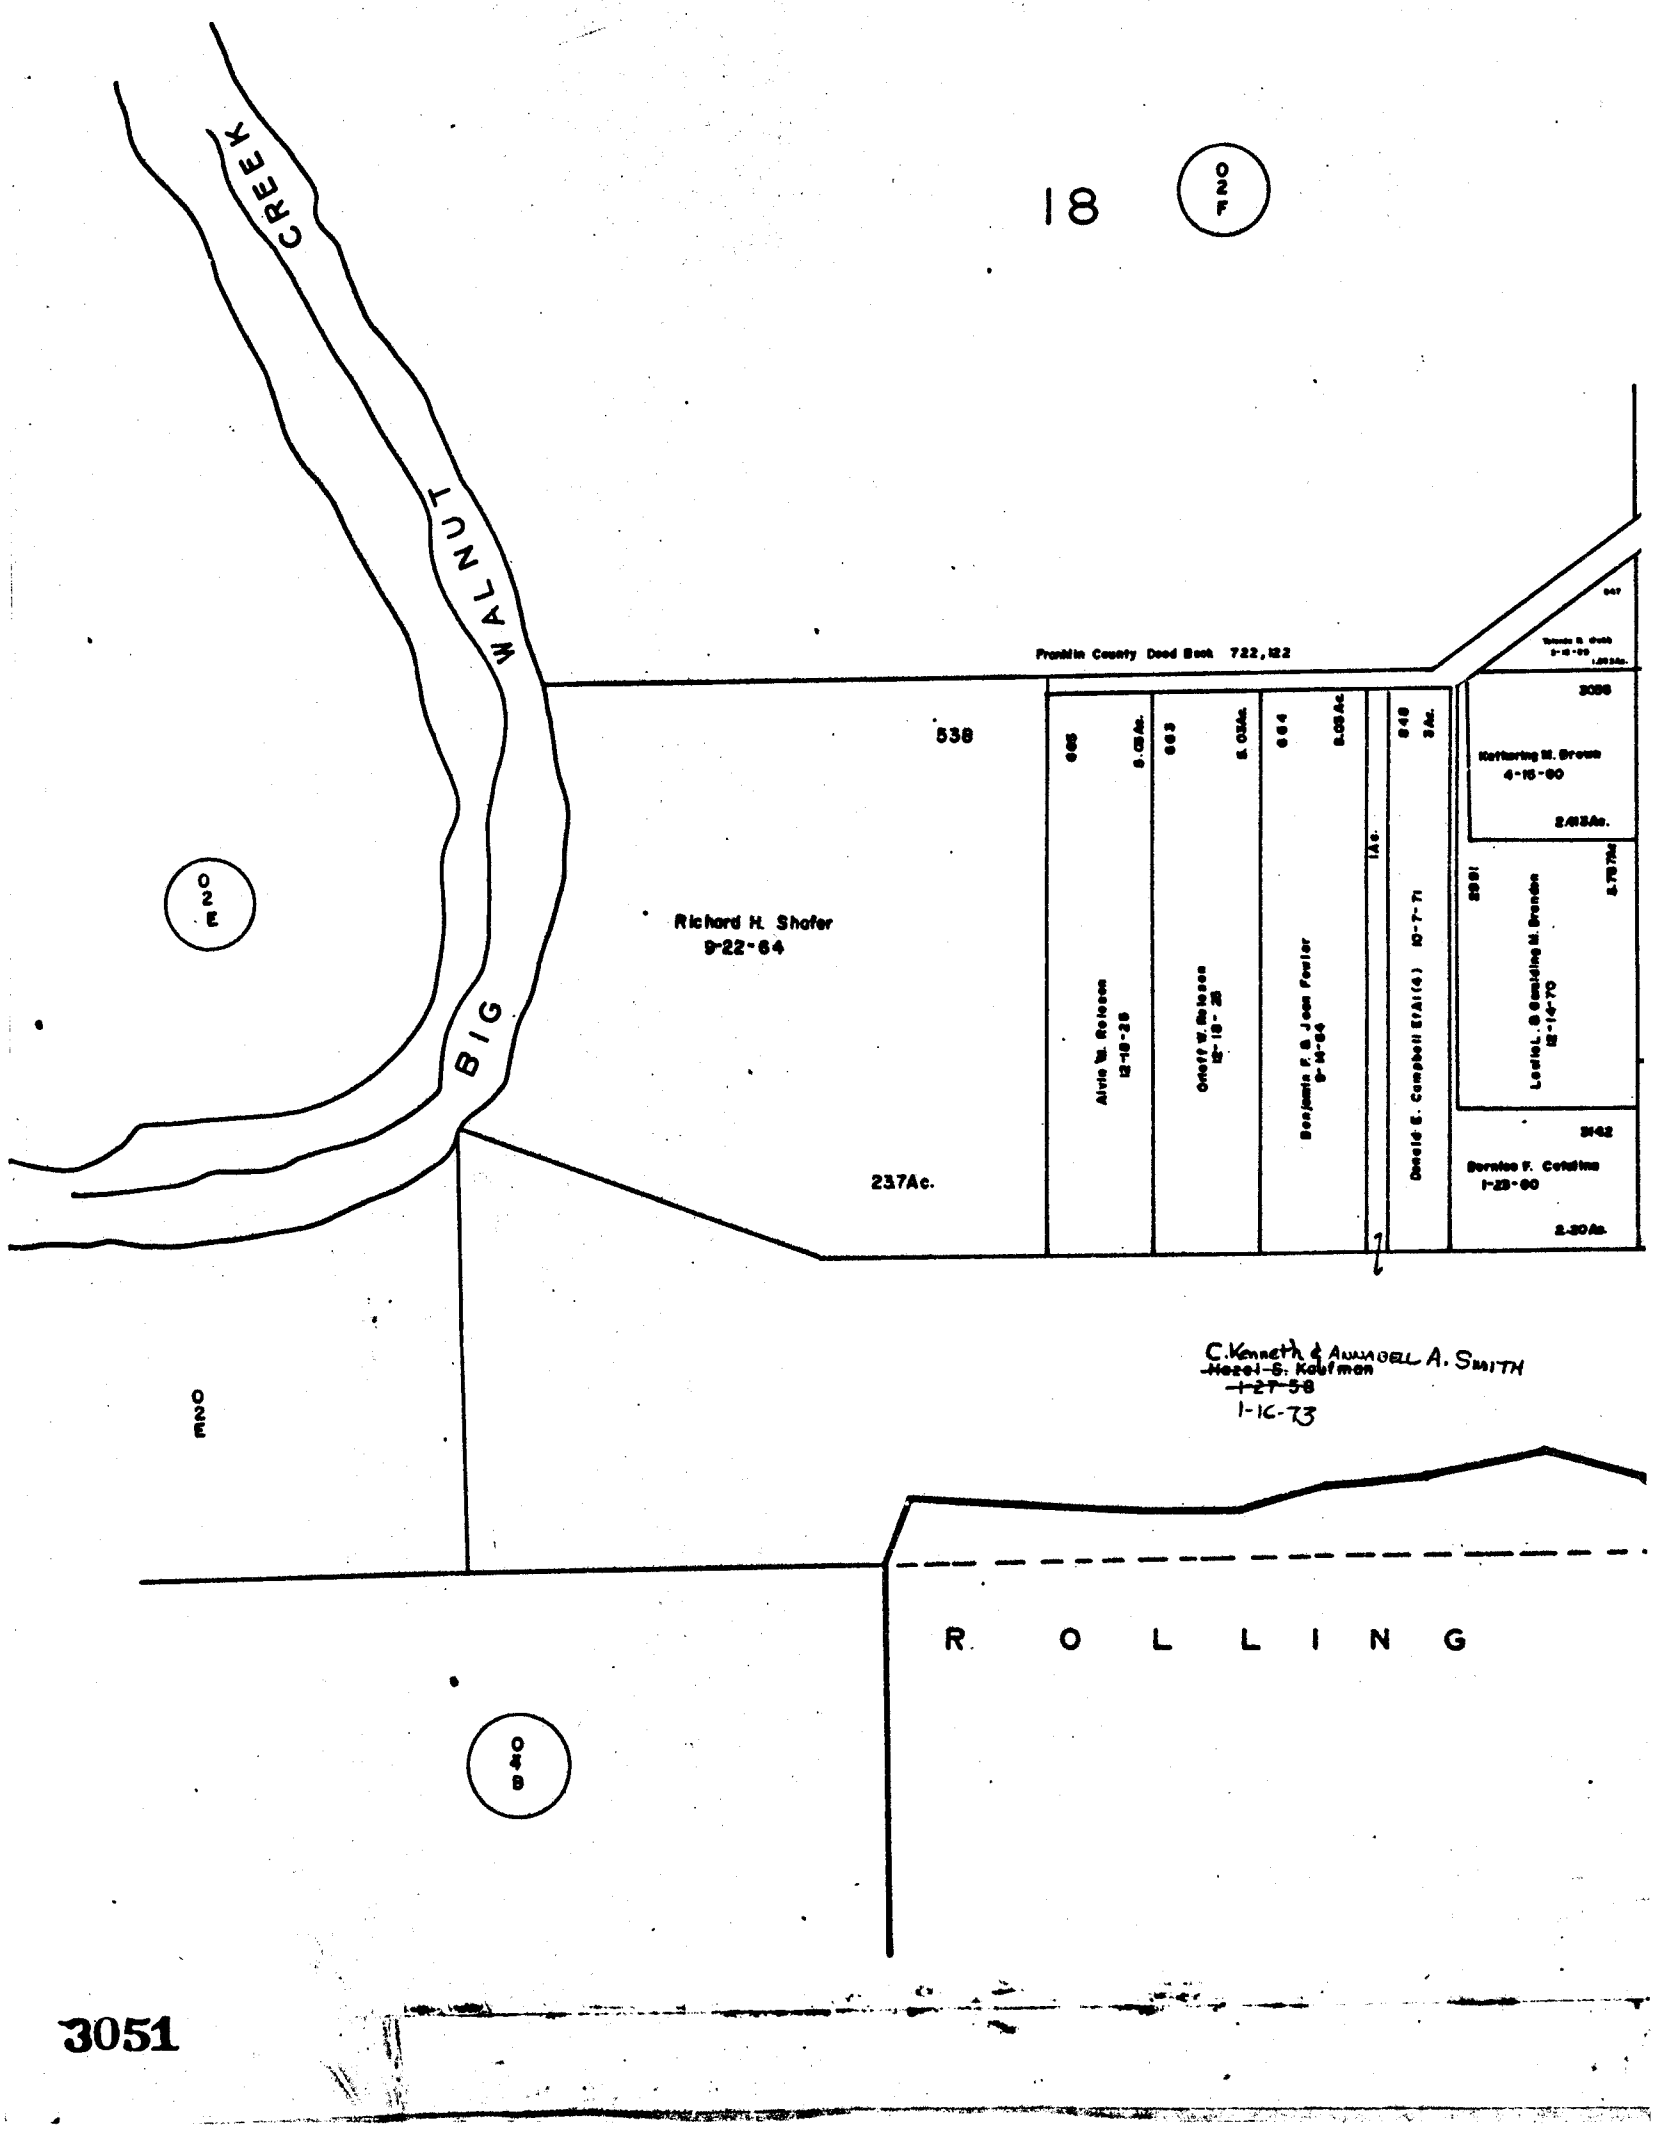
18
T 2 O N
BIG WALNUT CREEK
R 2 E
R 2 E
R 4 B
Franklin County Deed Book 722,122
538
Richard H. Shafer
9-22-64
237Ac.
Alvin W. Robison
12-18-28
Orloff W. Robison
12-18-28
Benjamin F. & Jean Fowler
9-18-64
Donald E. Campbell Et Al (4) 10-7-71
Katherine M. Brown
4-15-60
Leslie L. & Goalding M. Brandon
12-14-70
Bernice F. Collins
1-23-60
C. Kenneth & Annabell A. Smith
~~Hazel G. Kaufman~~
~~1-27-58~~
1-16-73
R O L L I N G

3051

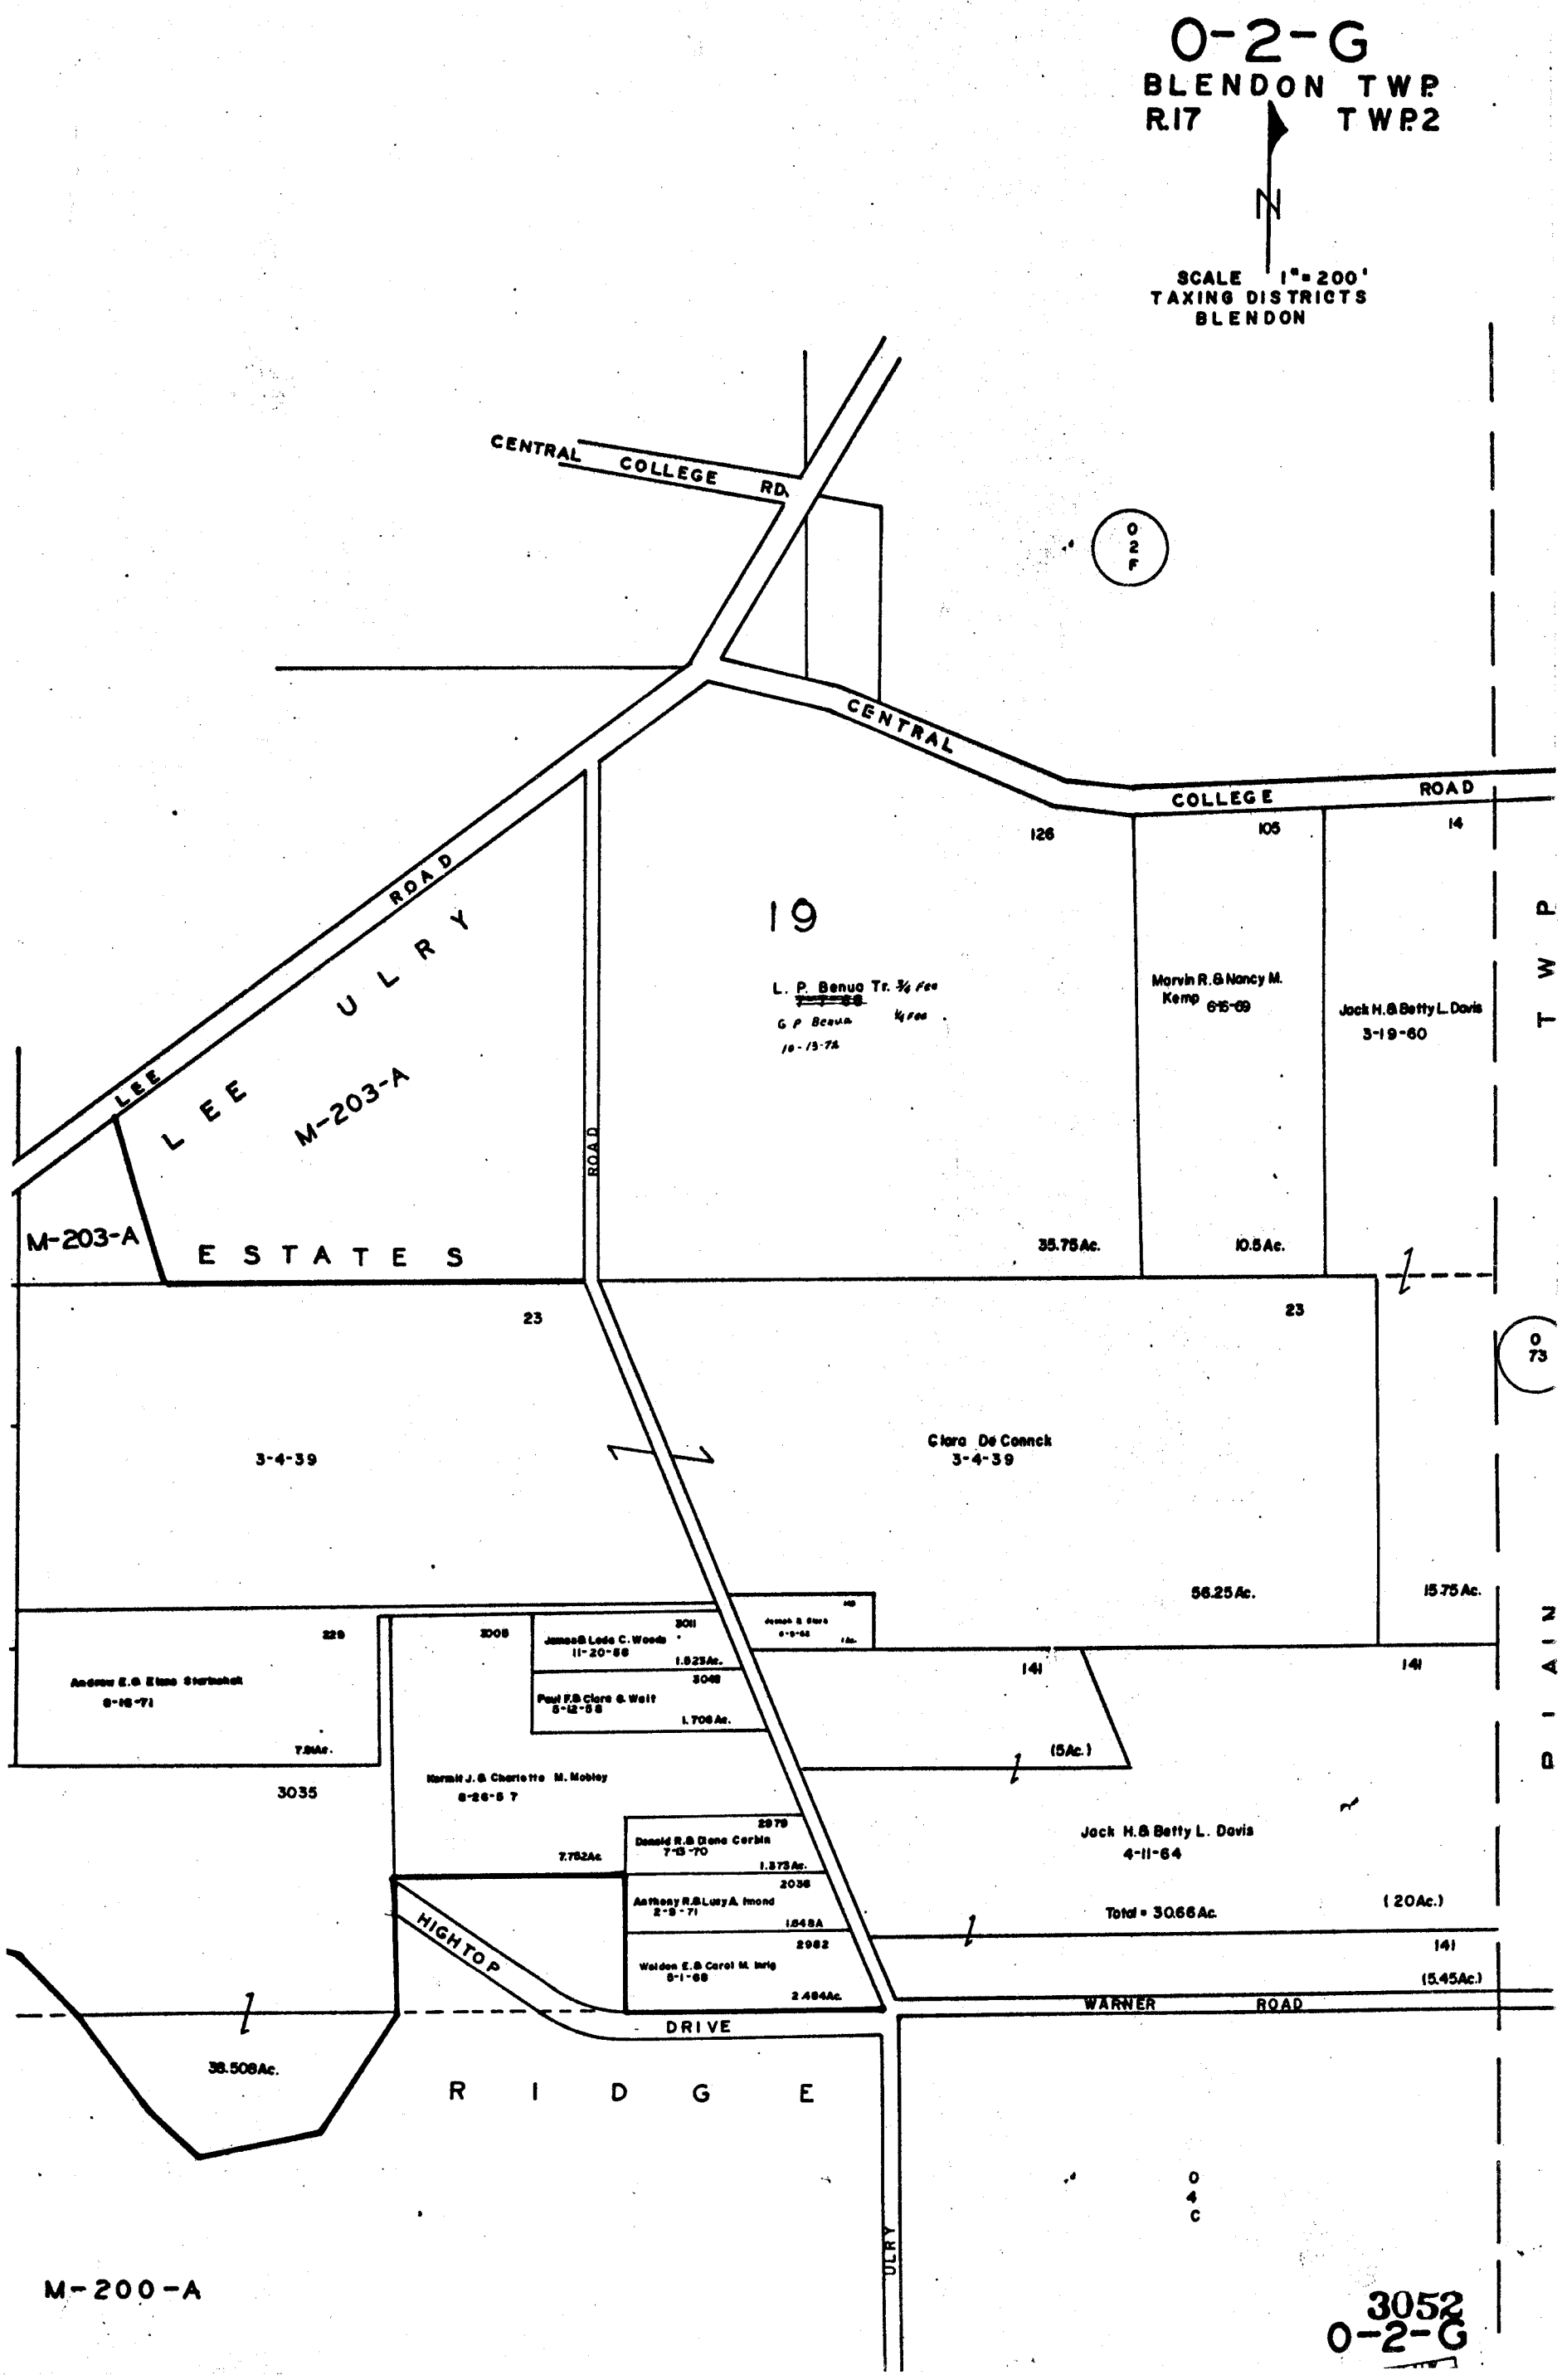
0-2-G
BLENDON TWP.
R.17
TWP.2
N
SCALE 1" = 200'
TAXING DISTRICTS
BLENDON
CENTRAL COLLEGE RD.
CENTRAL COLLEGE ROAD
LEE ULRY ROAD
LEE ULRY ESTATES
M-203-A
M-203-A
ROAD
19
L. P. Benua Tr. 3/4 Fee
1/4 Fee
G. P. Benua
10-13-78
126
105
14
Marvin R. & Nancy M. Kemp 6-15-69
Jack H. & Betty L. Davis 3-19-60
35.75 Ac.
10.5 Ac.
23
23
3-4-39
Clara De Connck 3-4-39
56.25 Ac.
15.75 Ac.
229
Andrew E. & Elane Starkshek 8-16-71
7.84 Ac.
3035
2008
James & Leda C. Woods 11-20-56
3011
1.823 Ac.
3048
Paul F. & Clara G. Wolf 5-12-58
1.706 Ac.
Harold J. & Charlotte M. Mobley 8-26-57
7.752 Ac.
2979
Donald R. & Diane Corbin 7-13-70
1.373 Ac.
2036
Anthony R. & Lucy A. Imond 2-9-71
1.648 A
2982
Weldon E. & Carol M. Inrig 5-1-68
2.484 Ac.
HIGHTOP DRIVE
38.508 Ac.
R I D G E
141
141
(5 Ac.)
Jack H. & Betty L. Davis 4-11-64
Total = 30.66 Ac.
(20 Ac.)
141
(5.45 Ac.)
WARNER ROAD
ULRY
M-200-A
0 2 F
0 73
0 4 C
3052
0-2-G