


T W P.

160
00

S H A R O N

CLEVELAND


030

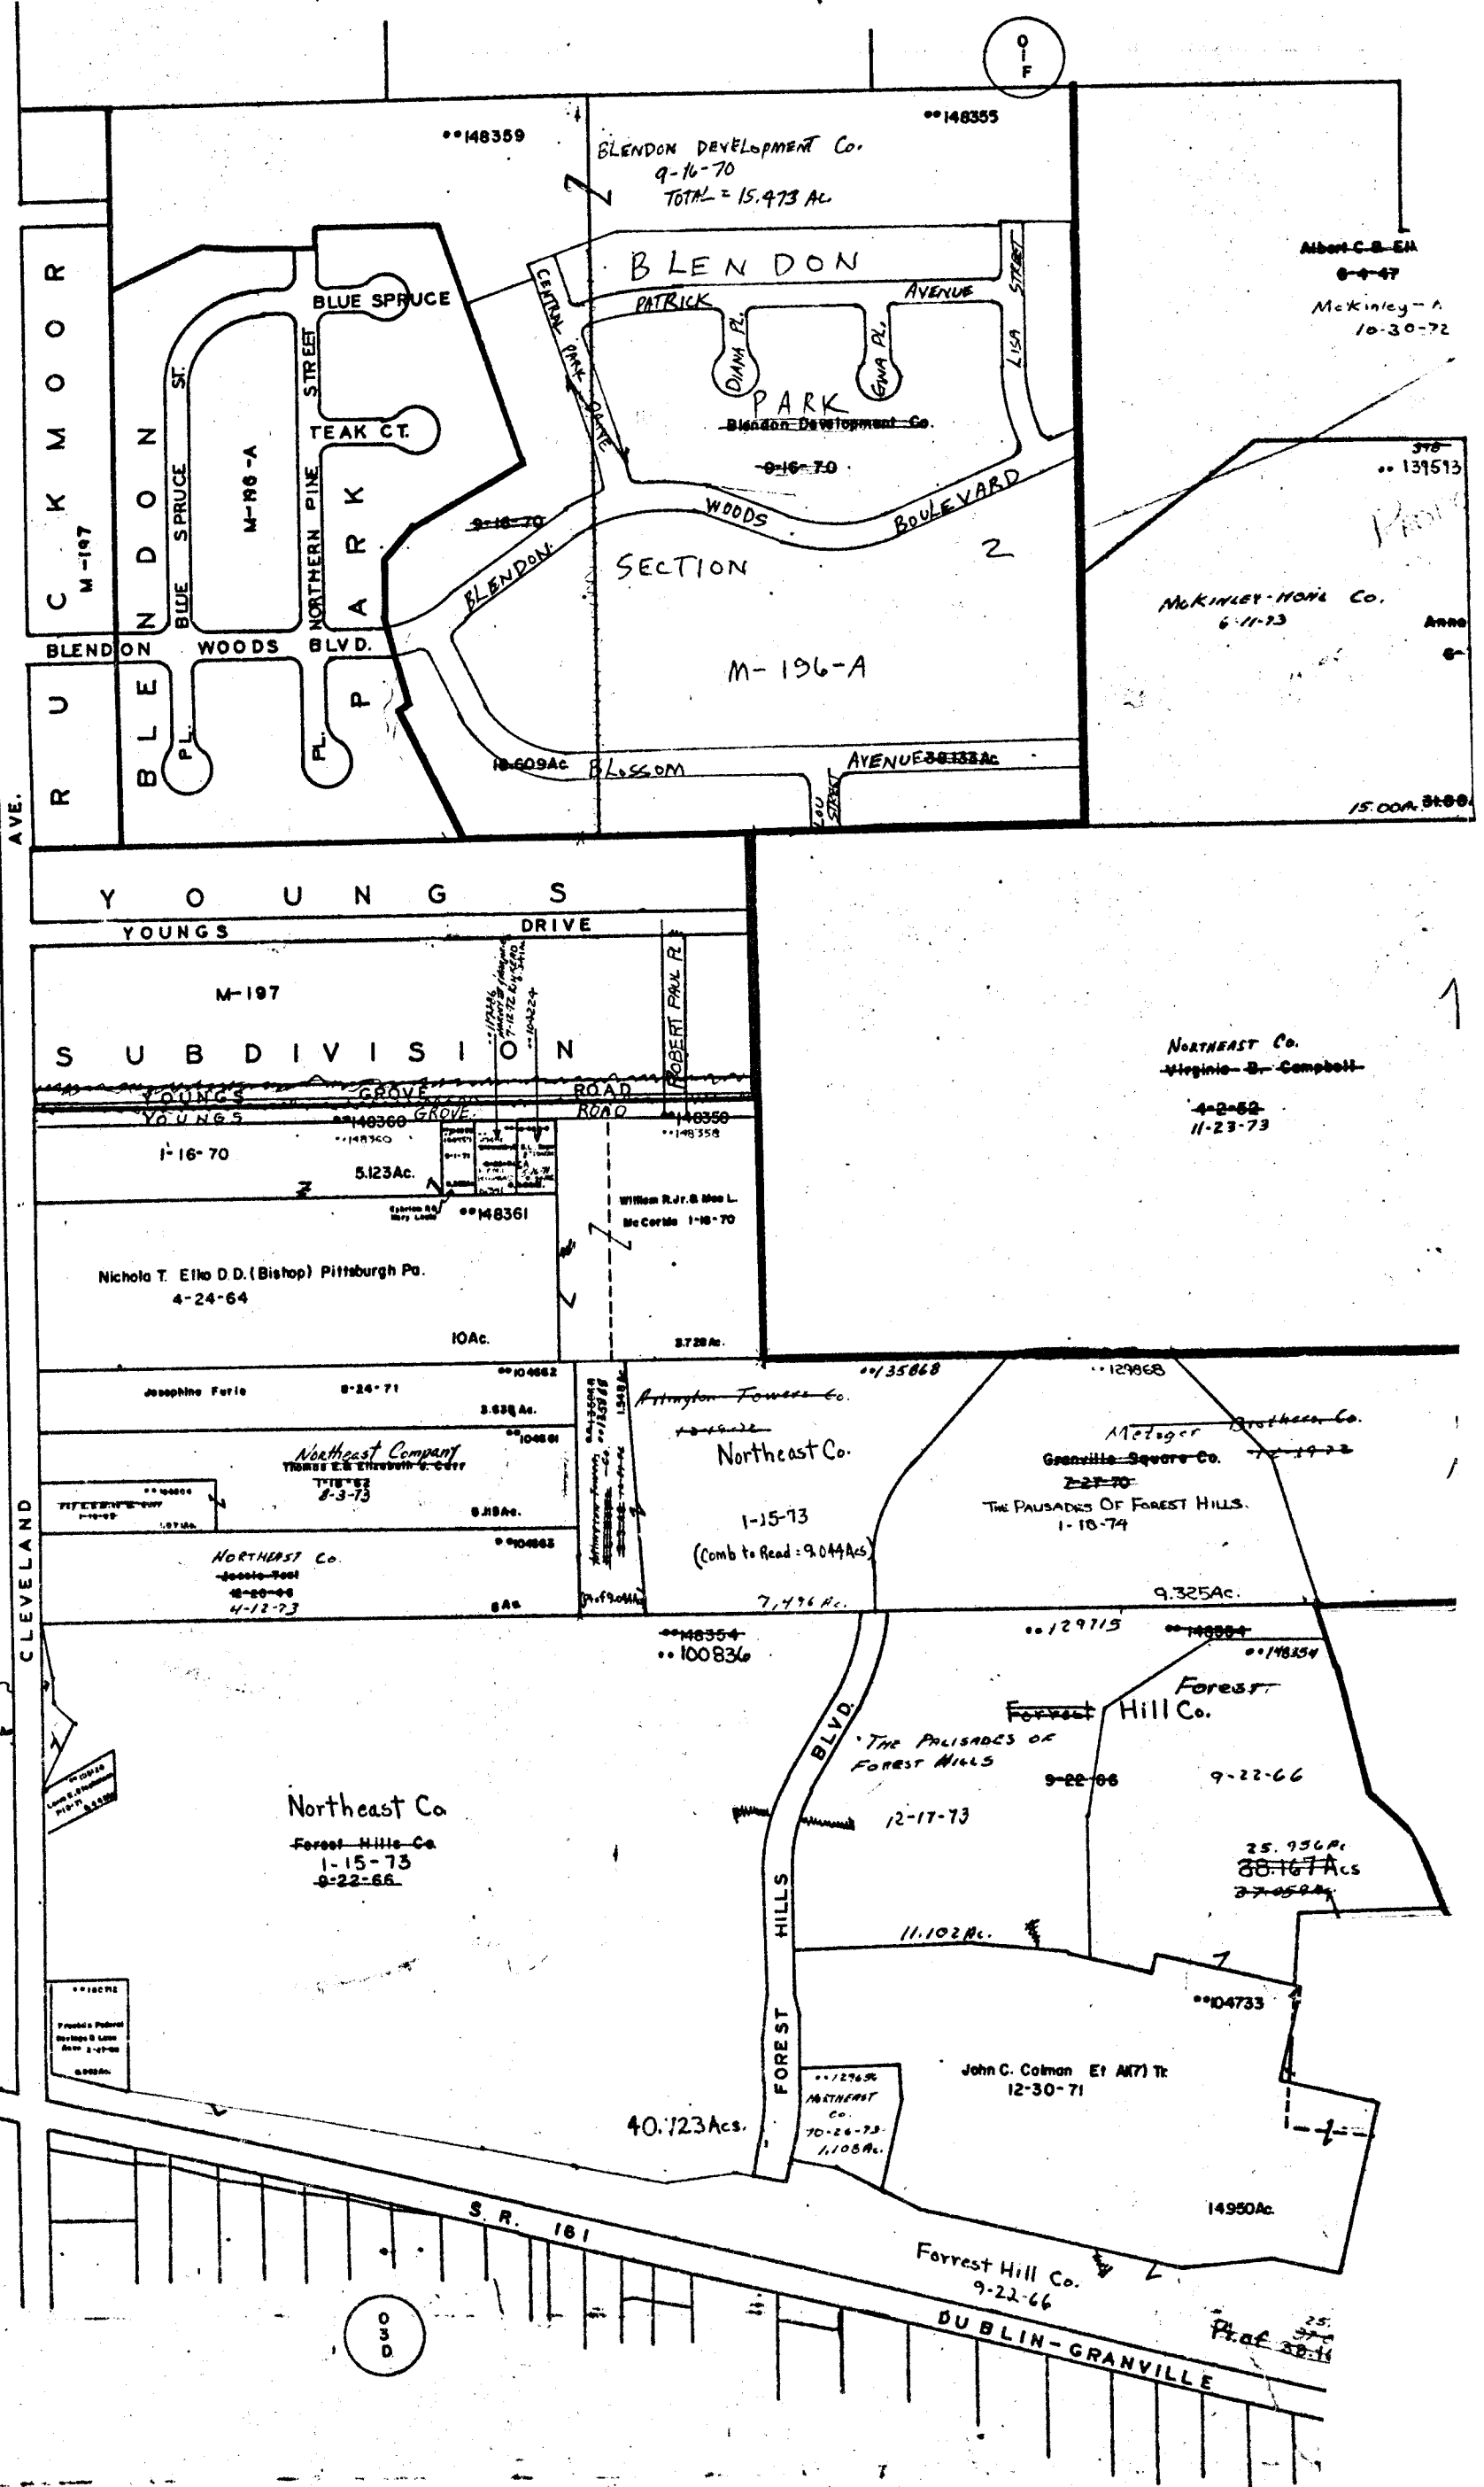

0-3-A
BLENDON TWP
R.17 TWP 2



SCALE 1"=200'
TAXING DISTRICTS
BLENDON
COLS.-WESTERVILLE S.D.

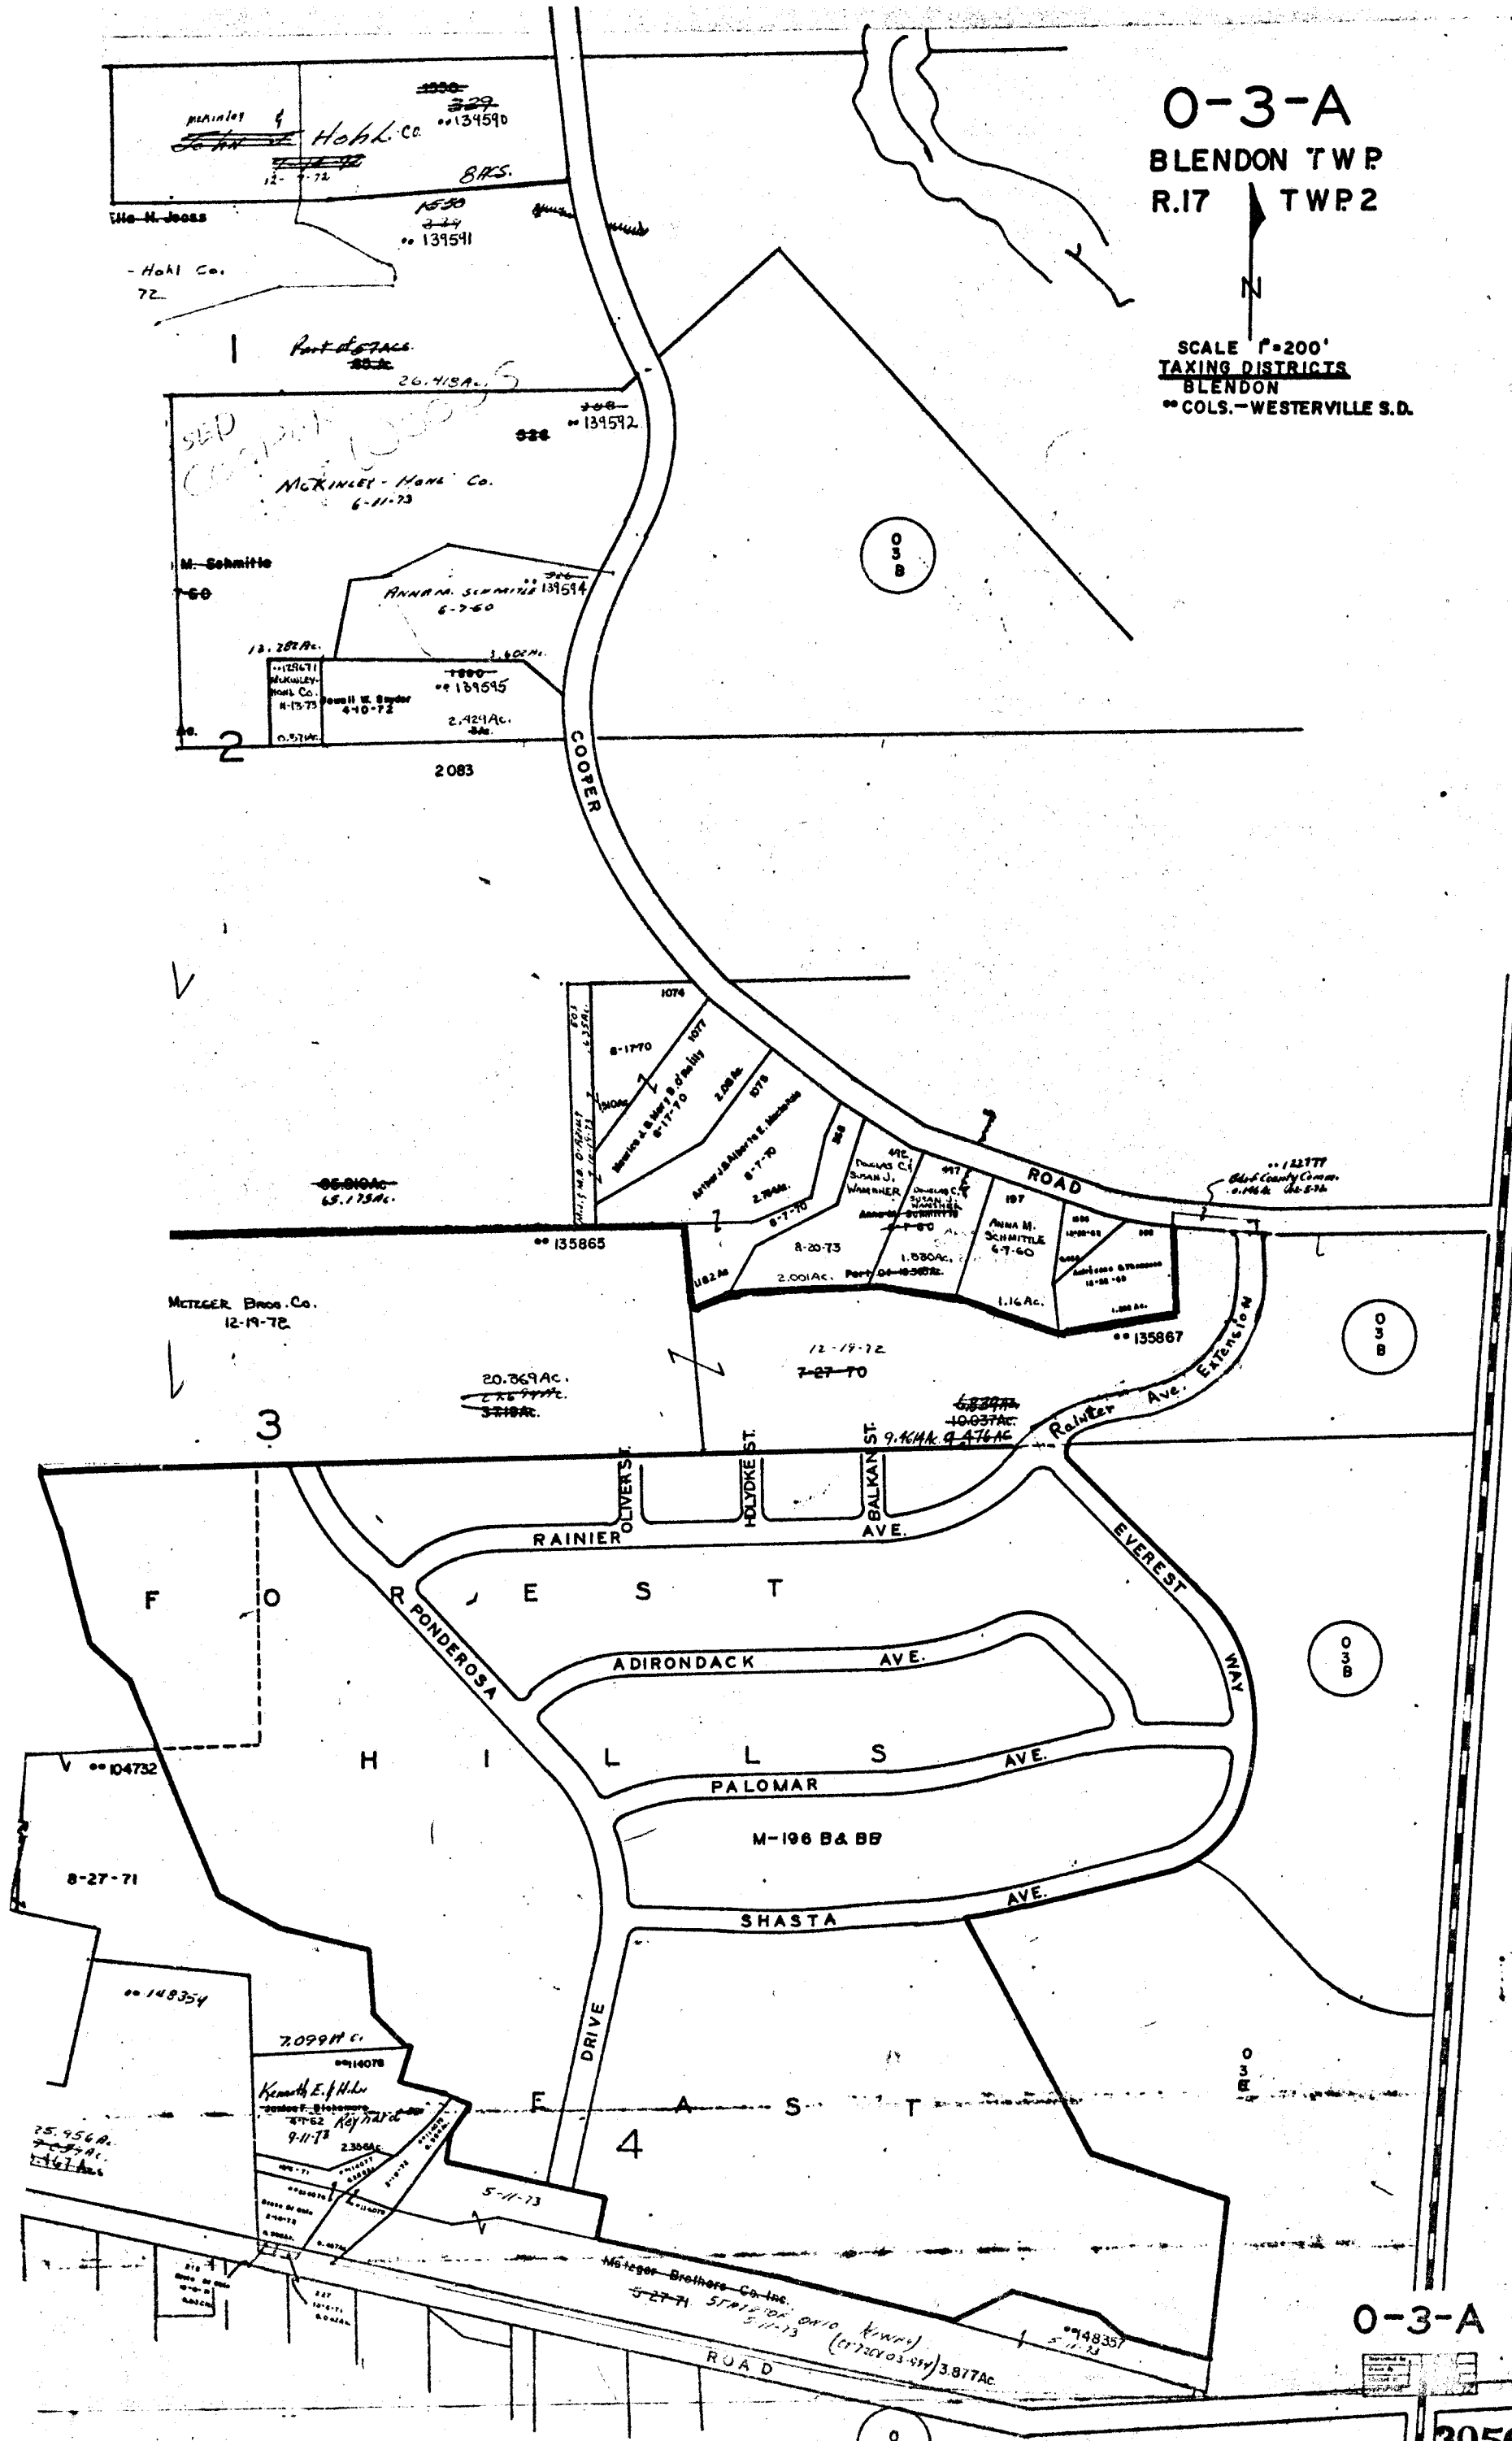

0-3-A