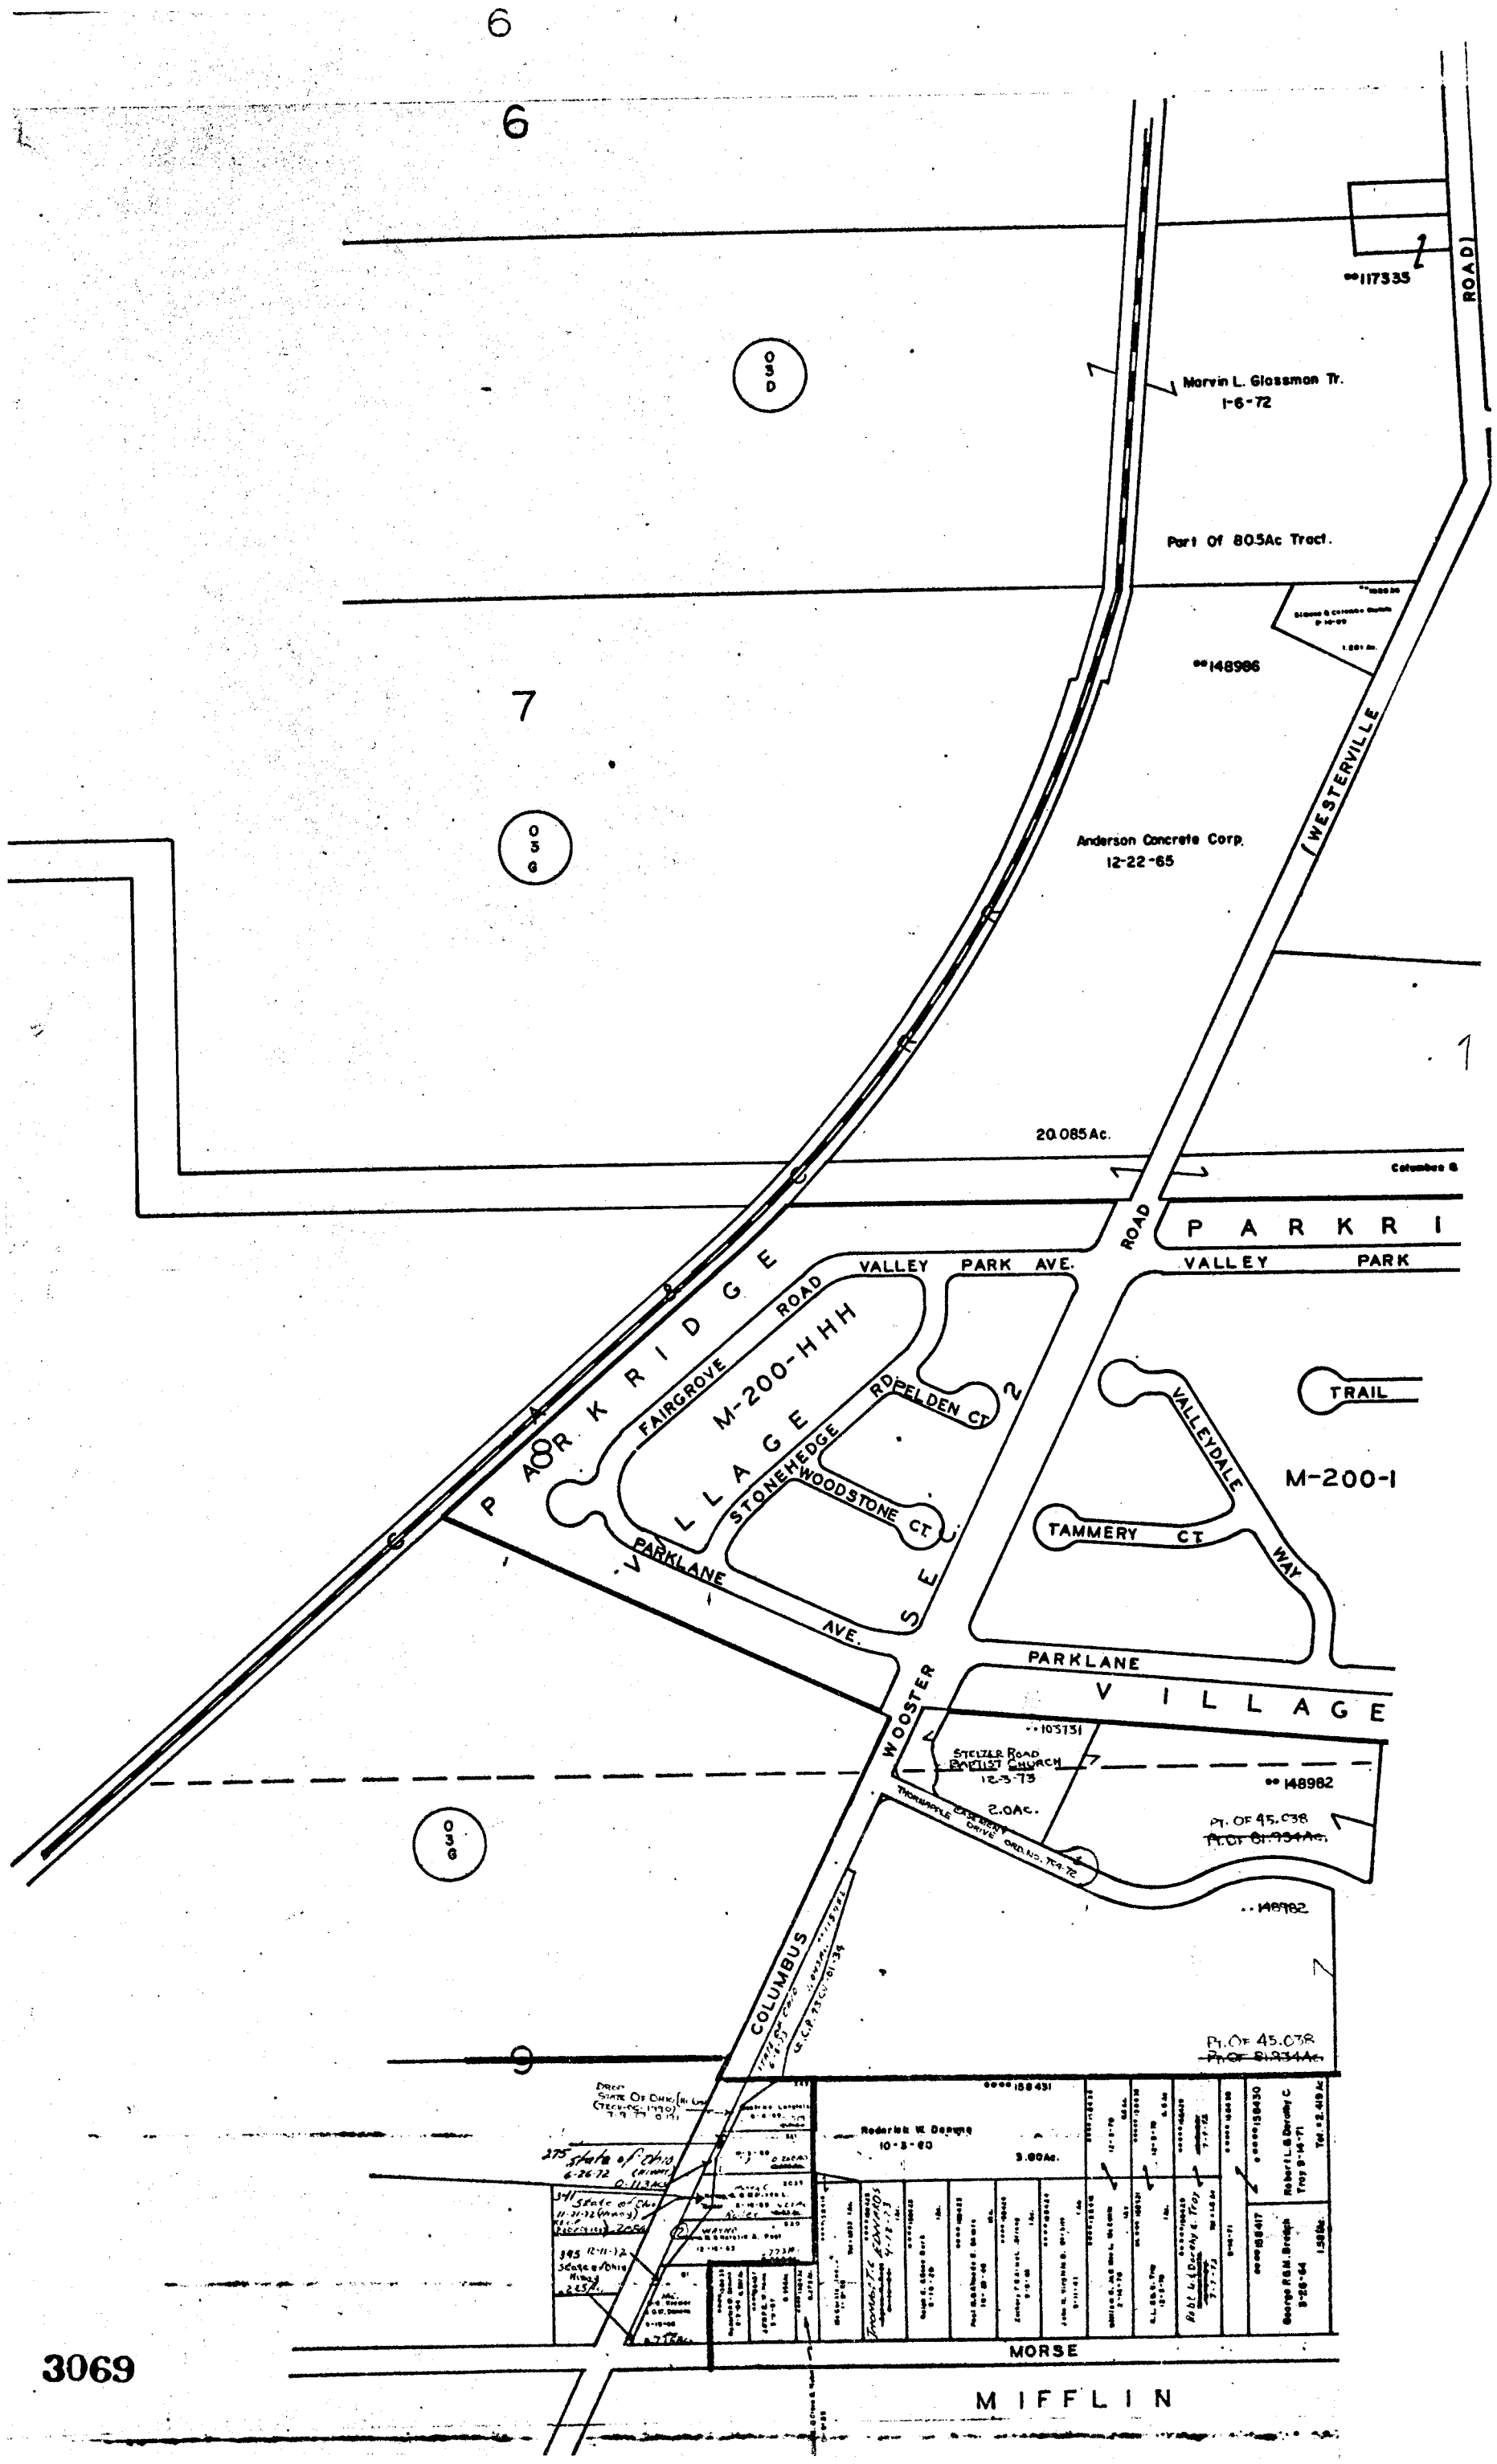
6
6
7
O S D
O S G
Marvin L. Glassman Tr.
1-6-72
Part Of 80.5Ac Tract.
117335
148986
Anderson Concrete Corp.
12-22-65
WESTERVILLE ROAD
20.085Ac.
Columbus &
PARKRIDGE
VALLEY PARK AVE.
VALLEY PARK
FAIRGROVE ROAD
M-200-HHH
VILLAGE
PELDEN CT.
STONEHEDGE
WOODSTONE CT.
PARKLANE AVE.
TRAIL
VALLEYDALE WAY
TAMMERY CT.
M-200-I
PARKLANE
VILLAGE
WOOSTER
STELZER ROAD BAPTIST CHURCH
12-3-73
105731
148982
2.0Ac.
Pt. Of 45.038
Pt. Of 81.934Ac.
THORNAPPLE DRIVE ORD. NO. 764-72
COLUMBUS
158431
Roderick W. Dempsey
10-3-60
3.00Ac.
State of Ohio
6-26-72
0.113Ac.
State of Ohio
11-21-72
2.054
State of Ohio
12-11-72
2.654
Thomas & Edwards
4-12-73
158430
Robert L. & Dorothy C. Troy
9-14-71
Tot. 2.419Ac.
158417
George R.&M. Bridgh
8-26-64
1.598Ac.
MORSE
MIFFLIN

3069

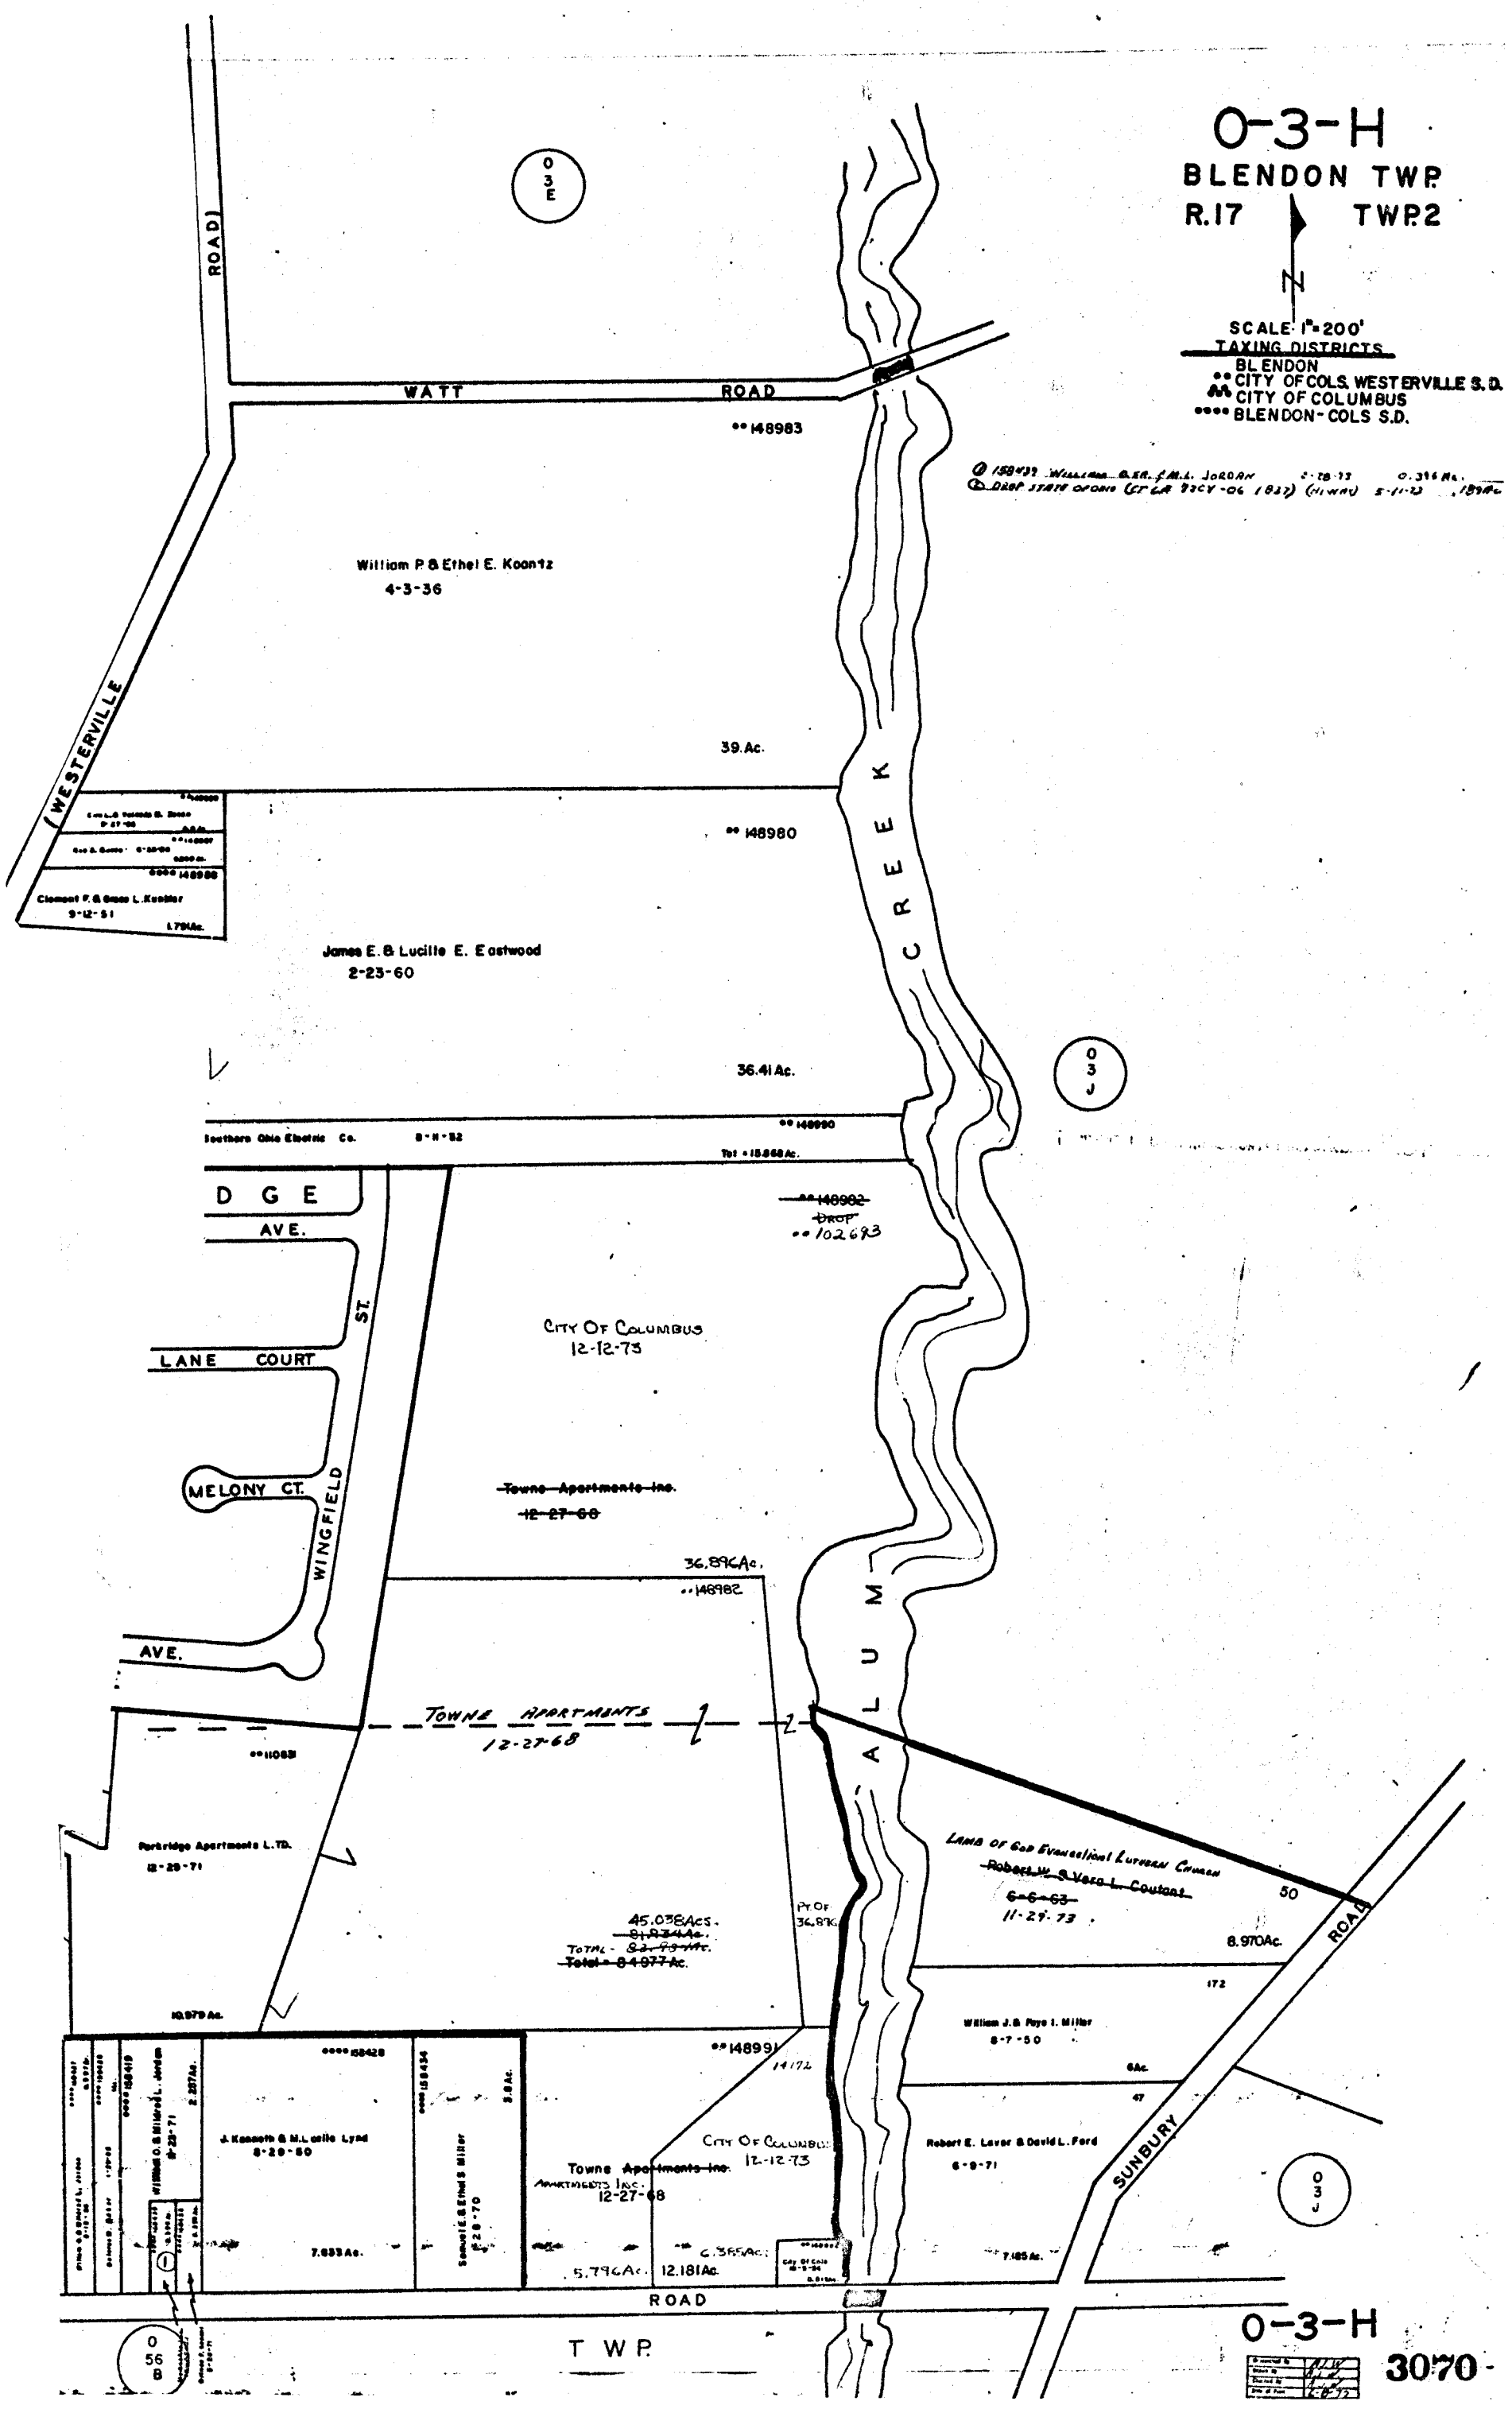
0-3-H
BLENDON TWP.
R.17
TWP.2
N
SCALE 1"=200'
TAXING DISTRICTS
BLENDON
•• CITY OF COLS. WESTERVILLE S.D.
CITY OF COLUMBUS
•••• BLENDON-COLS S.D.
WATT ROAD
•• 148983
William P. & Ethel E. Koontz
4-3-36
39.Ac.
WESTERVILLE ROAD
•• 148980
James E. & Lucille E. Eastwood
2-23-60
36.41 Ac.
Southern Ohio Electric Co.
DGE AVE.
LANE COURT
MELONY CT.
WINGFIELD ST.
AVE.
City Of Columbus
12-12-73
Towne Apartments Inc.
12-27-68
36.896Ac.
•• 148982
TOWNE APARTMENTS
12-27-68
Parkridge Apartments L.TD.
12-29-71
45.038Acs.
Total - 83.934Ac.
Total = 84.977Ac.
Pt. Of 36.896
Lamb Of God Evangelical Lutheran Church
11-29-73
8.970Ac.
William J. & Faye I. Miller
8-7-50
Robert E. Laver & David L. Ford
6-9-71
7.185Ac.
SUNBURY ROAD
•• 148991
14.172
J. Kenneth & M. Lucile Lynd
8-29-50
7.653Ac.
Samuel E. & Ethel S. Miller
5.796Ac.
12.181Ac.
6.365Ac.
ROAD
T W P.
0-3-H
3070