

C
A
O

DUBLIN

GRANVILLE


















O
4
H

R
4
O


O
4
E

O-4-F
BLENDON TWP.
R17 TWP2



SCALE 1" = 200'
TAXING DISTRICTS
BLENDON TWP.
•• COLS. - WESTERVILLE SD
••• COLS. - BLENDON TWP - PLAIN SD
•••• COLS. - PLAIN SD

0
4
C

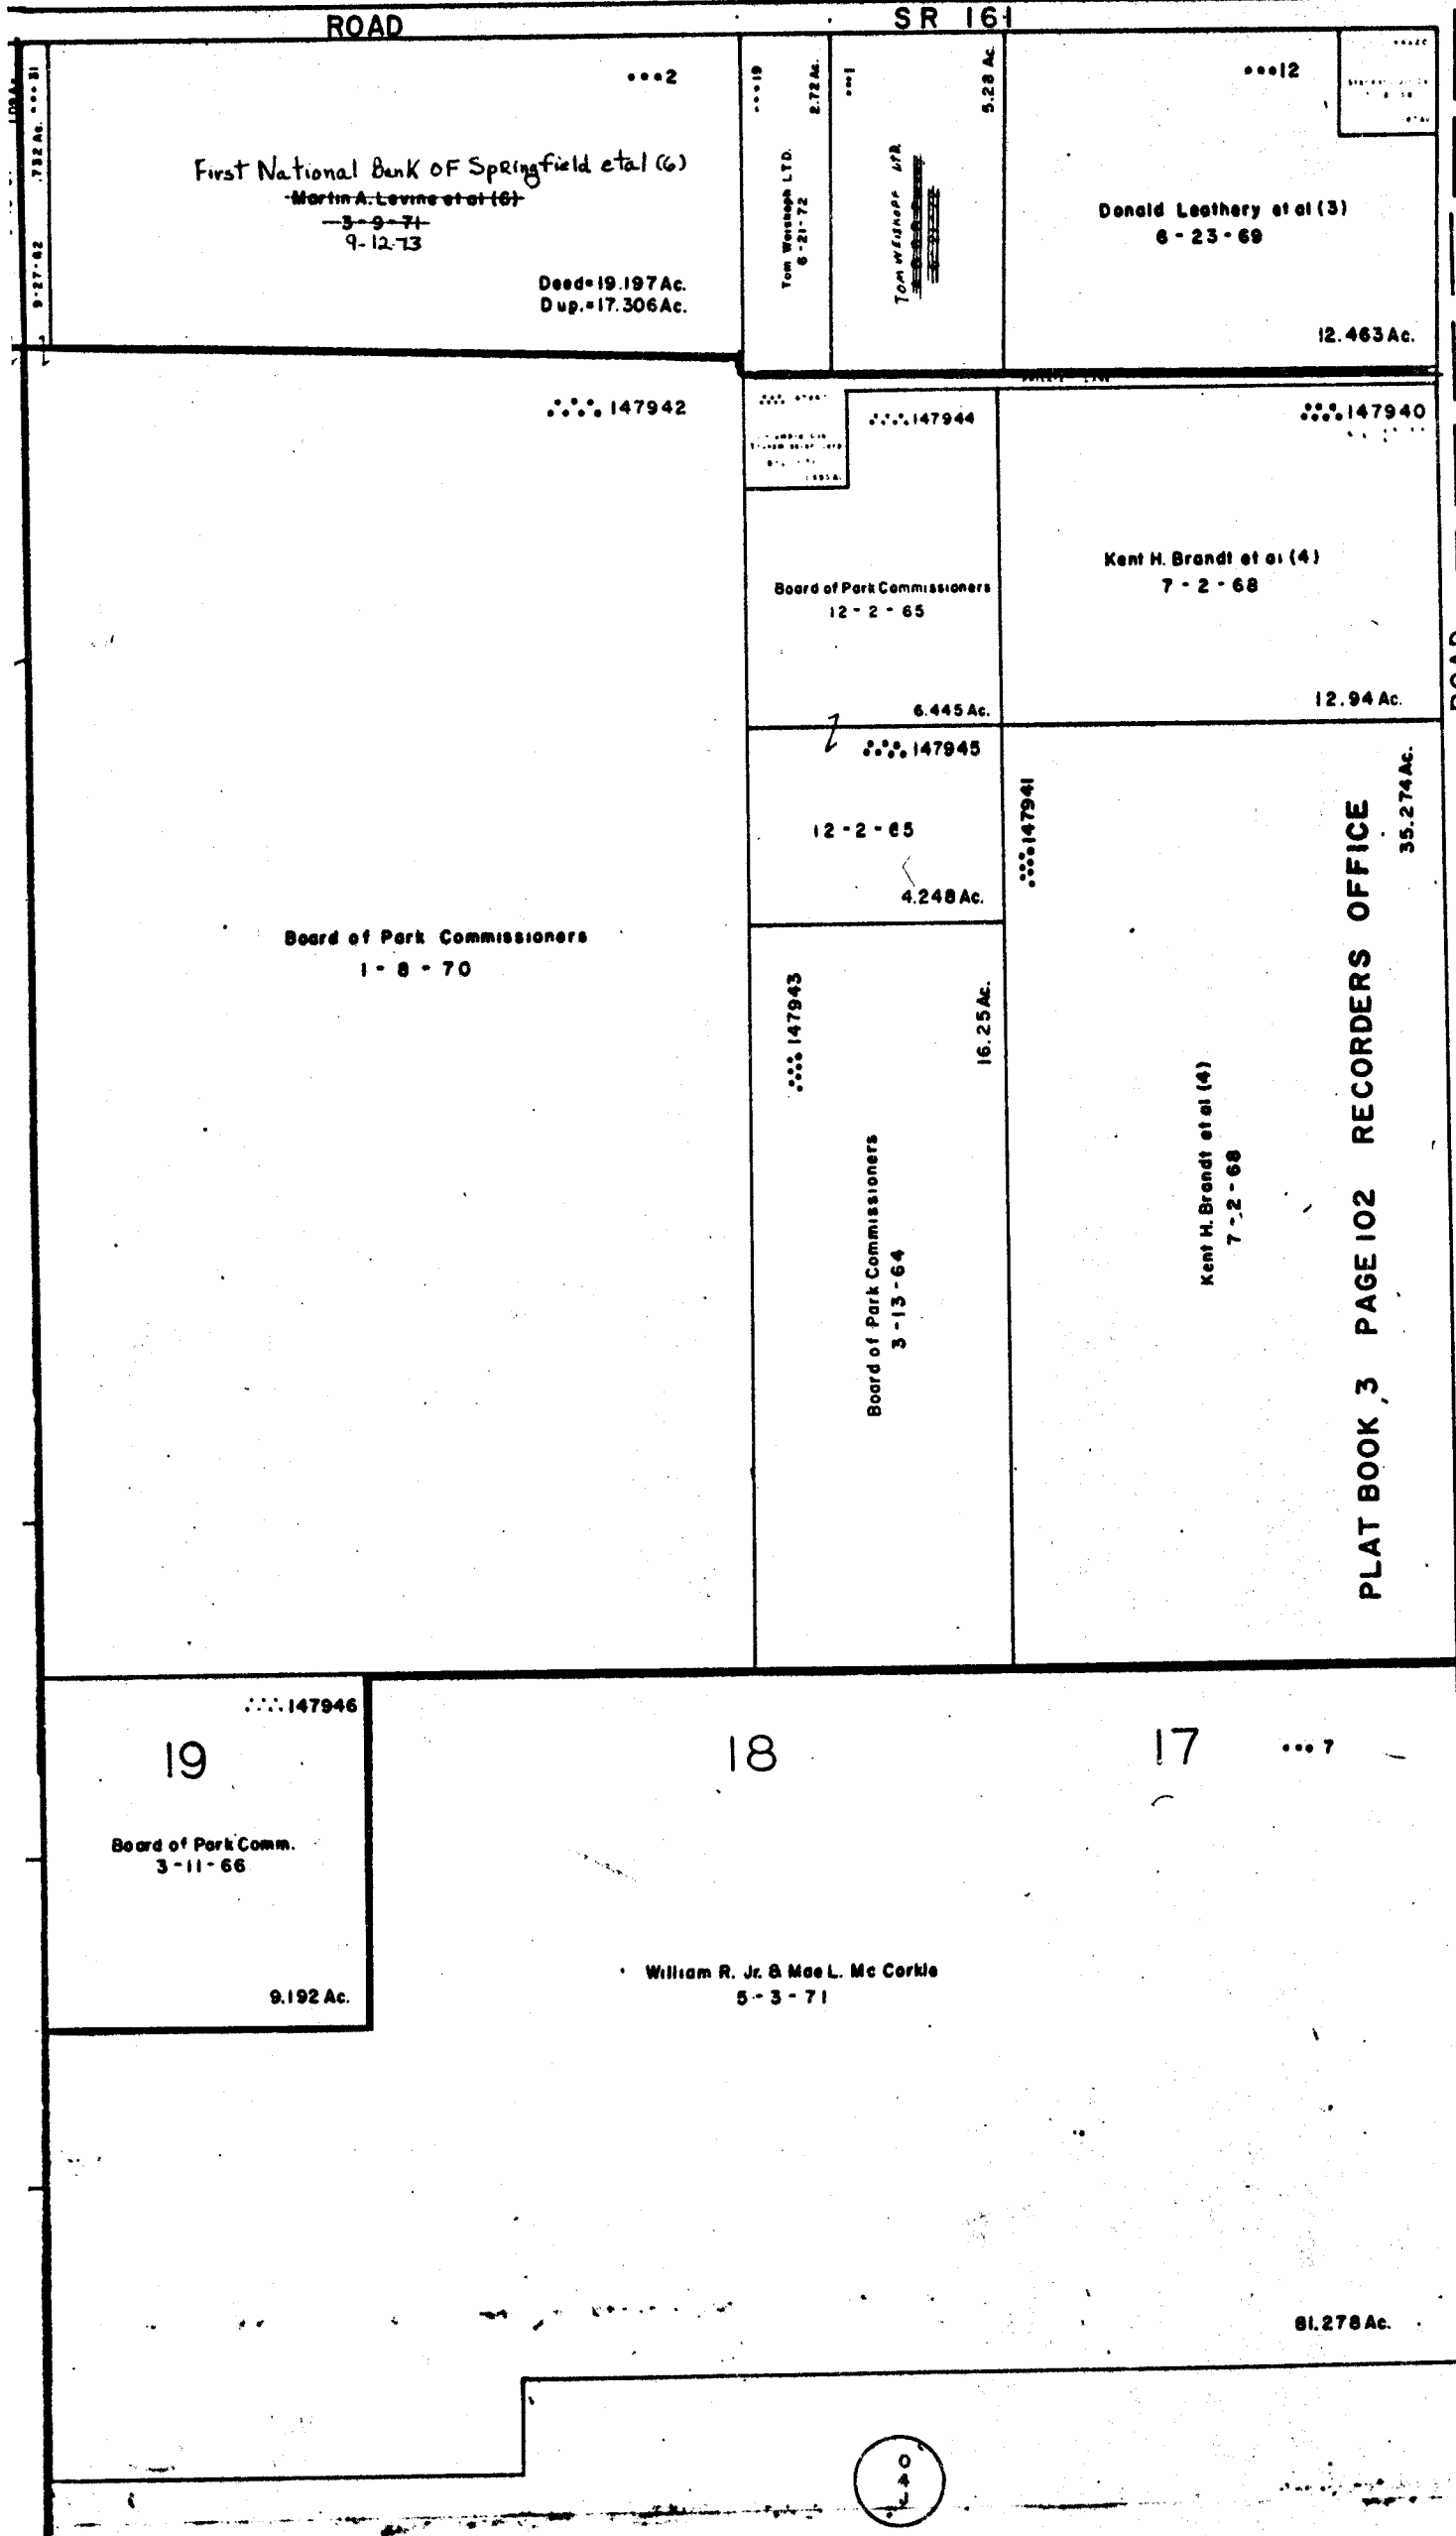

R.
W
T

0
75

N
I
A
L
P

ROAD
HAMILTON ROAD

PLAT BOOK 3 PAGE 102 RECORDERS OFFICE

3086
O-4-F

0
4
C