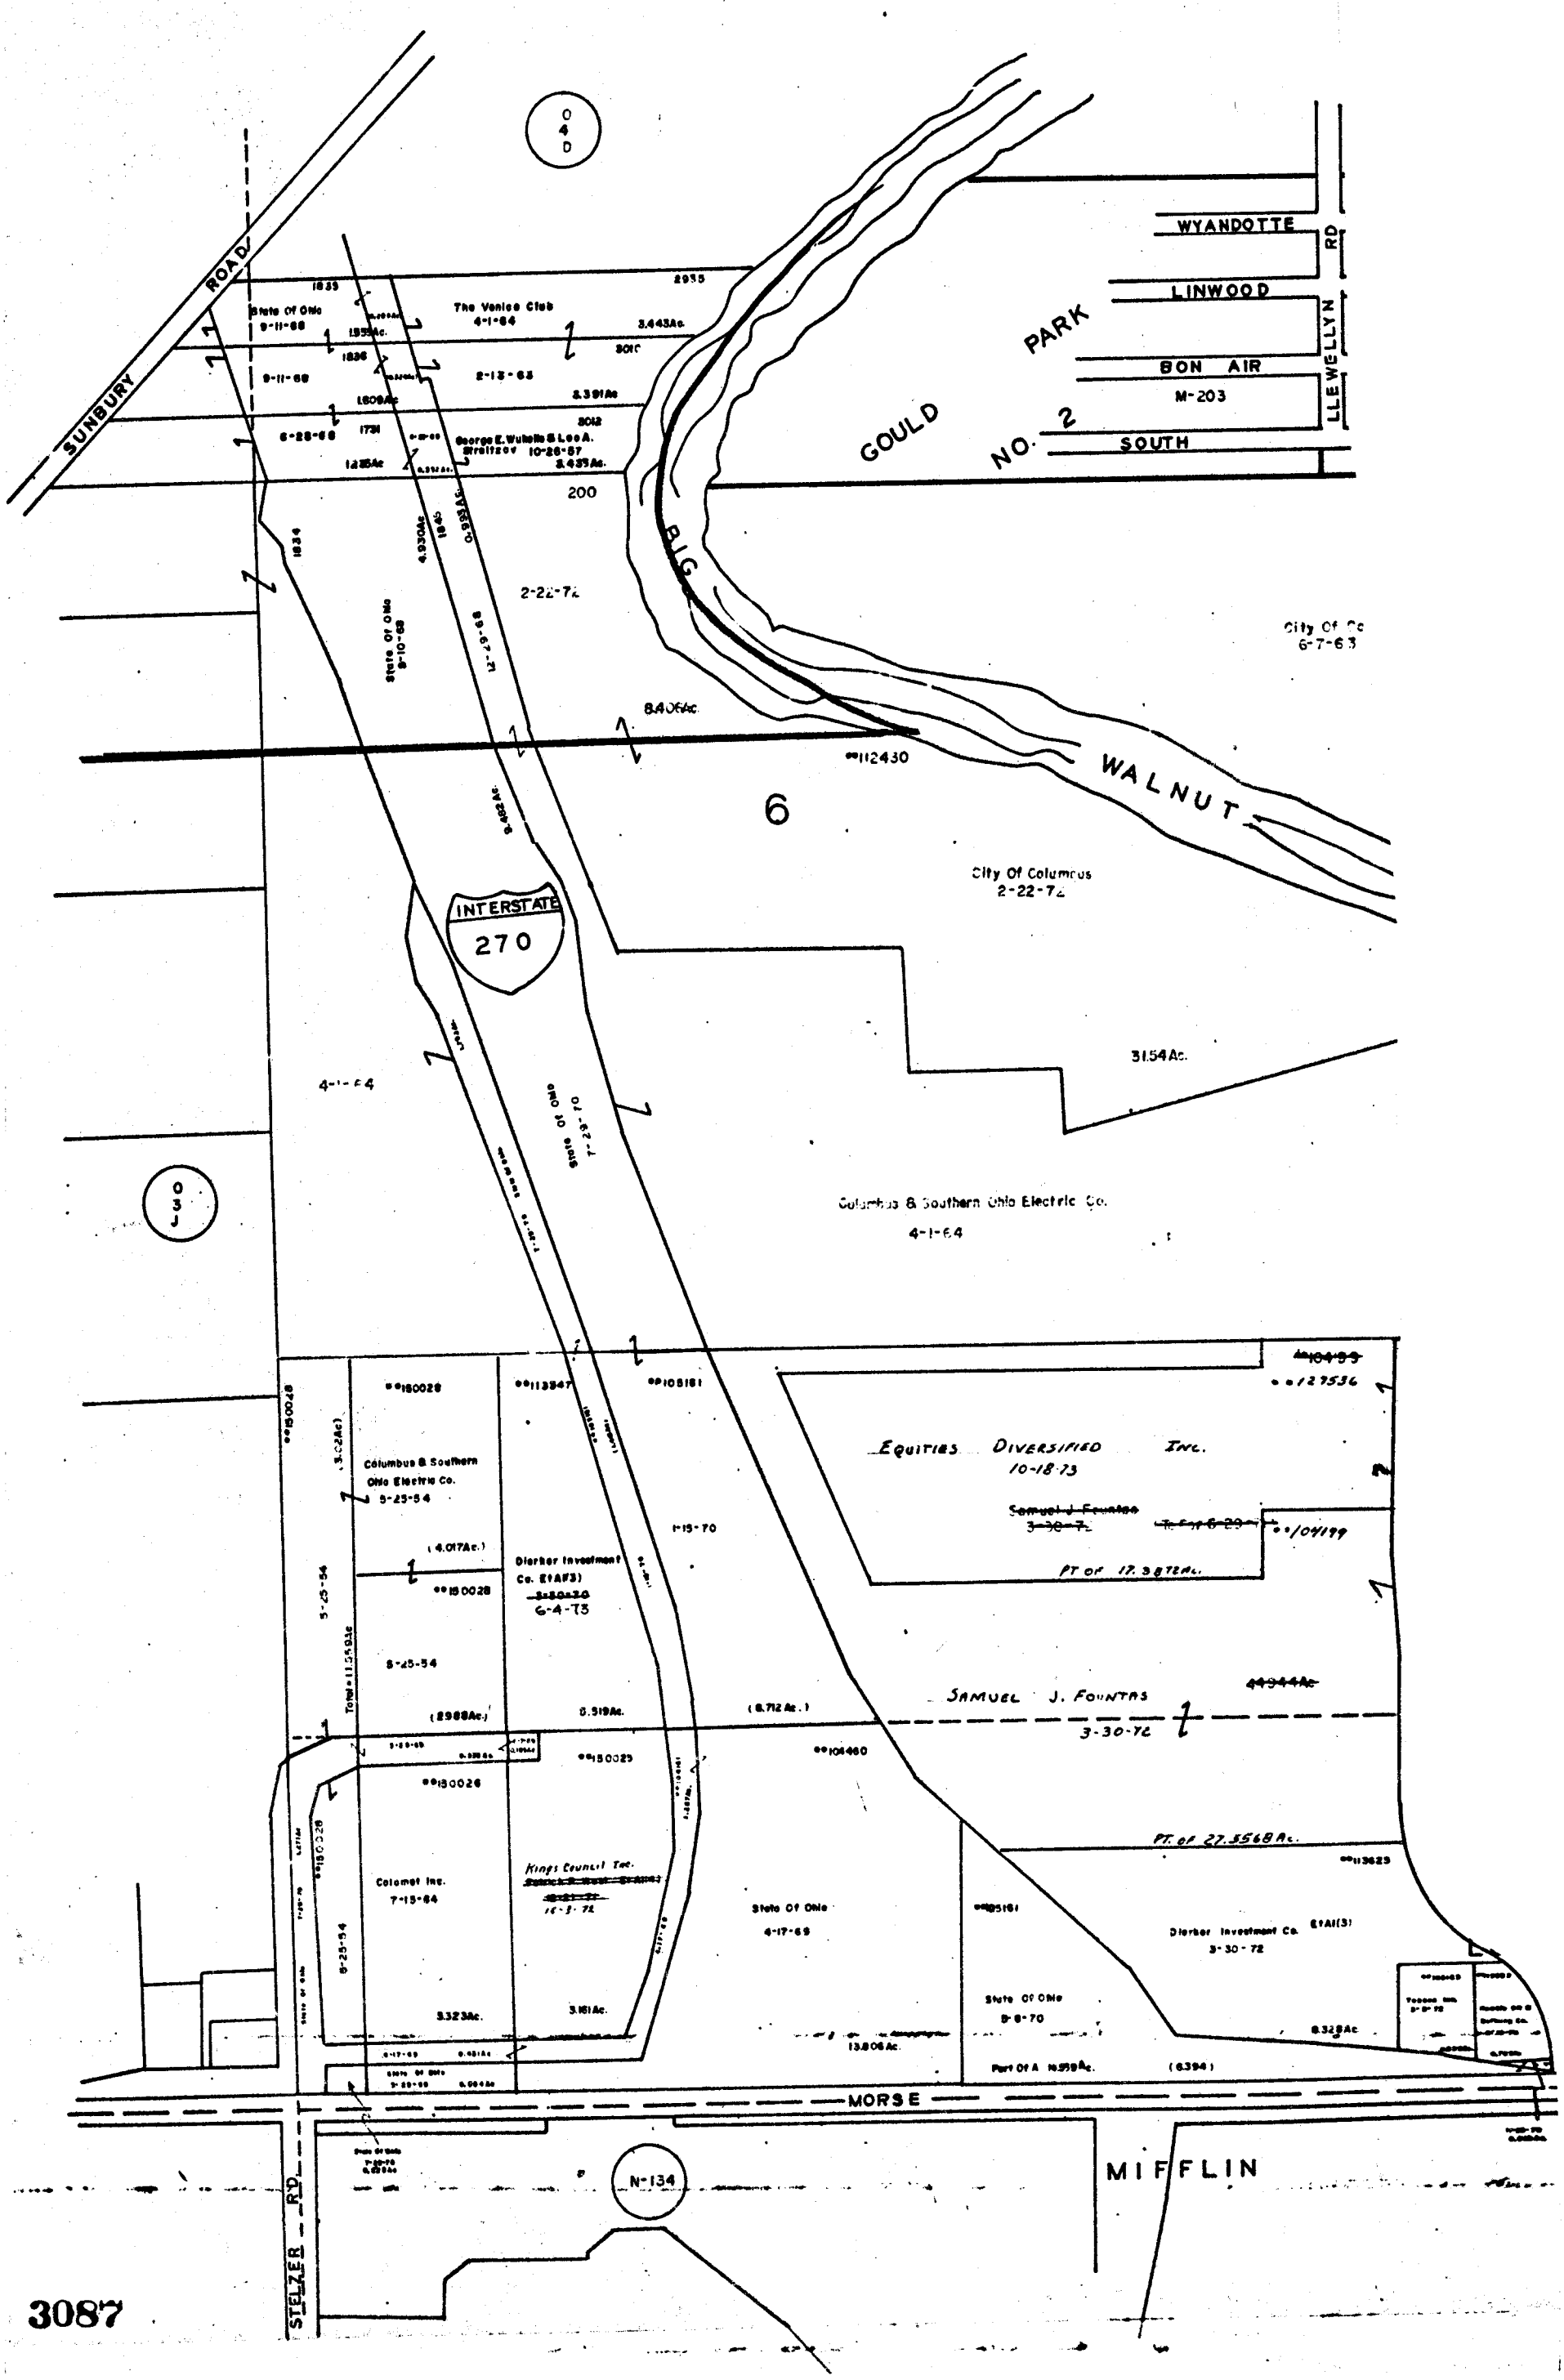
SUNBURY ROAD
WYANDOTTE
LINWOOD
BON AIR
M-203
SOUTH
LLEWELLYN RD
GOULD PARK
NO. 2
BIG WALNUT
City Of Columbus
2-22-72
INTERSTATE 270
Columbus & Southern Ohio Electric Co.
4-1-64
EQUITIES DIVERSIFIED INC.
10-18-73
SAMUEL J. FOUNTAS
3-30-72
PT. OF 27.3568 Ac.
Colomet Inc.
7-15-64
Kings Council Inc.
State Of Ohio
4-17-69
Diarbar Investment Co.
3-30-72
MORSE
MIFFLIN
STELZER RD
N-134

3087

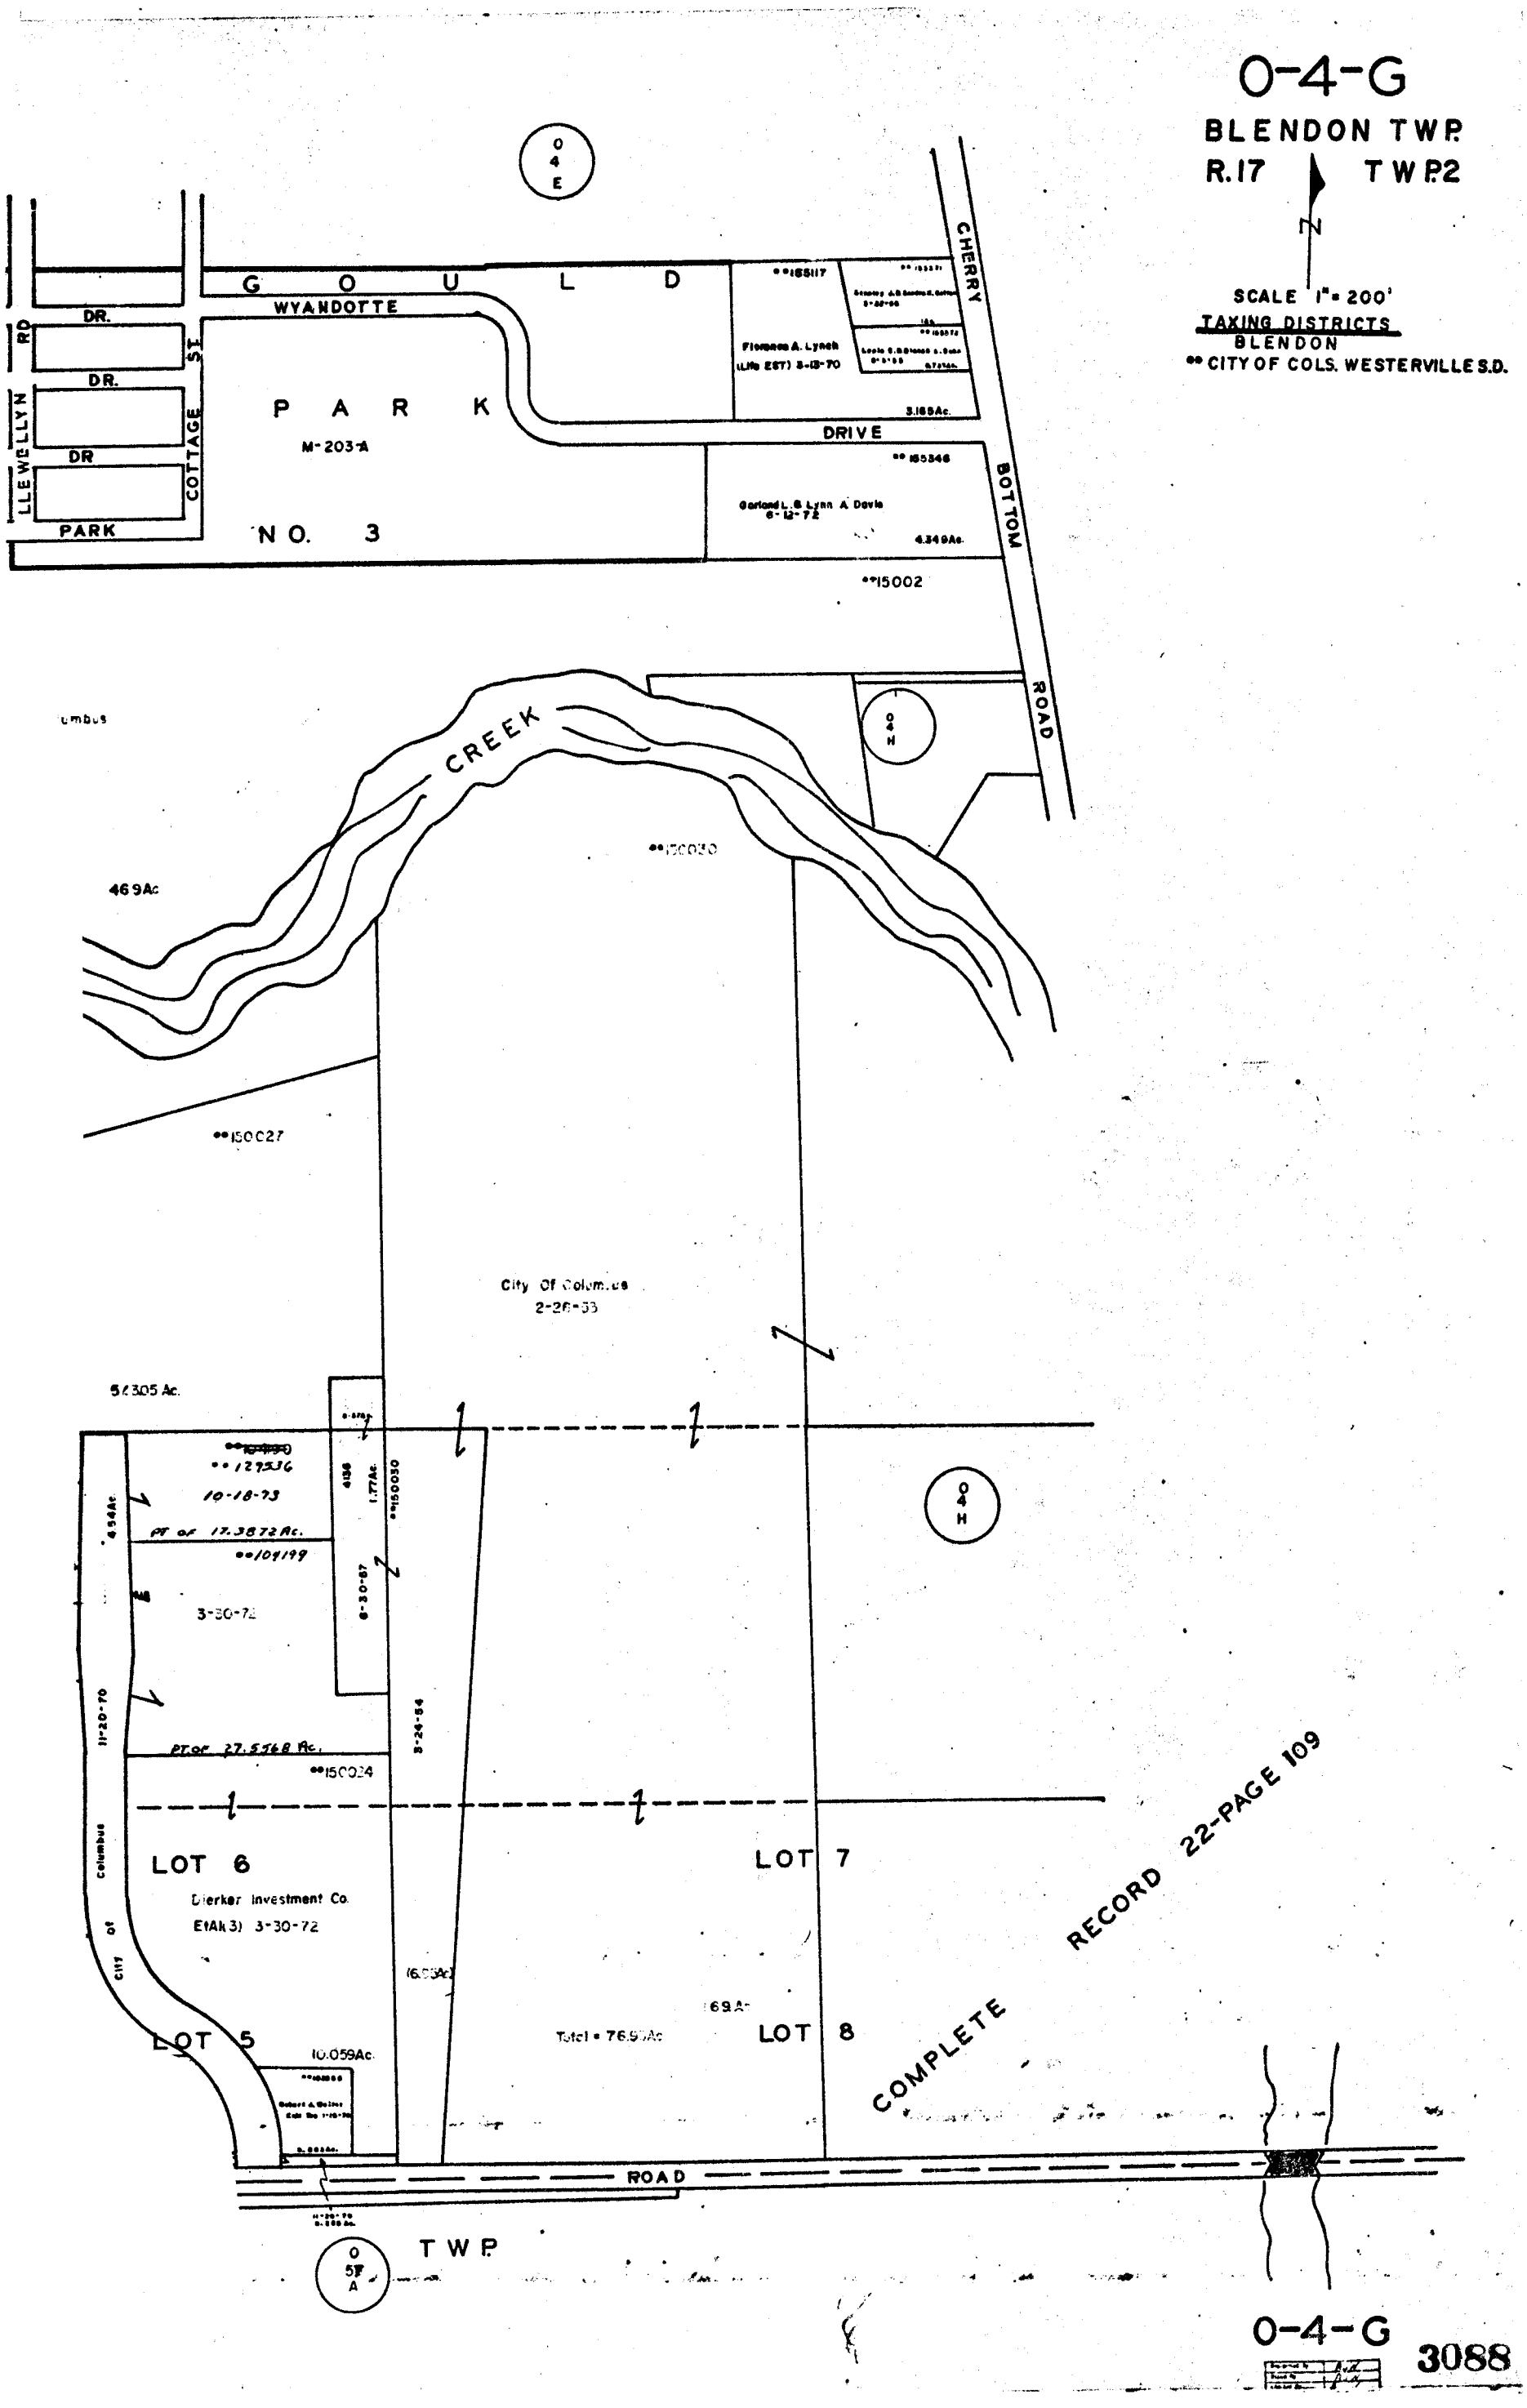
0-4-G
BLENDON TWP.
R.17
TWP.2
N
SCALE 1" = 200'
TAXING DISTRICTS
BLENDON
** CITY OF COLS. WESTERVILLE S.D.
0 4 E
G O U L D
WYANDOTTE
DR.
DR.
DR
PARK
LLEWELLYN RD
COTTAGE ST
P A R K
M-203-A
N O. 3
**165117
Florence A. Lynch
(Life EST) 3-13-70
3.169Ac.
DRIVE
**155346
Garland L. & Lynn A. Davis
6-12-72
4.349Ac.
**15002
CHERRY
BOTTOM
ROAD
0 4 H
CREEK
**150030
46.9Ac
**150027
City Of Columbus
2-26-53
56.305 Ac.
**127536
10-18-73
PT of 17.3872 Ac.
**109199
3-30-72
PT of 27.5568 Ac.
**150024
4.54Ac.
4.136
1.77Ac.
**150030
6-30-67
3-24-54
11-20-70
City of Columbus
LOT 6
Dierker Investment Co.
Et Al(3) 3-30-72
LOT 5
10.059Ac.
LOT 7
LOT 8
Total = 76.9Ac
COMPLETE RECORD 22-PAGE 109
ROAD
TWP
0 5F A
0-4-G
3088