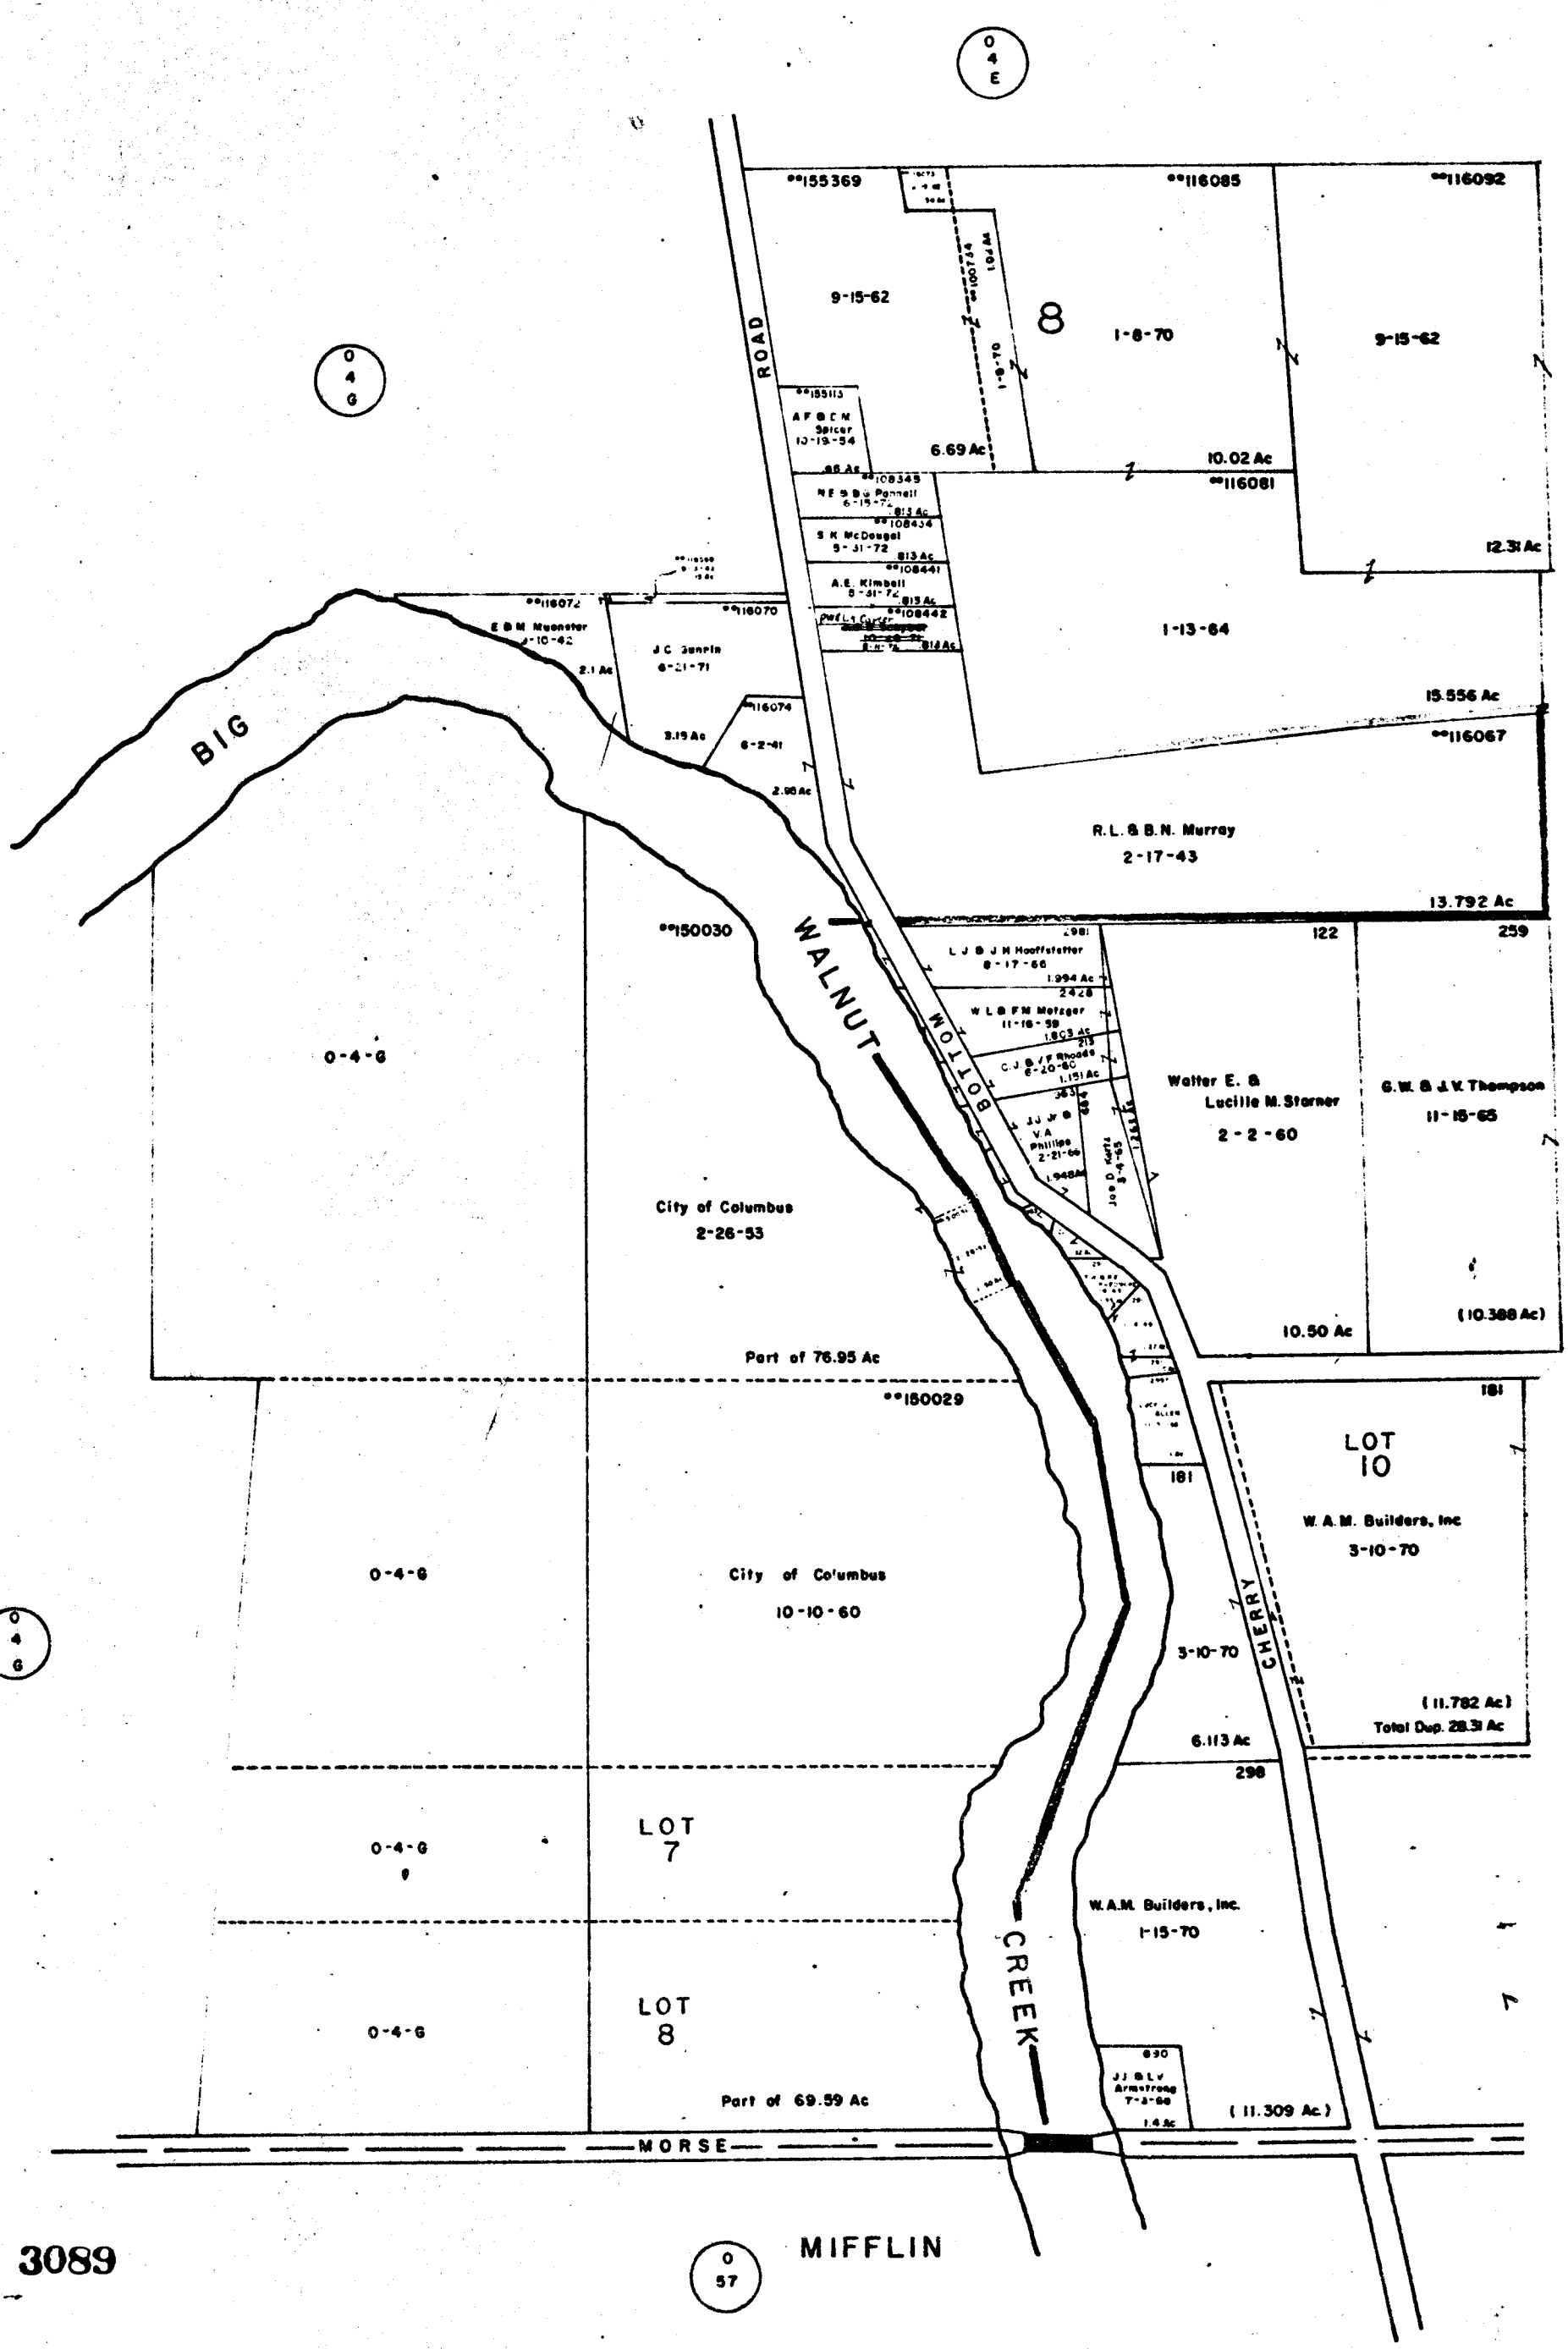
0 4 E
0 4 G
0 4 G
0 57
ROAD
BIG
WALNUT
BOTTOM
CREEK
CHERRY
MORSE
MIFFLIN
**155369
9-15-62
8
1-8-70
**116085
**116092
9-15-62
6.69 Ac
10.02 Ac
**116081
12.31 Ac
1-13-64
15.556 Ac
**116067
R.L. & B.N. Murray
2-17-43
13.792 Ac
**155113
A F & C M Spicer 10-19-54
.98 Ac
**108345
N E & B G Pannell 6-15-72
.813 Ac
**108434
S K McDougal 5-31-72
.813 Ac
**108441
A.E. Kimball 5-31-72
.813 Ac
**108442
.813 Ac
**116072
E & M Muenster 4-10-42
2.1 Ac
**116070
J C Sunpin 6-21-71
3.19 Ac
**116074
6-2-41
2.98 Ac
**150030
0-4-G
City of Columbus
2-26-53
Part of 76.95 Ac
**150029
0-4-G
City of Columbus
10-10-60
LOT 7
0-4-G
LOT 8
0-4-G
Part of 69.59 Ac
L J & J H Hoeffstetter 8-17-66
1.994 Ac
W L & F M Metzger 11-16-59
1.803 Ac
C J & V F Rhoades 6-20-60
1.151 Ac
J J Jr & V A Phillips 2-21-66
1.948 Ac
Joe D Kurtz 8-4-65
122
Walter E. & Lucille M. Starner
2-2-60
10.50 Ac
259
G.W. & J.V. Thompson
11-15-65
(10.388 Ac)
181
LOT 10
W.A.M. Builders, Inc
3-10-70
(11.782 Ac)
Total Dup. 28.31 Ac
3-10-70
6.113 Ac
298
W.A.M. Builders, Inc.
1-15-70
690
J J & L V Armstrong 7-3-68
1.4 Ac
(11.309 Ac)

O-4-H

BLENDON TWP.

R.17 TWP. 2

N

SCALE 1" = 200'

TAXING DISTRICTS
BLENDON TWP.
**COLS.-WESTERVILLE S.D.

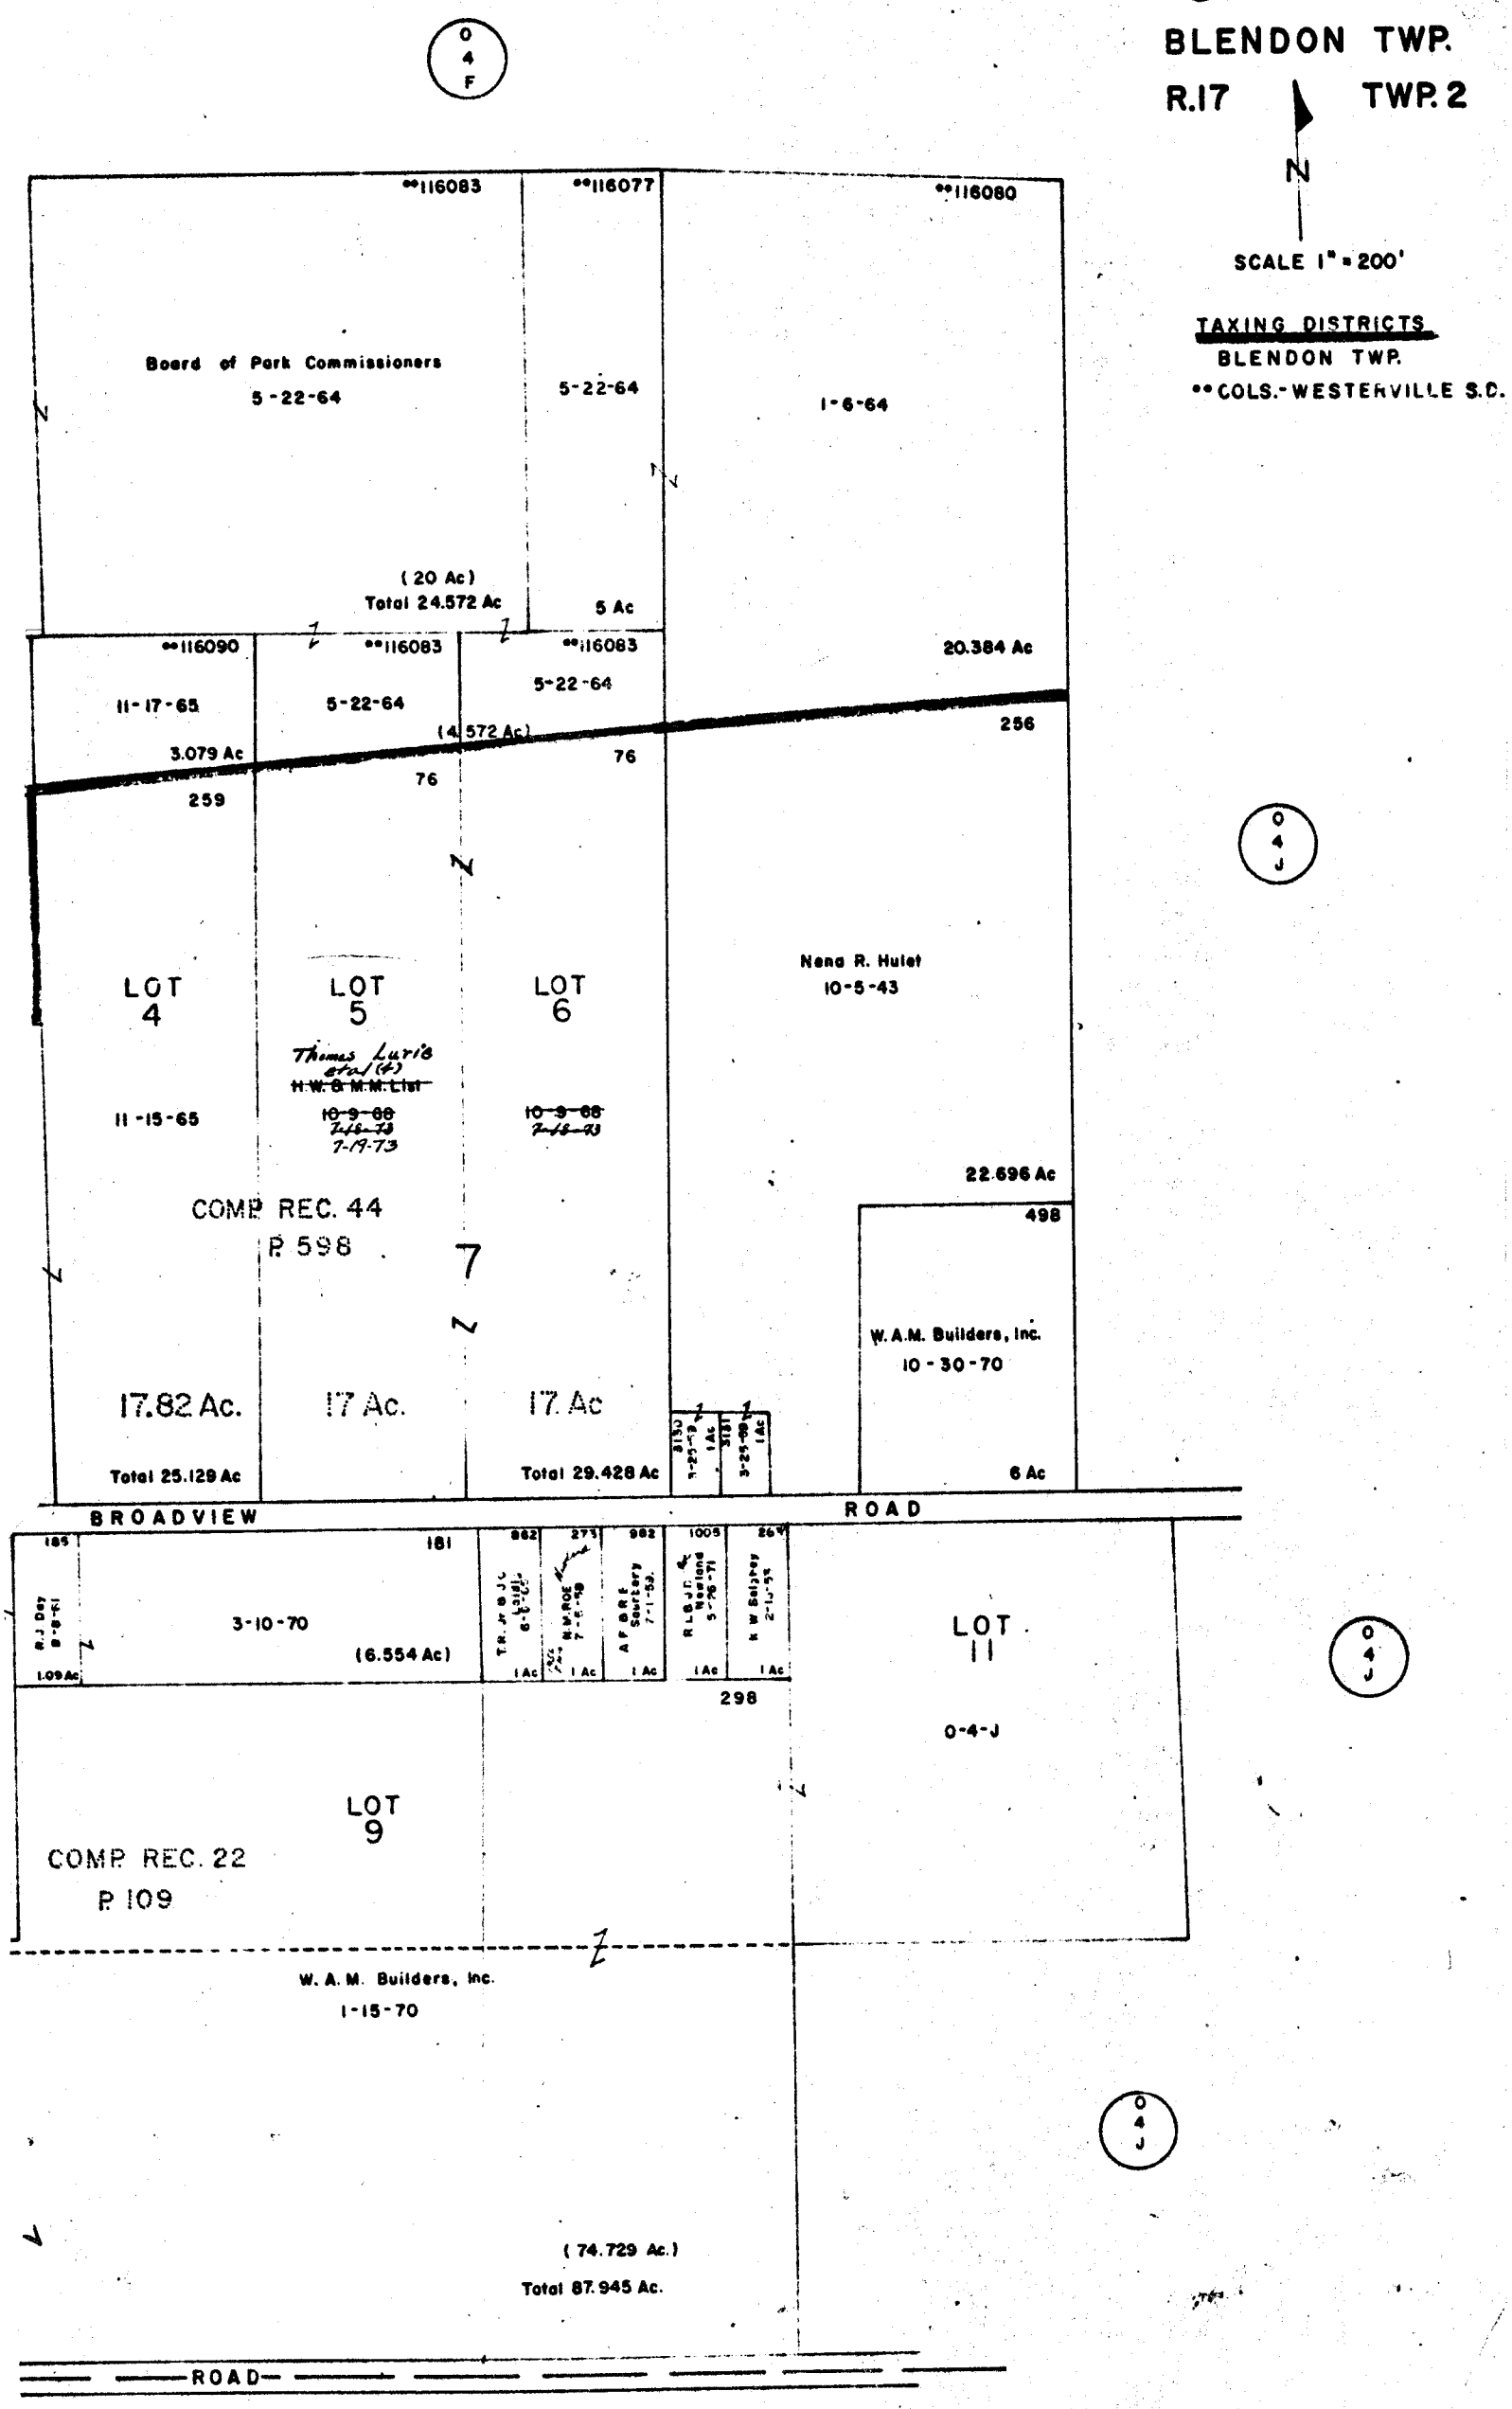

O-4-H
3090