12A

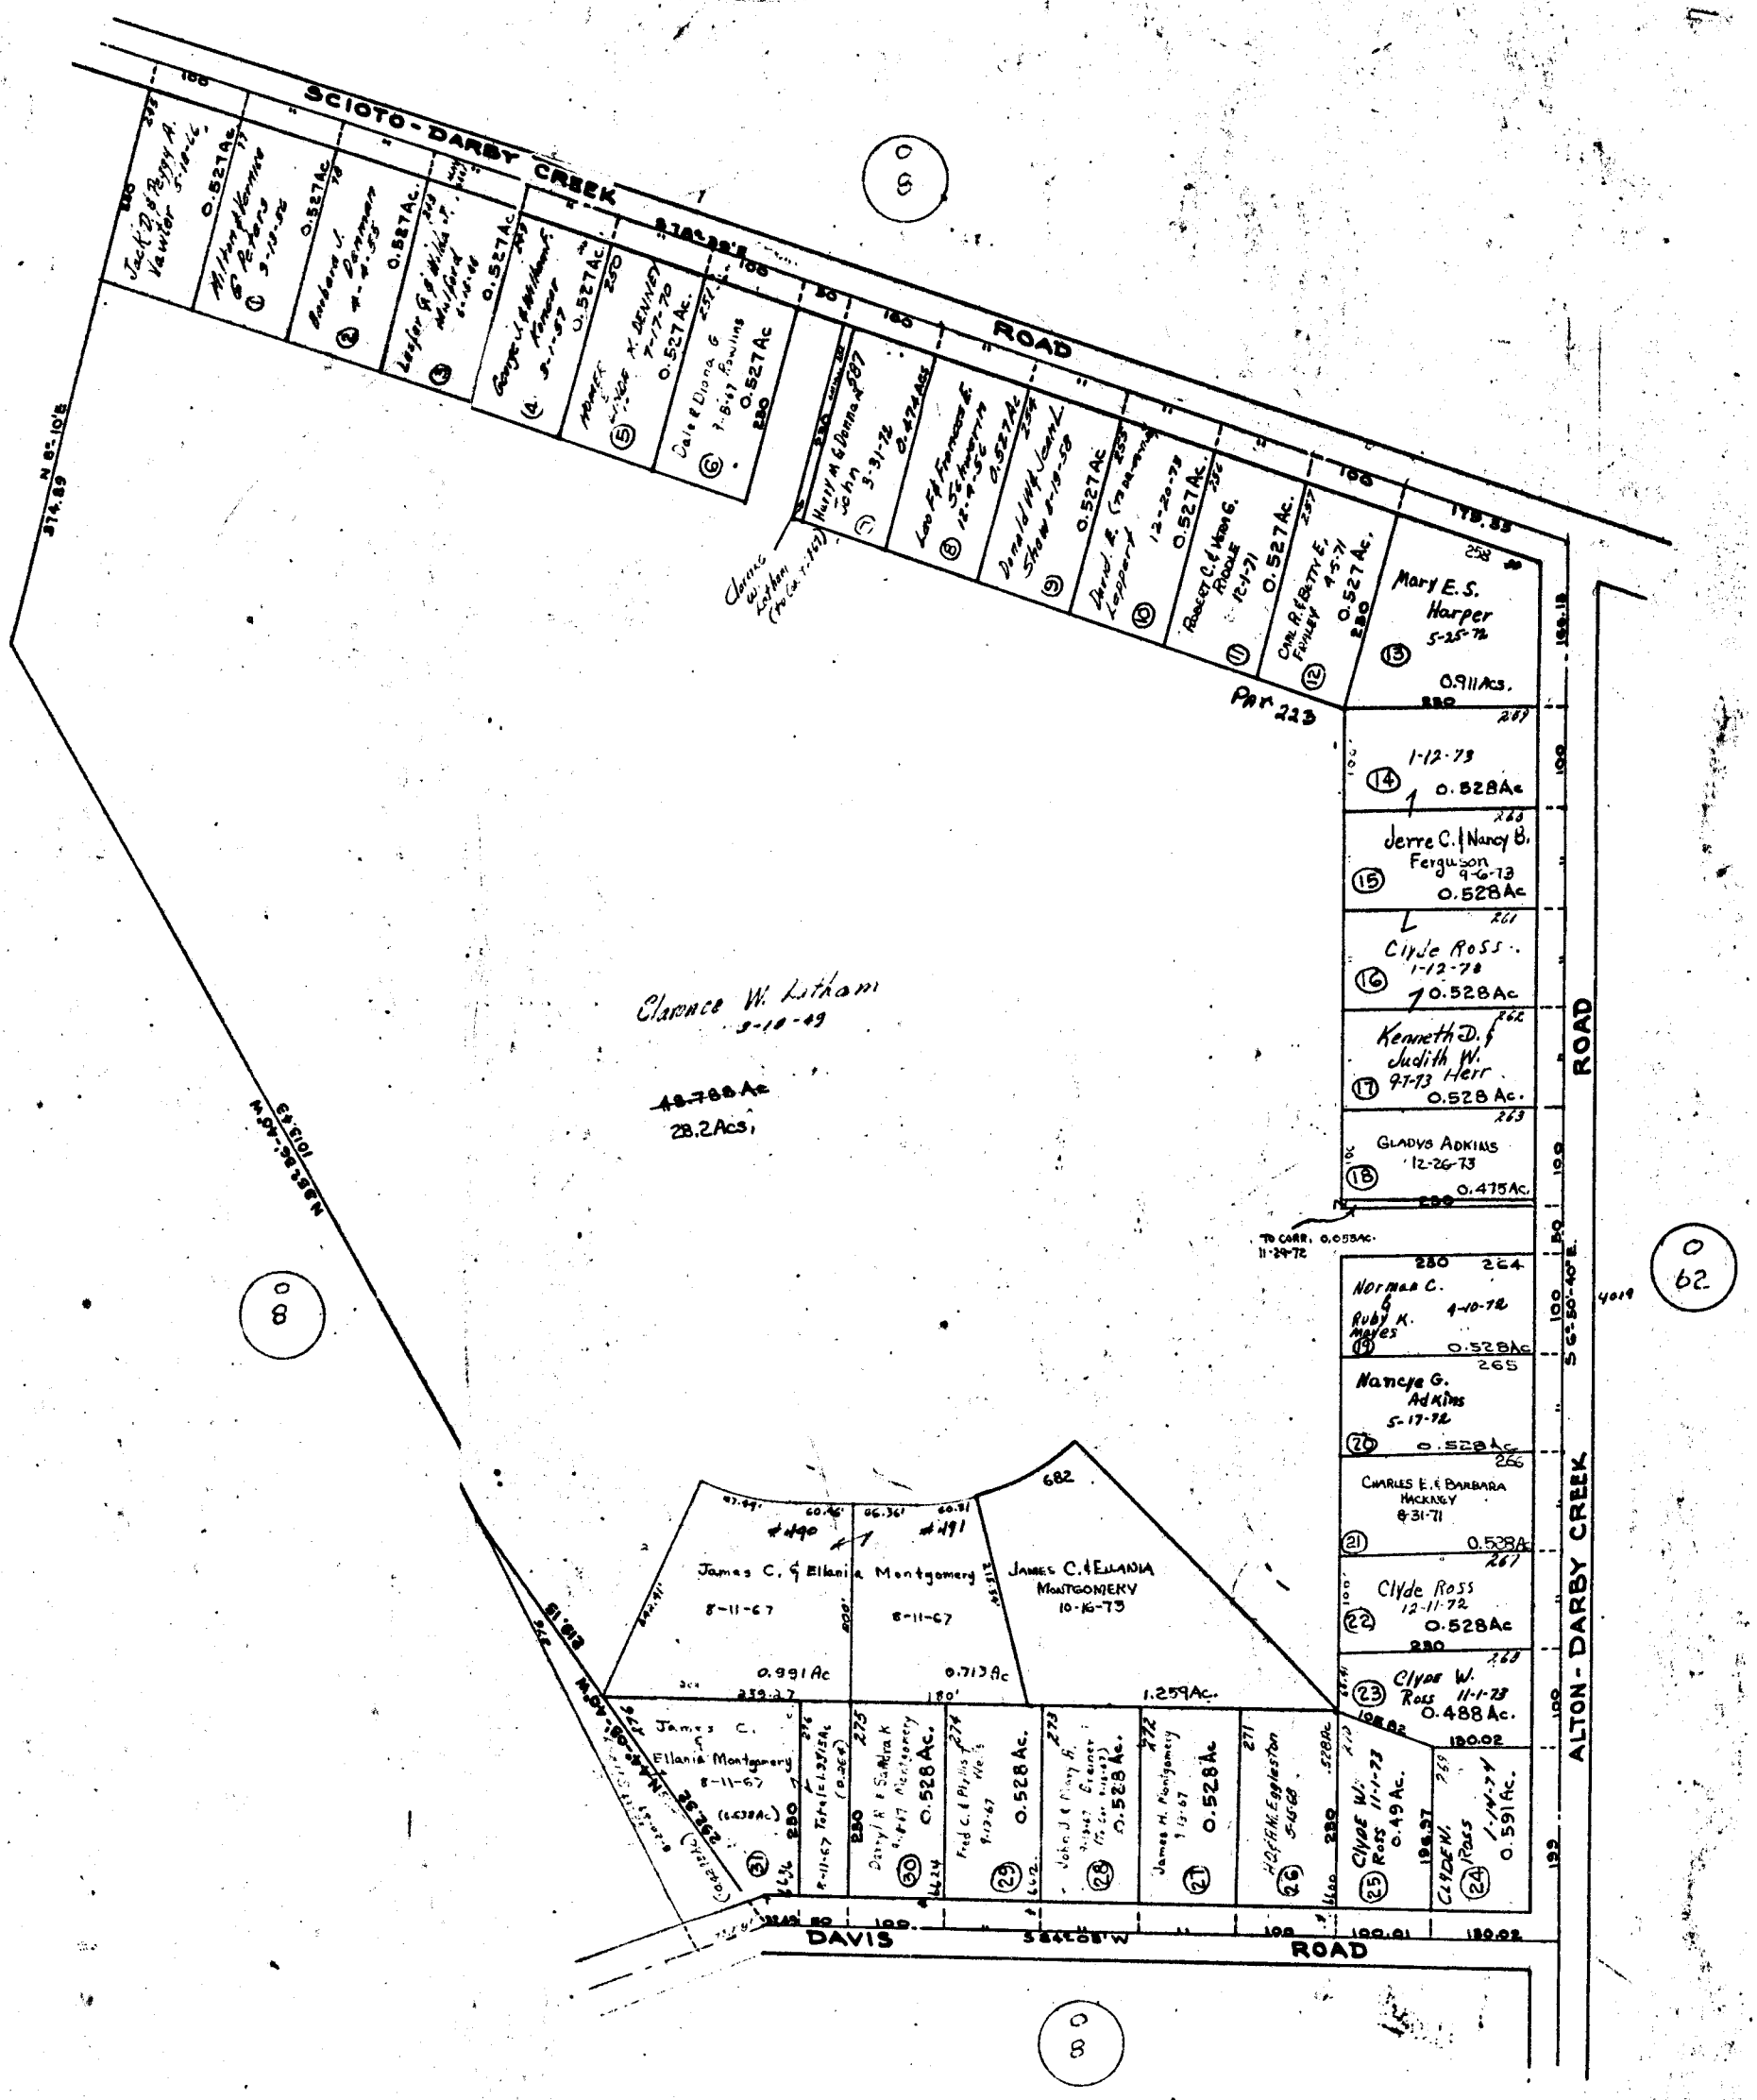
SCIOTO-DARBY CREEK ROAD
ALTON-DARBY CREEK ROAD
DAVIS ROAD
Clarence W. Latham 9-10-49
28.2Acs.
James C. & Ellania Montgomery 8-11-67
James C. & Ellania Montgomery 10-16-73
Mary E.S. Harper 5-25-72
Jerre C. & Nancy B. Ferguson 9-6-73
Clyde Ross 1-12-78
Kenneth D. & Judith W. Herr 9-7-73
Gladys Adkins 12-26-73
Norman C. & Ruby K. Mayes 4-10-72
Nancye G. Adkins 5-17-72
Charles E. & Barbara Hackney 8-31-71
Clyde Ross 12-11-72
Clyde W. Ross 11-1-73
Par 223