

NORWICH

FRABVE

FRANKLIN

Karl Jaeger
5-26-55

M. M. McFarland
Estate
6-16-69

6.924 AC.

EDWARD N. B.
VILMA JO ANN OSBORN
2-11-70

1.413 AC.
3.078 AC.

MARGARET E. G. KING & OHIO NATIONAL BANK TR.
1-30-74

C. Carlton & Dorothy Hartley
12-13-51

Dean L. & Mary H. Rager
5-25-72

City National
Bank & Trust
Co. of
Columbus
1-9-73

PLANNED
COMMUNITIES
INC.
3-20-69

PLANNED COMMUNITIES INC.

Wilson Woods Ltd.
12-31-73

Colo. Southwestern S.D.

HOMESTEAD

BROOK-SIDE

DOVER

PLAIN VIEW

PLACE

PLANK

F


M O N I T O R

180
A

TWP

TWP
4316

FRANKLIN TWP.

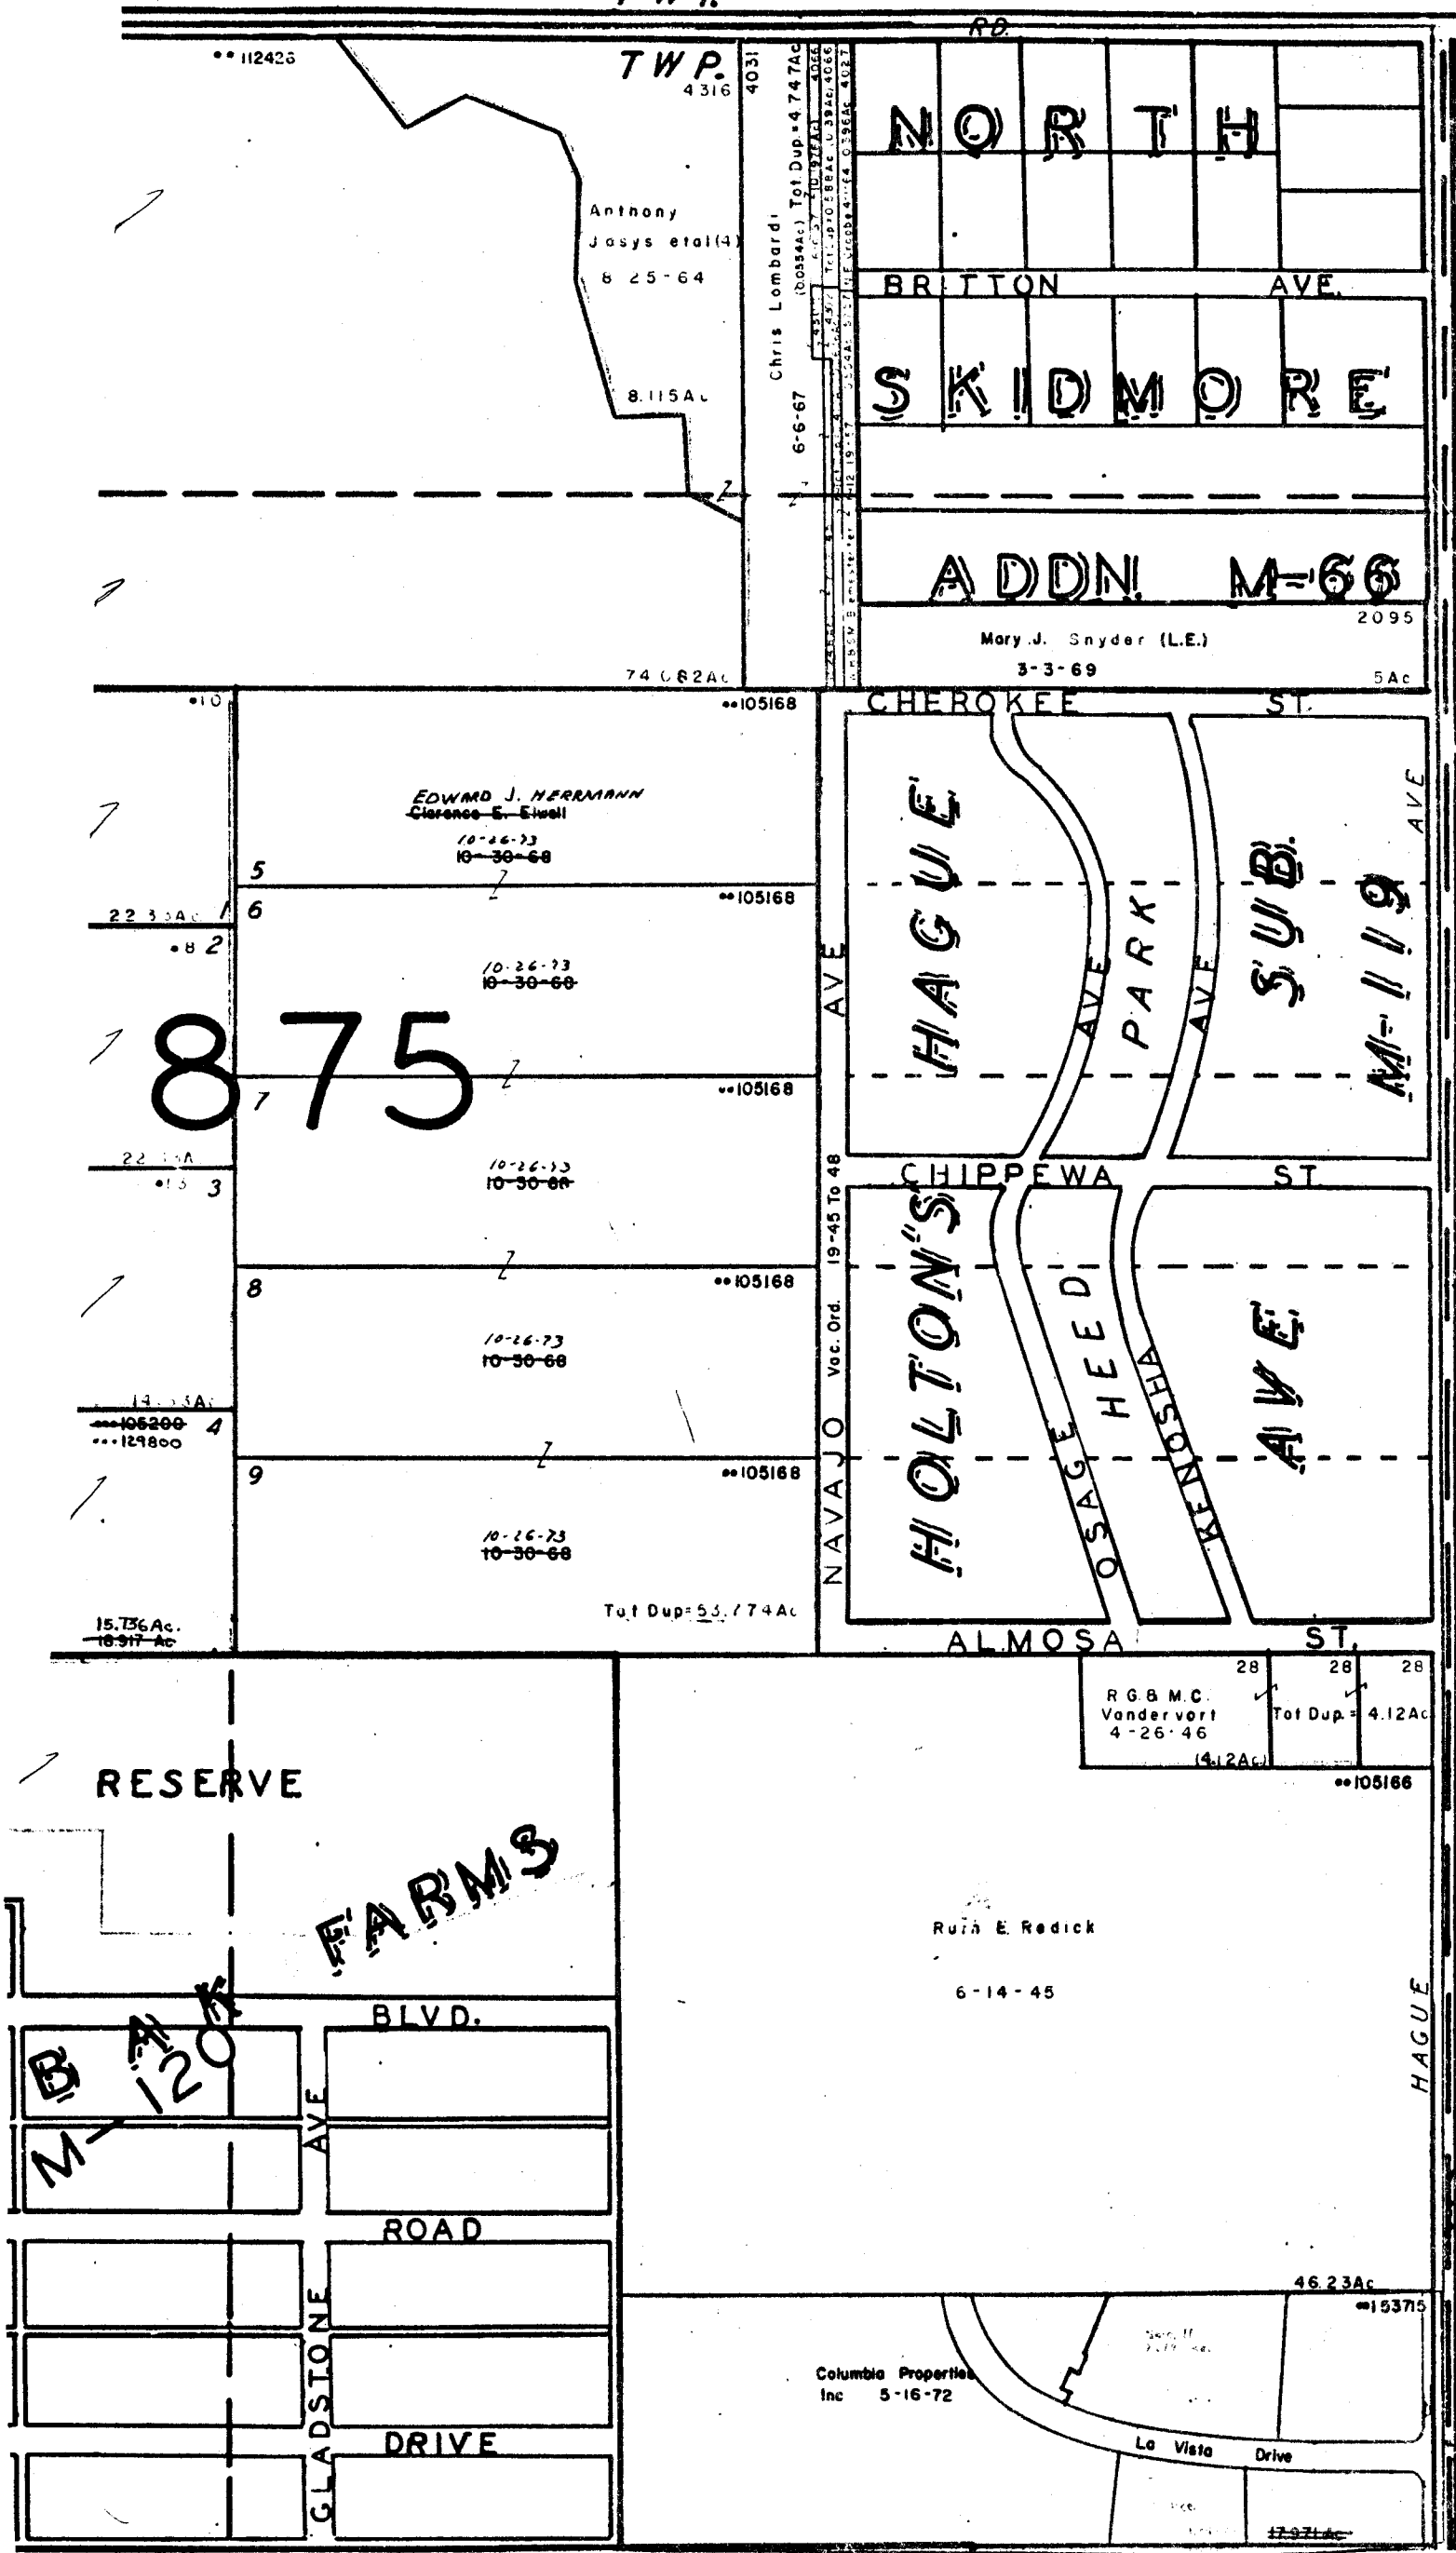

SCALE 1" = 200'
 TAXING DISTRICT
 • SCIOTO DARBY S. D.
 •• Cois. Southwestern S. D.
 ••• Cois. Scioto Darby S. D.

0
18
C

0
18
F

Dec. of La Vista
 Dr. & Easements