


0  
65

TRABUE

Almond Duffins  
1-14-48

Jennie A. Whittington  
10-24-55  
F.M. Co.  
6-12-69  
7000  
F.M. Co.  
6-12-65

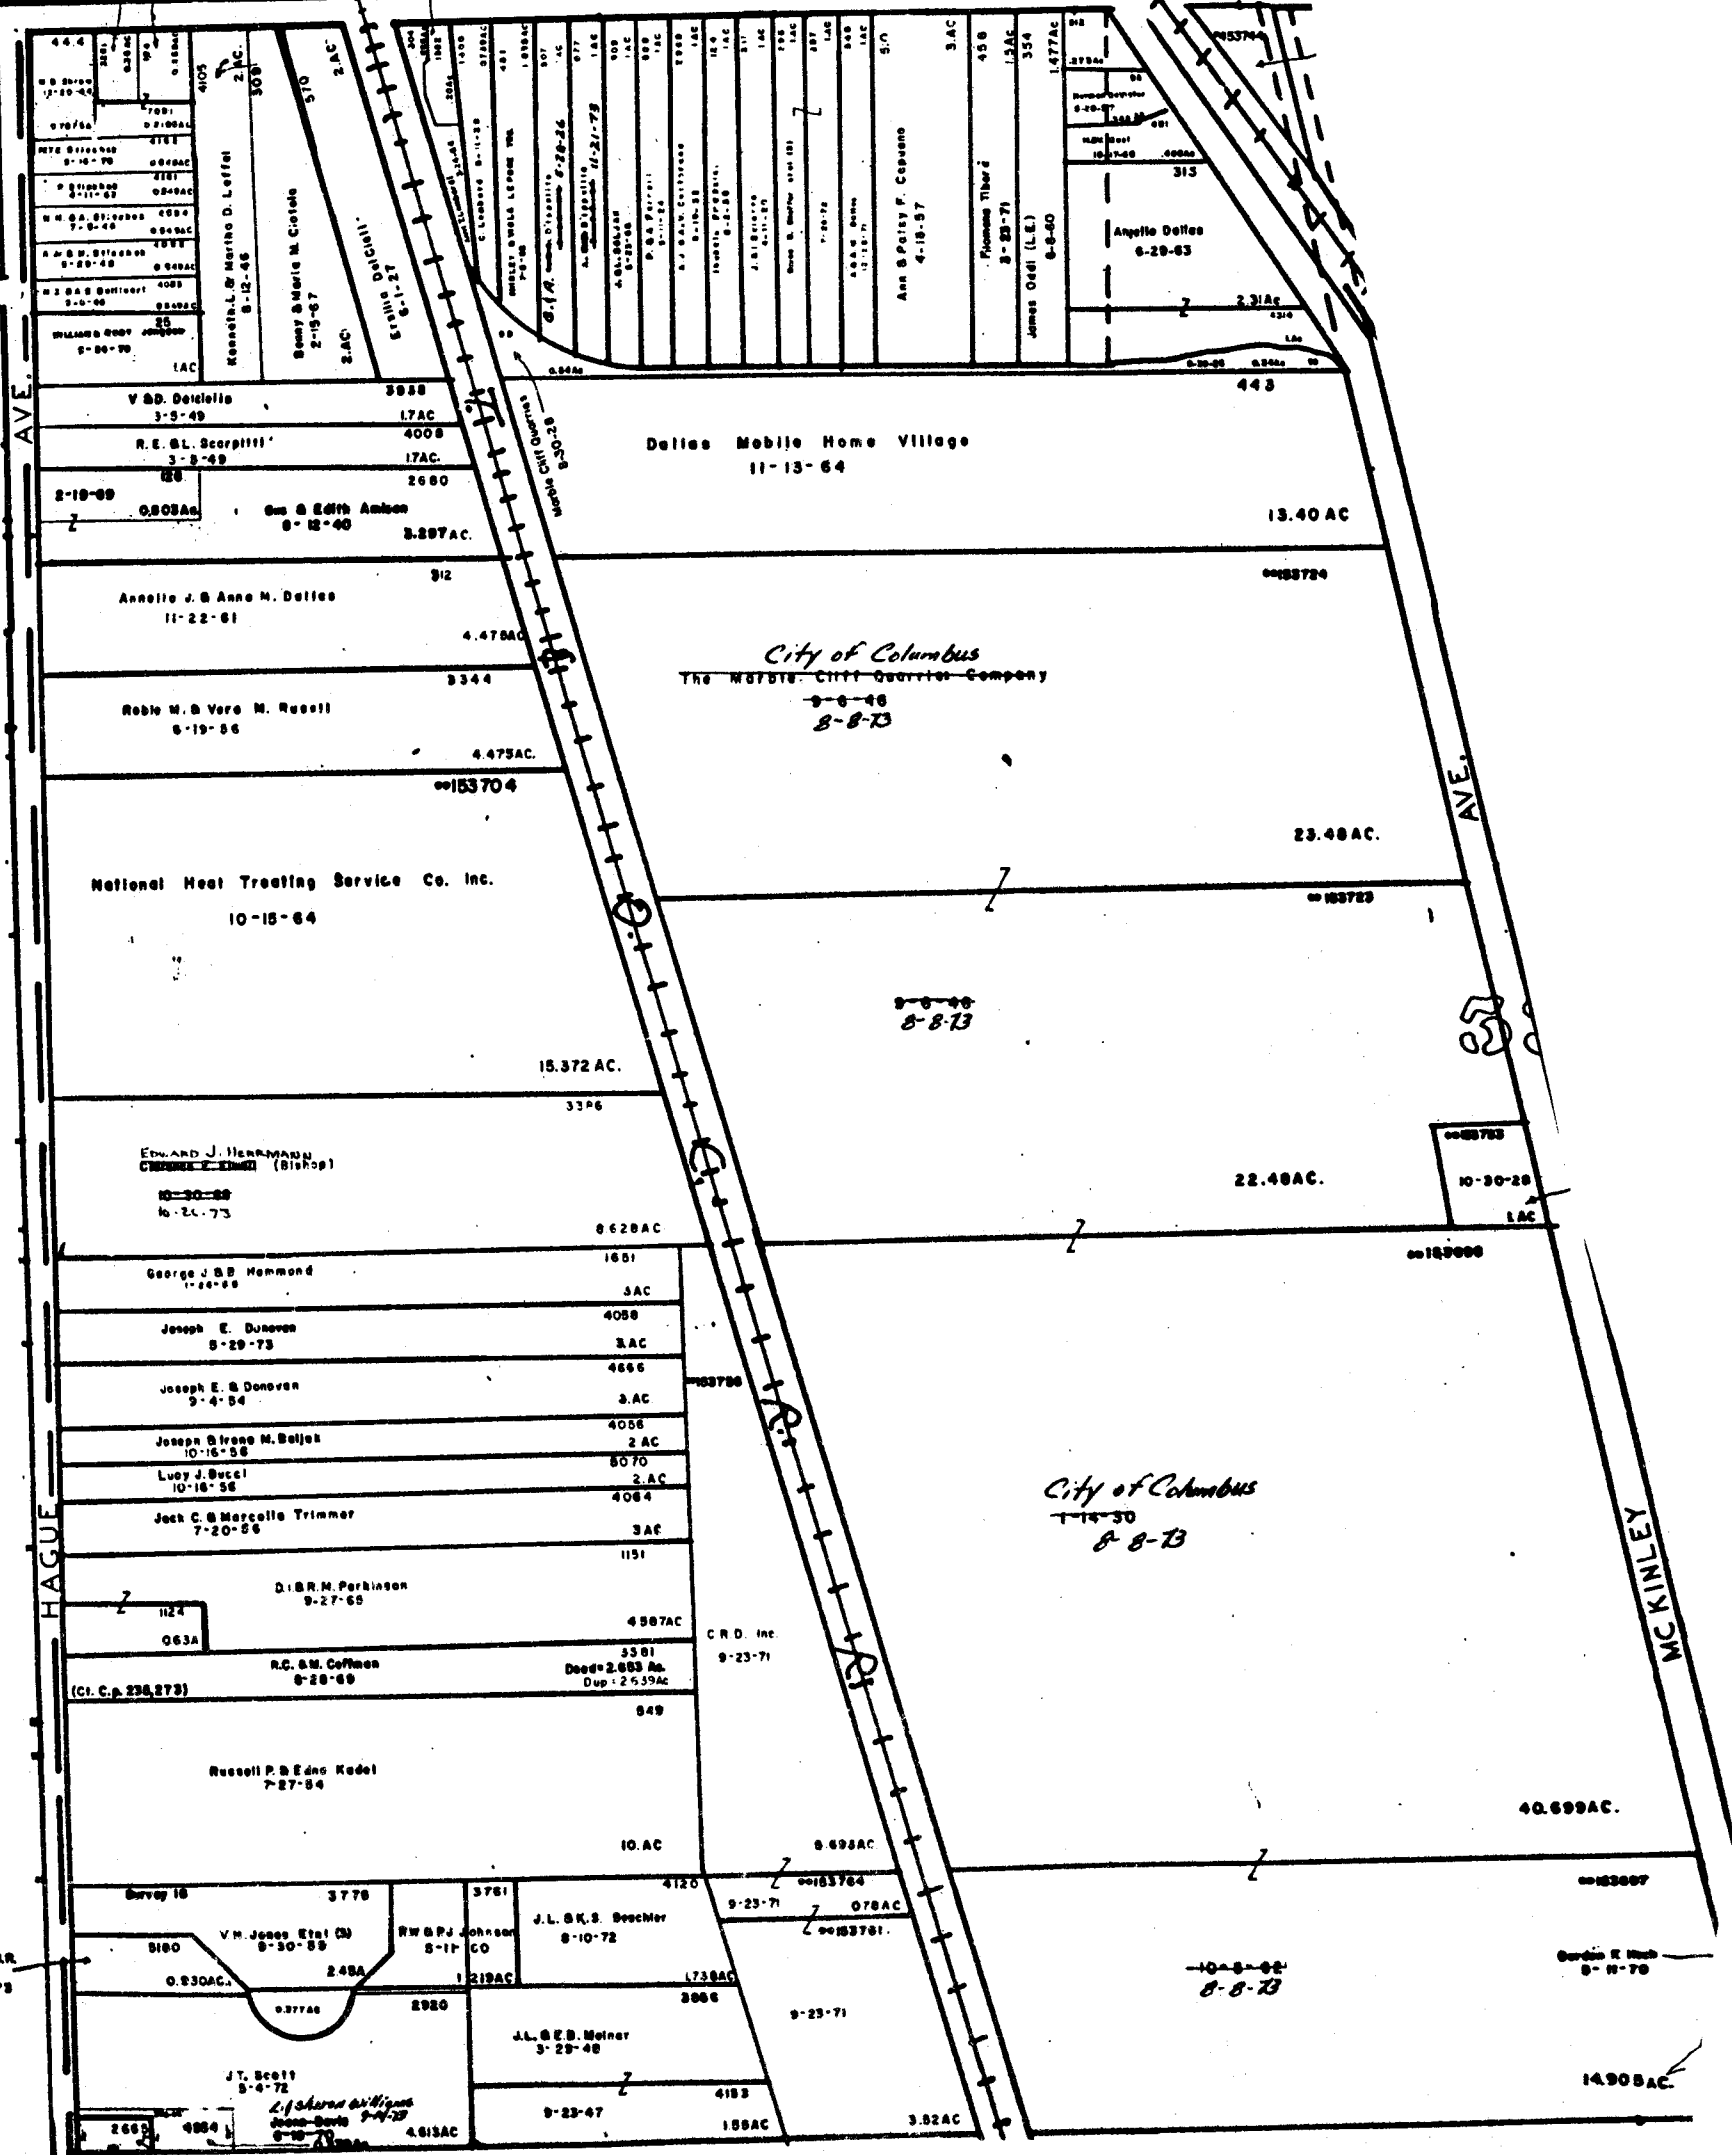

M  
119

0  
18  
F

O-18-C  
FRANKLIN TWP



SCALE 1"=200'  
TAXING DISTRICT  
FRANKLIN  
COLUMBUS SOUTHWESTERN

