


018C

018B


530

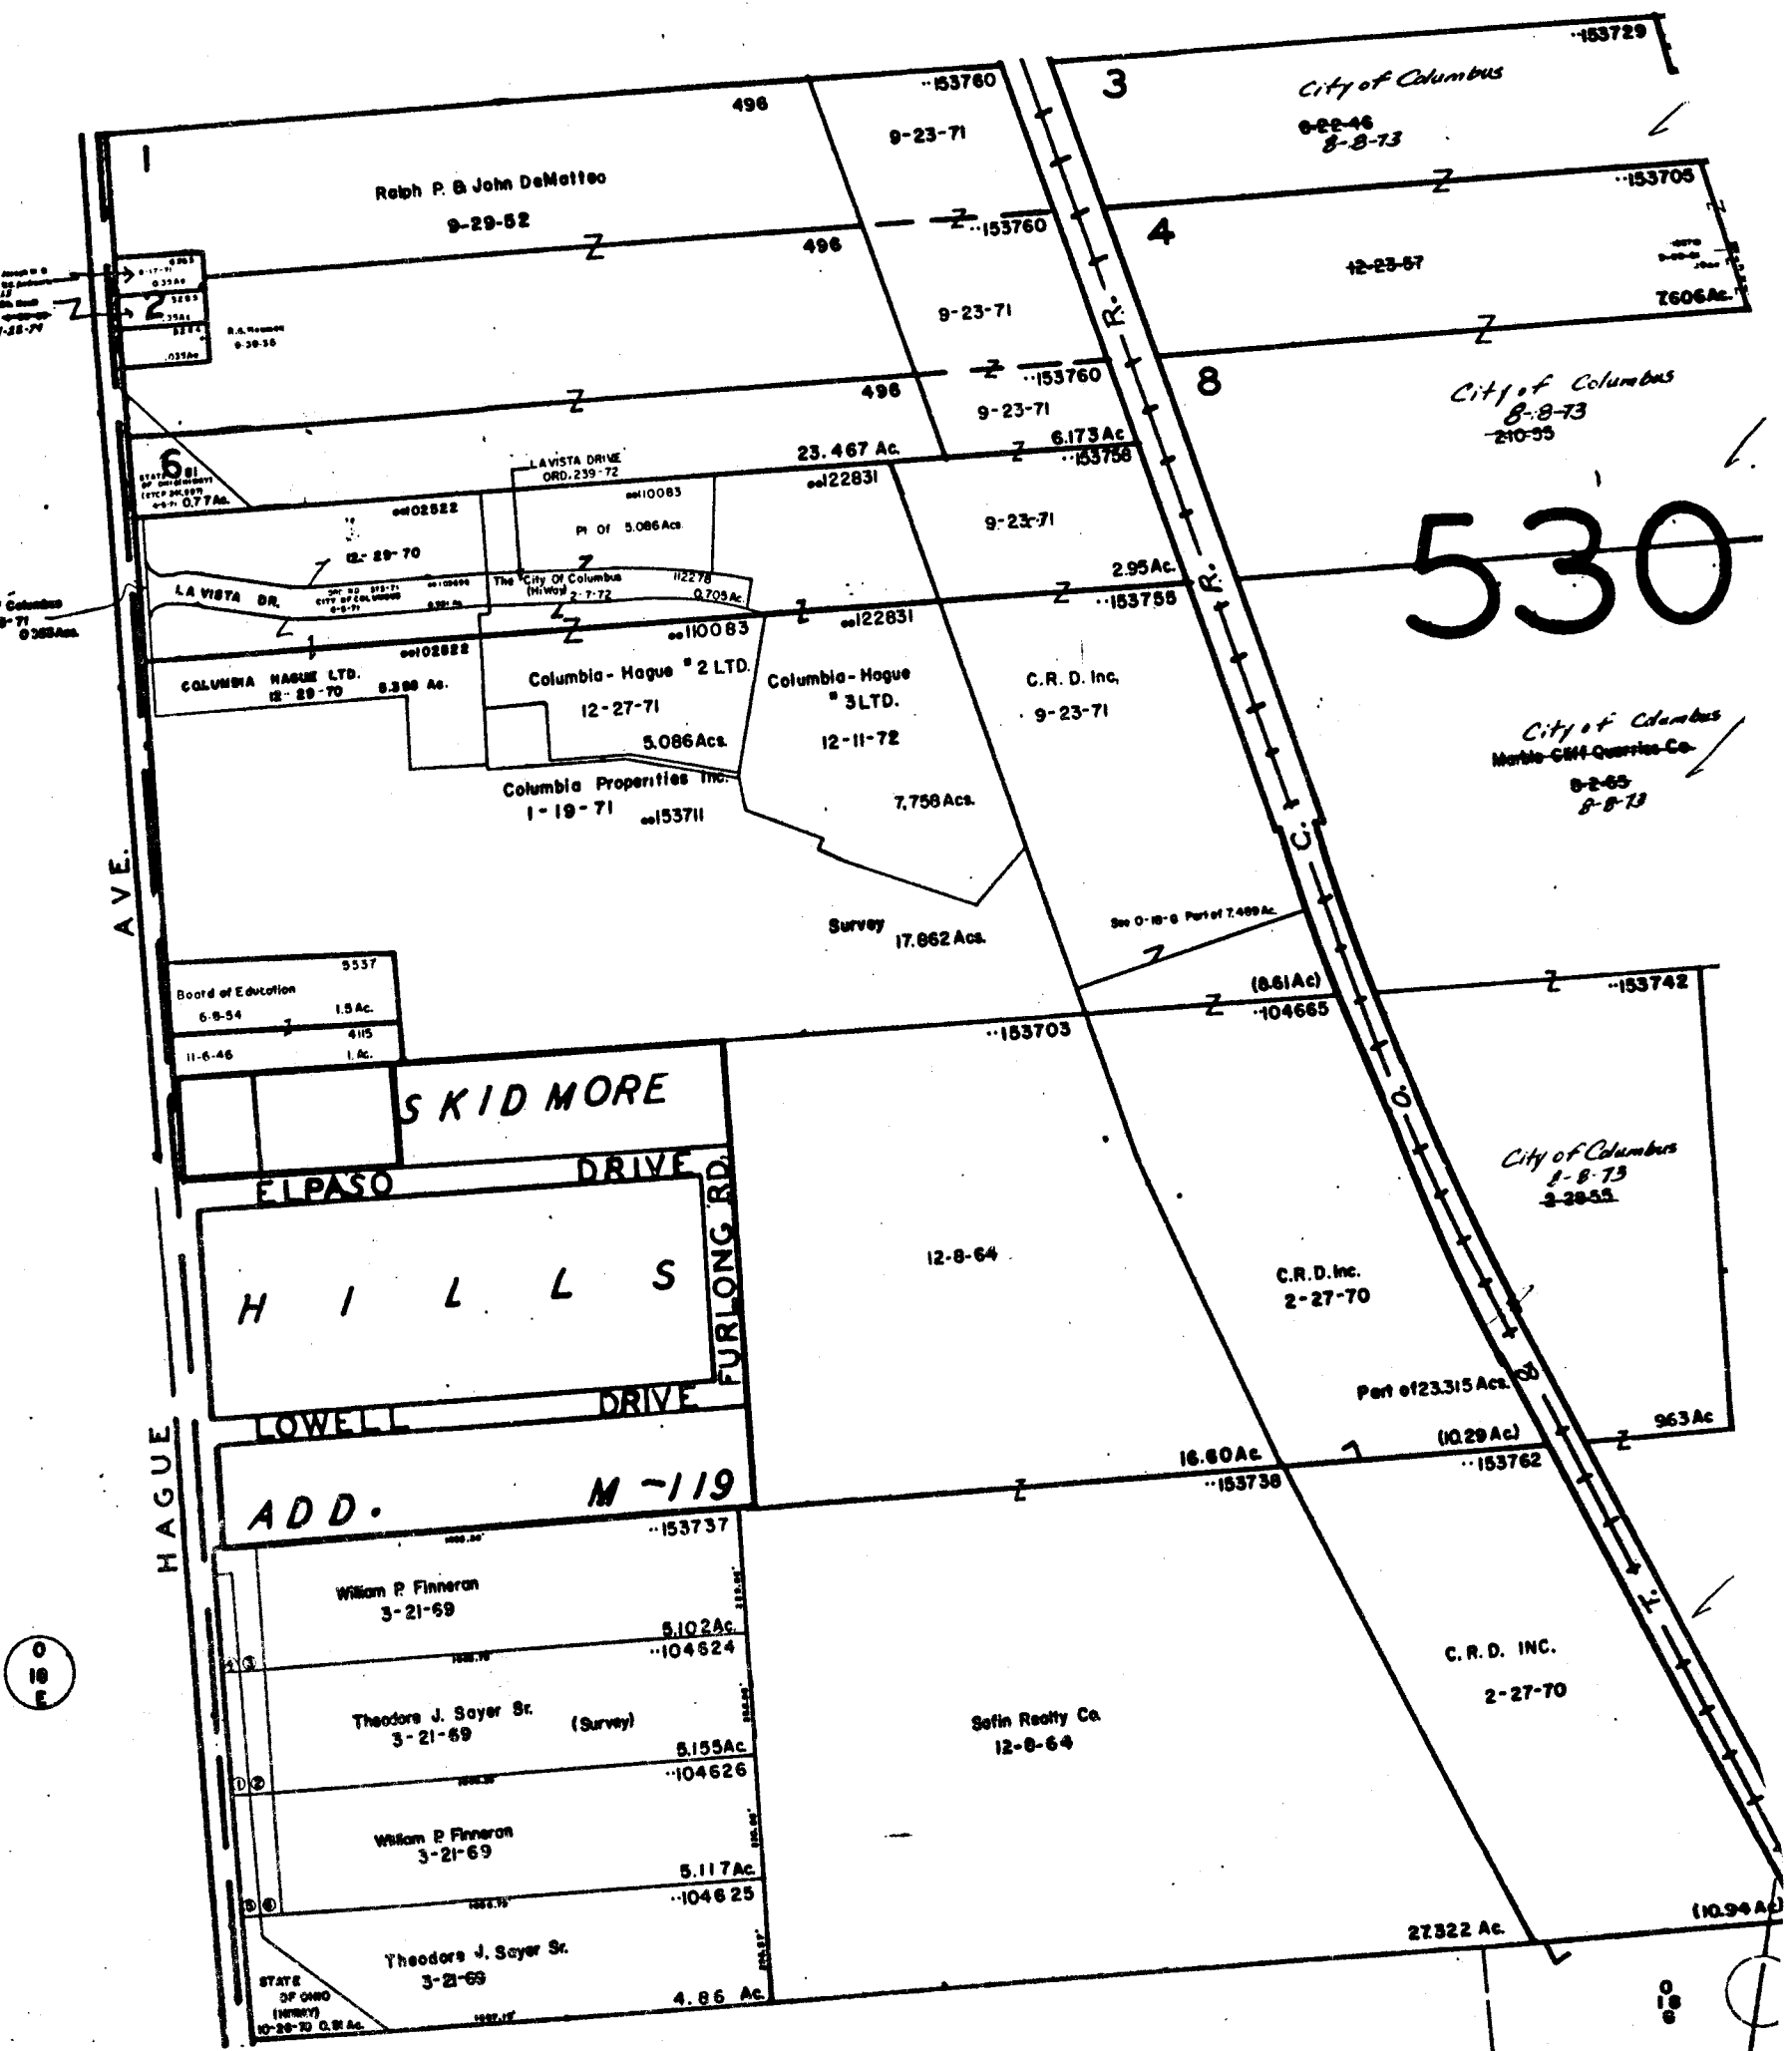

- ① STATE OF OHIO (HWAY) 10-26-70 0.34Ac.
- ② STATE OF OHIO (HWAY) 10-26-70 0.27Ac.
- ③ STATE OF OHIO (HWAY) 10-26-70 0.25Ac.
- ④ STATE OF OHIO (HWAY) 10-26-70 0.34Ac.
- ⑤ STATE OF OHIO (HWAY) 10-26-70 0.38Ac.
- ⑥ STATE OF OHIO (HWAY) 10-26-70 0.27Ac.



SCALE 1"=200'  
TAXING DISTRICT  
FRANKLIN TWP.  
COL-SOUTHWESTERN S.D.  
V.M.S.

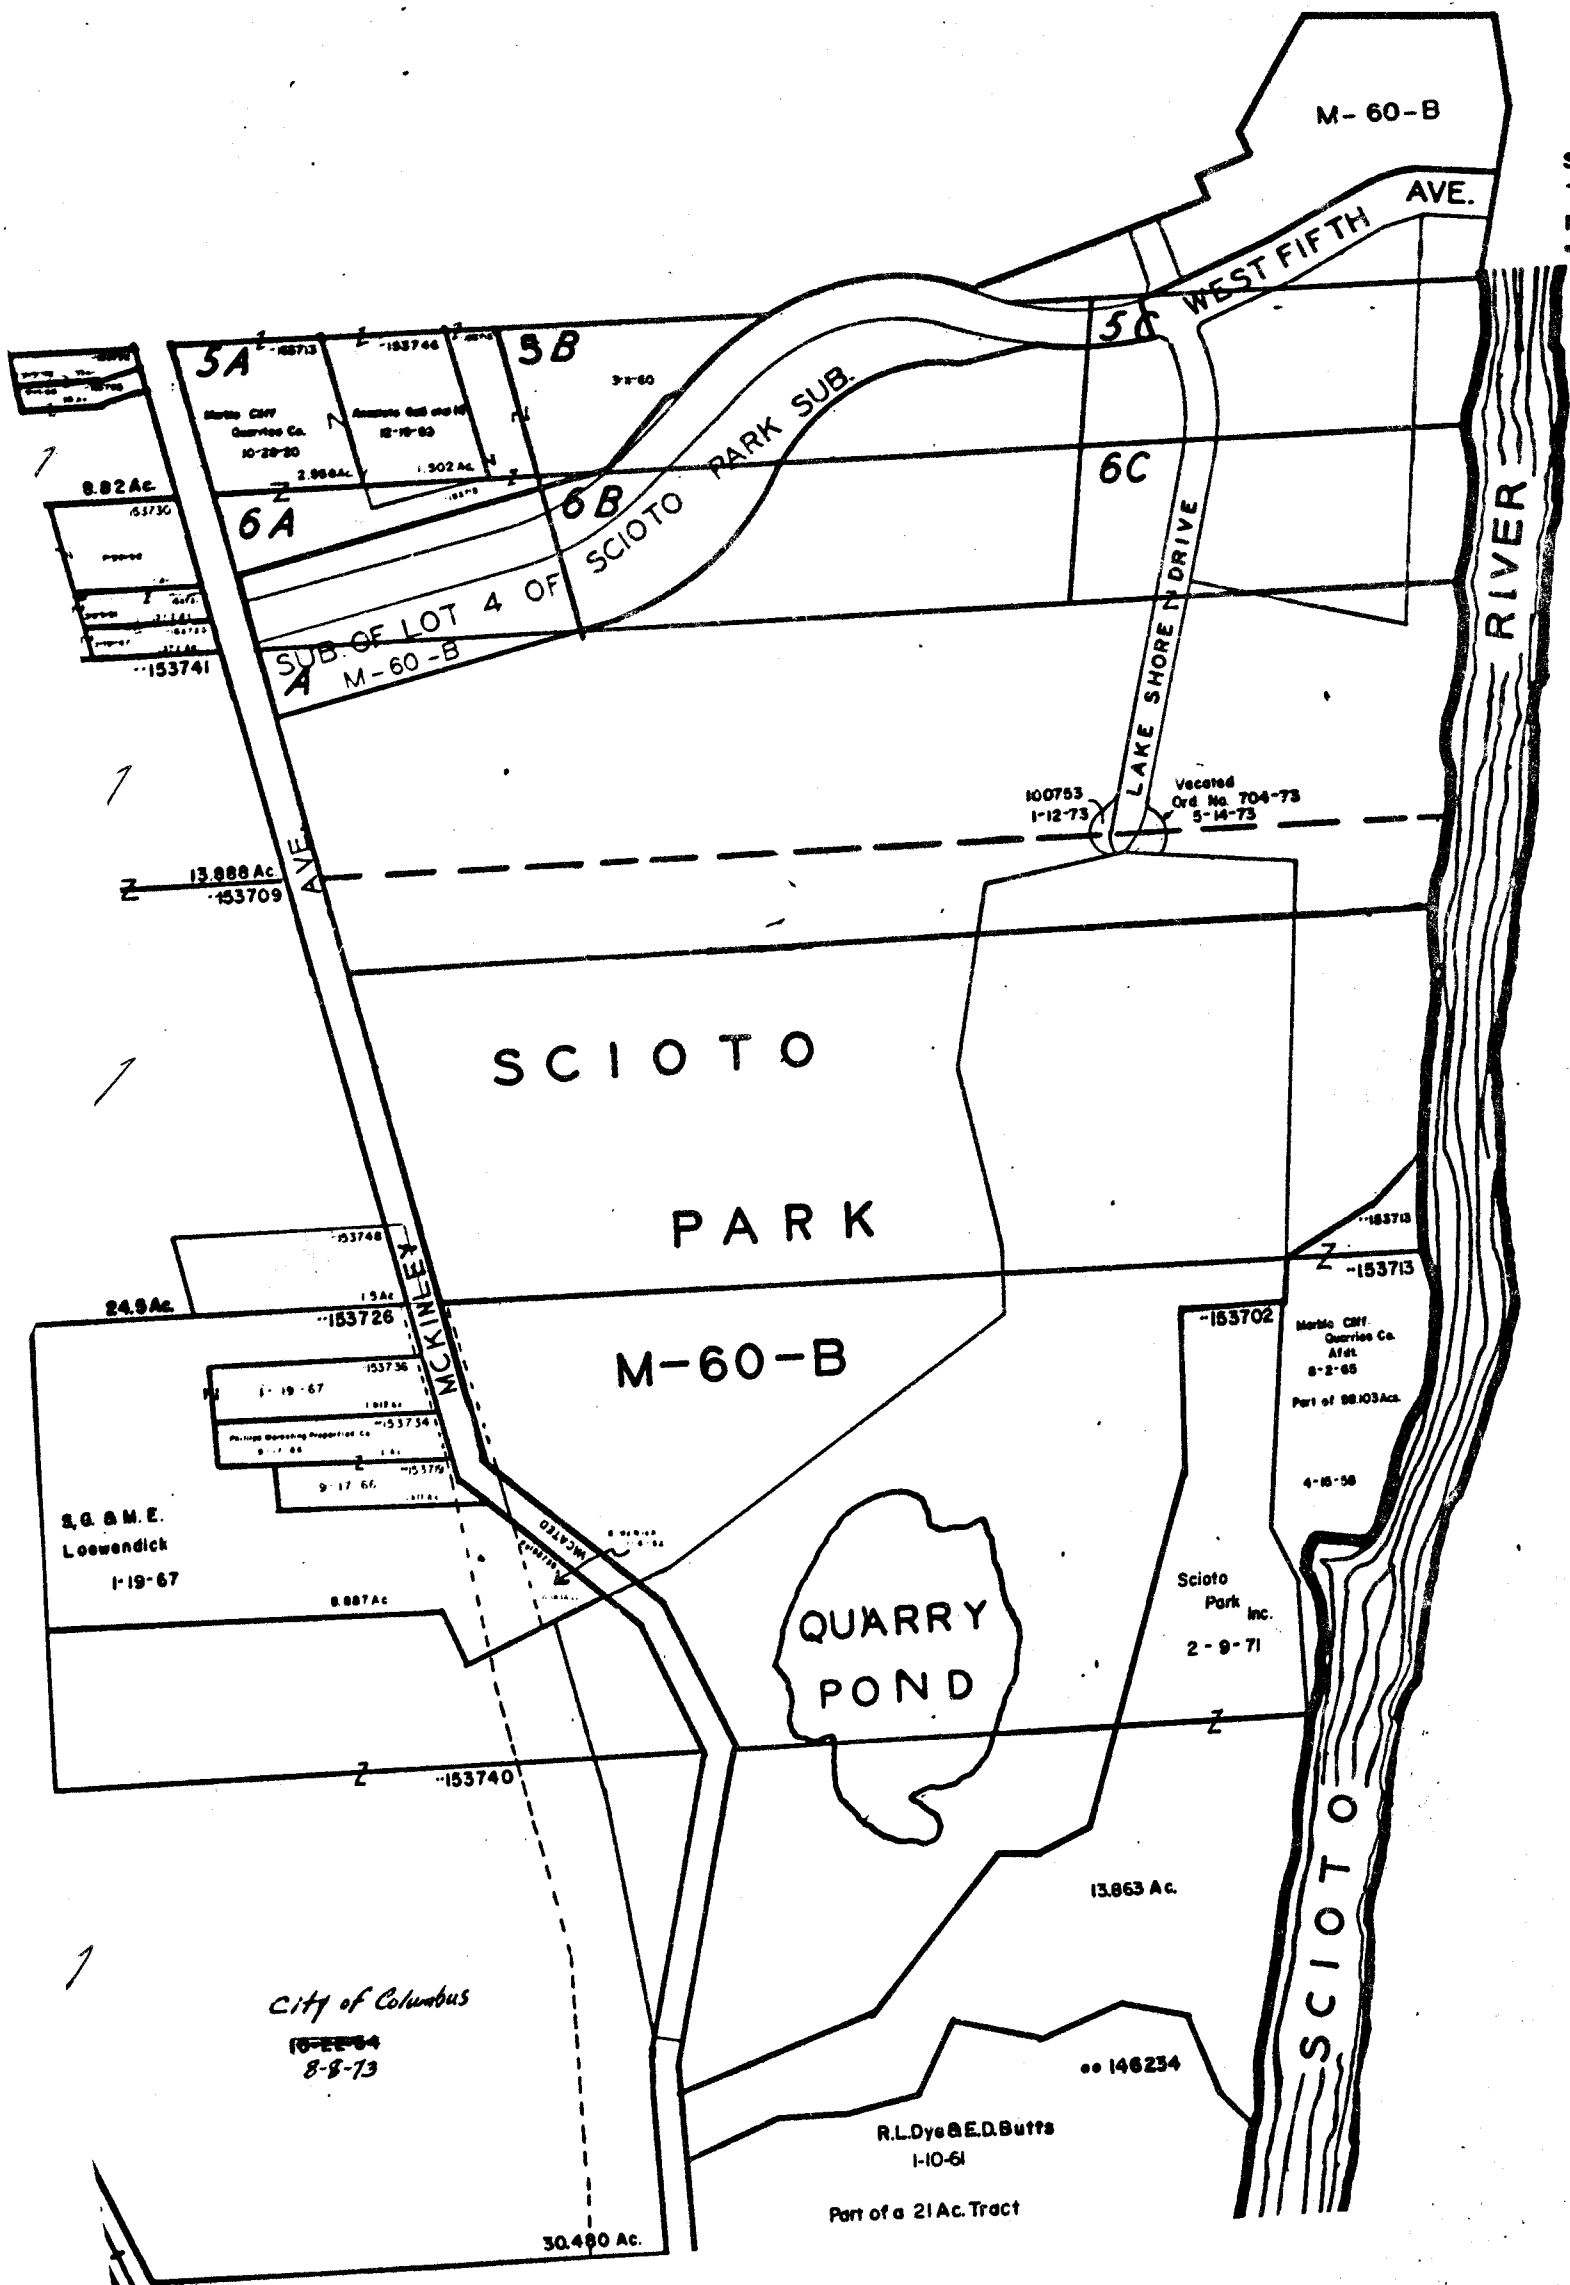

017