


780

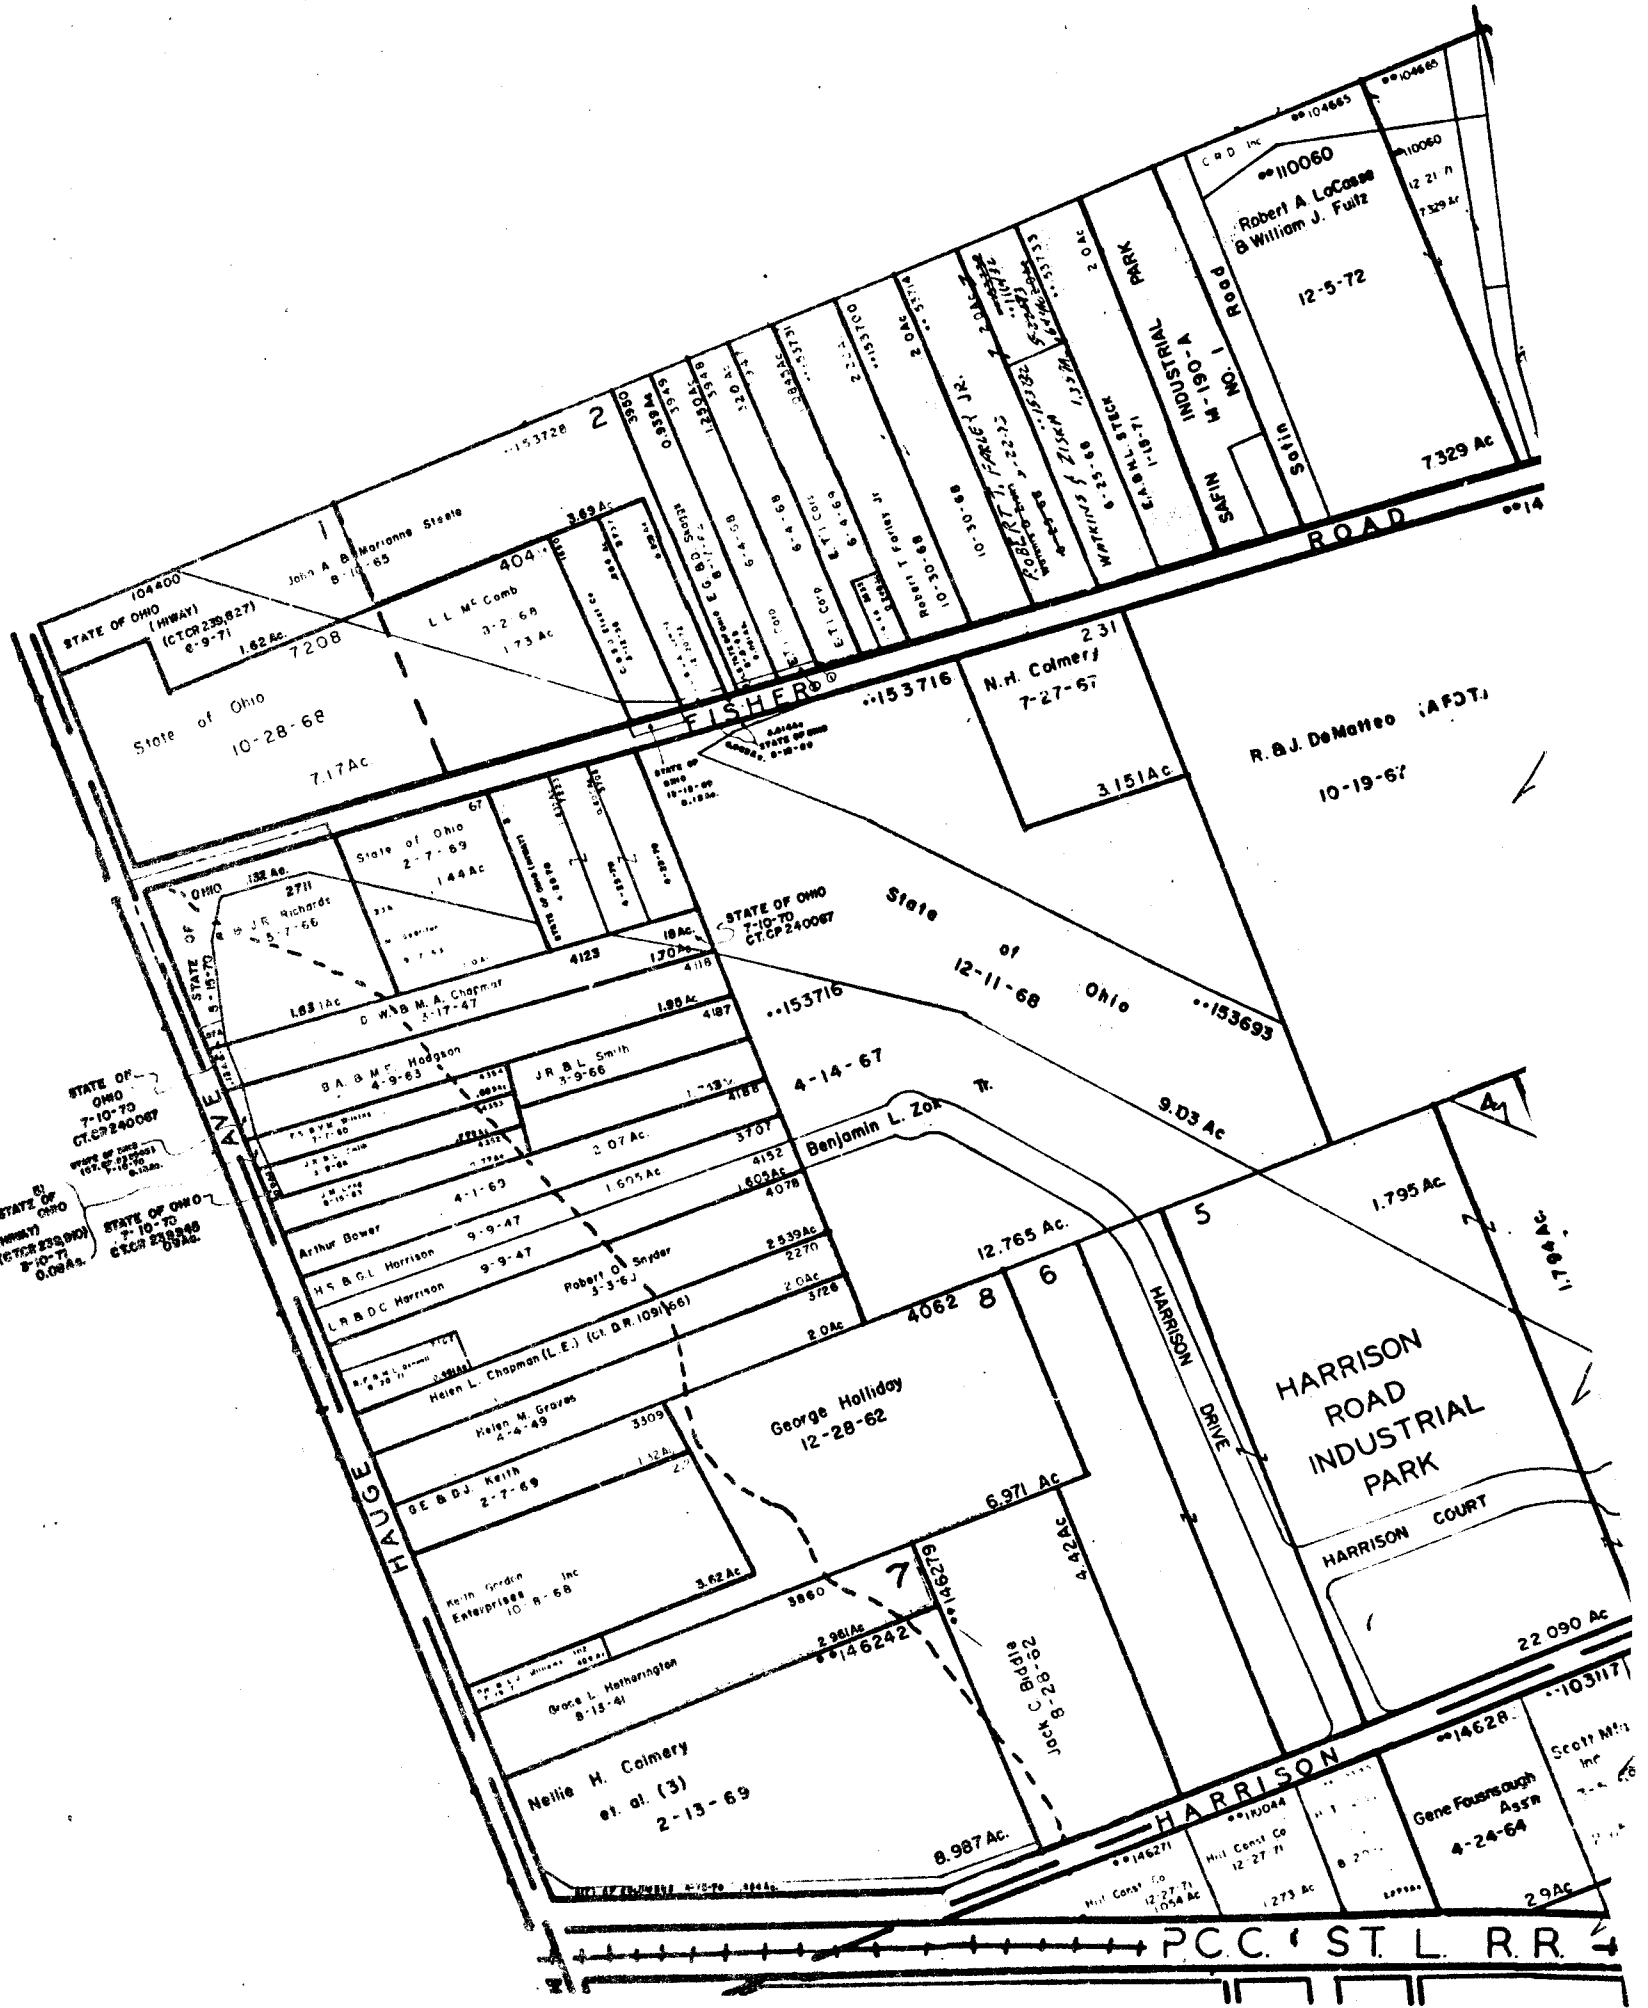

STATE OF OHIO
 (H.WAY) CT. CP 240067
 7-10-70
 0.088 Ac.

STATE OF OHIO
 (H.WAY) CT. CP 240067
 7-10-70
 0.088 Ac.

0 18 E

173-174


- ① DROP STATE OF OHIO (H.WAY) CT. CP 240067 11-10-70 0.012 Ac.
- ② DROP STATE OF OHIO (H.WAY) 12-10-72 0.030 Ac.
- ③ 14-12-70 THERESA DEWITO ETAL (H.WAY) 12-10-72 0.030 Ac.
- ④ 108703 DONALD L. DAVIS 11-4-71 443 Ac.
- ⑤ 12636 RIVERSIDE COND 11-9-61 3737 Ac.
- ⑥ 146224 A. B. E. PIGNATELLO 7-5-67 1.0 Ac.
- ⑦ 108403 STATE OF OHIO (H.WAY) CT. CP 242284 12-3-71 .35 Ac.
- ⑧ 109439 STATE OF OHIO (H.WAY) CT. CP 241671 12-14-71 .9 Ac.
- ⑨ HARRISON ROAD INDUSTRIAL PARK 12-15-72 4554 Ac.
- ⑩ 143561 STATE OF OHIO (H.WAY) CT. CP 241070 2-10-72 .14 Ac.
- ⑪ 14337 STATE OF OHIO (H.WAY) CT. CP 241070 2-10-72 .62 Ac.
- ⑫ 14818 T.A. & P.L. HAMPTON 7-17-72 .186 Ac.

0-18-G

FRANKLIN TWP.



SCALE 1" = 200'
TAXING DISTRICTS
FRANKLIN TWP.
** COL. - SOUTHWESTERN S. &
**** FRANKLIN-COL. IND. S. &

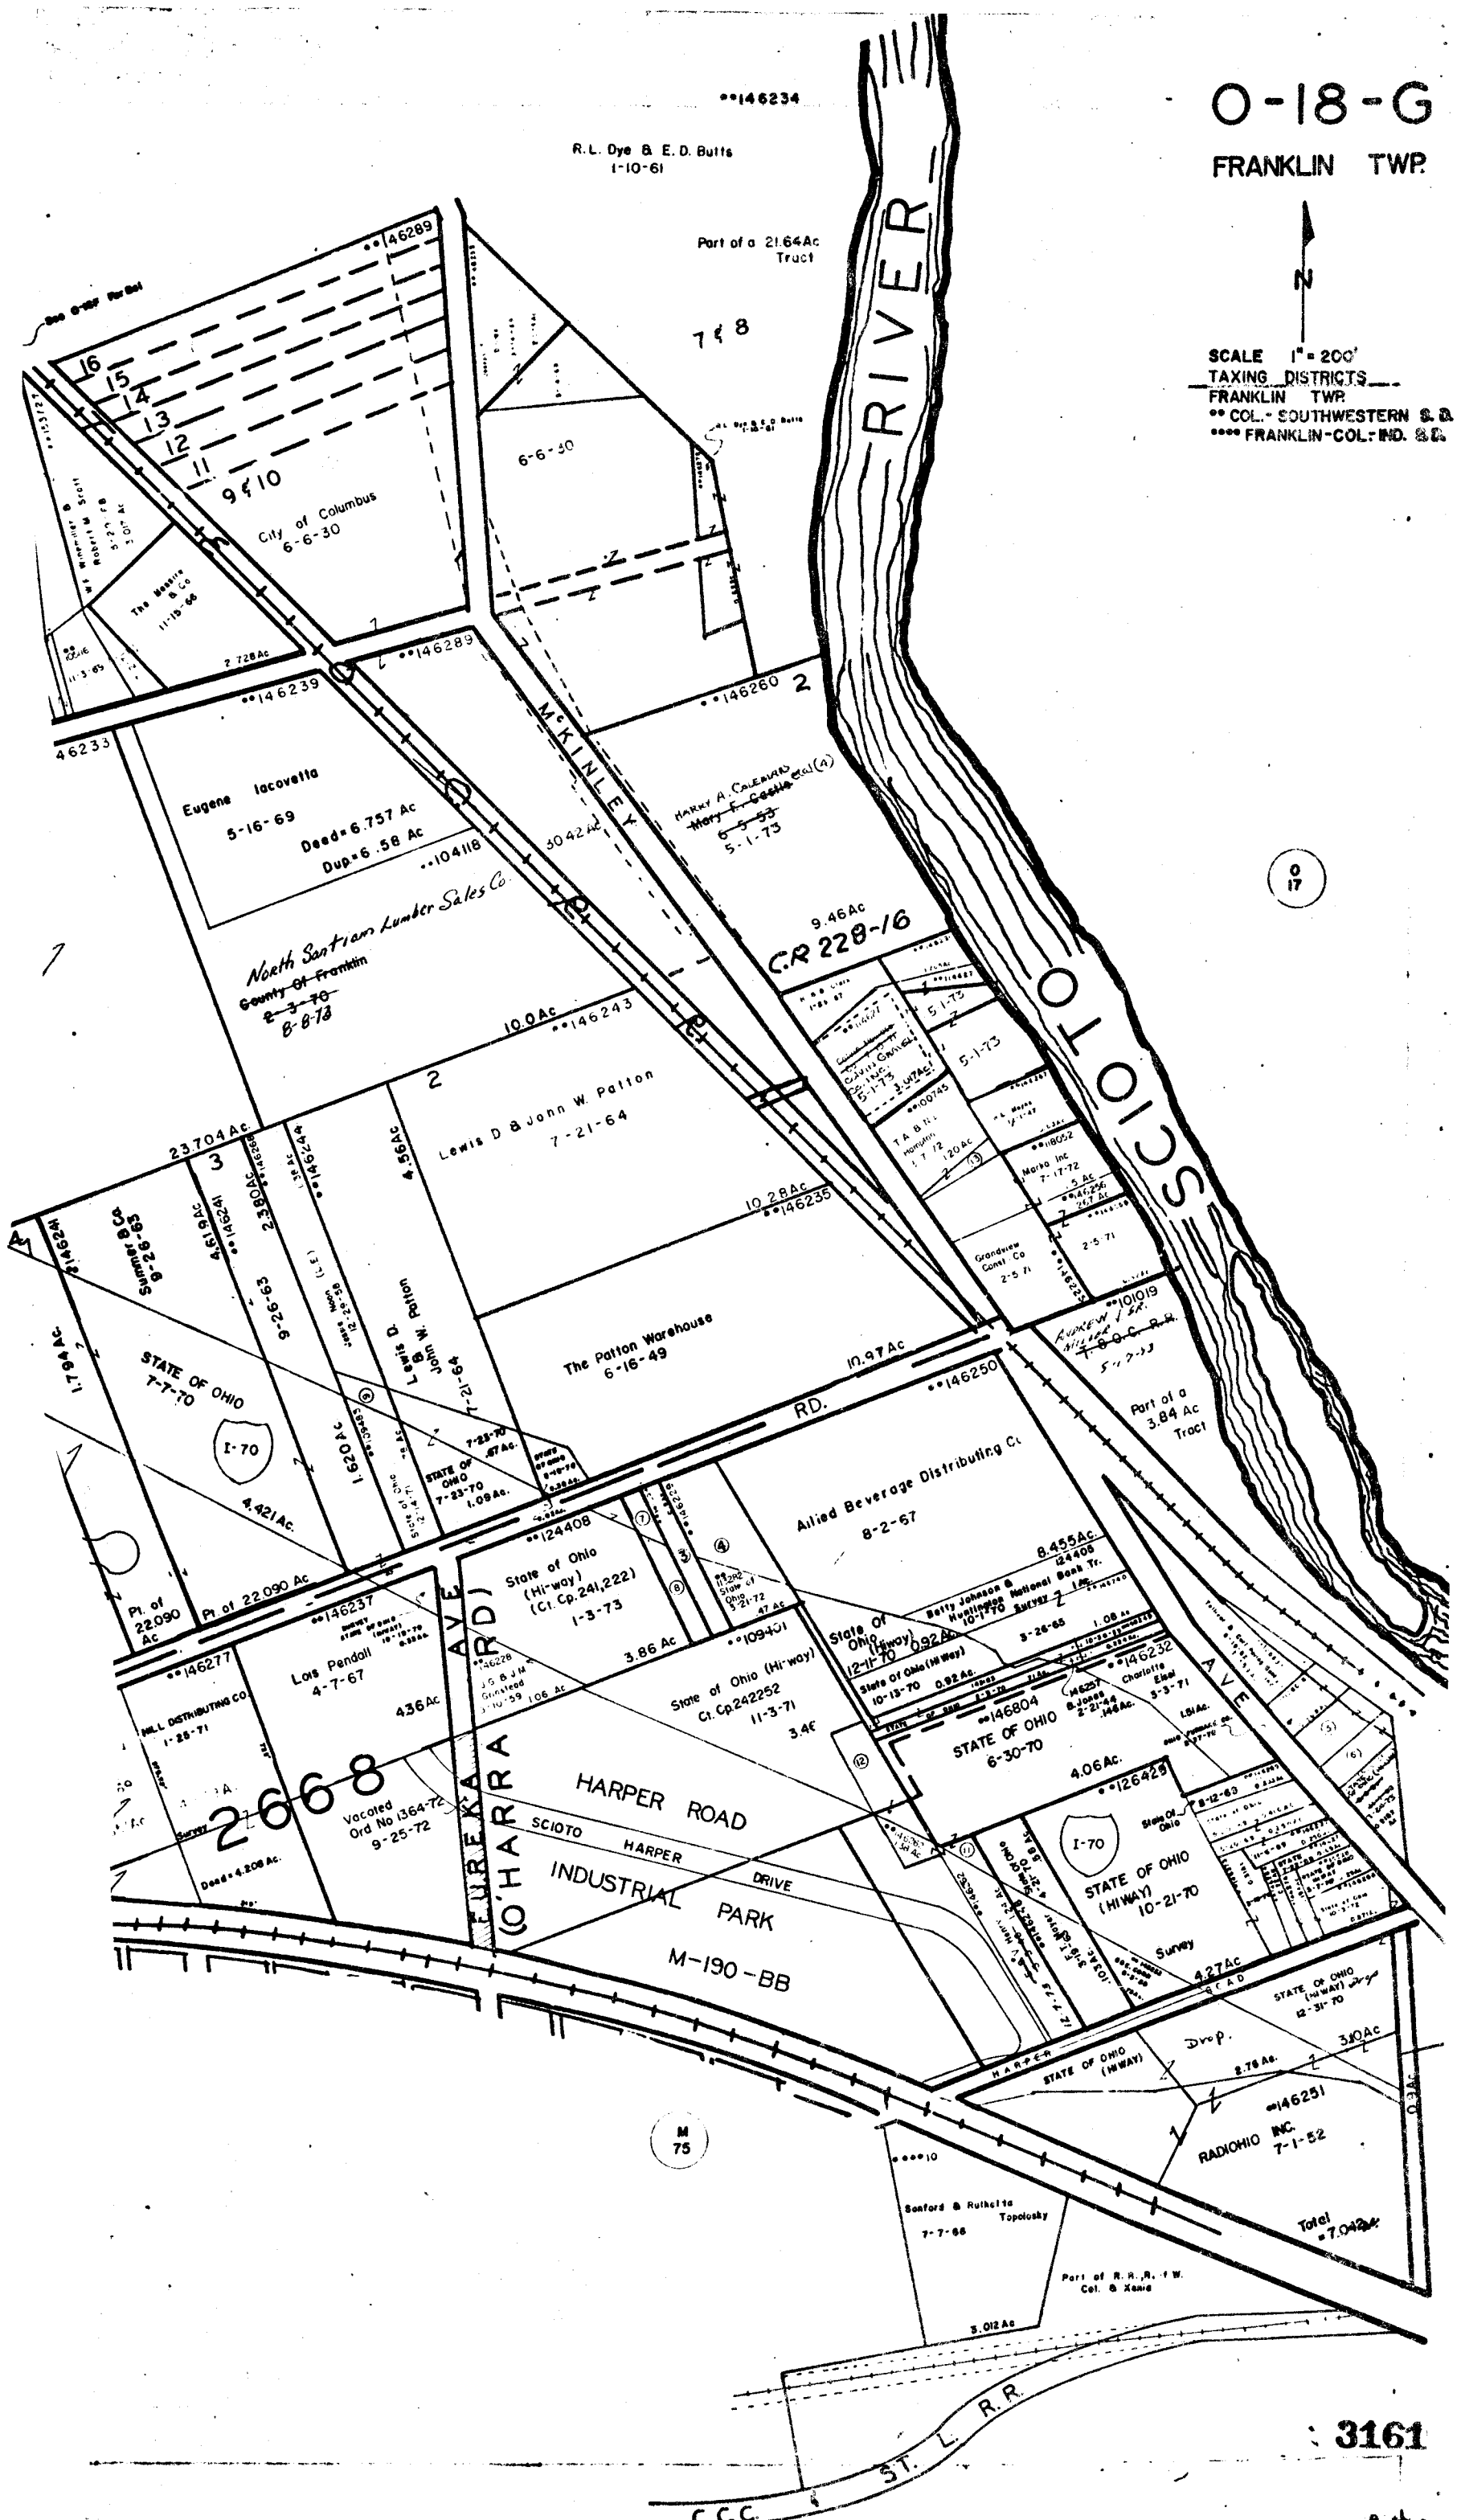

0
17

M
75

3161