


32

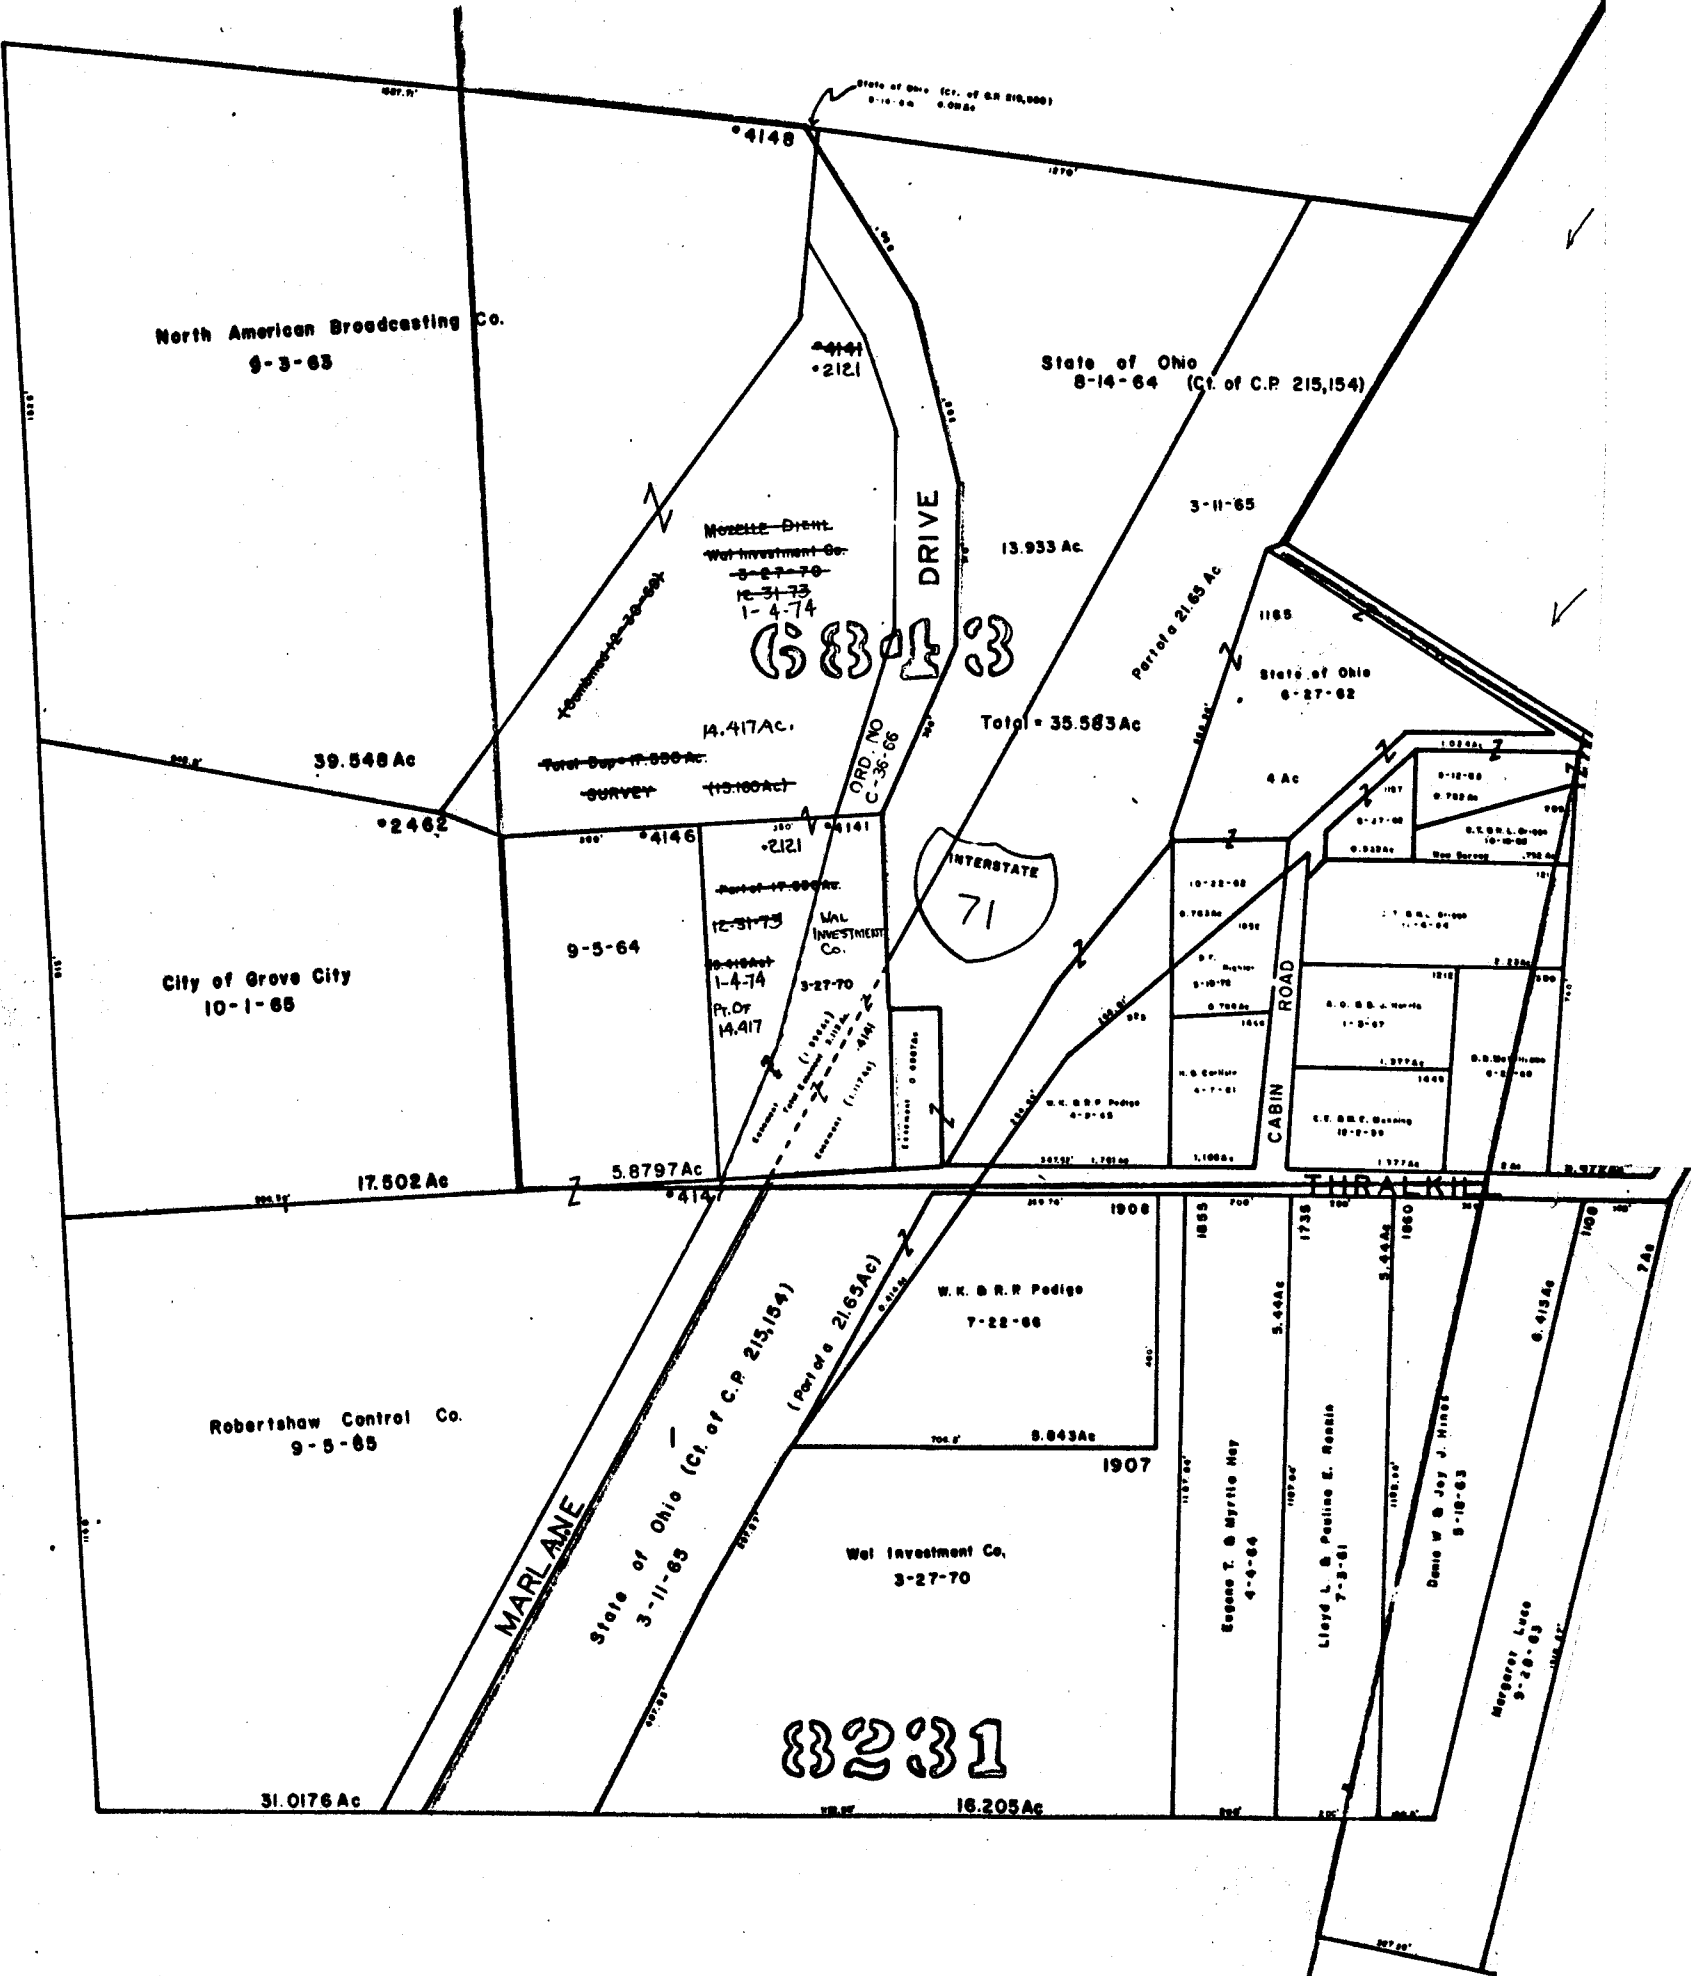

32


32

0-32-

JACKSON TWP



VMS  
SCALE 1"=200'  
TAXING DISTRICTS  
JACKSON TWP  
GROVE CITY

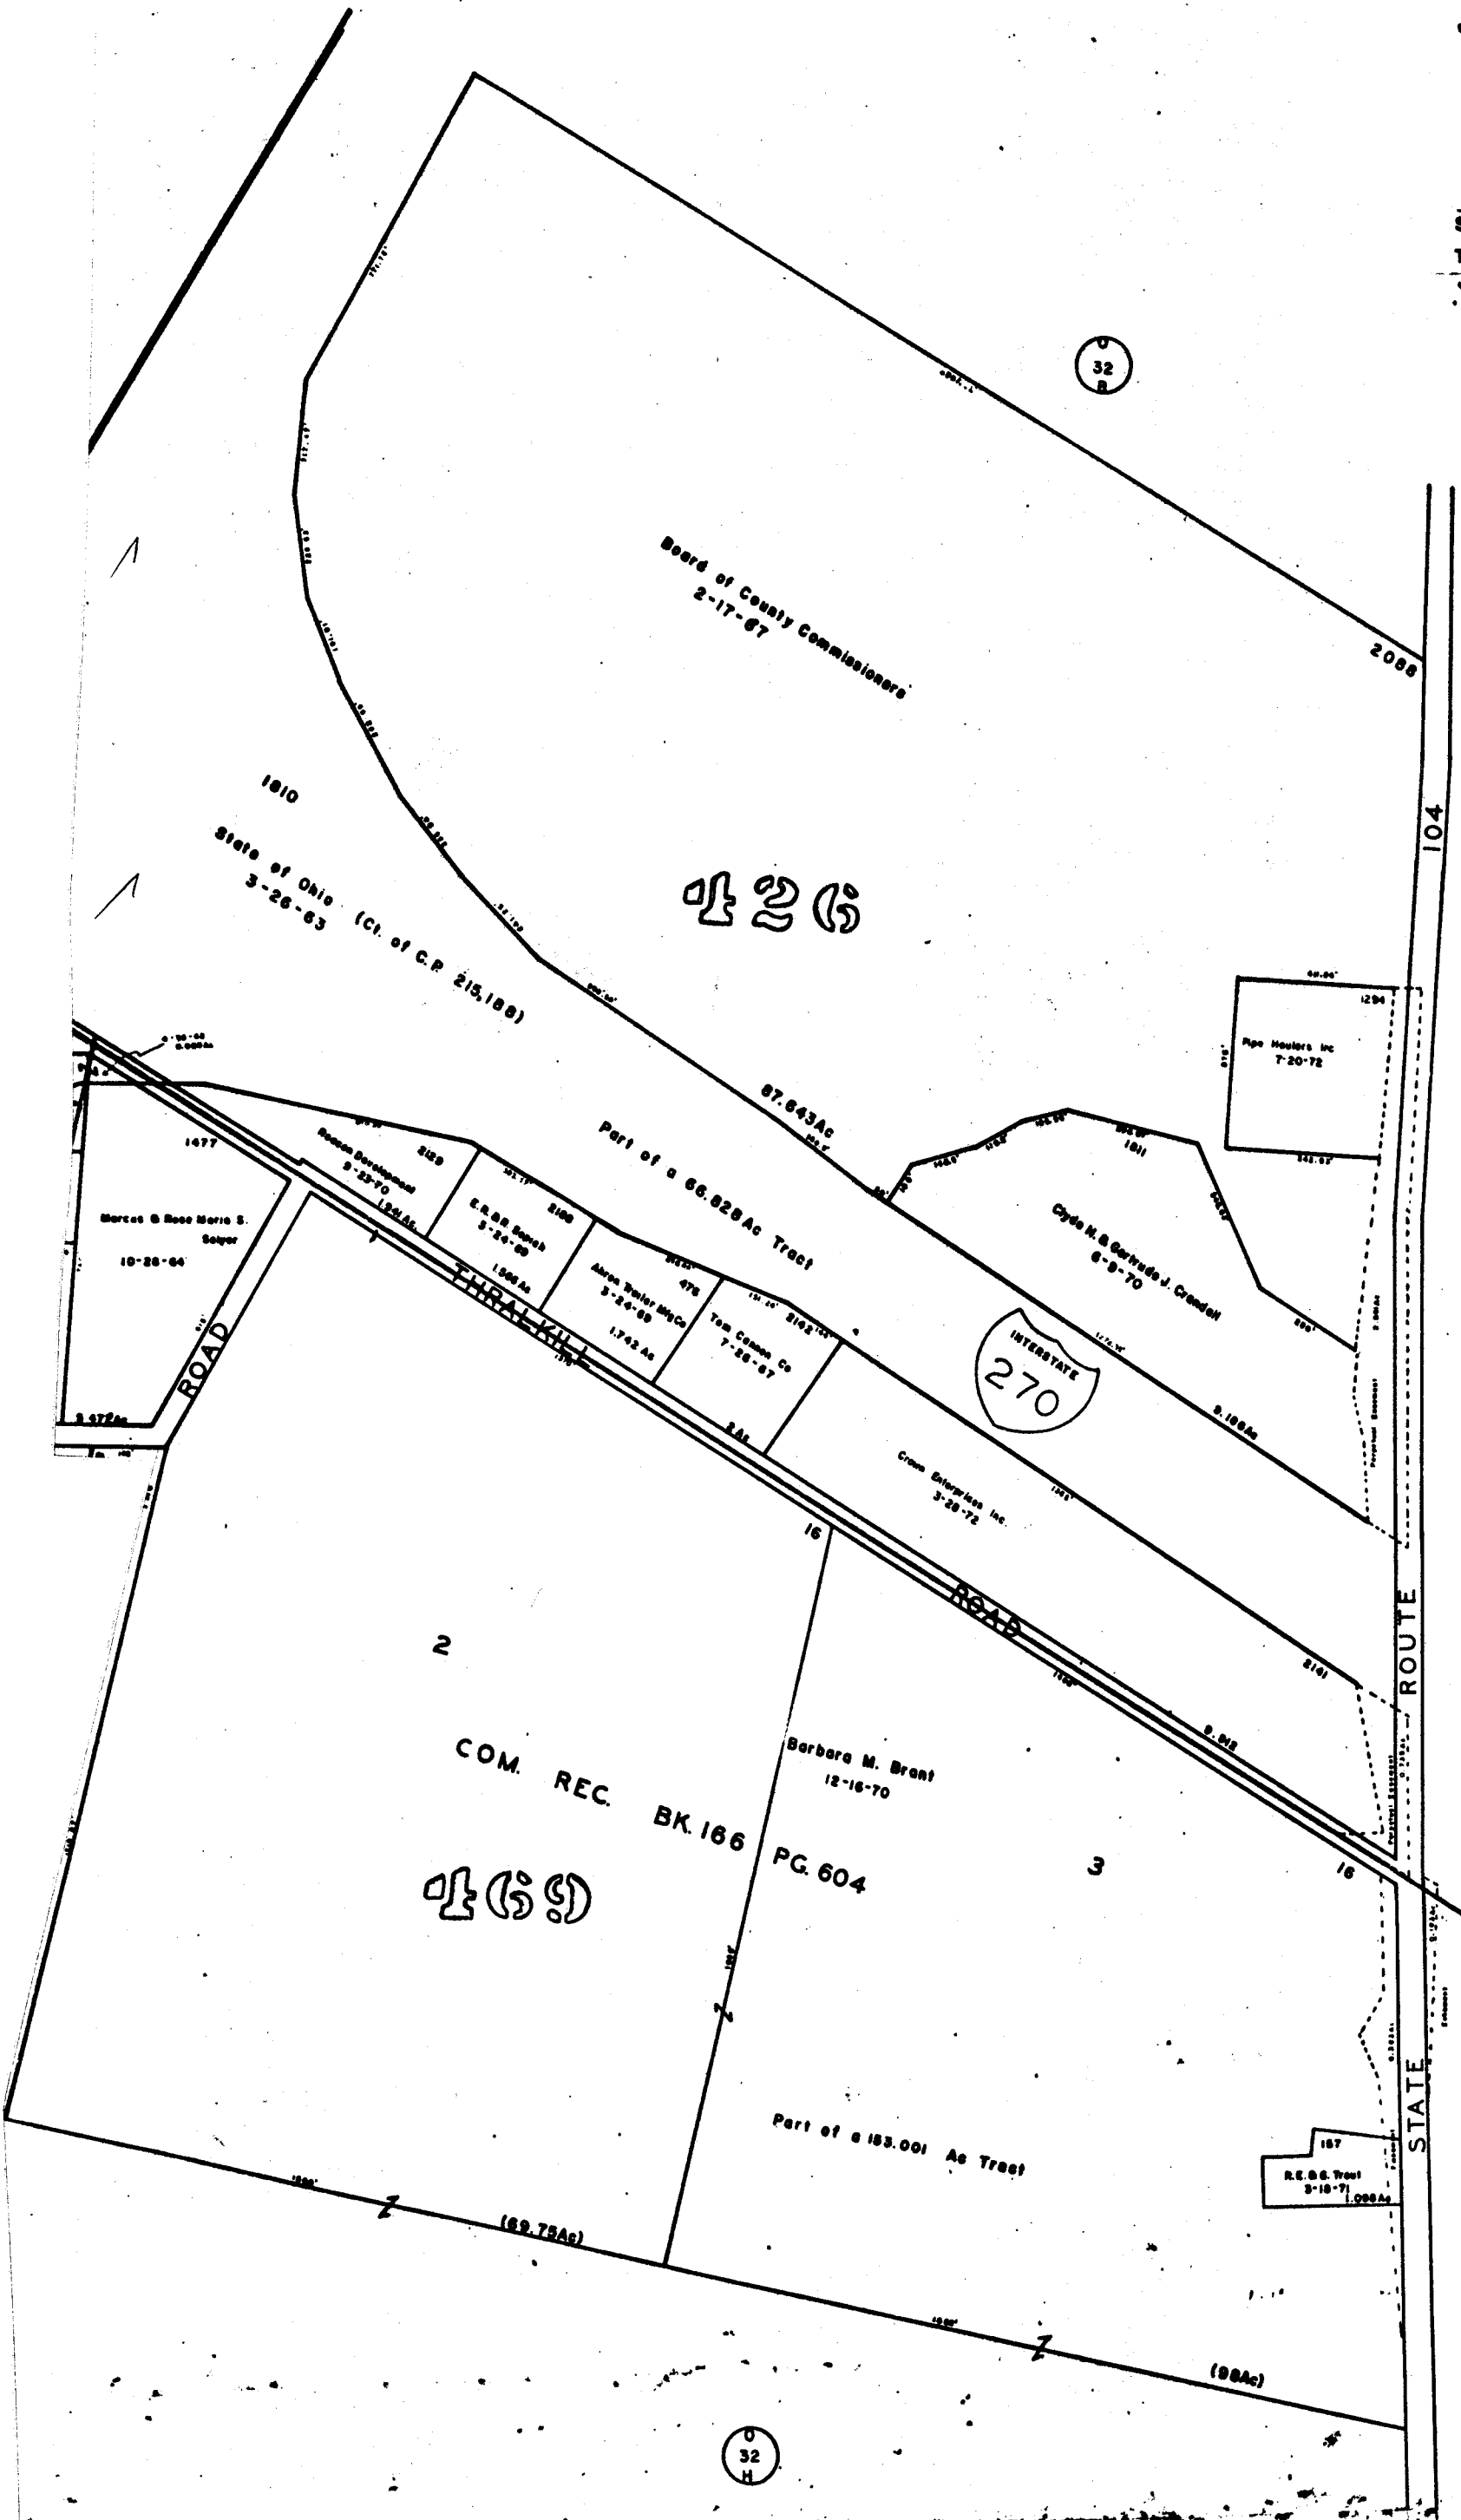

32 B

32 C

32 H

32 H

3272

0-3