


0  
31

TOWNSHIP  
PLEASANT

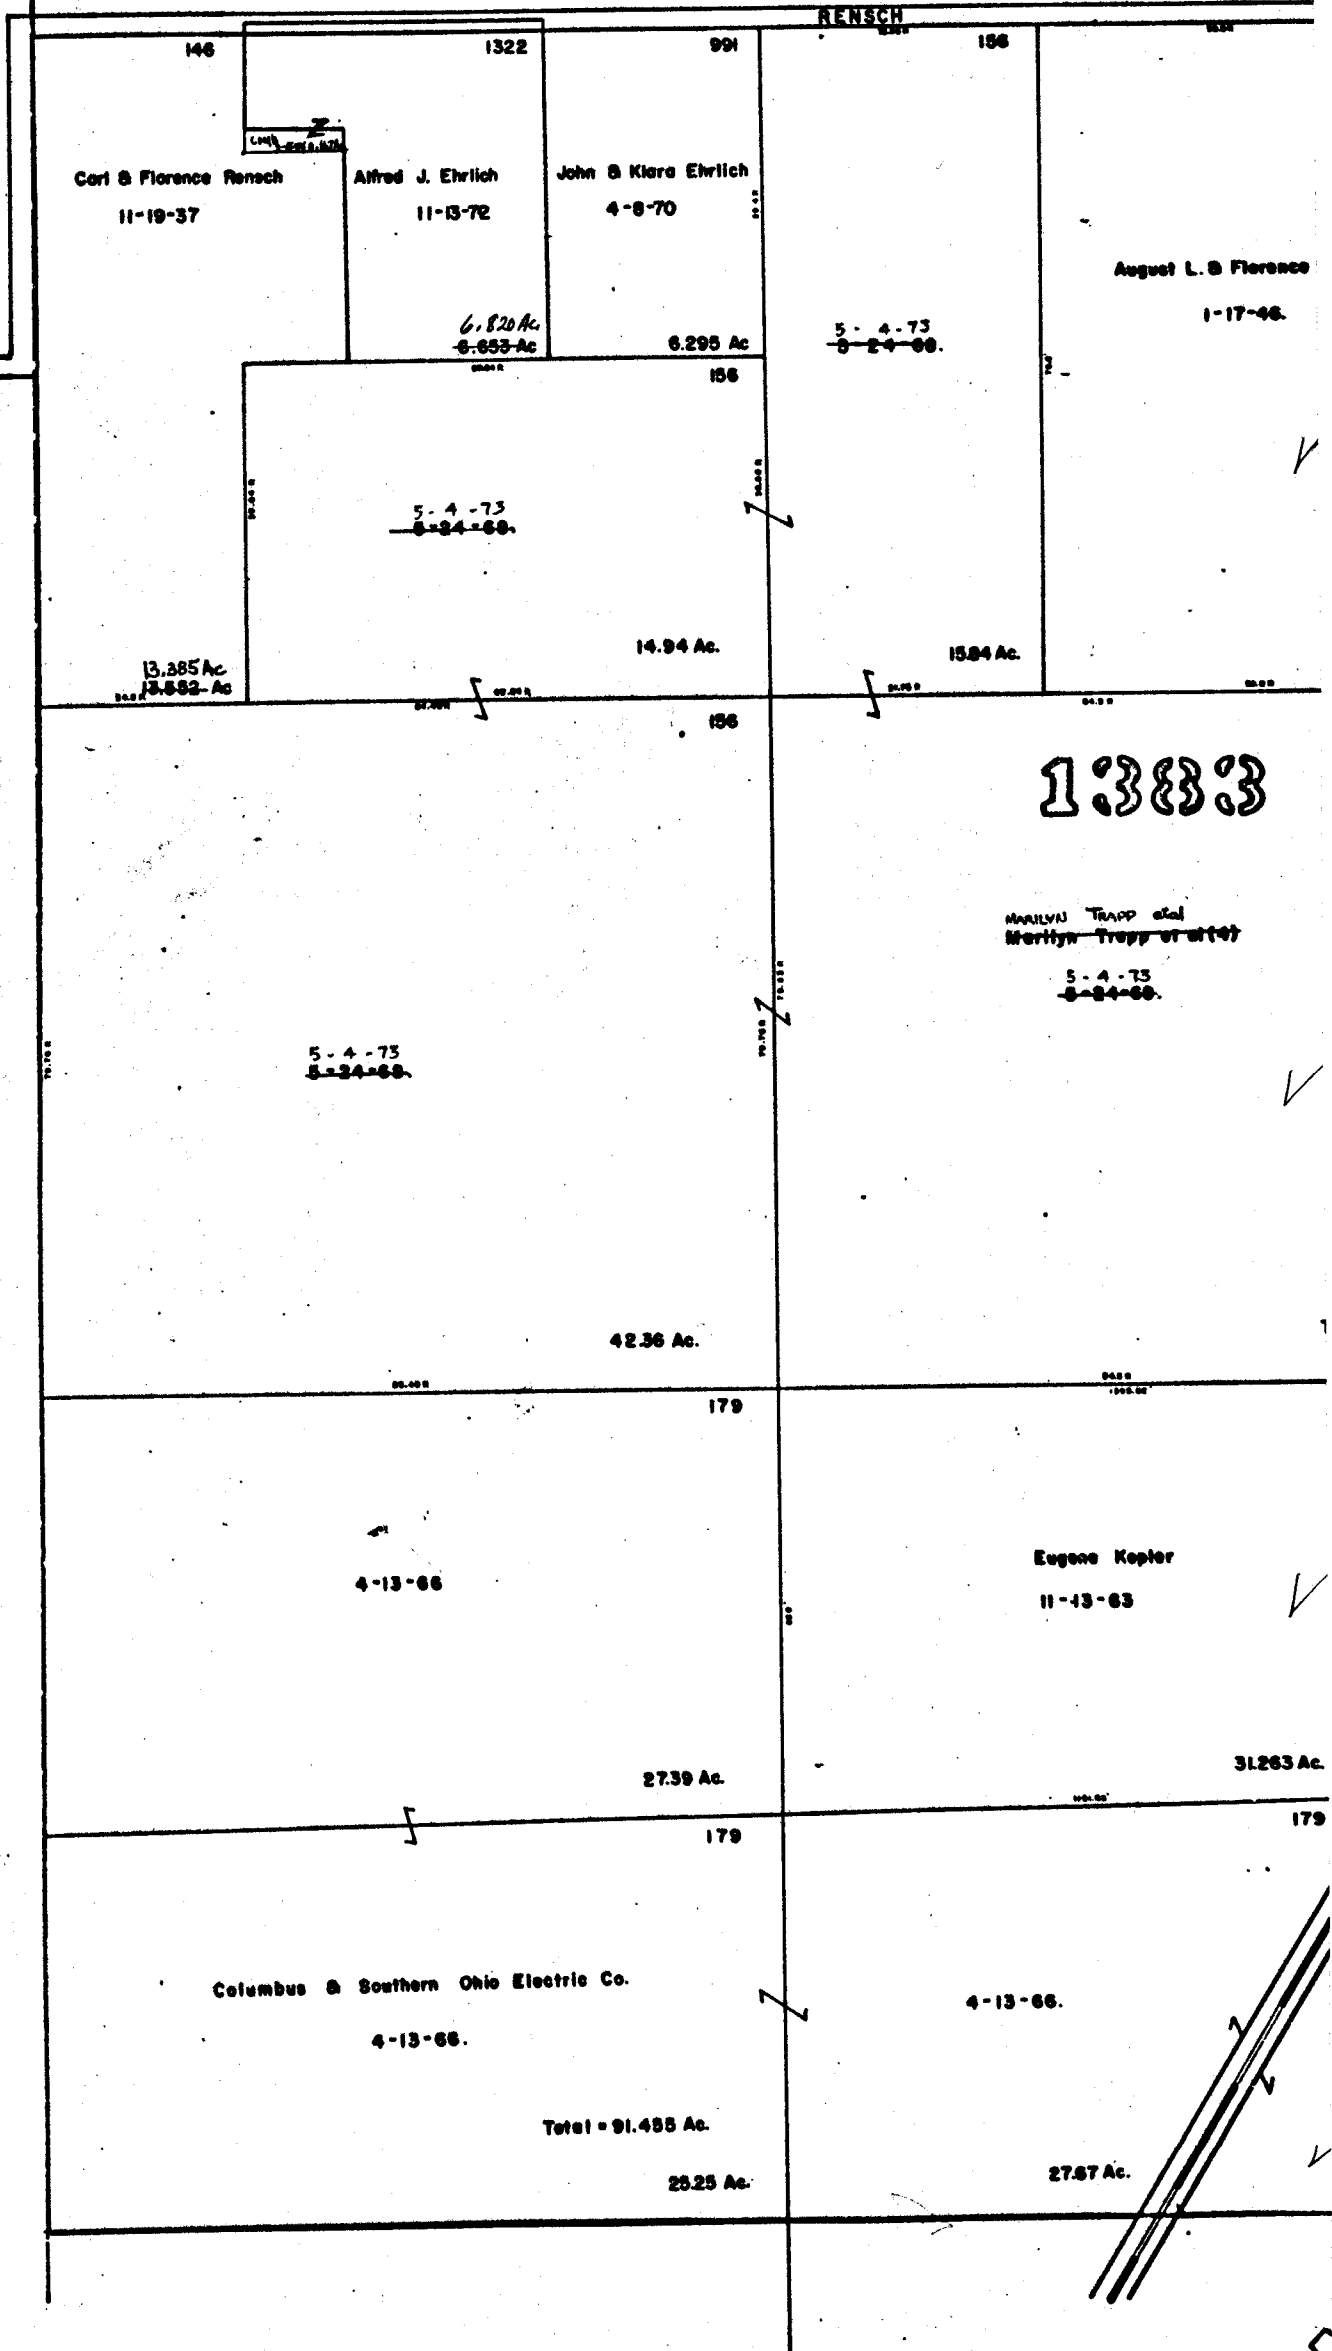

0  
63

3



SCALE 1" = 200'

JACKSON TWP.


V.M.S.

TAXING DISTRICT

JACKSON TWP.

0  
31

0  
33  
B

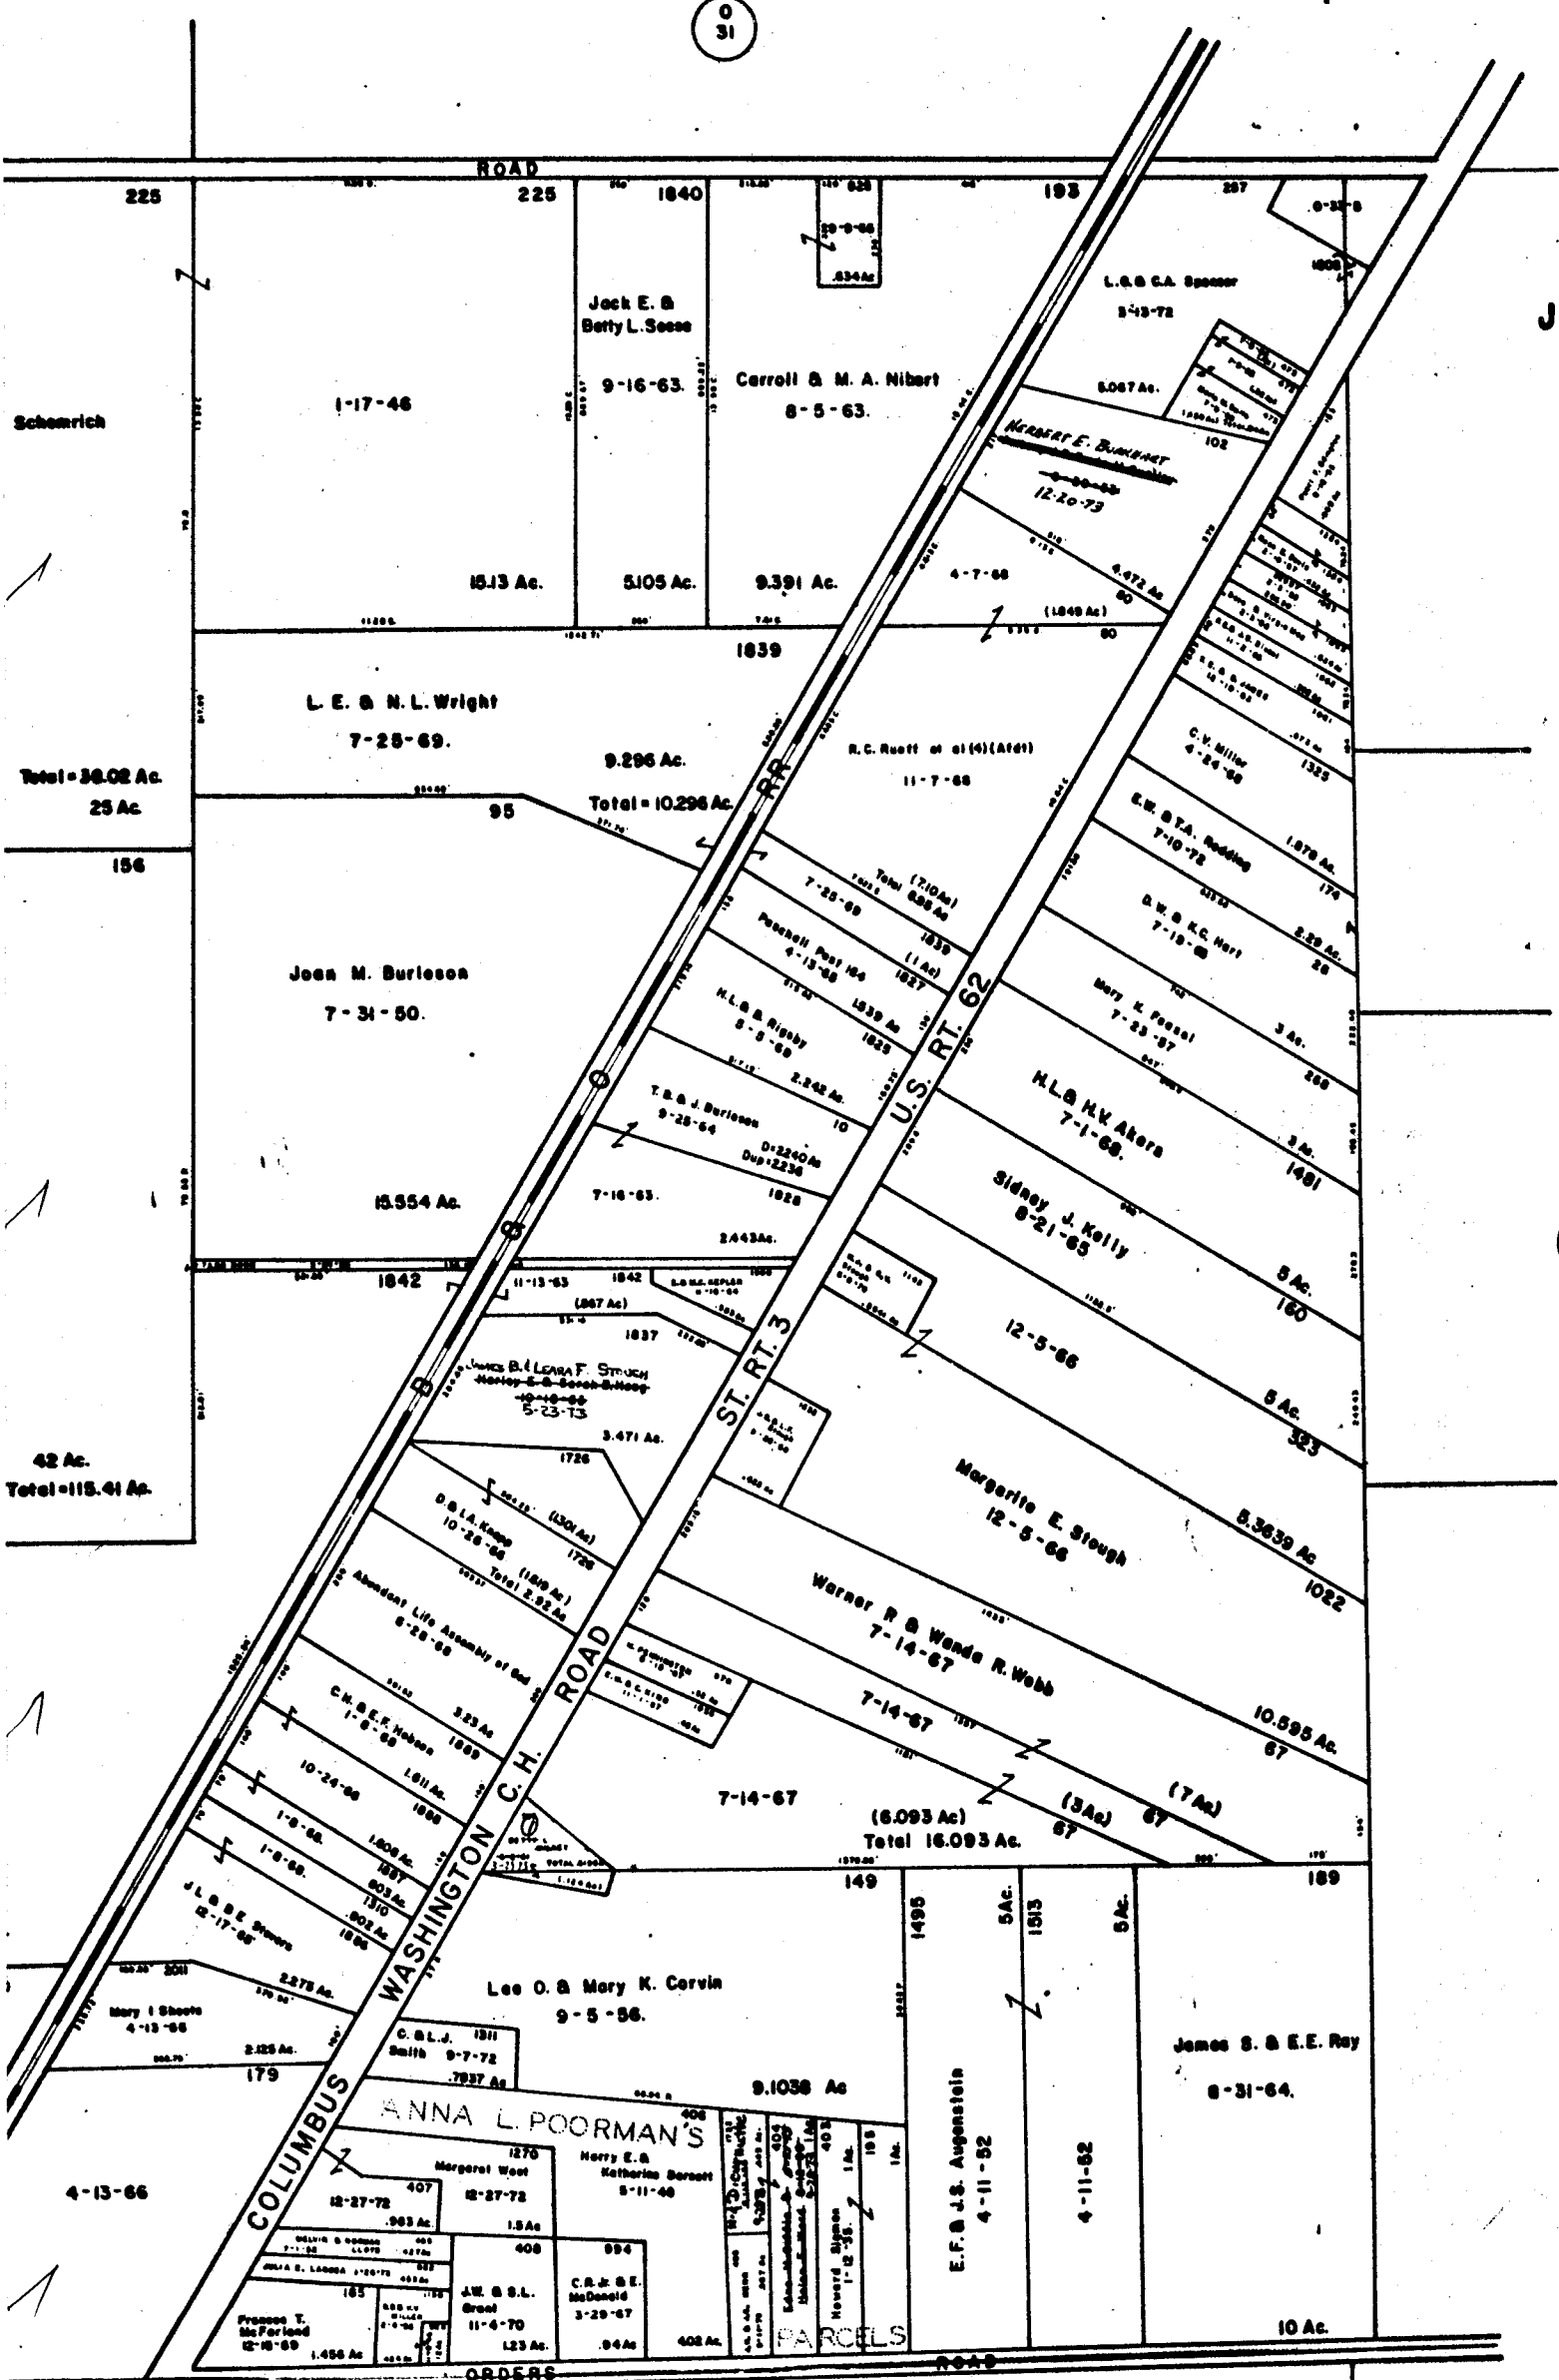

62

0  
33  
D