


PLEASANT TWP. 30




O-35-C
JACKSON TWP

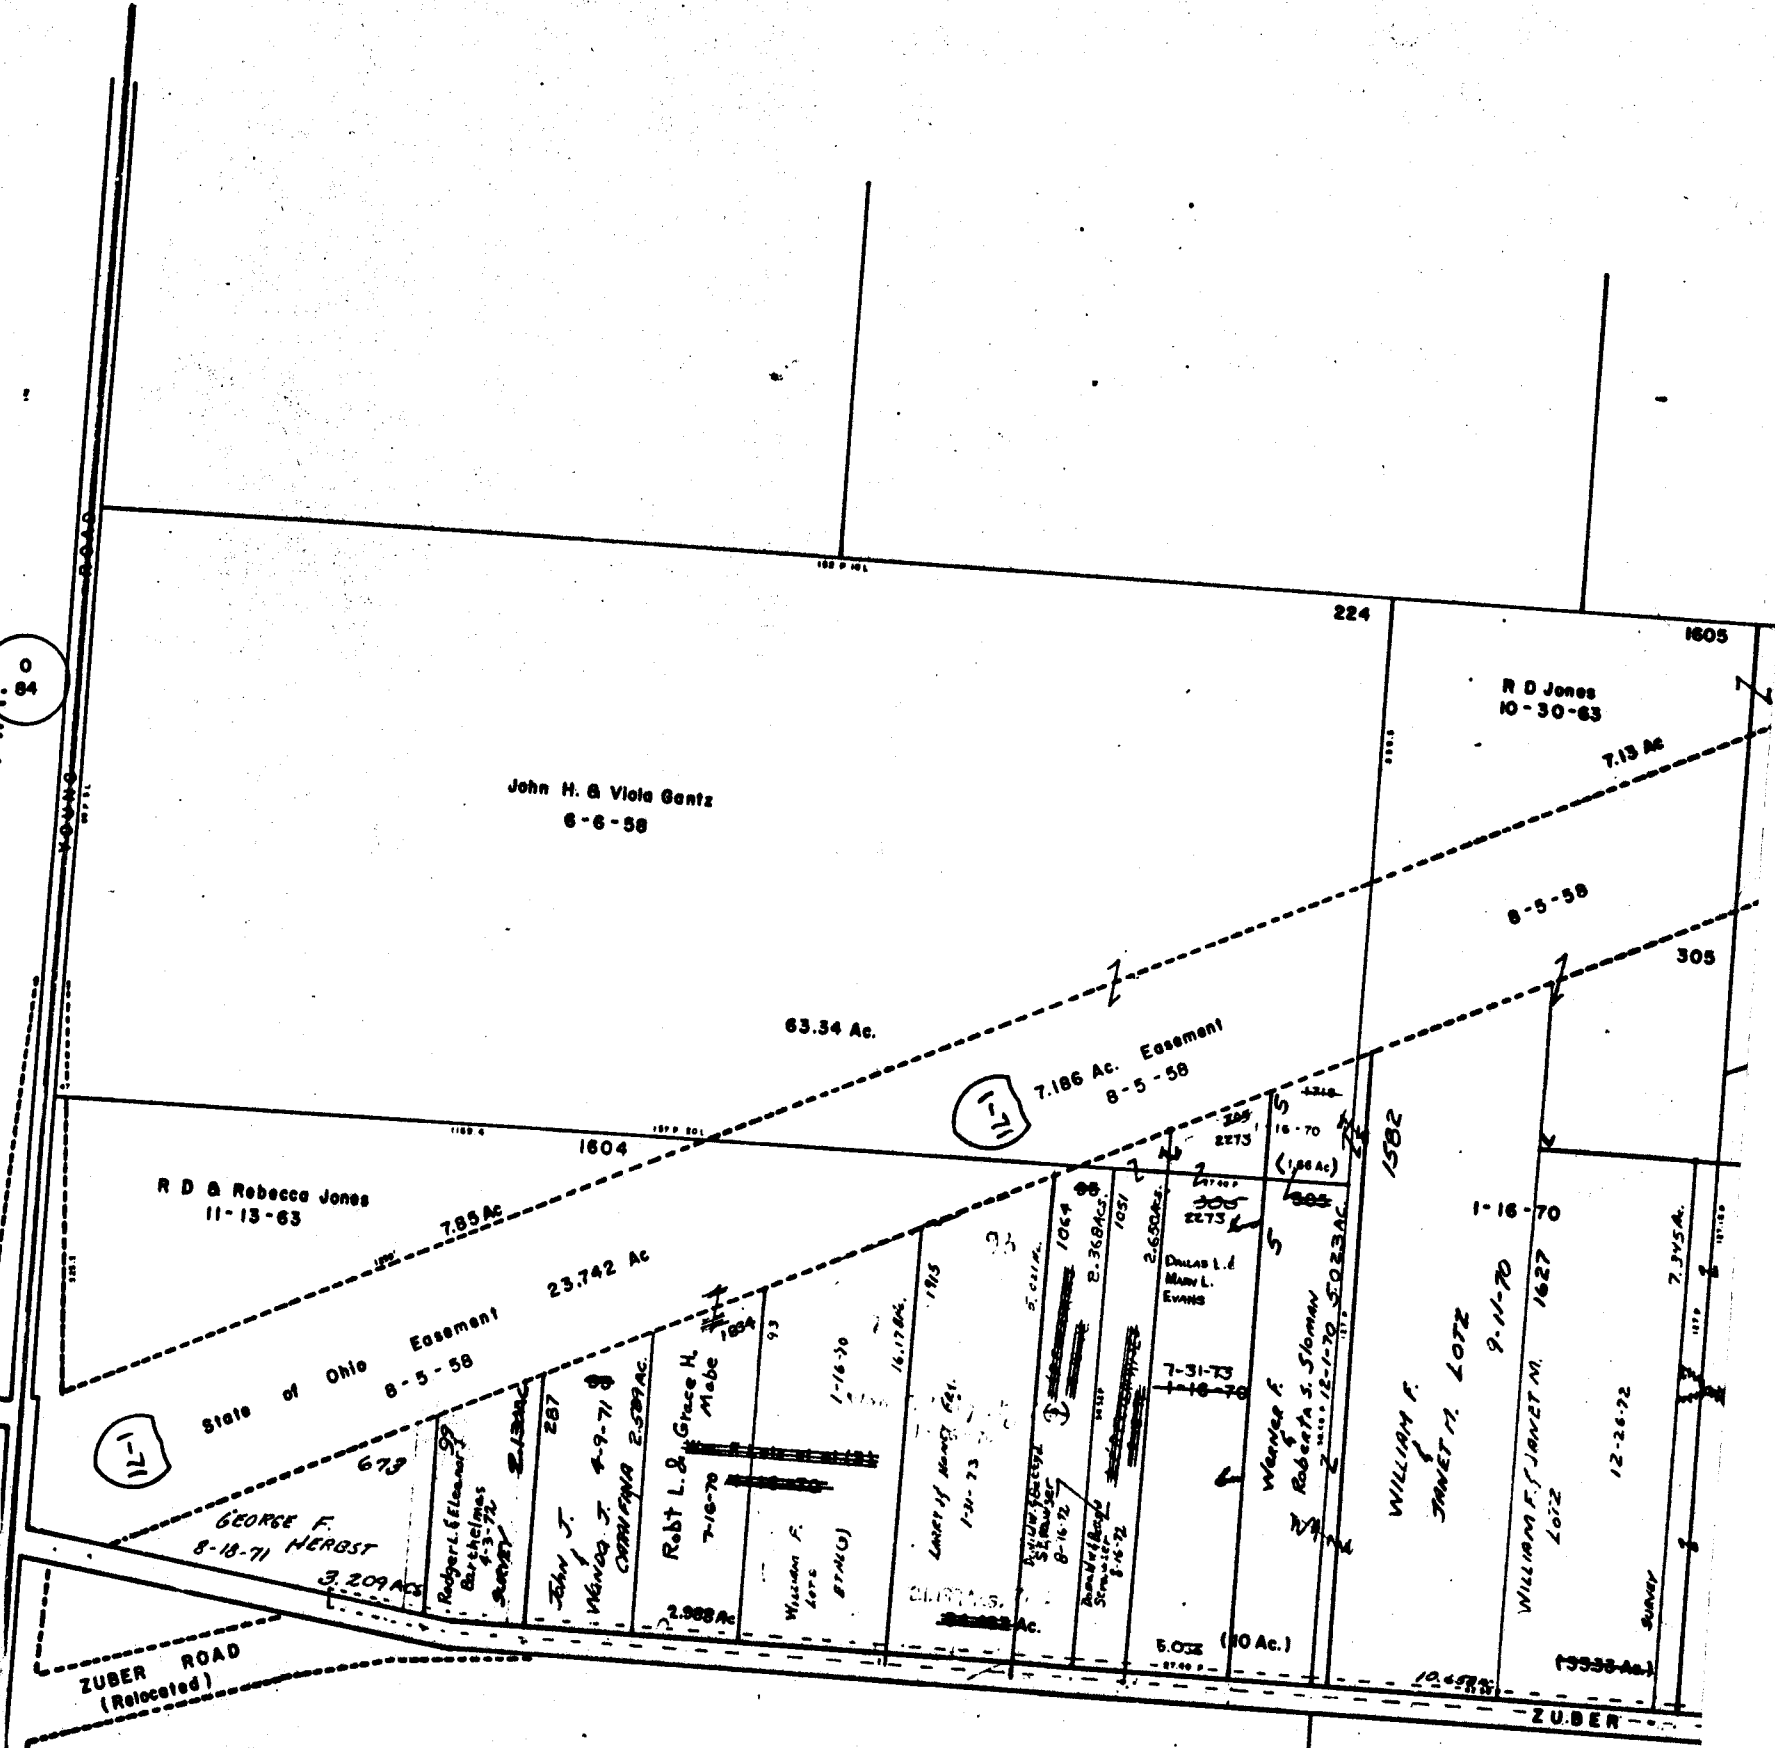

SCALE 1" = 200'
V.M.S.
TAXING DISTRICT
JACKSON TWP

O
35
A

O
35
B

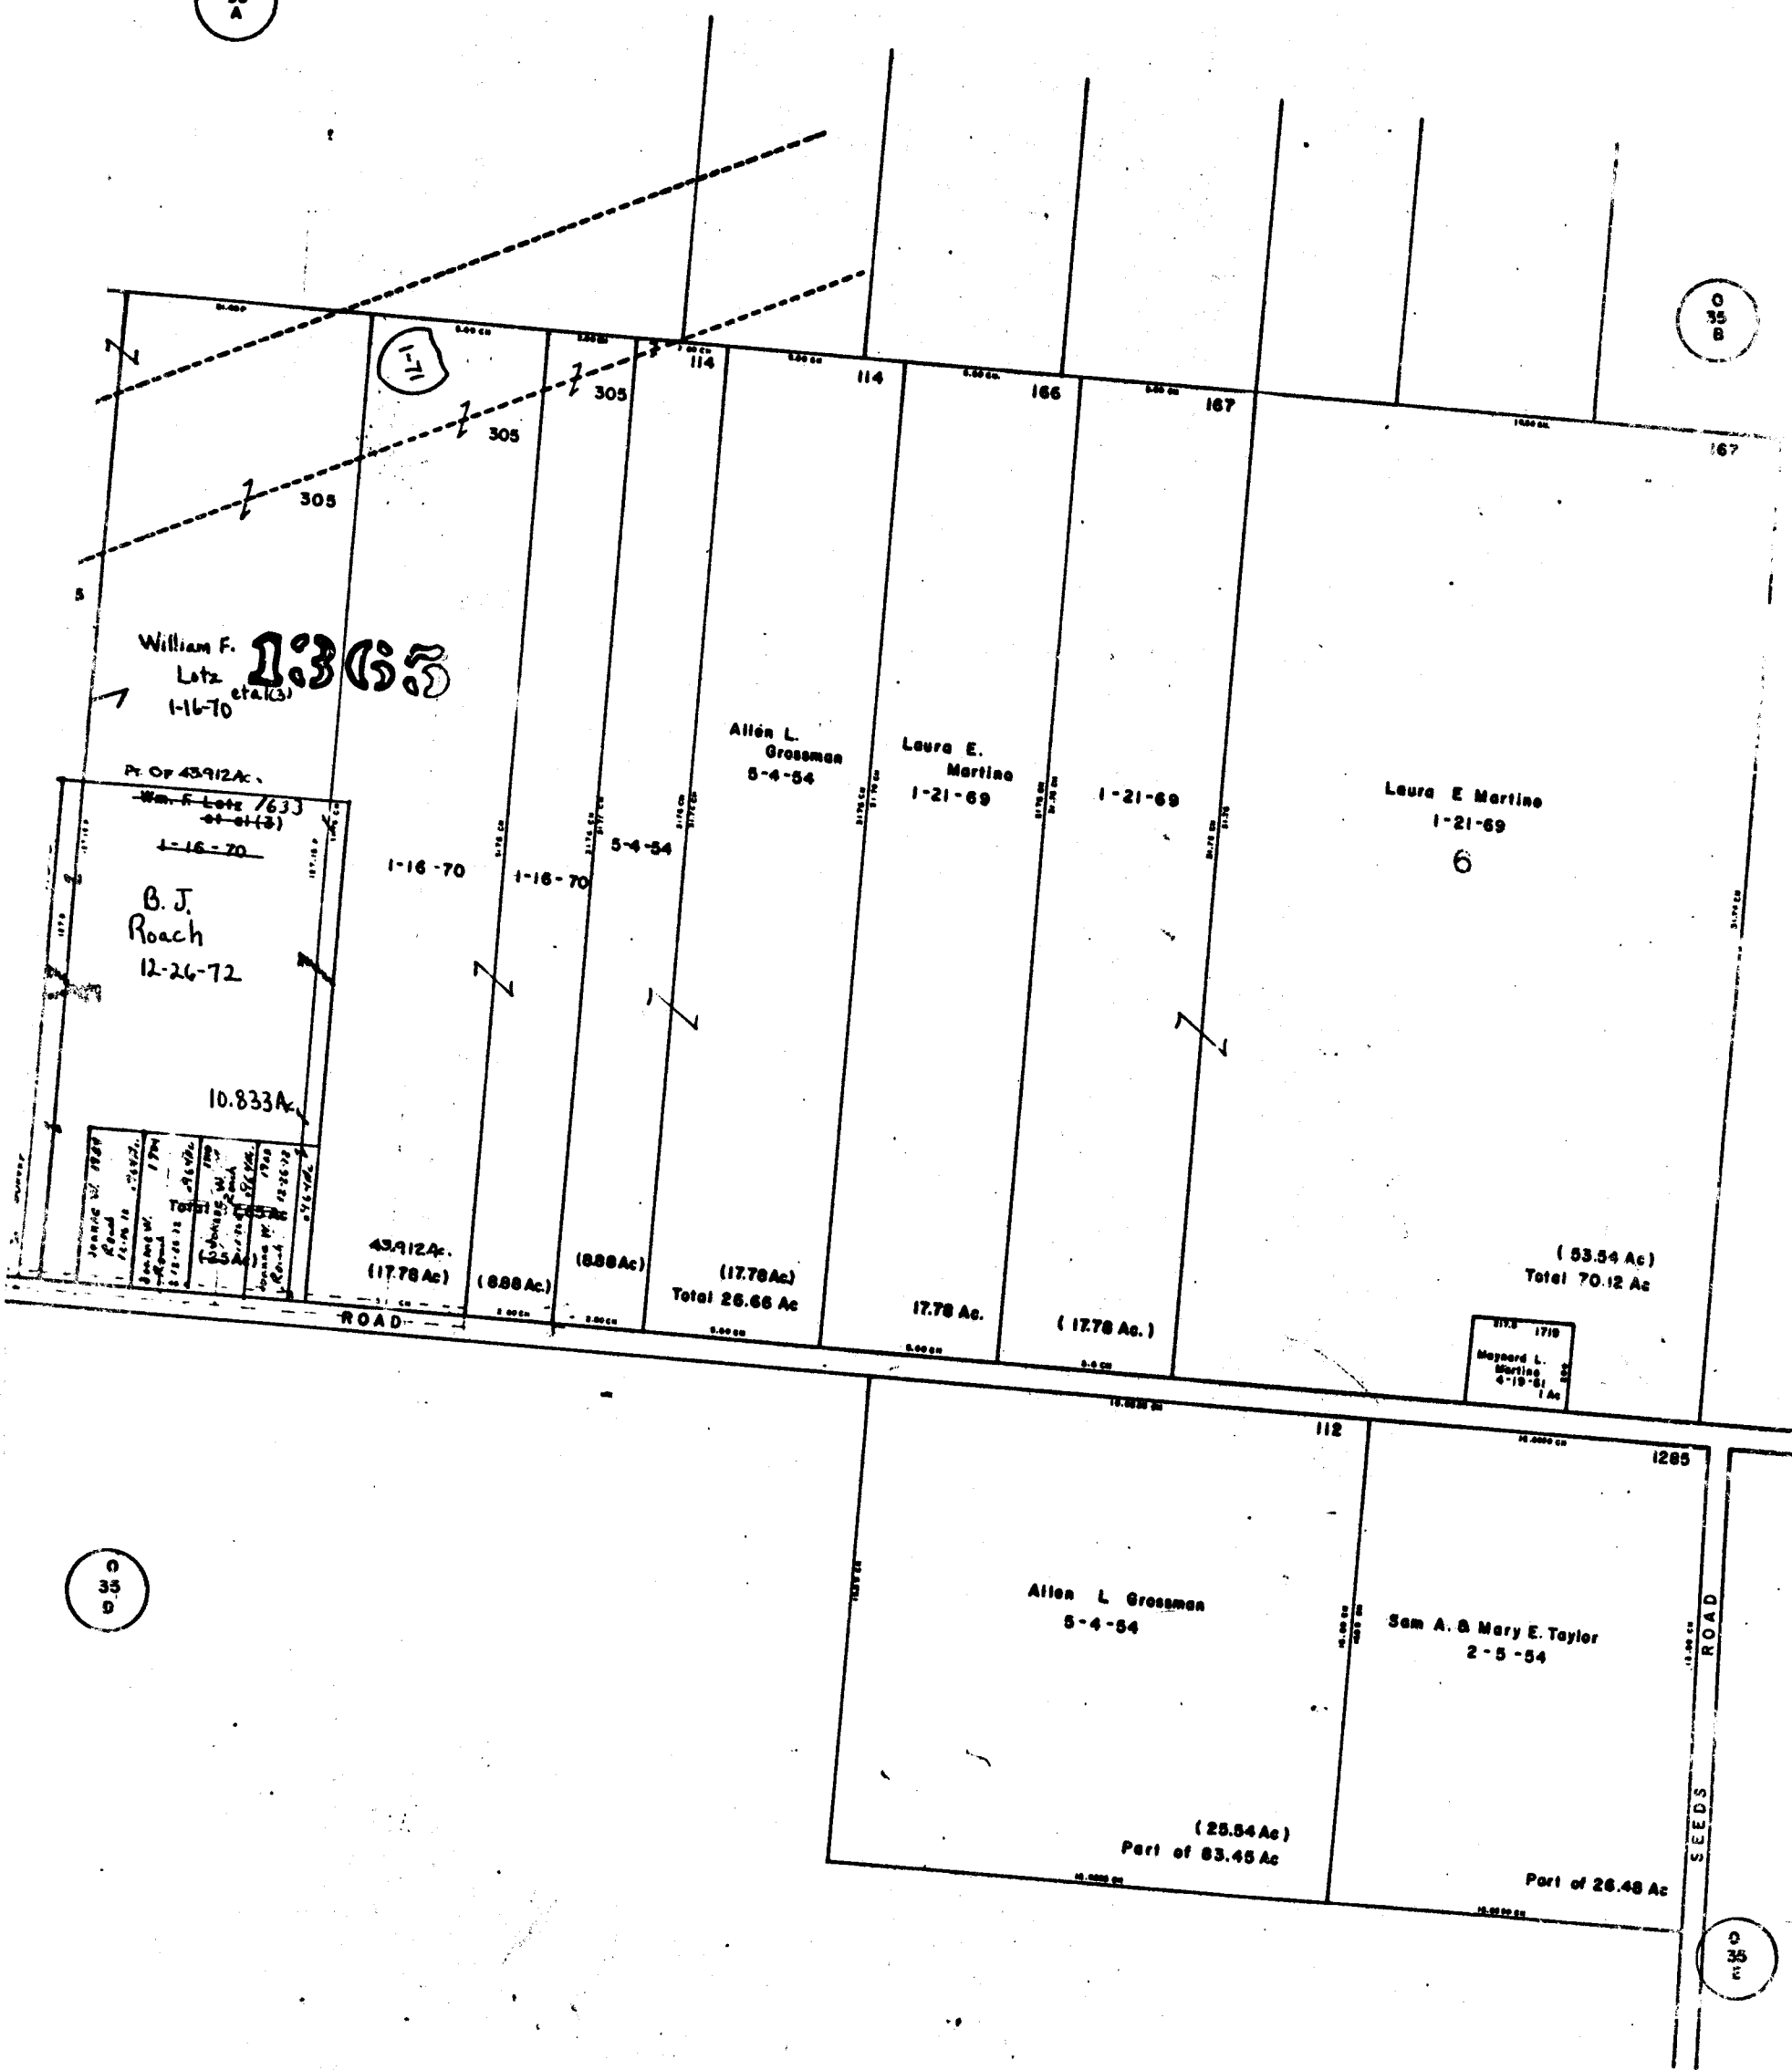

O
35
D

O
35
E