


0
34
E

0
34
E

0
34
E

0
31
E

0
36
A

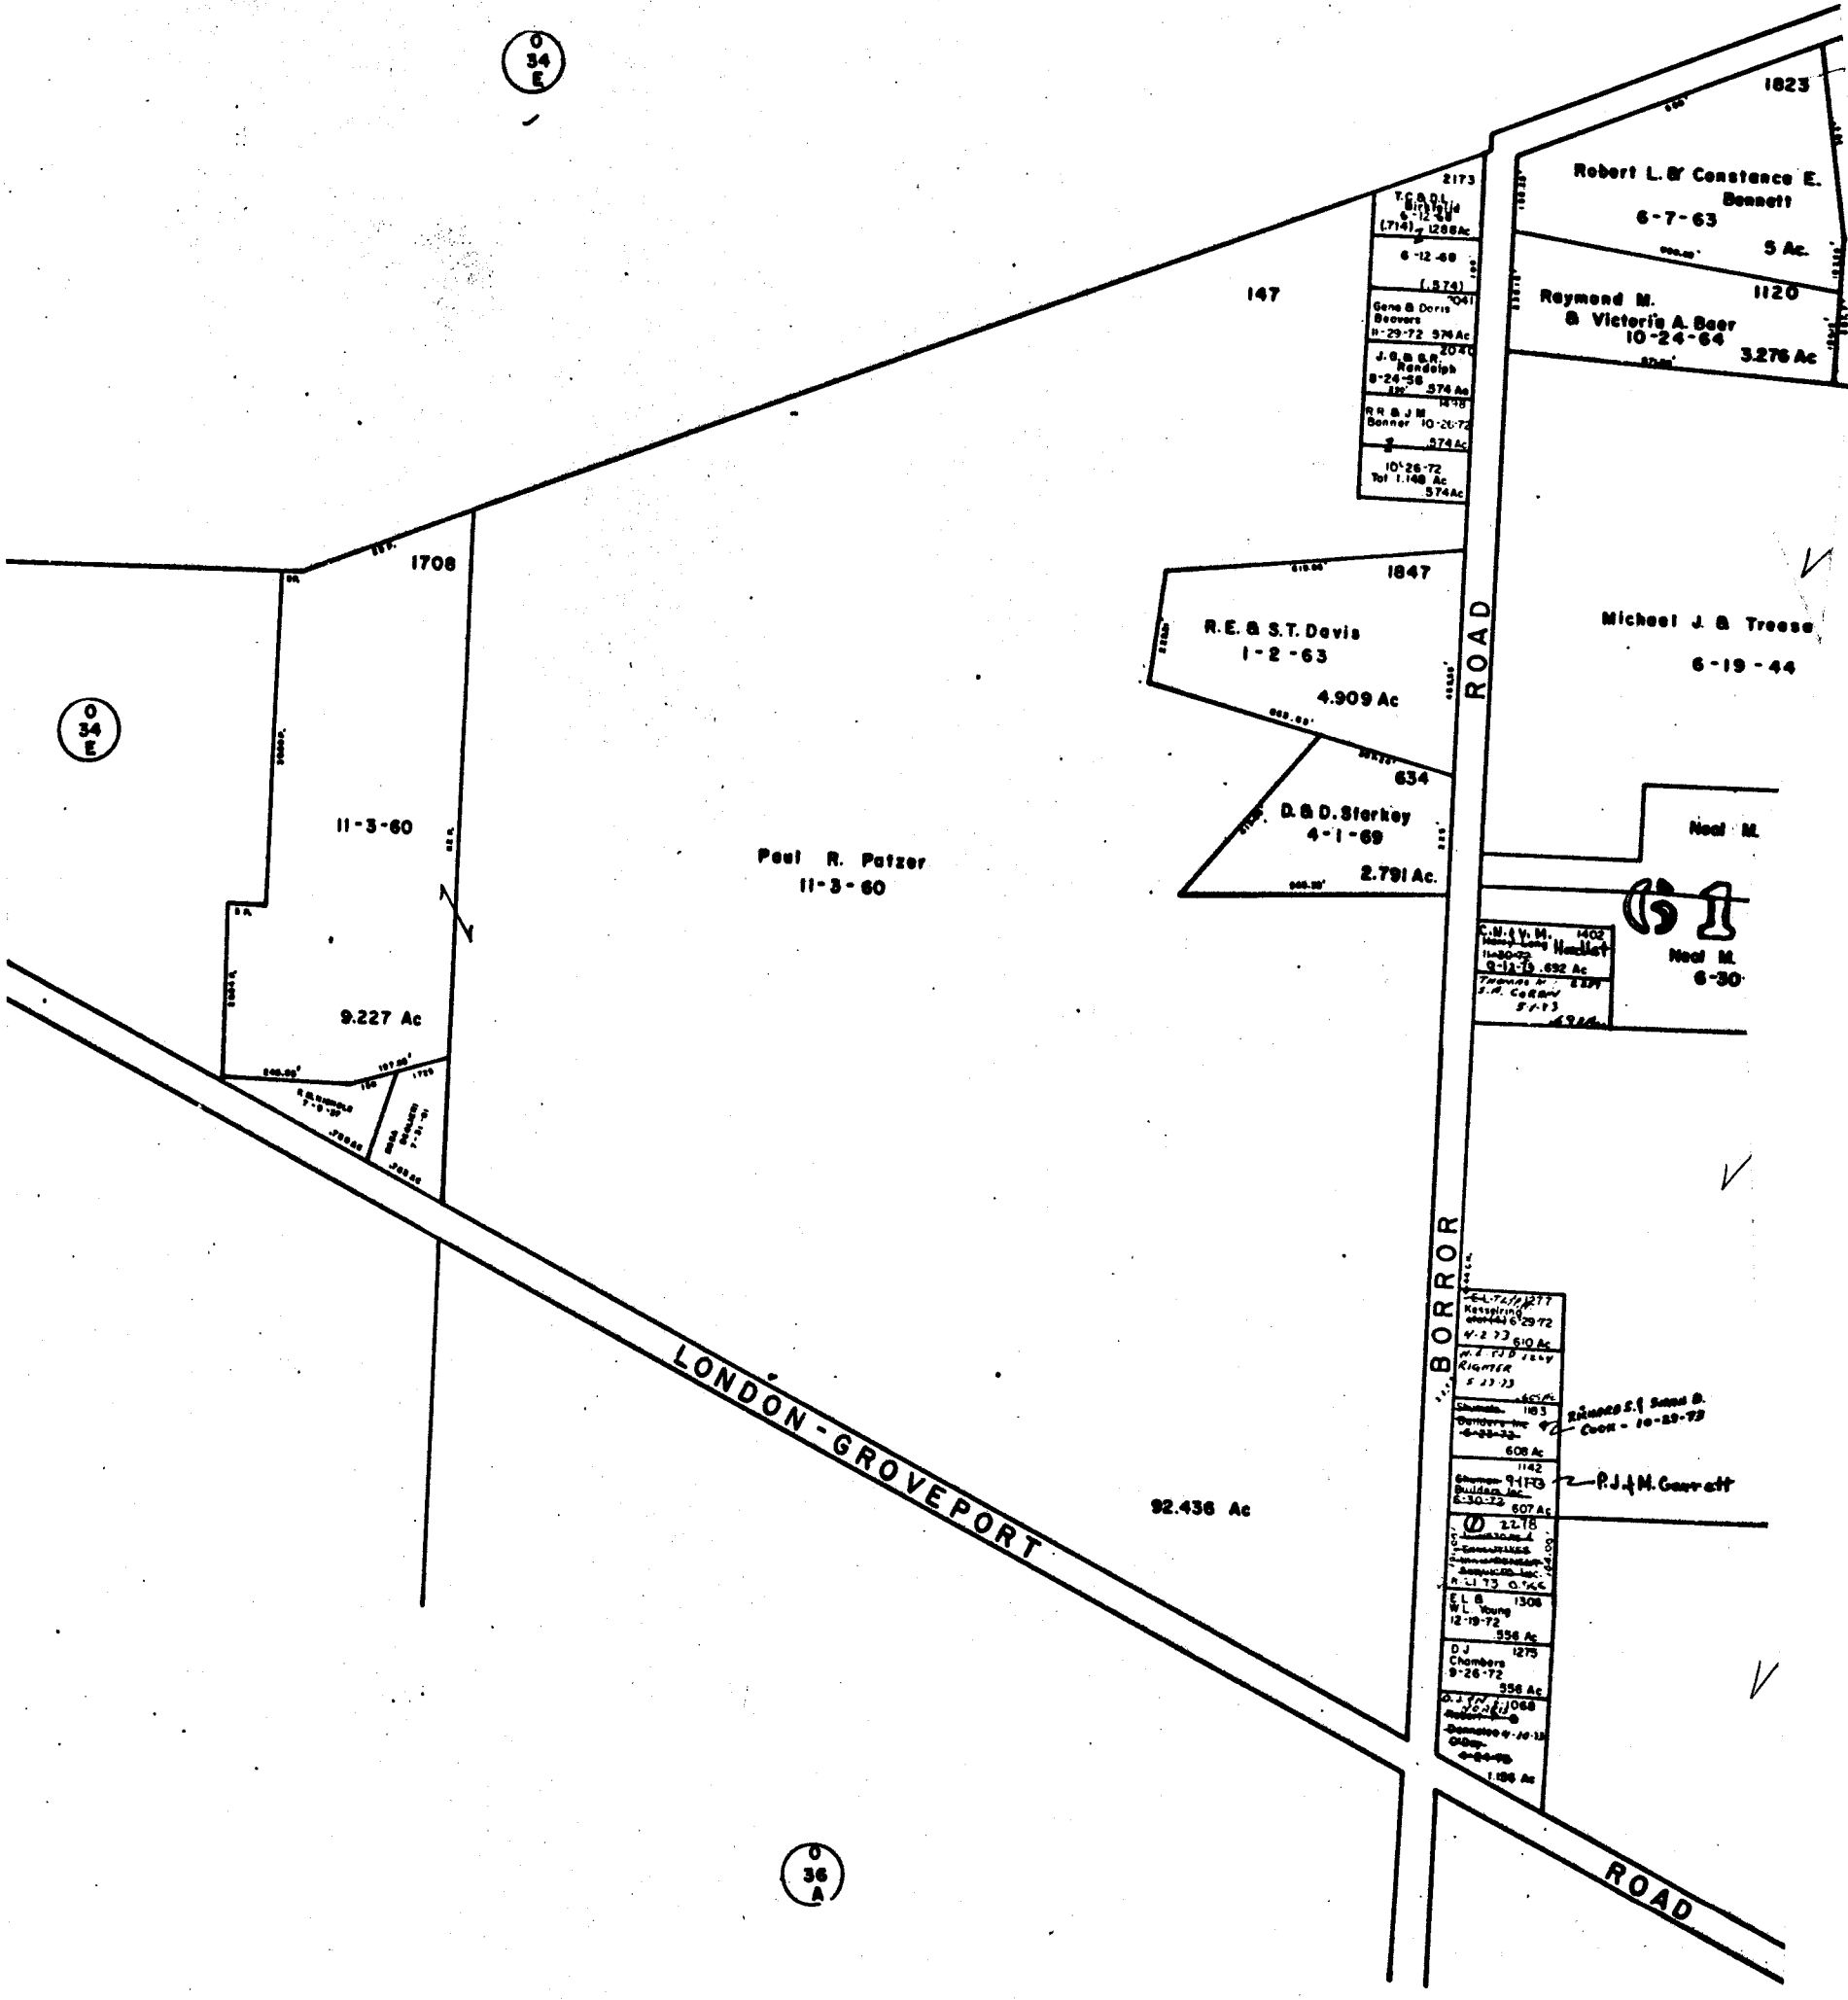


O-36-B
JACKSON TWP



SCALE 1" = 200'

VMS

TAXING DISTRICT
JACKSON TWP

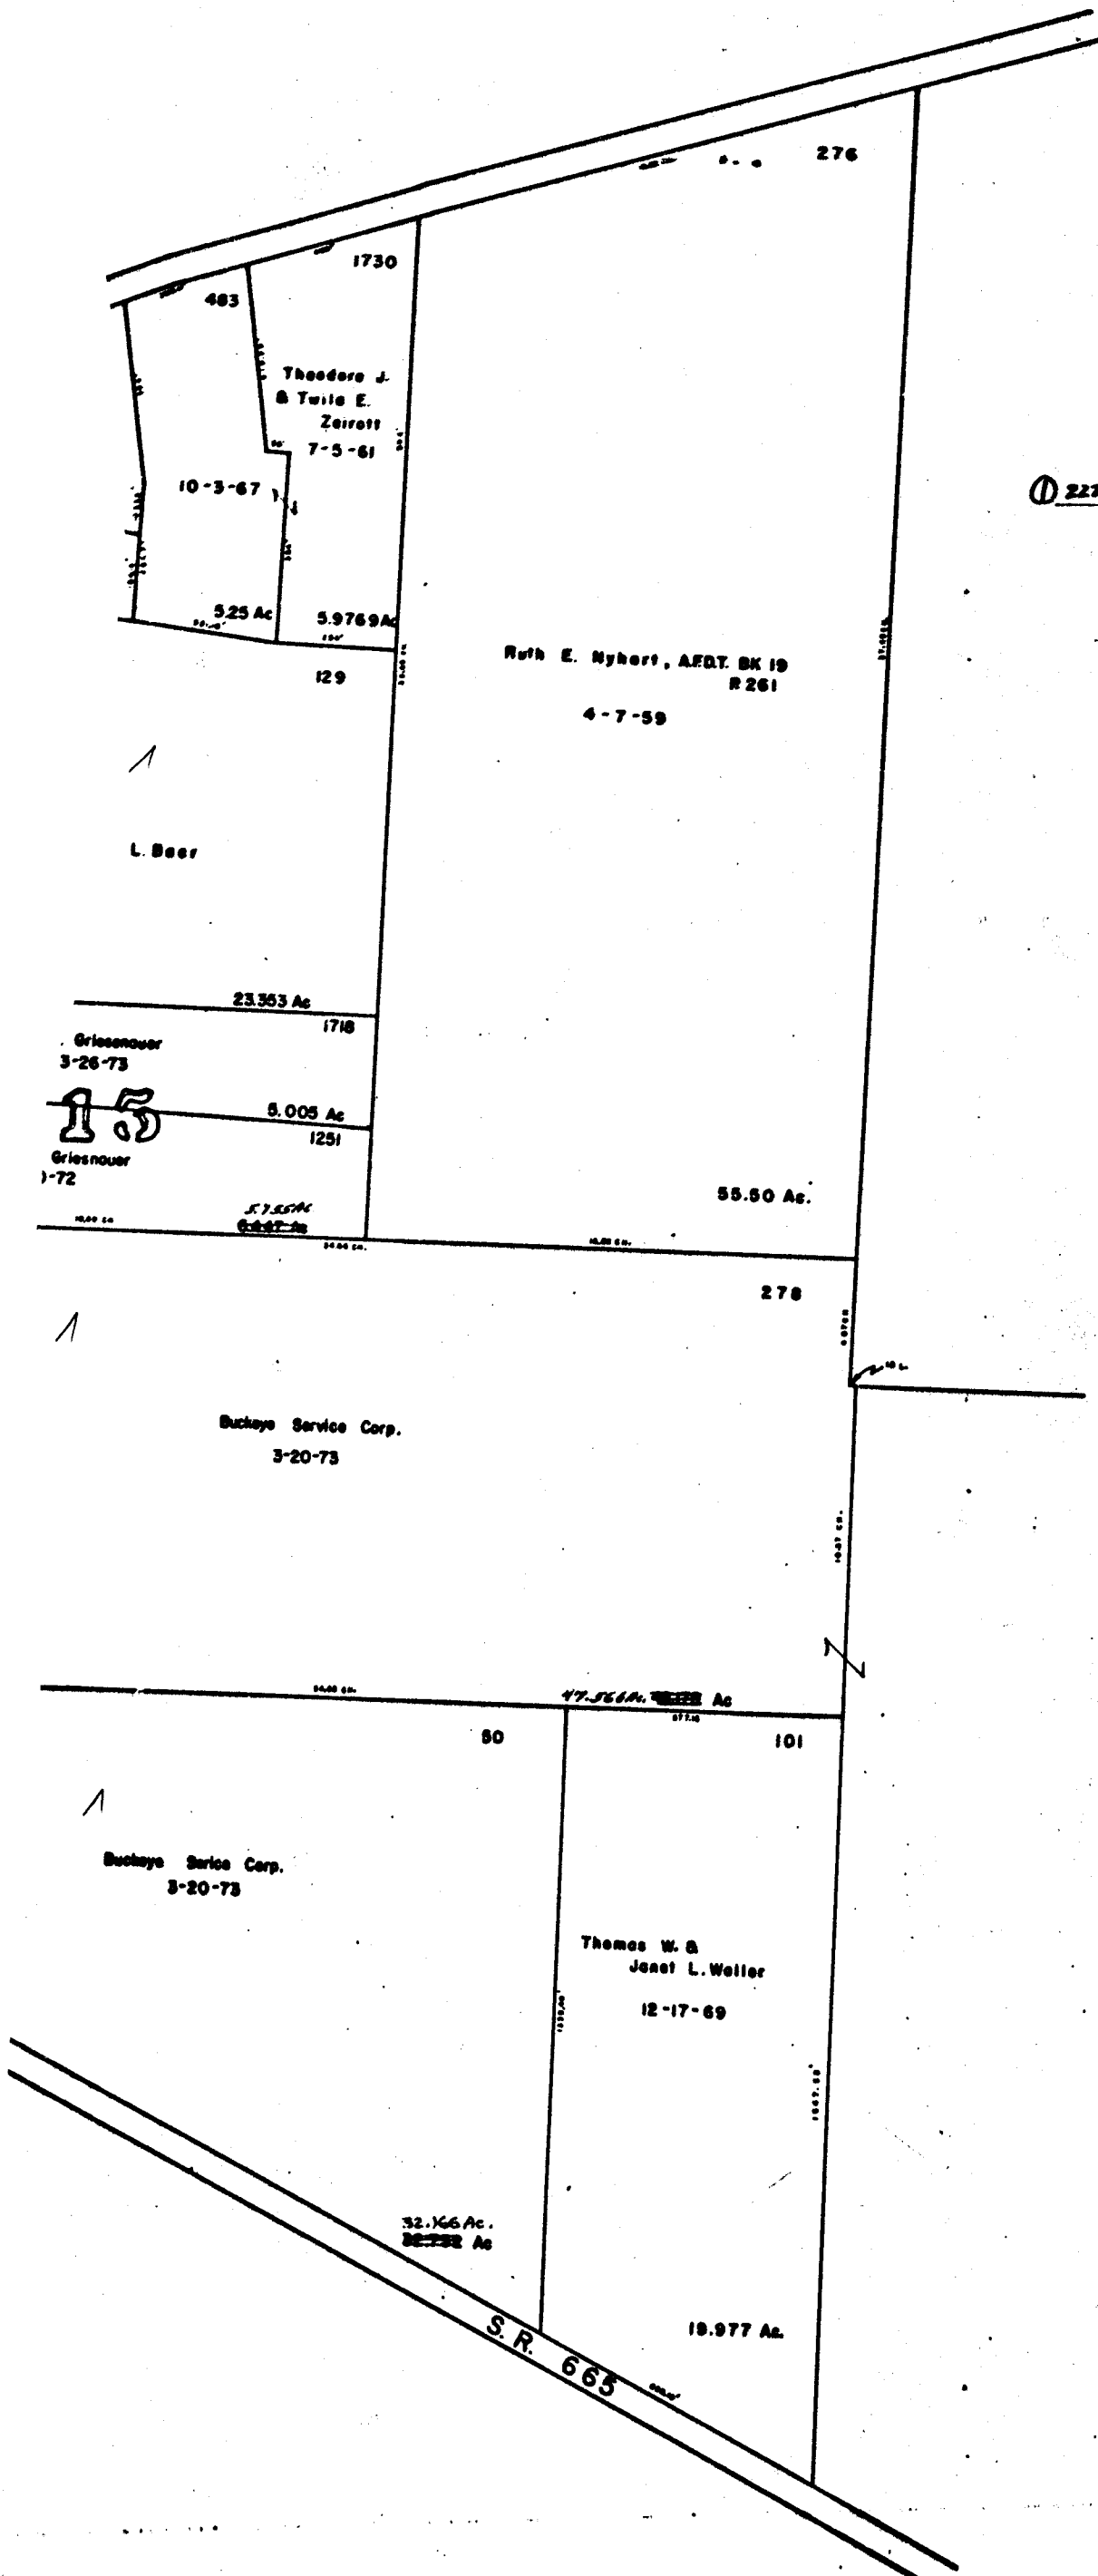

① 2278 - Theodore J. & Twila E. Zierott
Surveyed & Platted for 6-24-73

O-36-B

3336

