


@ DROP STATE OF OHIO (Hwy) 2-19-72 0.1384
 @ DROP " " " (City) 7-19-72 0.4184

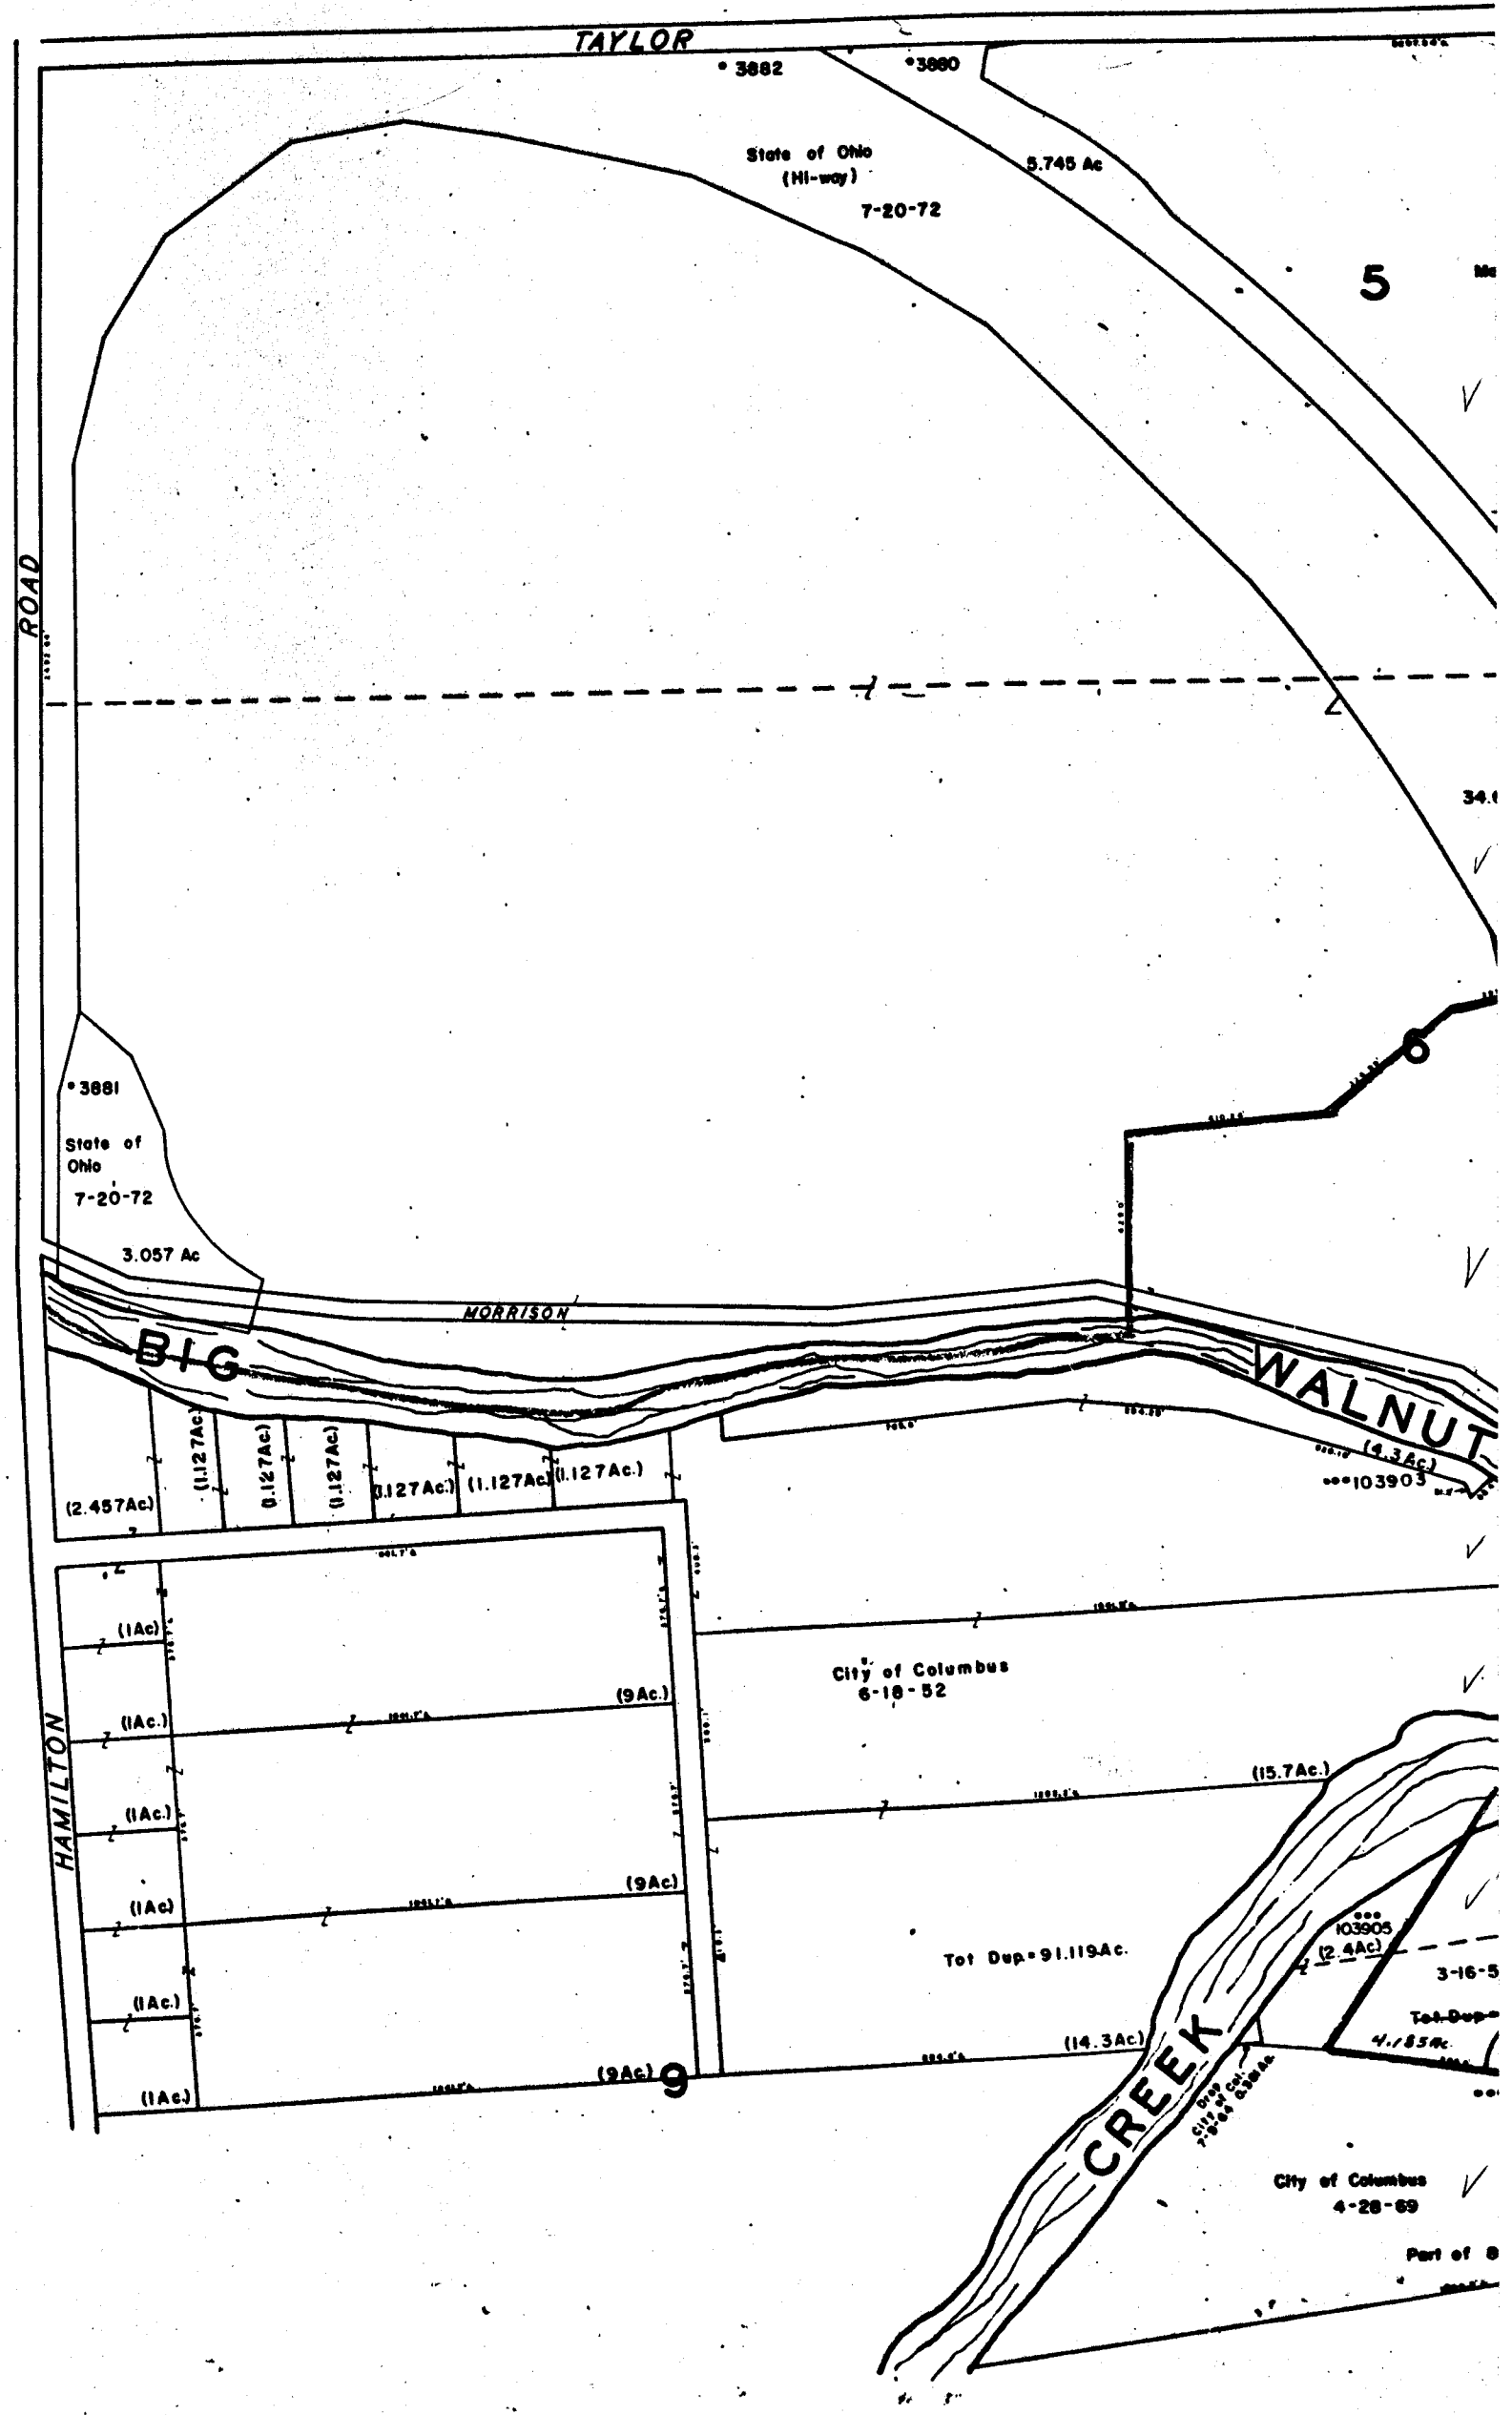

O-39-D


JEFFERSON TWP

R.16, TWP1



SCALE 1" = 200'
TAXING DISTRICTS
• CITY OF GAHANNA
••• COLUMBUS SD.

0
39
A

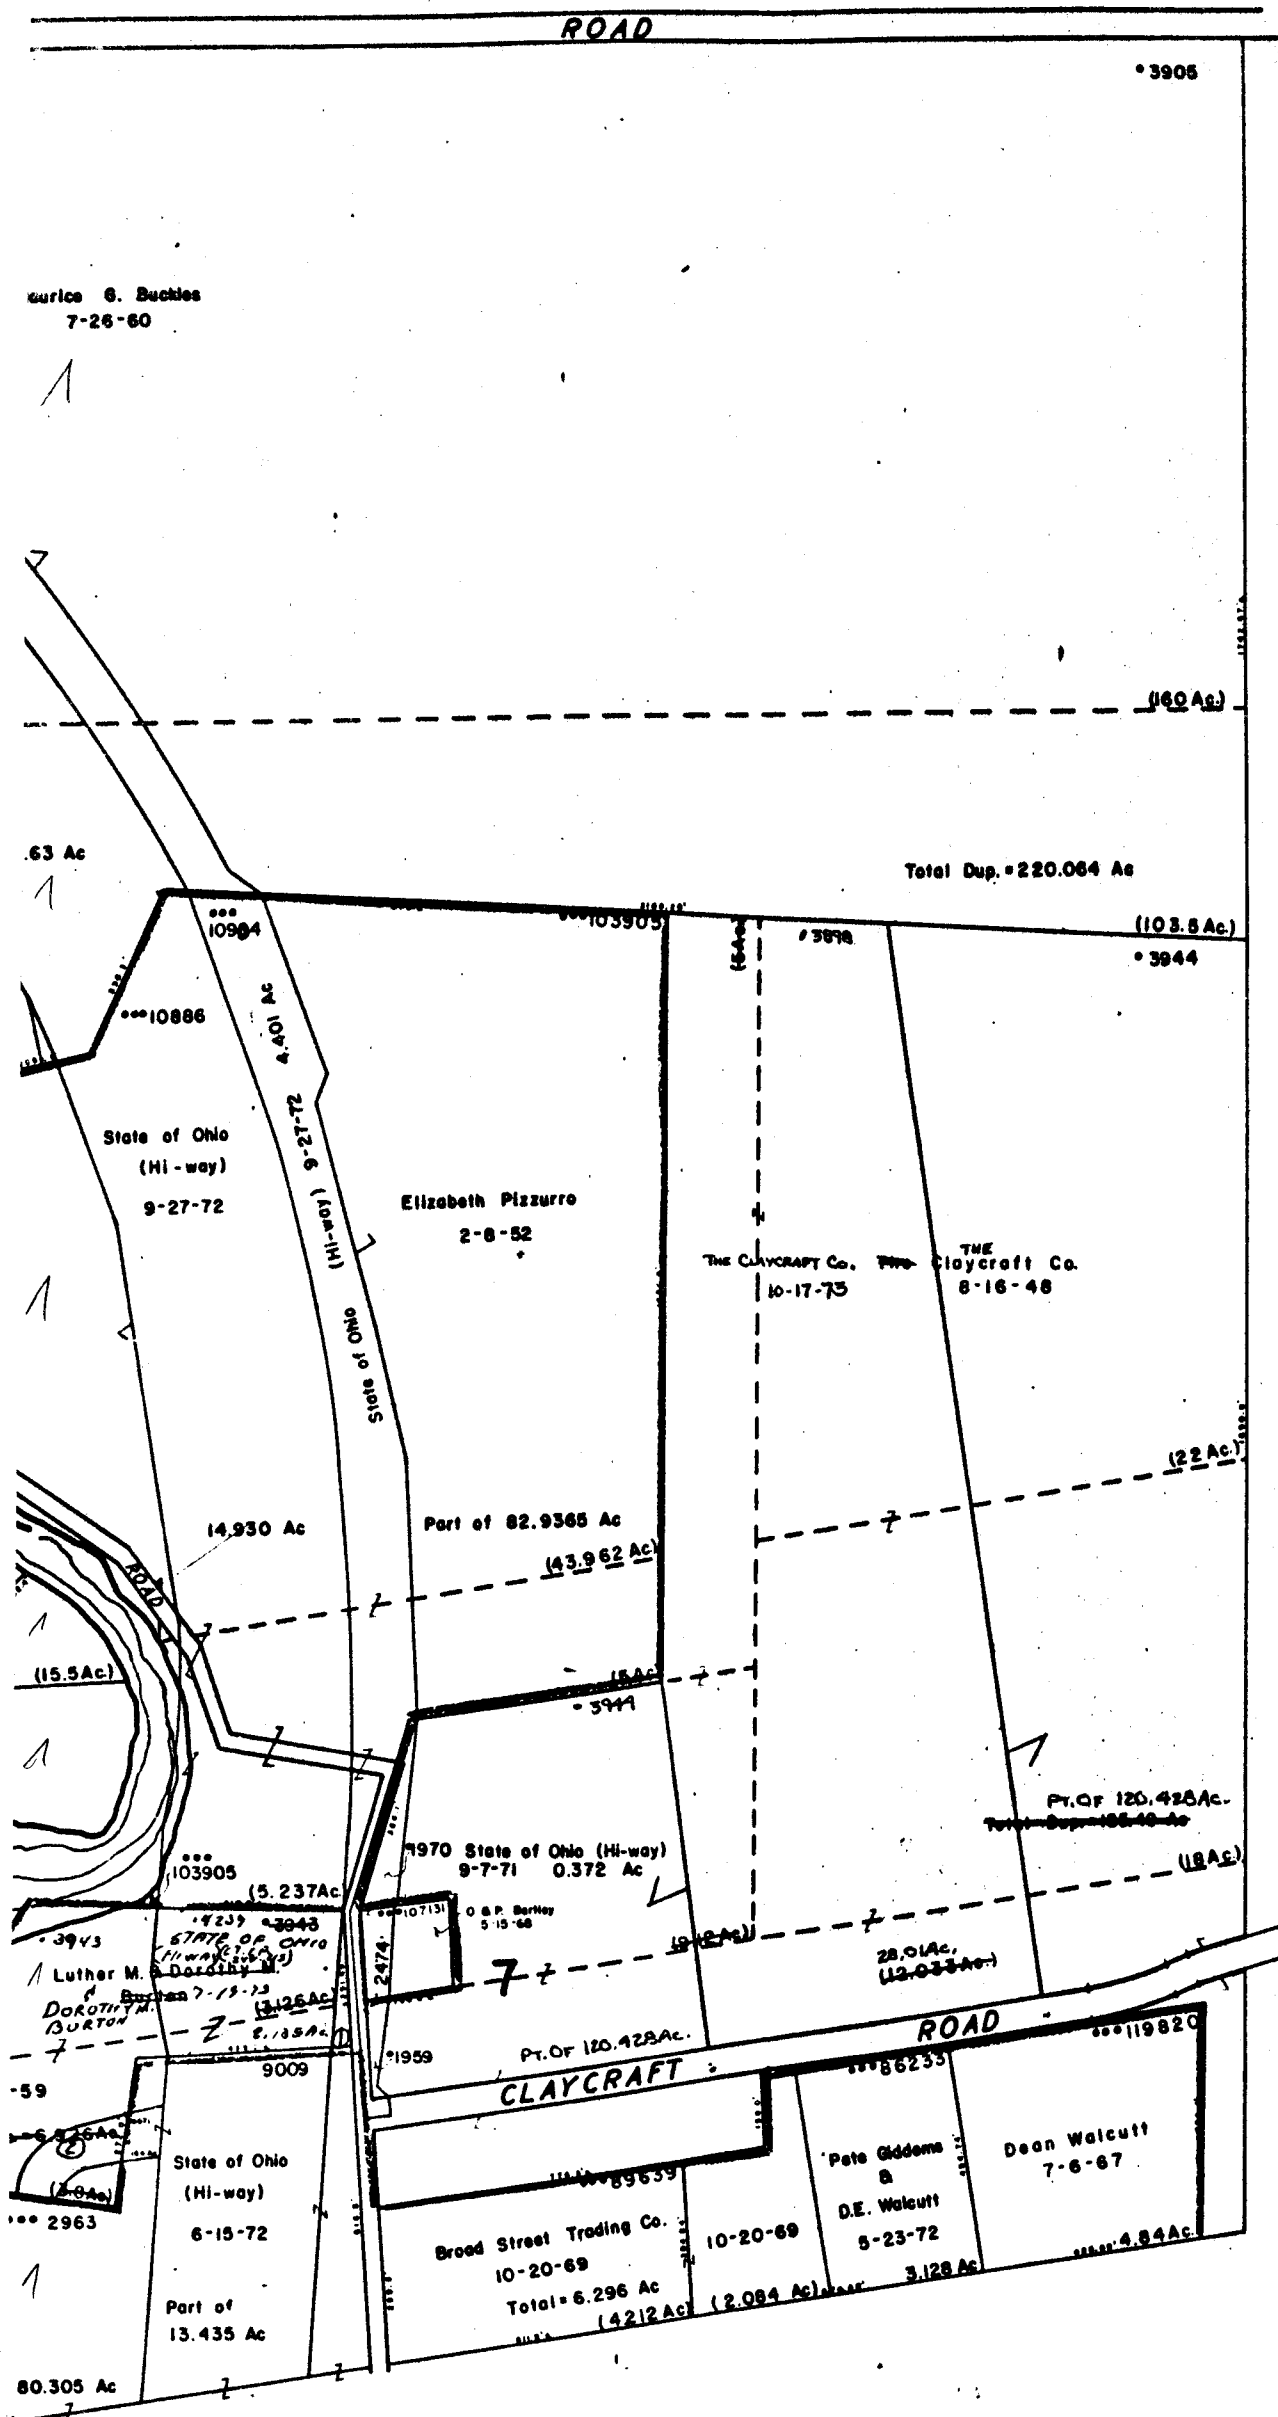

0
39
E

0
39
G

3364
O-39-D