



39  
C

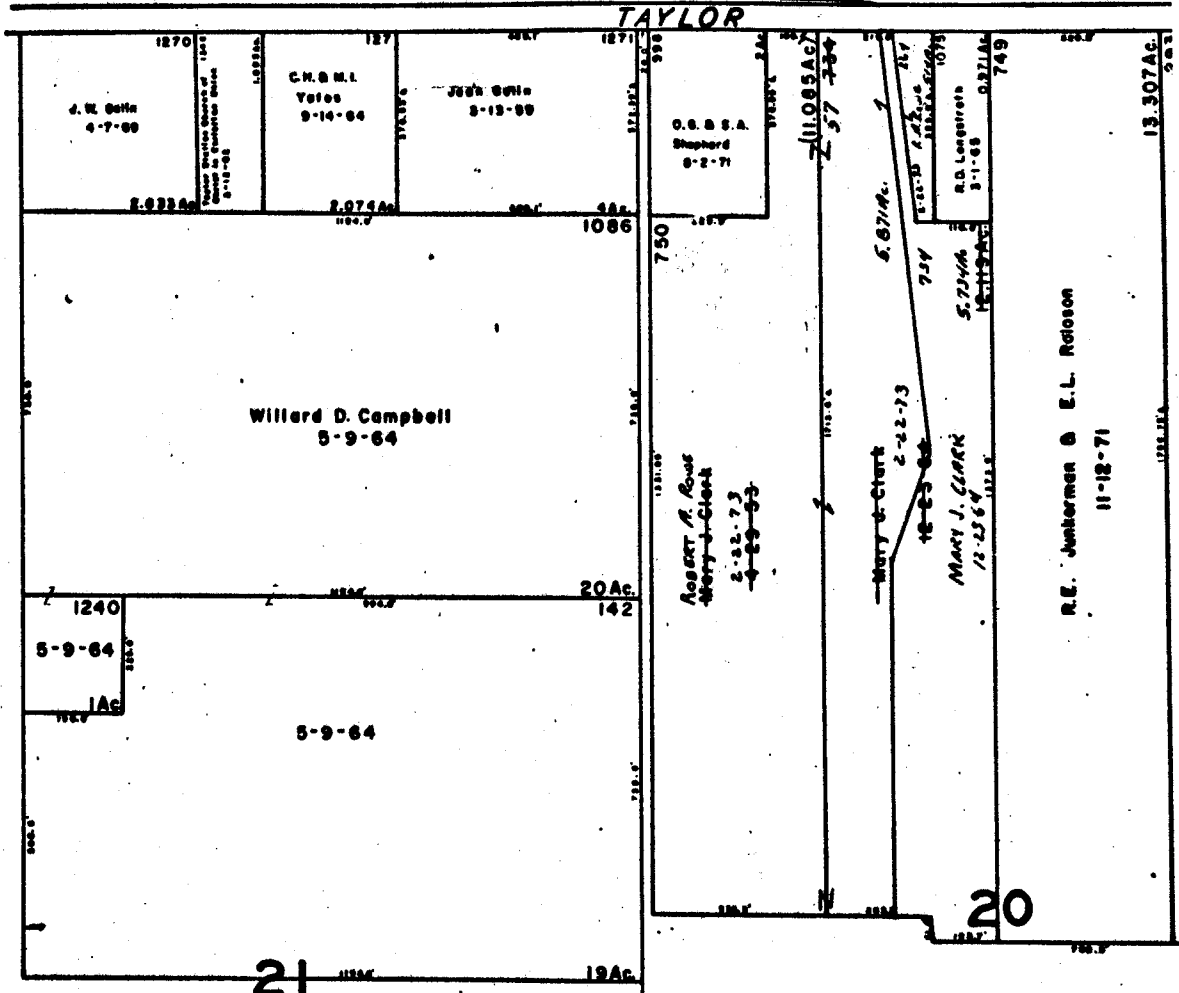


O-39-F

JEFFERSON TWP  
R.16, TWP1

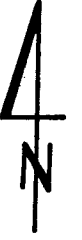

SCALE 1" = 200'  
TAXING DISTRICT  
JEFFERSON TWP  
CITY OF GAHANNA

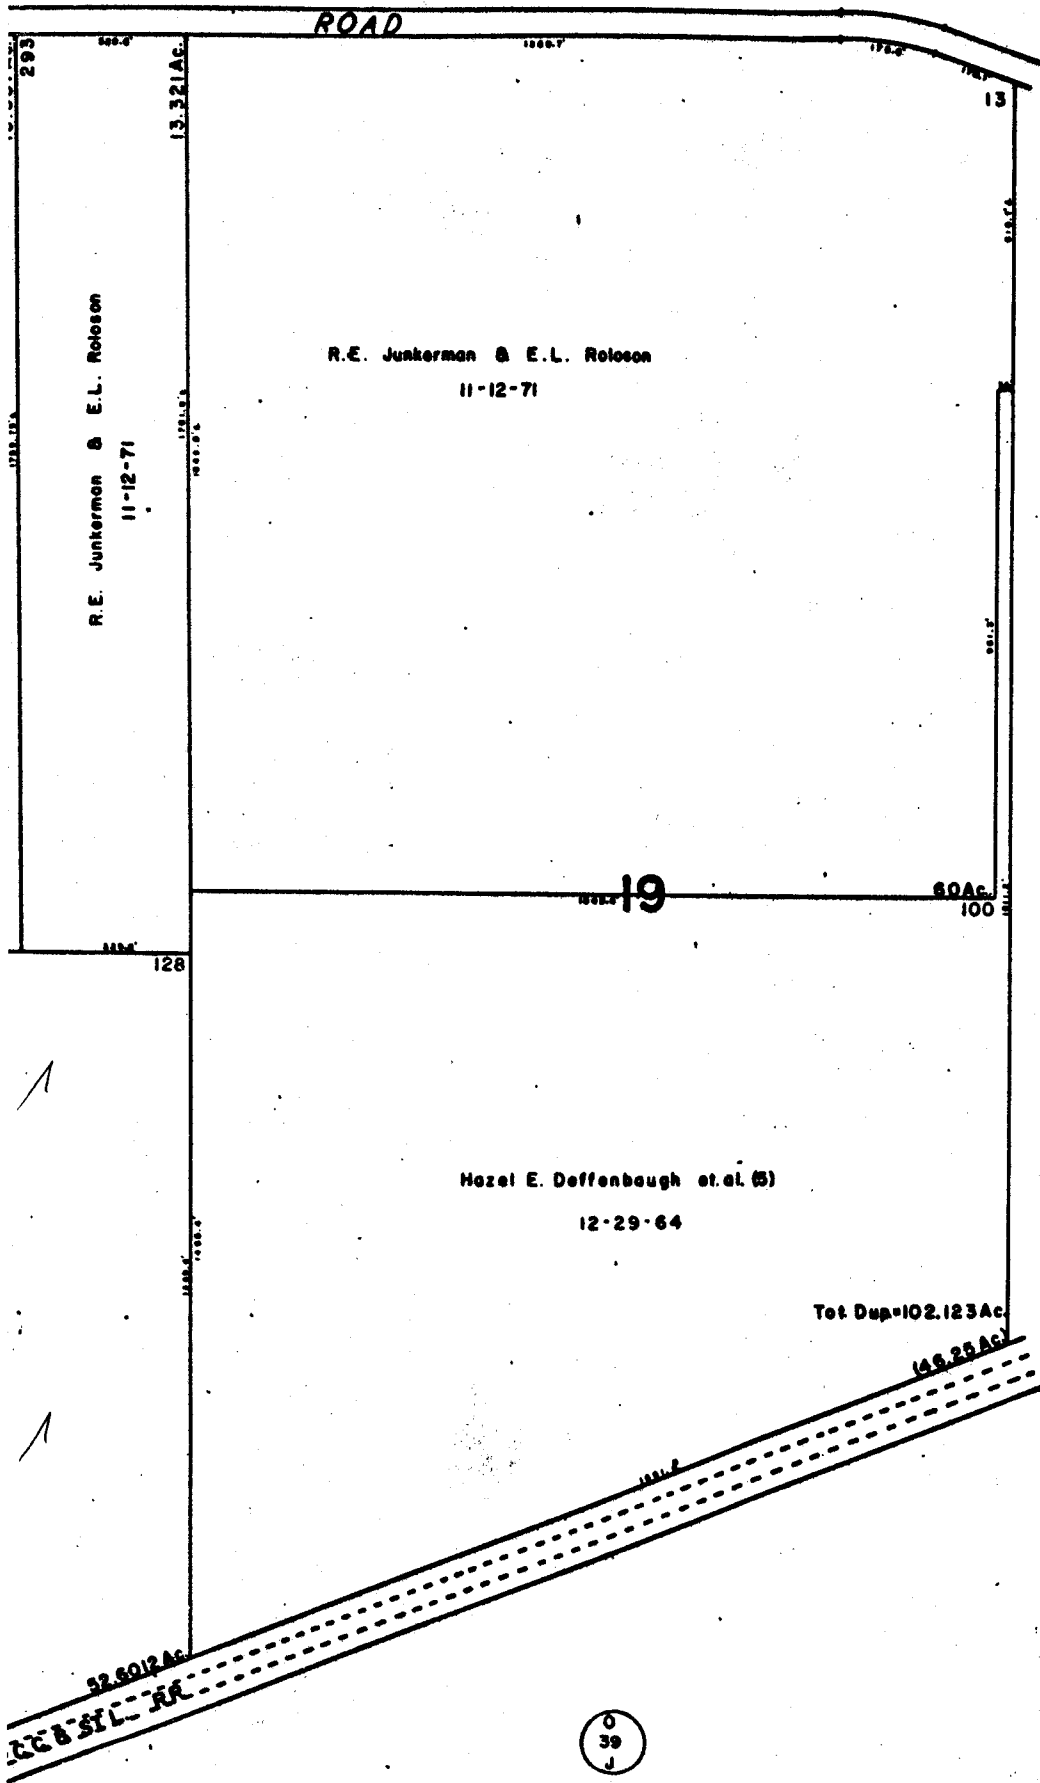

O-39-F  
3368