

Sec. 23, 1/2 Sec. 32.

175'












E. J. SPENCER  
N-16

ER'S SUB.

ELLSWORTH  
DRIVING  
KELTON  
N-10-A

LILLEY  
PARK  
BERKELEY

BERKELEY  
N-10-A

M E L  
COLUMBUS  
U O N  
S  
N-16

AVE.  
103987  
Mary E. Miller  
3-26-63  
0.198Ac.  
104372  
5-18-70  
0.156Ac.  
107200  
A.L. C. C. Bowers  
7-8-69  
0.158A  
100.54


256.25' 10.35Ac.  
W.F. D.R.E. Gibbs  
5-26-66  
0.212Ac.  
104384  
J.E. B.H. Calloway  
8-19-67  
0.192Ac.  
104387  
James  
103985  
C.A.M. Marshall  
11-26-60  
0.297Ac.  
104388  
C.A.M. Marshall  
11-26-60  
0.297Ac.



STRANG  
PLACE  
J-60

Bd. of Education  
7-25-52  
1.185Ac.  
291

104397  
6-25-52  
1.184Ac.  
292

2 City of Columbus  
10-5-54

MOELLERS  
BERKELEY  
N-30-C

BERKELEY  
100.15 ROAD  
N-30-C

S T R A  
J-57

7-25-52  
1.183Ac.  
299.21





DESHLER Named by County Engr. 7-20-44. ALTMAN See Road Record at Page 104 for 56-57

E. J. SWERER'S  
J-60  
CITY  
LOCKBOURNE  
N-30  
AVE.  
JENNINGS  
ADDITON  
AVE.

McCLOUD  
AVE.  
N-30-A

ELLSWORTH  
KELTON  
AVE.  
LILLEY  
K

MARION TWP.  
R-22 TWP-5  
SCALE 1-100  
TAXING DISTRICT COL'S.  
N.E.L.M.P.  
Twp. 10-23-73  
ROAD

FRANK  
J. MOELLERS  
N-30-1

STEIN  
SUB.  
COMFIELD  
N-30-C

GATES  
AVE.

AVE.  















104054

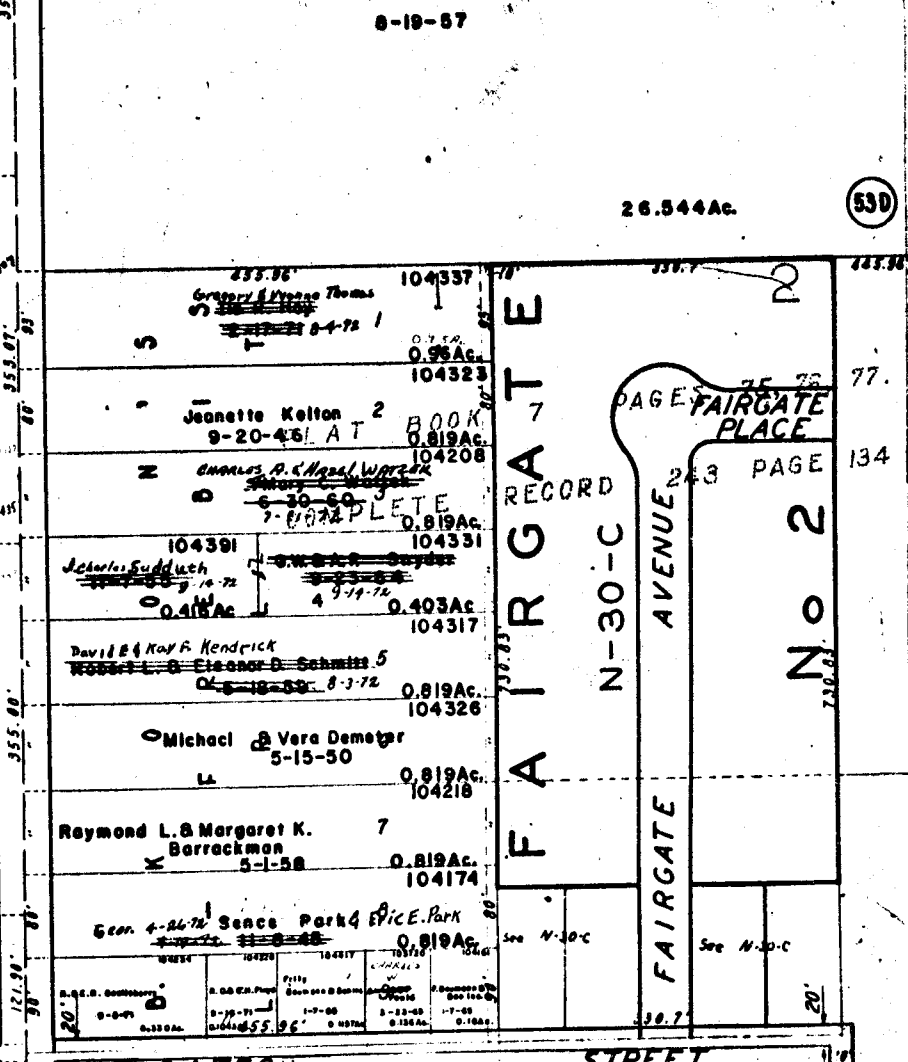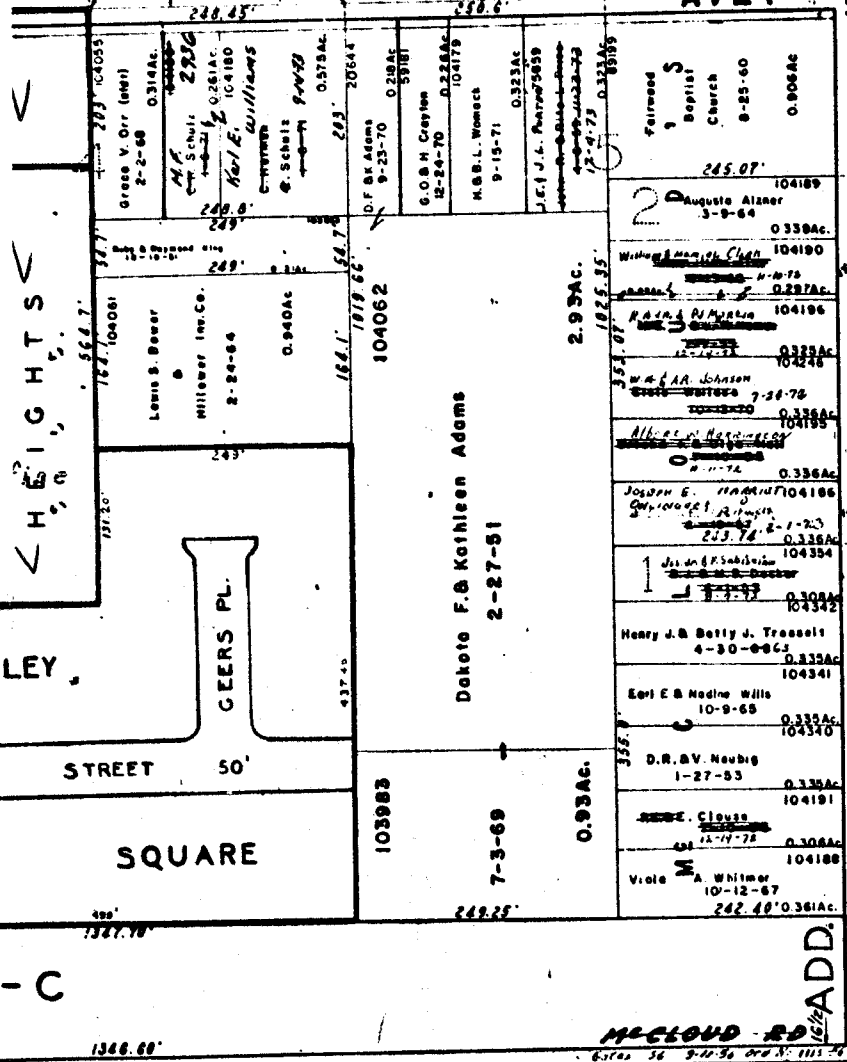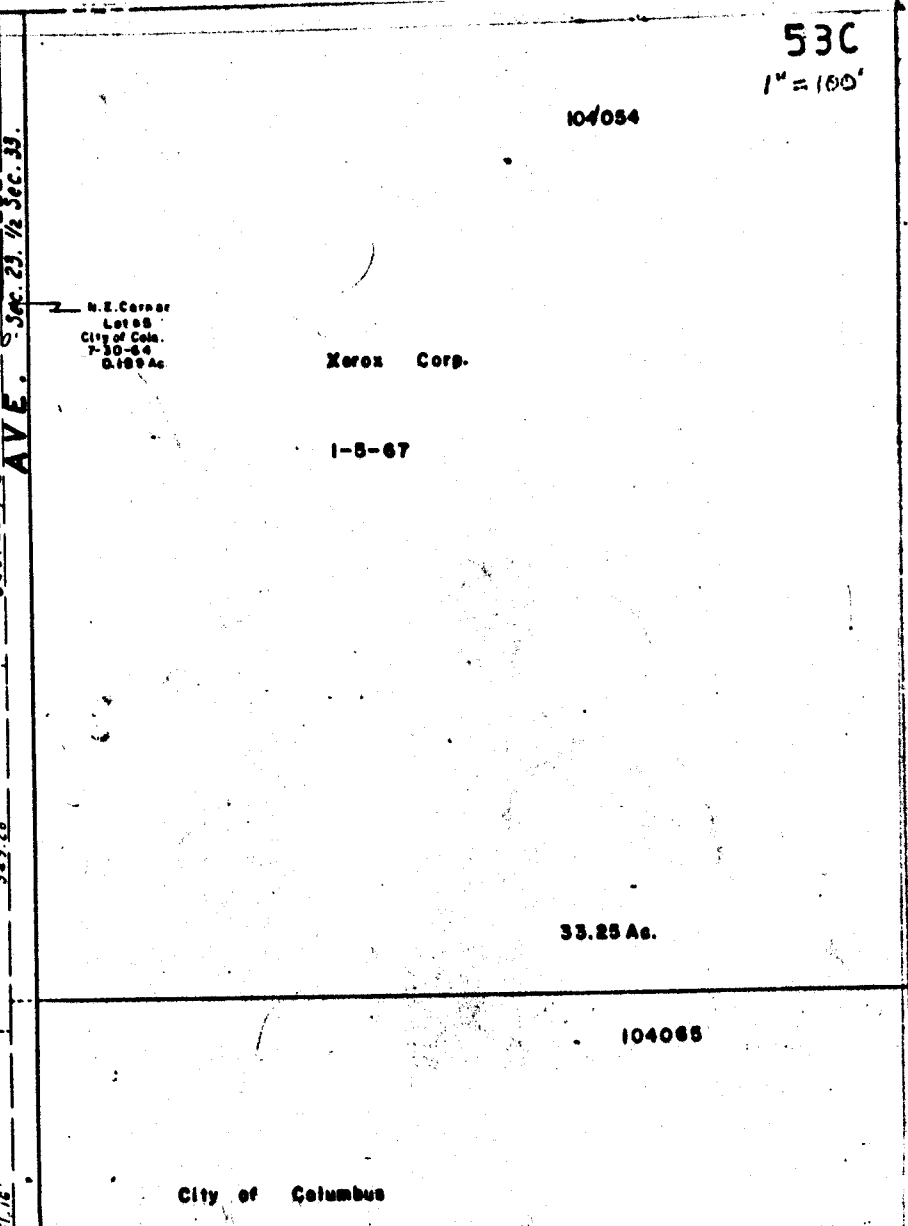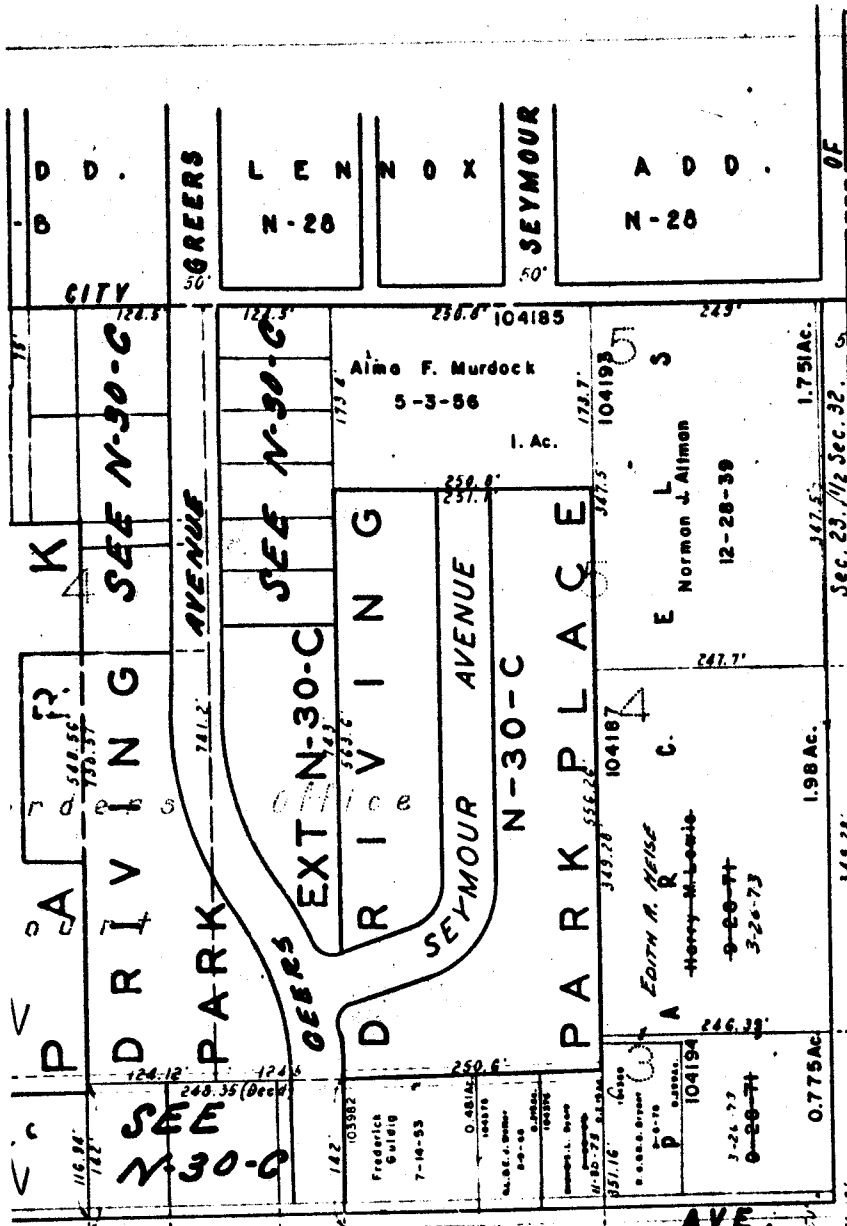

