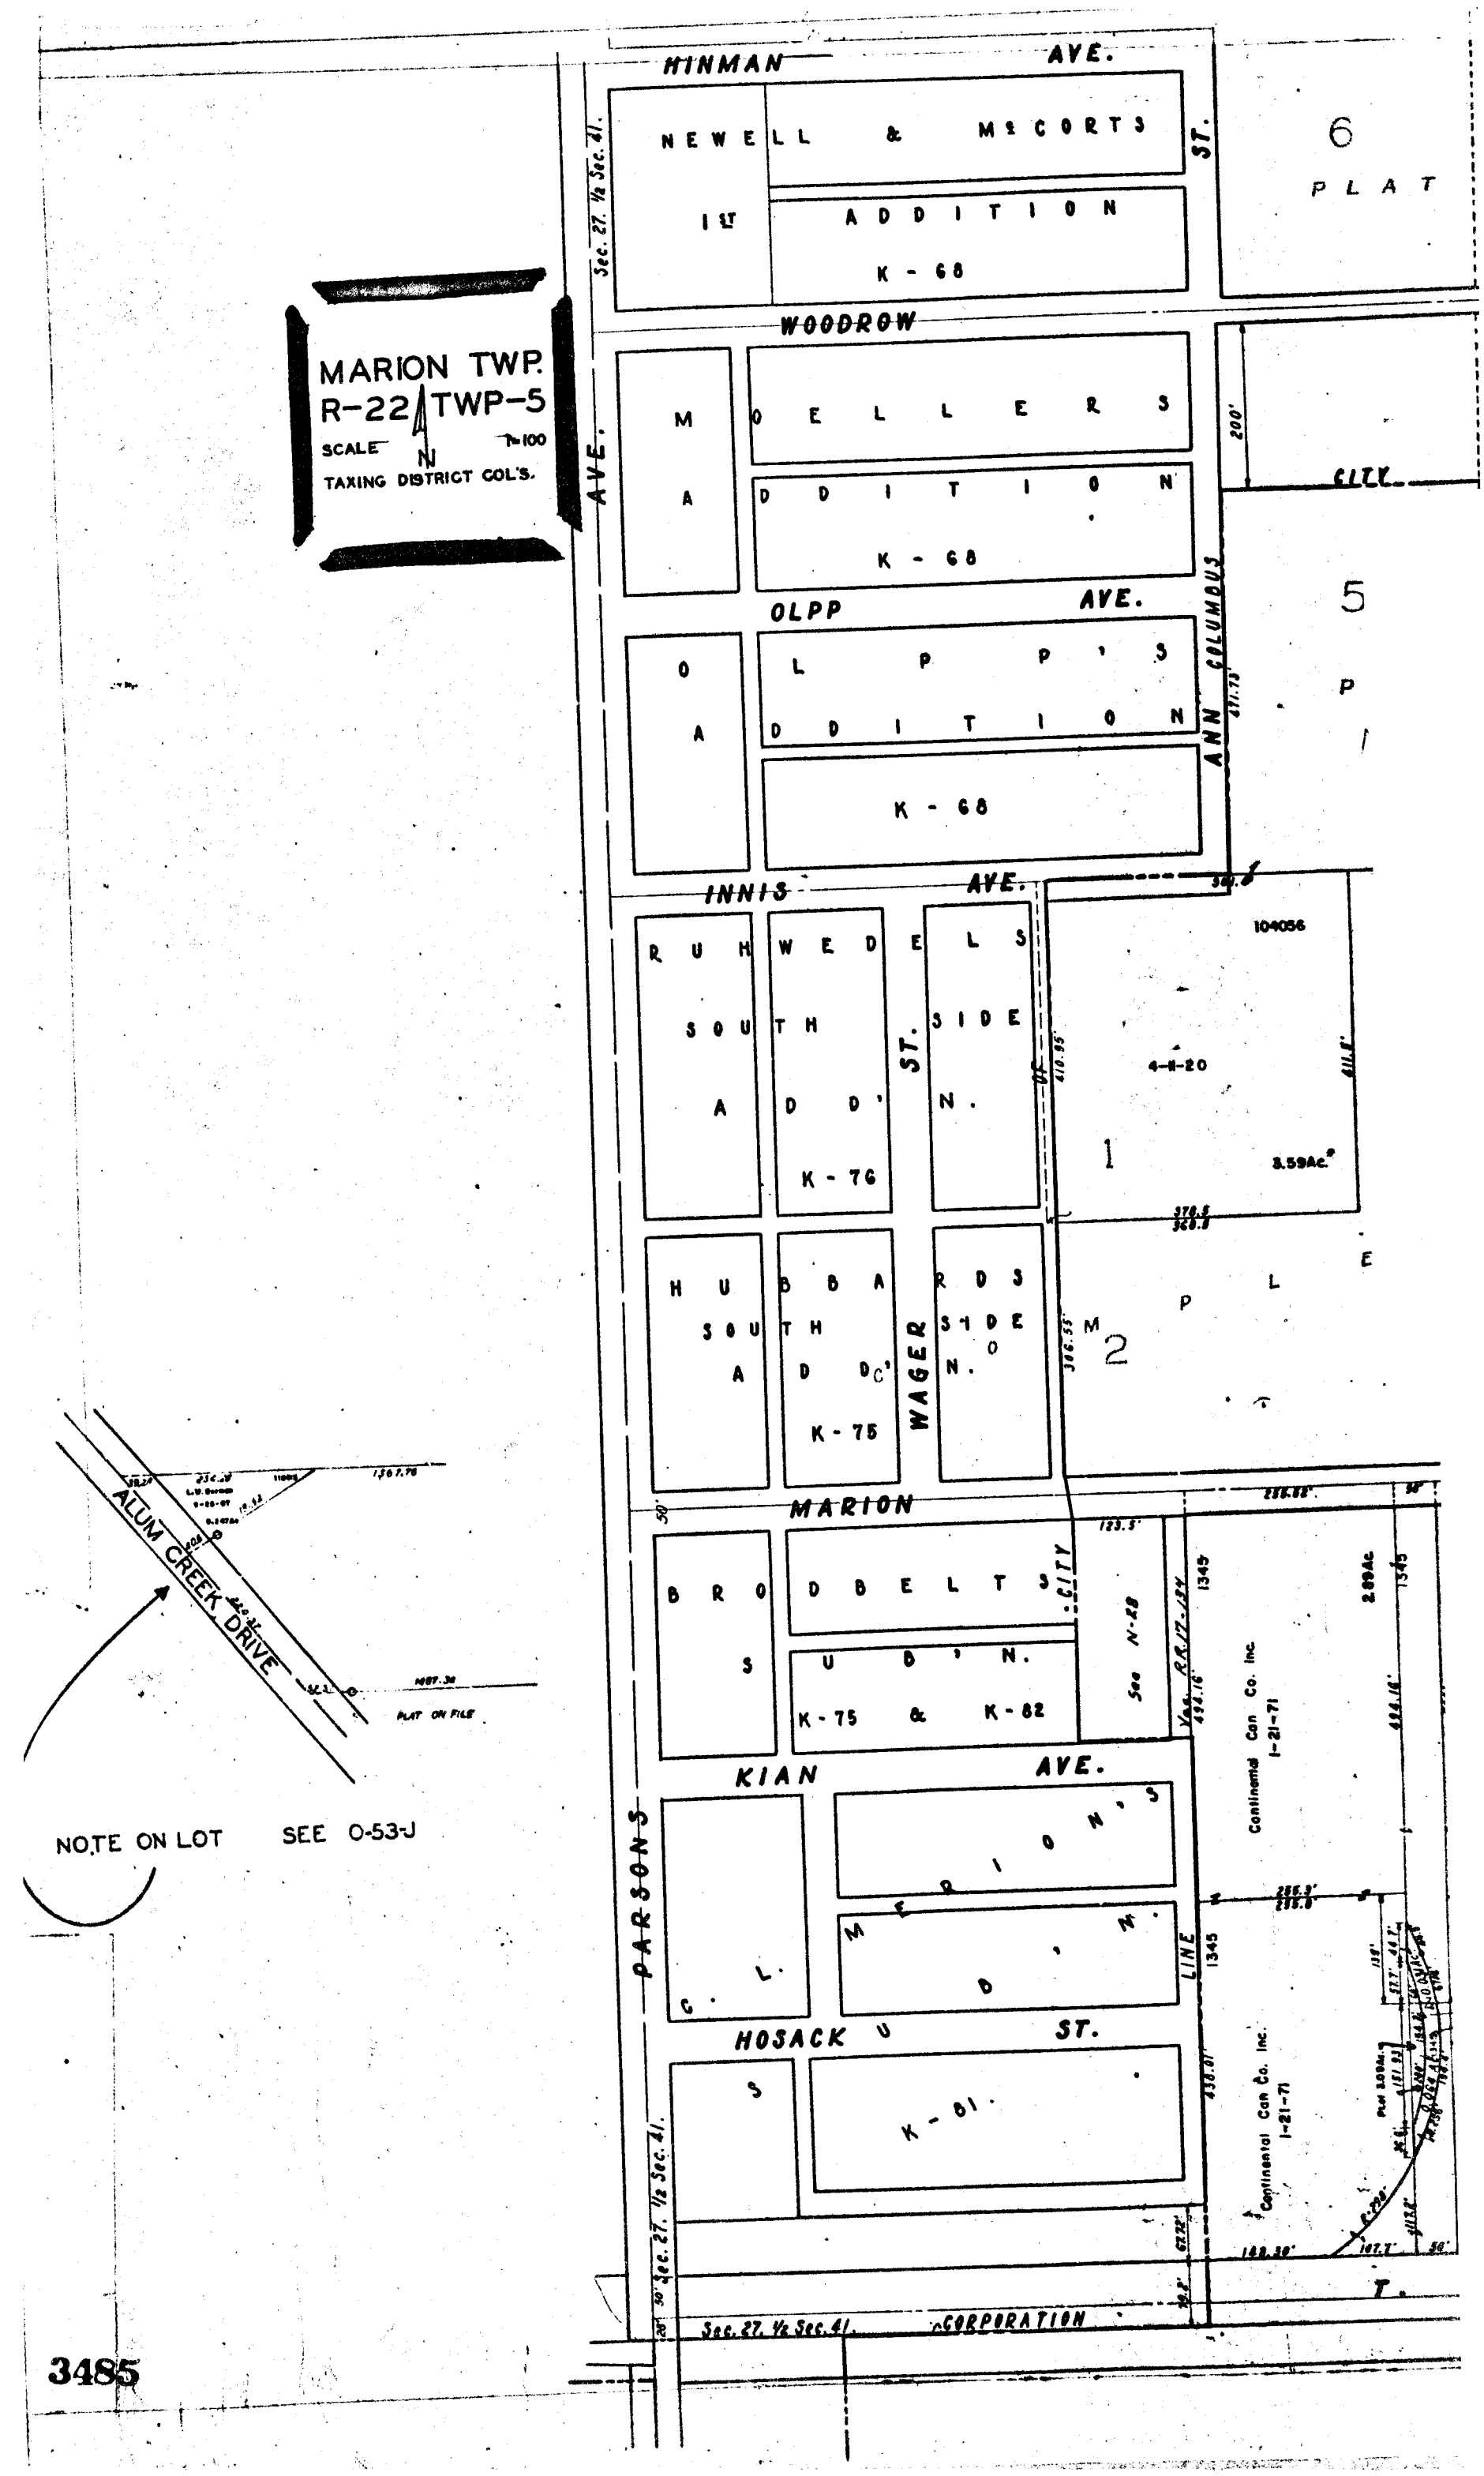
MARION TWP.
R-22 TWP-5
SCALE 1"=100'
TAXING DISTRICT COL'S.
HINMAN AVE.
NEWELL & McCORTS
1ST ADDITION
K - 68
6
PLAT
WOODROW
MAPOELLERS
ADDITION
K - 68
CITY
5
OLPP AVE.
OLPPS
ADDITION
K - 68
ANN COLUMBUS ST.
INNIS AVE.
RUSH SOUTH ADD'N.
K - 76
WEDELS SIDE ST.
104056
4-8-20
3.59Ac.
1
HUBBARDS SOUTH ADD'N.
K - 75
WAGER
HUBBARDS SIDE ST.
2
MARION
BROSDELTS
SUB'N.
K - 75 & K - 82
See N-28
CITY
KIAN AVE.
PARSONS
C. L. MERIONS
MERIONS SUB'N.
HOSACK ST.
K - 01
LINE
Continental Can Co. Inc.
1-21-71
Sec. 27. 1/2 Sec. 41.
CORPORATION
ALUM CREEK DRIVE
PLAT ON FILE
NOTE ON LOT SEE 0-53-J
3485

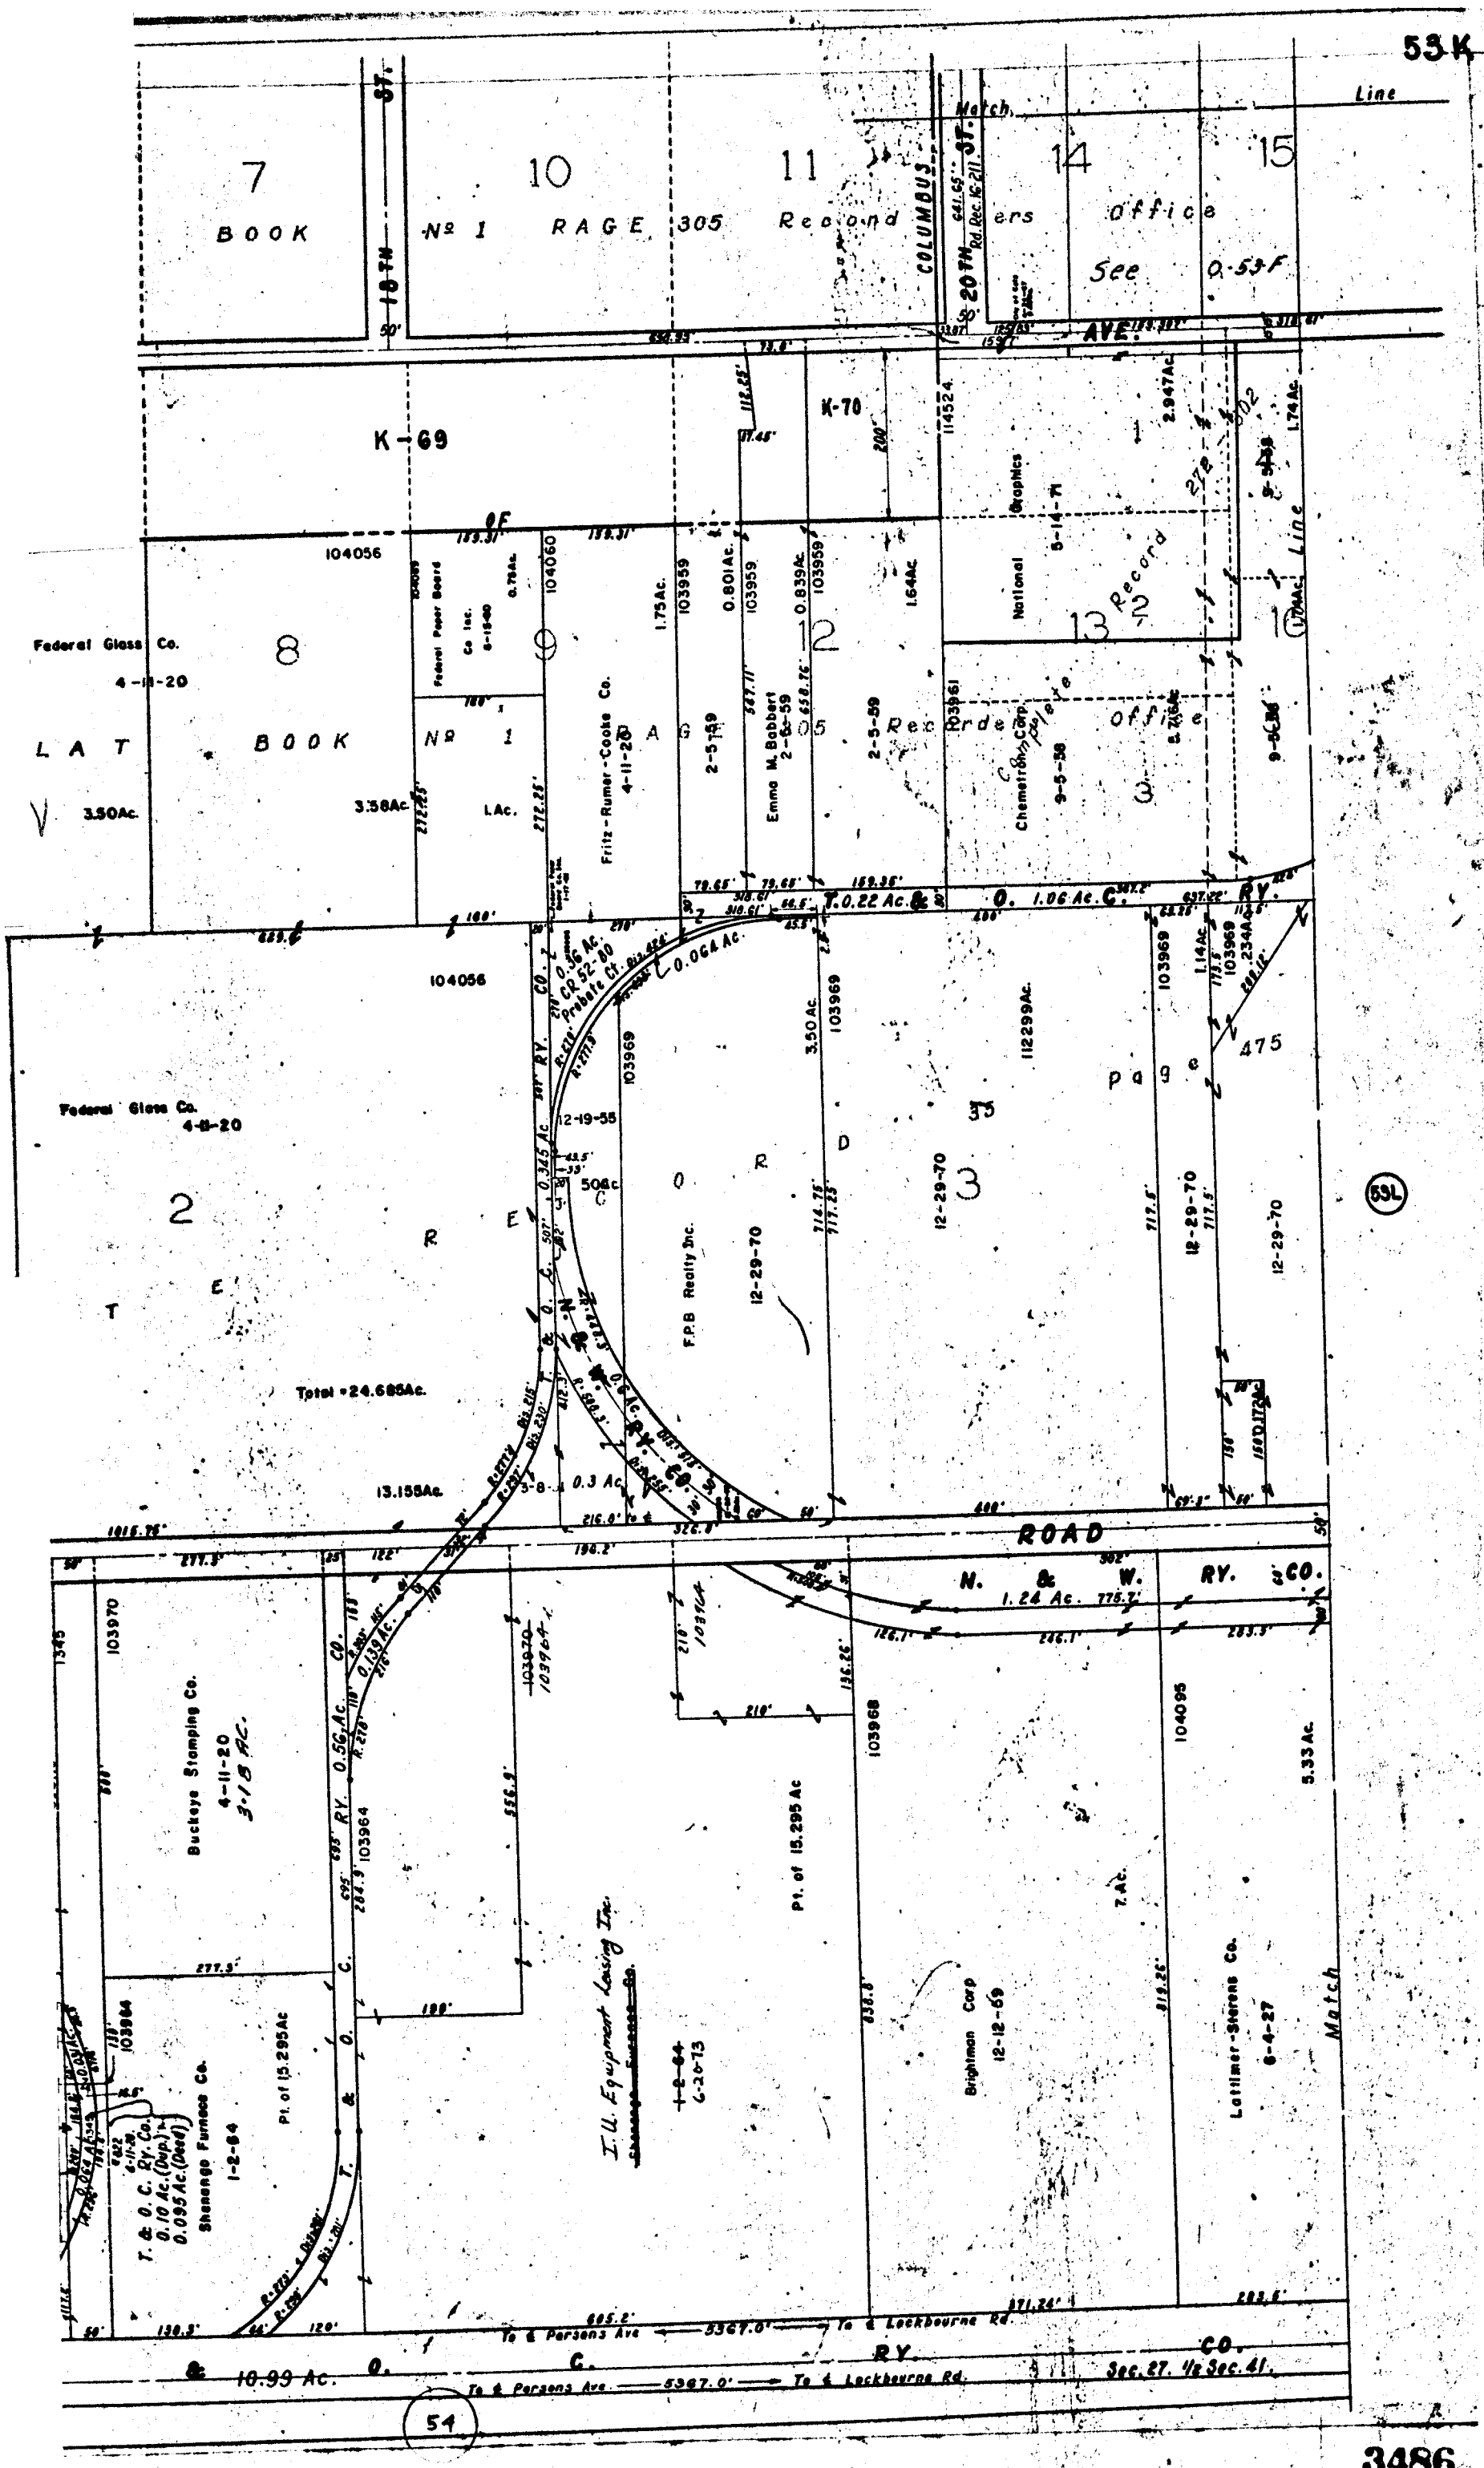
BOOK Nº 1 PAGE 305 Recorders office See O-53F
COLUMBUS AVE.
Match Line
K-69
K-70
Federal Glass Co. 4-11-20
BOOK Nº 1 PAGE 305 Recorders office
Fritz-Rumer-Cooke Co.
Emma M. Babbert 2-6-59
National Graphics 5-14-71
Chemetron Corp.
T. & O. C. RY.
Probate Ct. CR 52-80
F.P.B Realty Inc.
Total = 24.685Ac.
13.155Ac.
ROAD
N. & W. RY. CO.
Buckeye Stamping Co. 4-11-20 3.18 Ac.
Pt. of 15.295 Ac
I.U. Equipment Leasing Inc.
Brightman Corp 12-12-69
Lattimer-Stevens Co. 6-4-27
Shenango Furnace Co. 1-2-84
T. & O. C. Ry. Co. 0.10 Ac.(Dup.) 0.095 Ac.(Deed)
To & Persons Ave. 5367.0' To & Lockbourne Rd.
10.99 Ac. O. C. RY. CO.
Sec. 27. 1/2 Sec. 41.
Page 475
54